

1

2


3

4

5

D

D

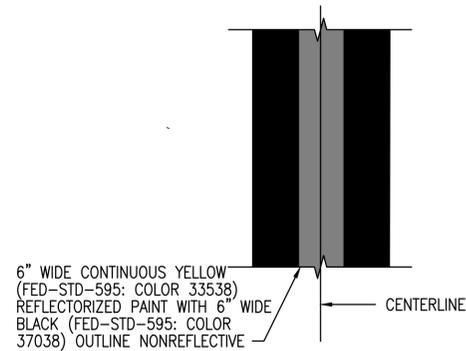


CENTERLINE MARKING (C1)
NOT TO SCALE



MARKING SHALL BE 6" YELLOW (FED-STD-595: COLOR 33538) REFLECTORIZED PAINT WITH 6" WIDE BLACK (FED-STD-595: COLOR 37038) NONREFLECTIVE BETWEEN


NOTE:
1. SEE DETAIL B2, THIS SHEET, FOR EDGE MARKINGS AT CONCRETE FILLET/RADI.

TAXIWAY/HCP APRON EDGE MARKING (C2)
NOT TO SCALE

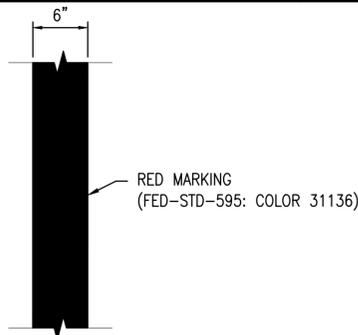


NOTE:
1. SEE DETAIL A1, THIS SHEET FOR ADDITIONAL MARKINGS.
2. SEE DETAILS B1, THIS SHEET, FOR RESTRICTED BOUNDARY SIGNS TO BE PAINTED EVERY 100' ALONG RESTRICTED BOUNDARY MARKINGS. COORDINATE WITH JOINT BASE ANDREWS SECURITY OFFICE.


RESTRICTED BOUNDARY MARKING (RED LINE) (C3)
NOT TO SCALE

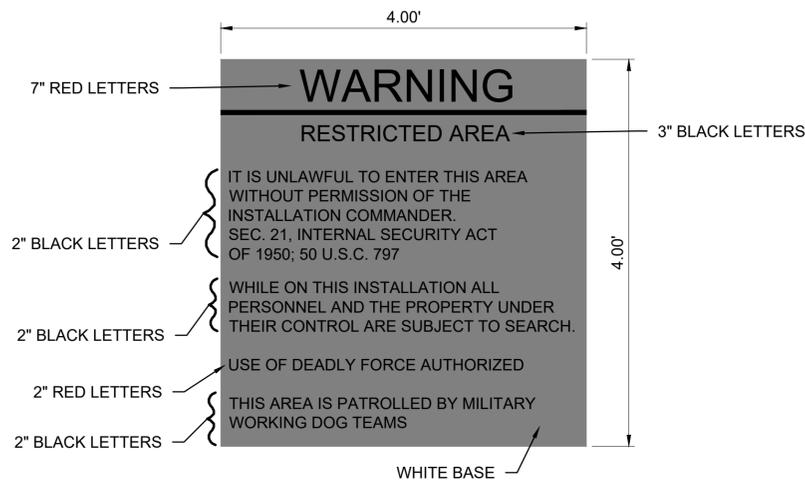

NOTES:
1. SIGN SHALL BE PAINTED ON PAVEMENT AT ECP AND EVERY 100FT ALONG REDLINE.
2. COORDINATE LOCATION WITH COR.
3. SIGN SHALL MEET REQUIREMENTS OF JOINT BASE ANDREWS SECURITY OFFICE.

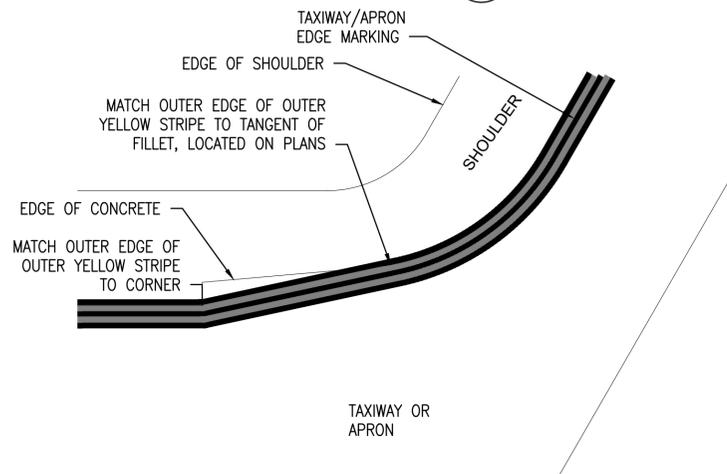


TYPICAL EDGE STRIPE AT FILLET (B2)
NOT TO SCALE

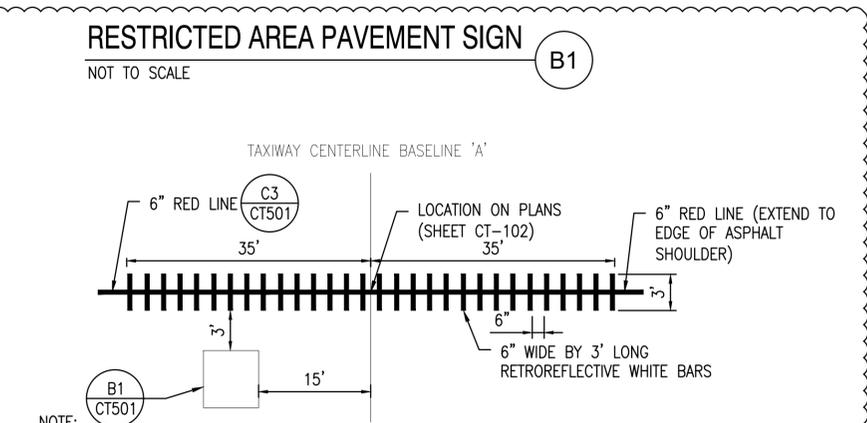

NOTE:
1. ENTRY CONTROL POINT MARKINGS ARE 6" WIDE BY 3' LONG RETROREFLECTIVE WHITE BARS SEPARATED BY 6" GAPS.
2. RESTRICTED AREA BOUNDARY IS A 6" WIDE RED BORDER AROUND THE RESTRICTED AREA.
3. SEE DETAIL B1, THIS SHEET, FOR ADDITIONAL MARKINGS.
4. SIGN SHALL MEET REQUIREMENTS OF JOINT BASE ANDREWS SECURITY OFFICE.

ENTRY CONTROL POINT (ECP) (A1)
NOT TO SCALE

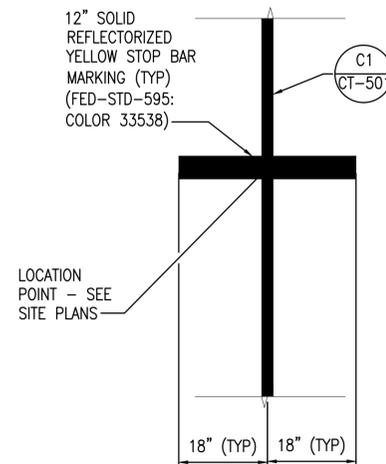

STOP BAR MARKING (A4)
NOT TO SCALE

C

C

B

B

A

A

AMENDMENT 0004	DATE	APPR
0	09/26/2022	
1	04/01/2023	
SYM DESCRIPTION	ISSUE FOR CONSTRUCTION	



WileyWilson | BURNS & MCDONNELL
JOINT VENTURE

APPROVED

FOR COMMANDER NAVFAC

ACTIVITY

SATISFACTORY TO	DATE
DES	DRW
CHK	
BRANCH MANAGER	
CHIEF ENGINEER	
FIRE PROTECTION	

DEPARTMENT OF THE NAVY
NAVAL FACILITIES ENGINEERING COMMAND
WASHINGTON DC
WASHINGTON NAVAL YARD

NAVAL FACILITIES ENGINEERING COMMAND - WASHINGTON
WASHINGTON DC
JOINT BASE ANDREWS NAVAL AIR FACILITY
CAMP SPRINGS, MD
P-3002 RELOCATE HAZARDOUS CARGO
PAD AND EOD PROFICIENCY RANGE
TAXIWAY MARKING DETAILS

SCALE:	AS NOTED
EPROJECT NO.:	1396850
CONSTR. CONTR. NO.:	N40080-22-R-8580
NAVFAC DRAWING NO.:	13140359
SHEET	89 OF 229

CT-501

DRAWING REVISION: 06 APRIL 2017

1

2

3

4

5