




**SOUTH ELEVATION**  
SCALE: 1/8"=1'-0"

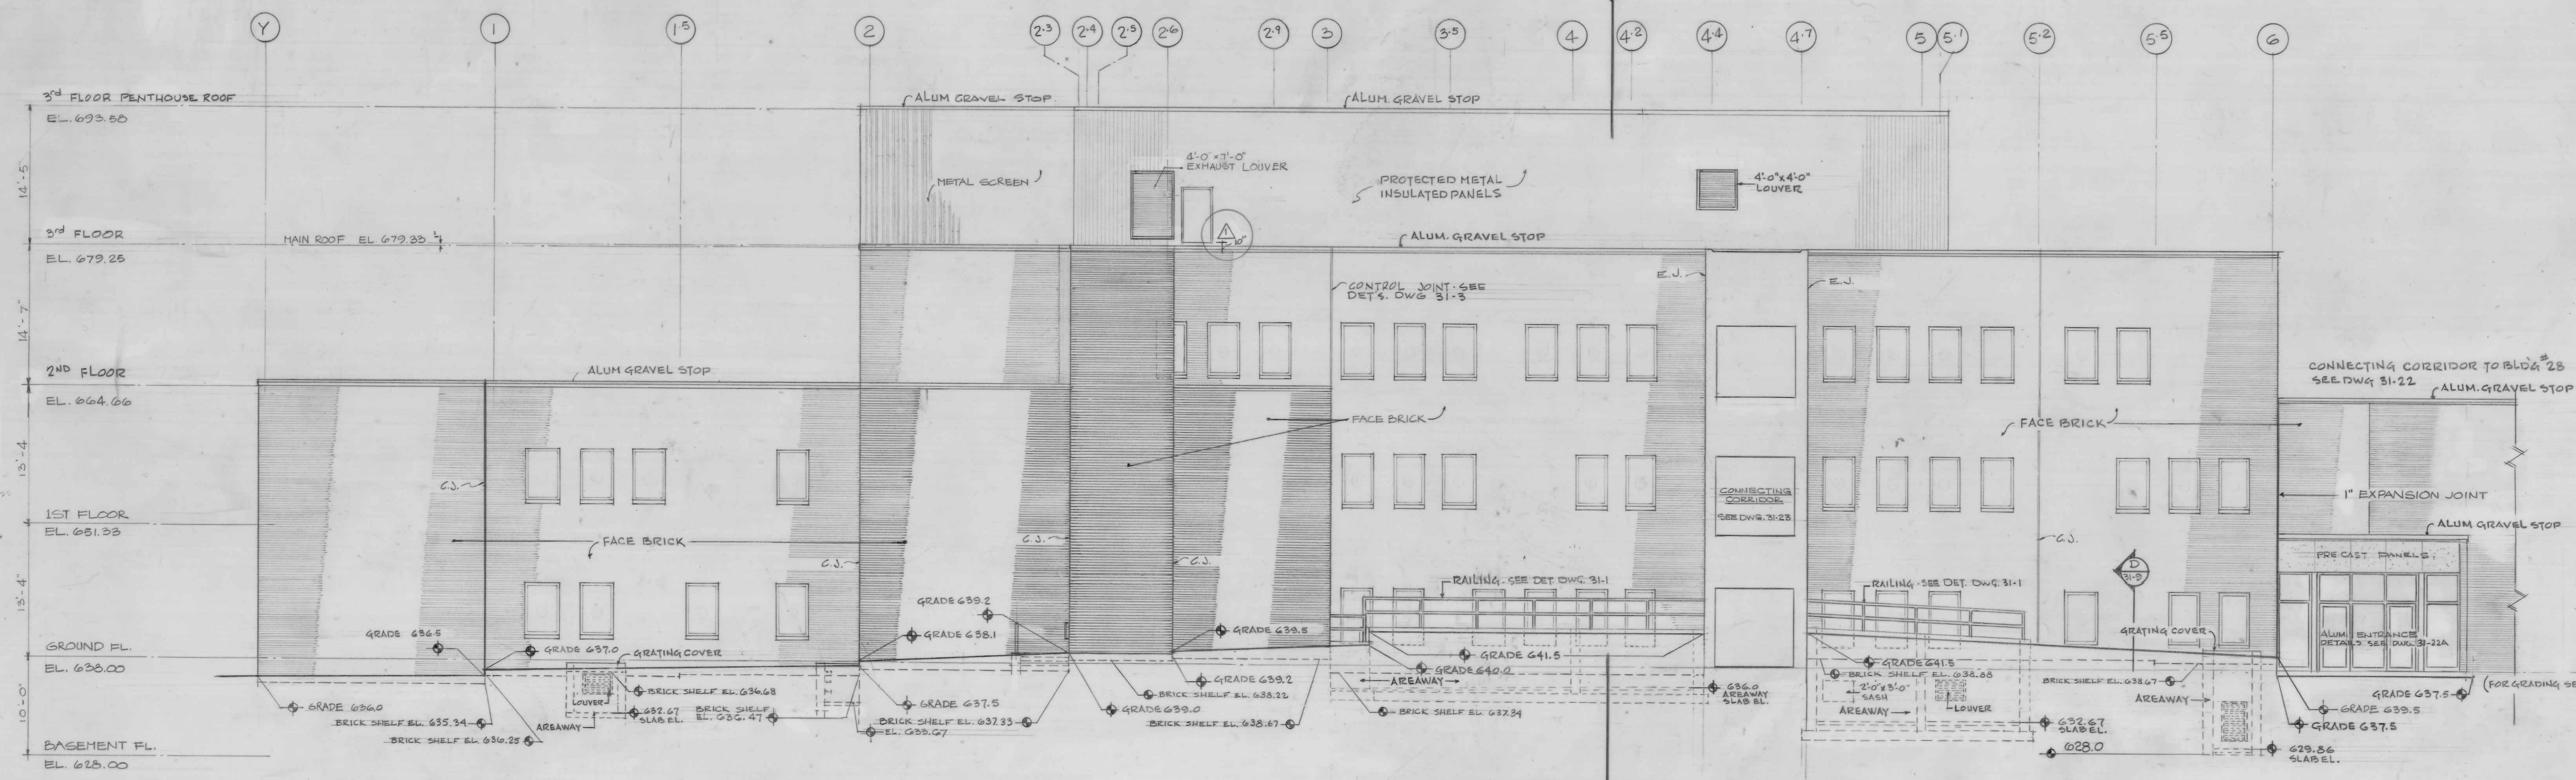

**WEST ELEVATION**  
SCALE: 1/8"=1'-0"

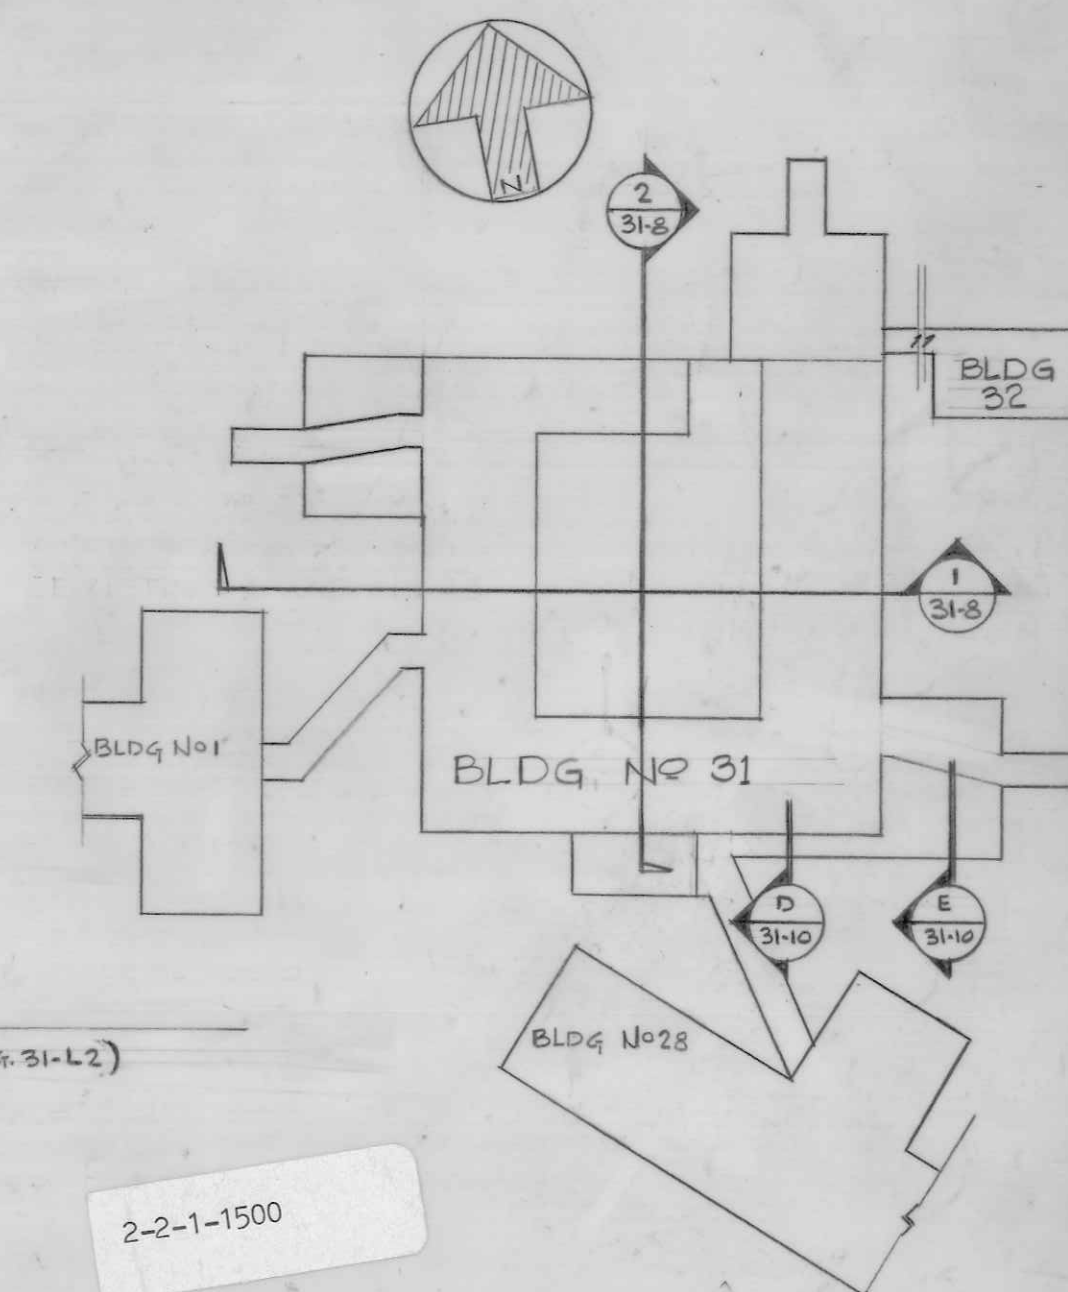

ELEVATIONS		
BUILDING NO. 31		
NEW 204 BED HOSPITAL BUILDING		
VETERANS ADMINISTRATION WHITE RIVER JUNCTION, VERMONT		
Drawn <u>RC</u>	Proj. Mgr. <u>SMB</u>	REVISIONS
Checked <u>RC</u>	Date <u>OCT. 27, 71</u>	No. Date Description
		<u>1</u> <u>10/27/71</u> <u>AS BUILT</u>
BELLANTE CLAUSS MILLER & NOLAN		
ARCHITECTS ENGINEERS PLANNERS		DRAWING NUMBER
130 NORTH WASHINGTON AVE. SCRANTON, PA.		<b>31-6</b>
		Sheet <u>6</u> of <u>23</u>
		Proj. No. <u>44-5053</u>



ONE EIGHTH INCH EQUALS ONE FOOT  
2 4 6 8 10 12 14 16 18 20 22 24 26 28 30 32 34

NOTE: SEE WINDOW DETAILS SHEET NO. 31-14



RETURN TO ARCHITECTS

FILE FOLDER NO. 31-6







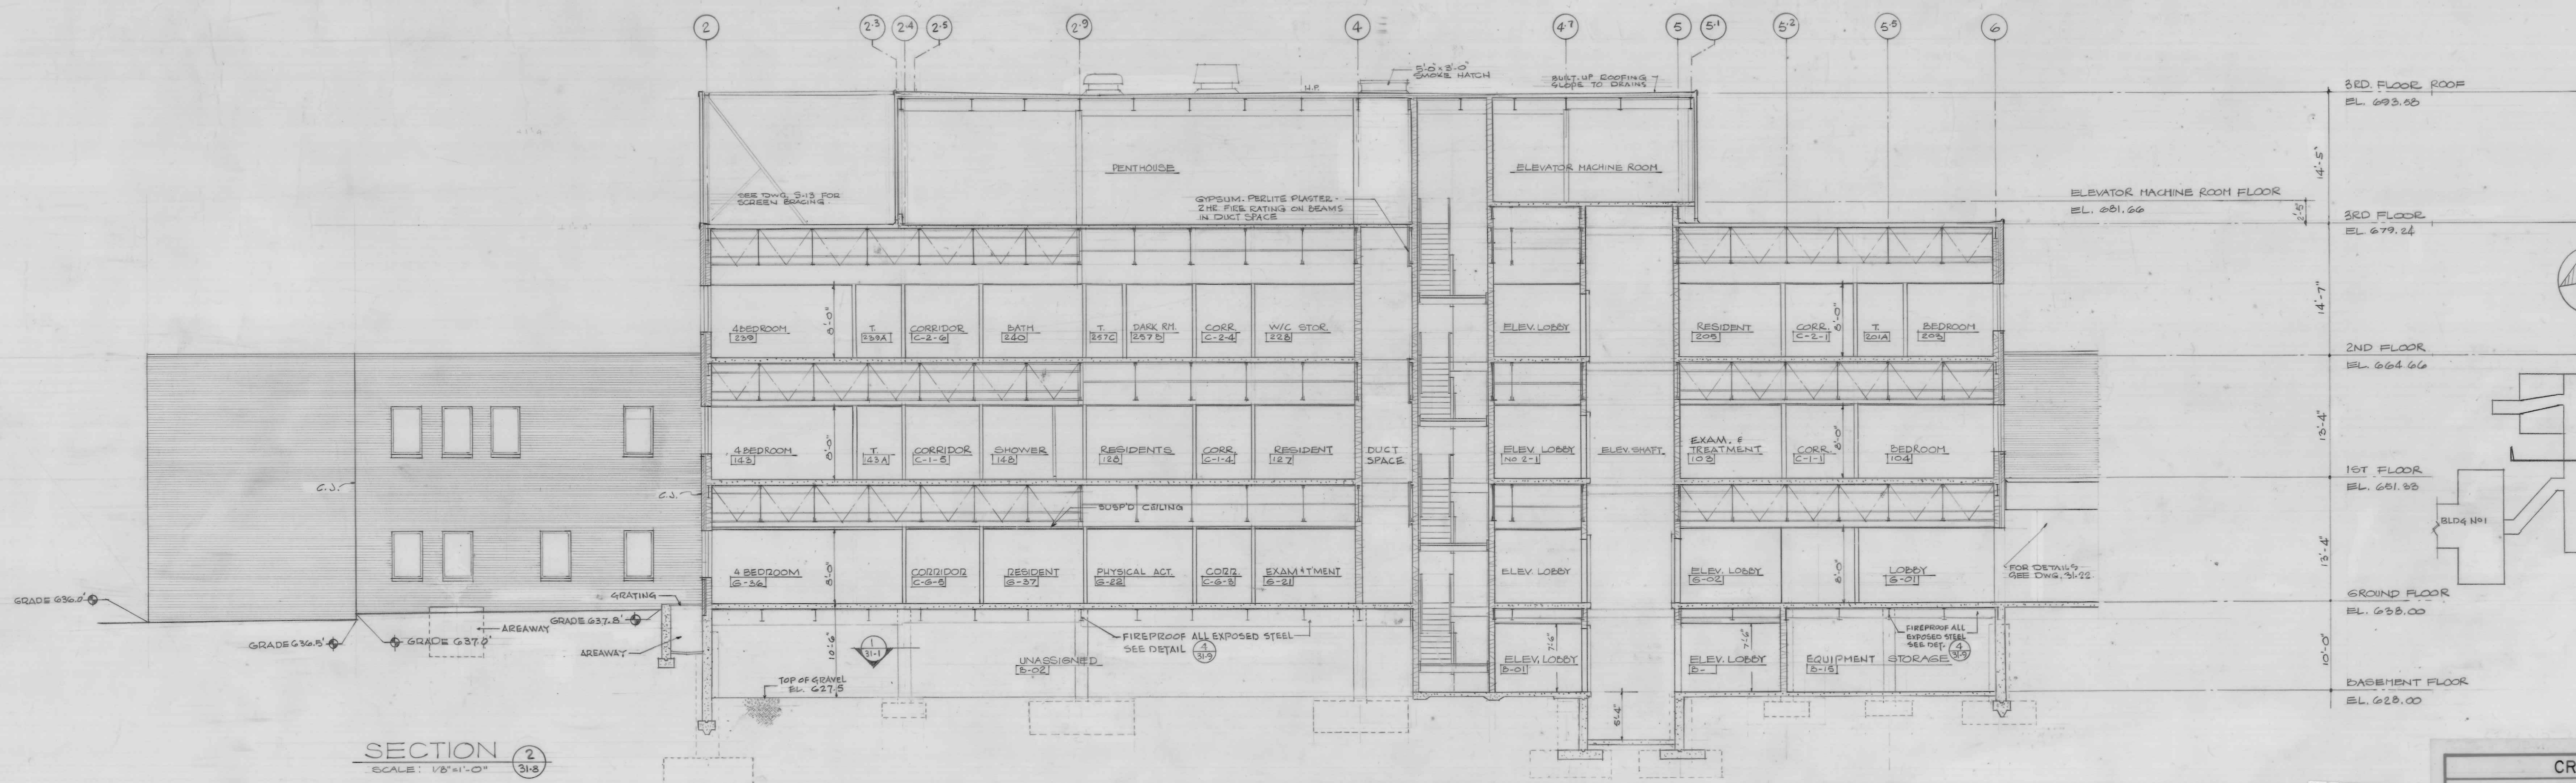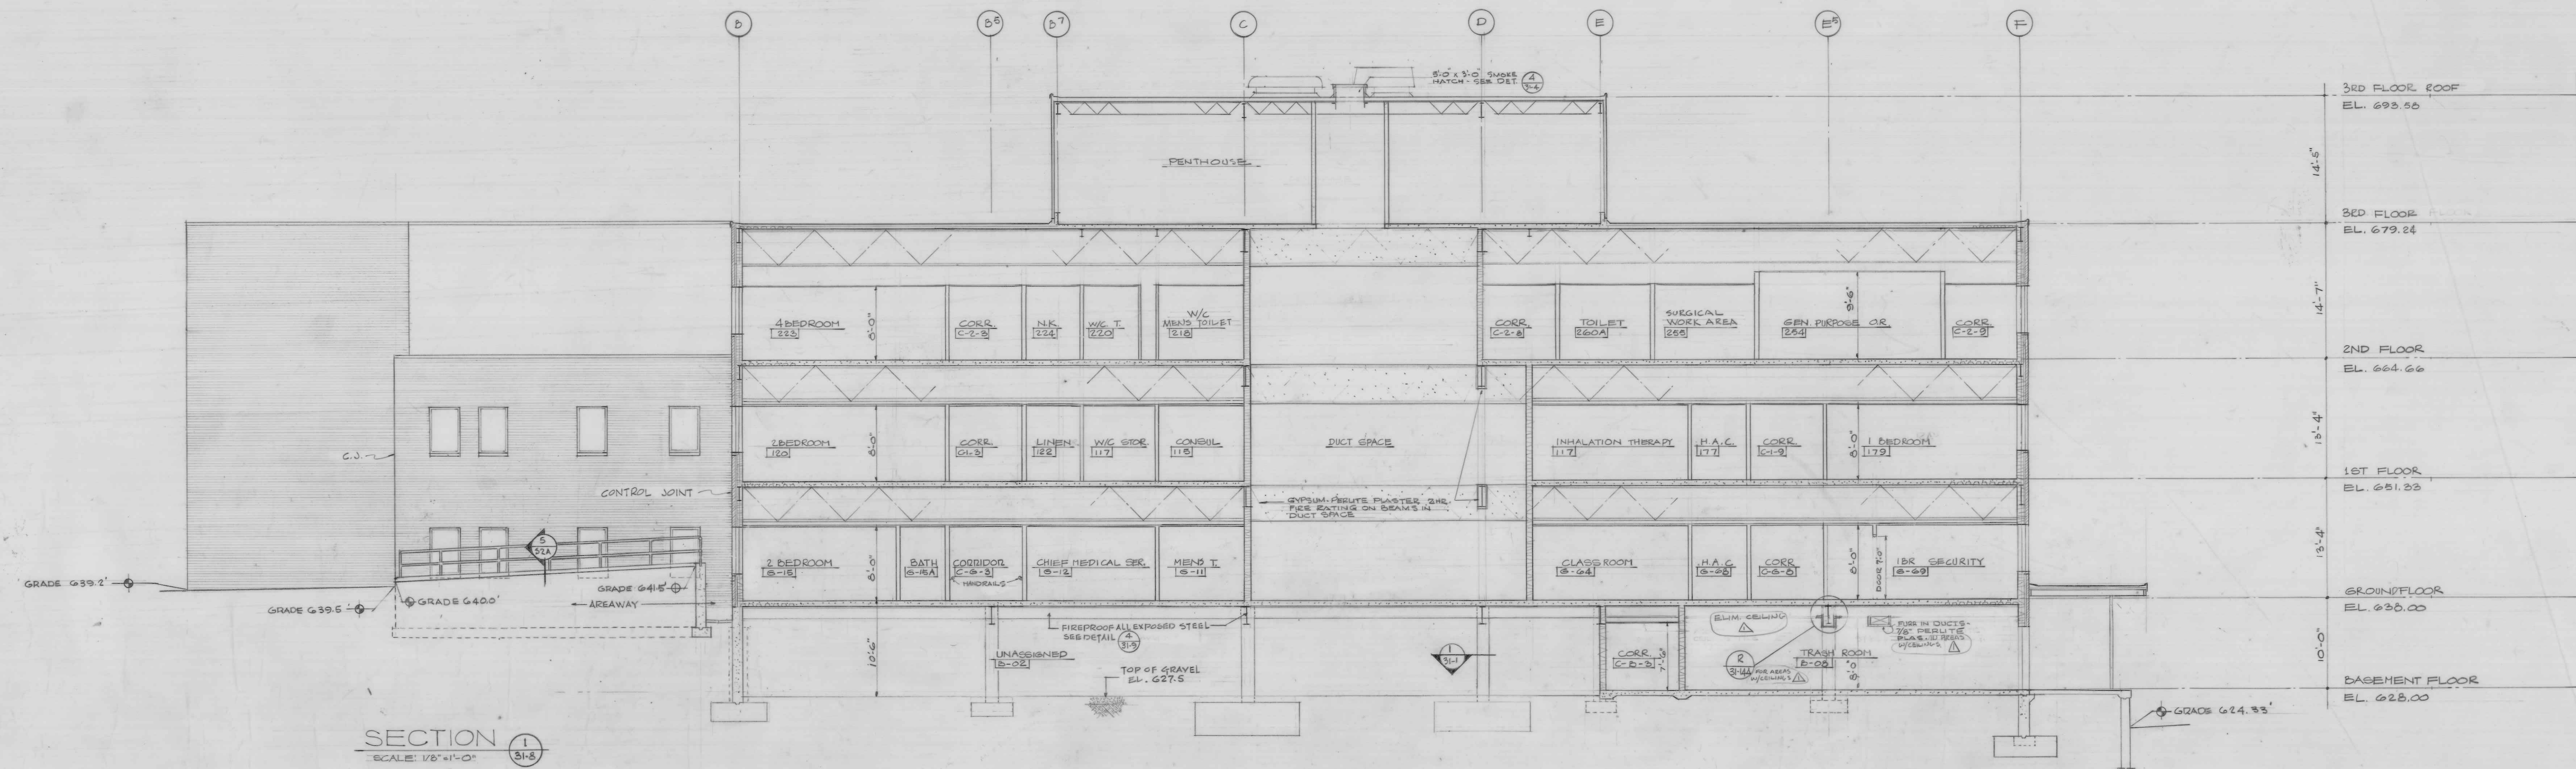

CROSS SECTIONS		BUILDING NO. 31	
NEW 204 BED HOSPITAL BUILDING			
VETERANS ADMINISTRATION WHITE RIVER JUNCTION, VERMONT			
Drawn: K.T.	Proj. Mgr: S.M.B.	REVISIONS	
Checked: R.C. 4.3.15	Date: Oct. 27, 71	No.	Date
BELLANTE CLAUSSE MILLER & NOLAN		Description	
ARCHITECTS ENGINEERS PLANNERS		AS-BUILT	
130 NORTH WASHINGTON AVE. SCRANTON, PA.		DRAWING NUMBER	
		31-8	
		Sheet 8 of 22	
		Proj. No. 44-5083	



ONE EIGHTH INCH EQUALS ONE FOOT  
2 4 6 8 10 12 14 16 18 20 22 24 26 28 30 32 34

RETURN TO ARCHITECTS TRACINGS TO PLAN LIBRARY