



6-1-1-1535

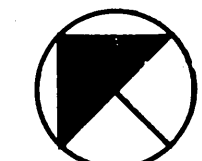

DEPARTMENTS SHOWN THIS DRAWING ARE: SPD AND BIO-MEDICAL ENGINEERING 6-1-1-1535

RECORD DRAWING
DATE: JUN 6 1984

NOTES: 1. FOR LARGE SCALE AND EQUIPMENT PLANS OF SPD AND FOR ALTERNATIVE TO SEE DWG. NO. 3-64.
2. FOR LARGE SCALE PLAN OF STAIRS SEE DWG. NO. 3-49
3. FOR LARGE SCALE PLAN OF ELEVATOR SEE DWG. NO. 3-52
4. ALL LOUVER DIMENSIONS SHOWN ARE NOMINAL - VERIFY
5. THIS AREA FLOOR SLABS DEPRESSSED 1 3/4" FOR AUTOMATIC CART WASH.
6. FOR ADDITIONAL EXTERIOR DIMENSIONS SEE DWG. NOS. 3-4 AND 3-7.
7. FOR LARGE SCALE PLAN OF DUMBWAITERS SEE DWG. NO. 3-55.
8. FOR INTERIOR PARTITION TYPES SEE DWG. NO. 3-44.

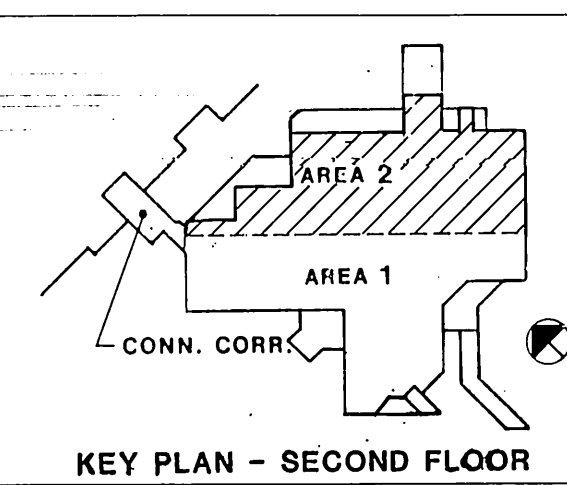

ARCHITECTS PLUS
THE HATHORN TYSON WARRINGTON GROUP
ARCHITECTURE P. O. Box 1348
200 East Pascagoula Jackson Mississippi 39205



Drawing Title
SECOND FLOOR PLAN AREA 2
SCALE 1/8" = 1'-0"
Approved Project Director
[Signature]

Project Title
CLINICAL ADDITION AND OUTPATIENT CLINIC
Building Number
3
Location
VAMC BILOXI MISSISSIPPI

Date
27 JULY 81
Project No.
520-054
DRAWING NO.
3-10
Dwg 10 of 10

Veterans Administration