

REFERENCE DRAWINGS:

LGP-1-3/8/1	TYPICAL DETAILS SHEET NO. 1
LGP-1-3/8/2	TYPICAL DETAILS SHEET NO. 2
LGP-1-3/8/3	MISC. ROOF SECTIONS
LGP-1-3/8/4	GENERATOR BAY TRANSVERSE SECT. & DETAILS
LGP-1-3/8/8	ERECTION BAY TRANSVERSE SECTION THRU PUMP
LGP-1-3/8/9	ERECTION BAY INTAKE DECK EL. 683 & 651
LGP-1-3/8/21	ERECTION BAY ROOF PLAN & TAIRLACE DECK PLAN
LGP-1-3/8/22	ERECTION BAY PLAN EL. 634 & 618
LGP-1-3/8/24	ERECTION BAY PLAN EL. 598 & 580
LGP-1-3/8/26	ERECTION BAY PLAN EL. 558
LGP-1-3/8/28	ERECTION BAY PLAN EL. 542
LGP-1-3/8/29	ERECTION BAY PLAN EL. 522 & 505
LGP-1-3/8/31	ERECTION BAY PLAN EL. 498 & 454.5
LGP-1-3/8/34	ERECTION BAY MISC. SECTIONS & DETAILS

NOTES:

- 1 - For general notes see LGP-1-3-8/1.
- 2 - See reference plan views for details of piping.
- 3 - Drainage and sanitary piping shall slope $\frac{1}{4}$ inch per foot unless otherwise shown.
- 4 - A.R.C.I. = Acid Resisting Cast Iron.
- 5 - All pipe lines crossing the expansion joint shall be as shown in detail "B" dwg. LGP-1-3-8/2 except $\frac{1}{8}$ inch gaps shall be increased as required.

C	71 JUL 14 As constructed. Minor revisions.		2411 PM
A	10 3066 Serial letter 217 ; revised vent lines		66D
A	8 2616 Deleted septic tank - added sewage disposal unit & parts.		66D
REVISION	DATE	DESCRIPTION	BY
<p align="center">U. S. ARMY ENGINEER DIVISION. N. P. PORTLAND, OREGON</p>			
DESIGNED BY: <u>III</u>	LITTLE GOOSE LOCK AND DAM		
DRAWN BY: <u>JCM</u>	SNAKE RIVER, OREGON, WASHINGTON & IDAHO		
CHECKED BY: <u>VLP</u>	POWERHOUSE		
PREPARED BY: <u>W. Carson</u>	EMBEDDED PIPING		
HEAD, TECHNICAL SECTION	ERECTION BAY		
	CROSS SECTION THRU SUMP		
SUBMITTED: <u>[Signature]</u> CRISP, HYDRO-ELECTRIC DESIGN BRANCH		APPROVED: FOR DY. ENGINEER <u>[Signature]</u> DATE: 5 DEC. 66 CHIEF, ENGINEERING DIVISION	
		SCALE AS SHOWN	SPEC. NO.
		VOL. IV	LGP-1-3-8/17
TNY. NO. CIVENS 65-164-65-10-		SHEET 38	

SHEET ID

R-002

FINAL

US Army Corps
of Engineers®

DATE

MARK

DESCRIPTION

ISSUE DATE:
AUGUST 2022
SOLICITATION NO.:
W91ZEEZ0001
CONTRACT NO.:
DESIGNED BY:
DRAWN BY:
CHECKED BY:
SUBMITTED BY:
FILENAME:
R-003.dgn



U.S. ARMY CORPS OF ENGINEERS
WALLA WALLA DISTRICT
201 NORTH 3RD AVENUE
SEATTLE, WASHINGTON

LITTLE GOOSE LOCK AND DAM
SNAKE RIVER
POWERHOUSE
DC SYSTEM AND LOW VOLTAGE SWITCHGEAR
POWERHOUSE ARRANGEMENT
ERECTION BAY
PLAN - ELS 494 & 498



SHEET ID

R-003


FINAL

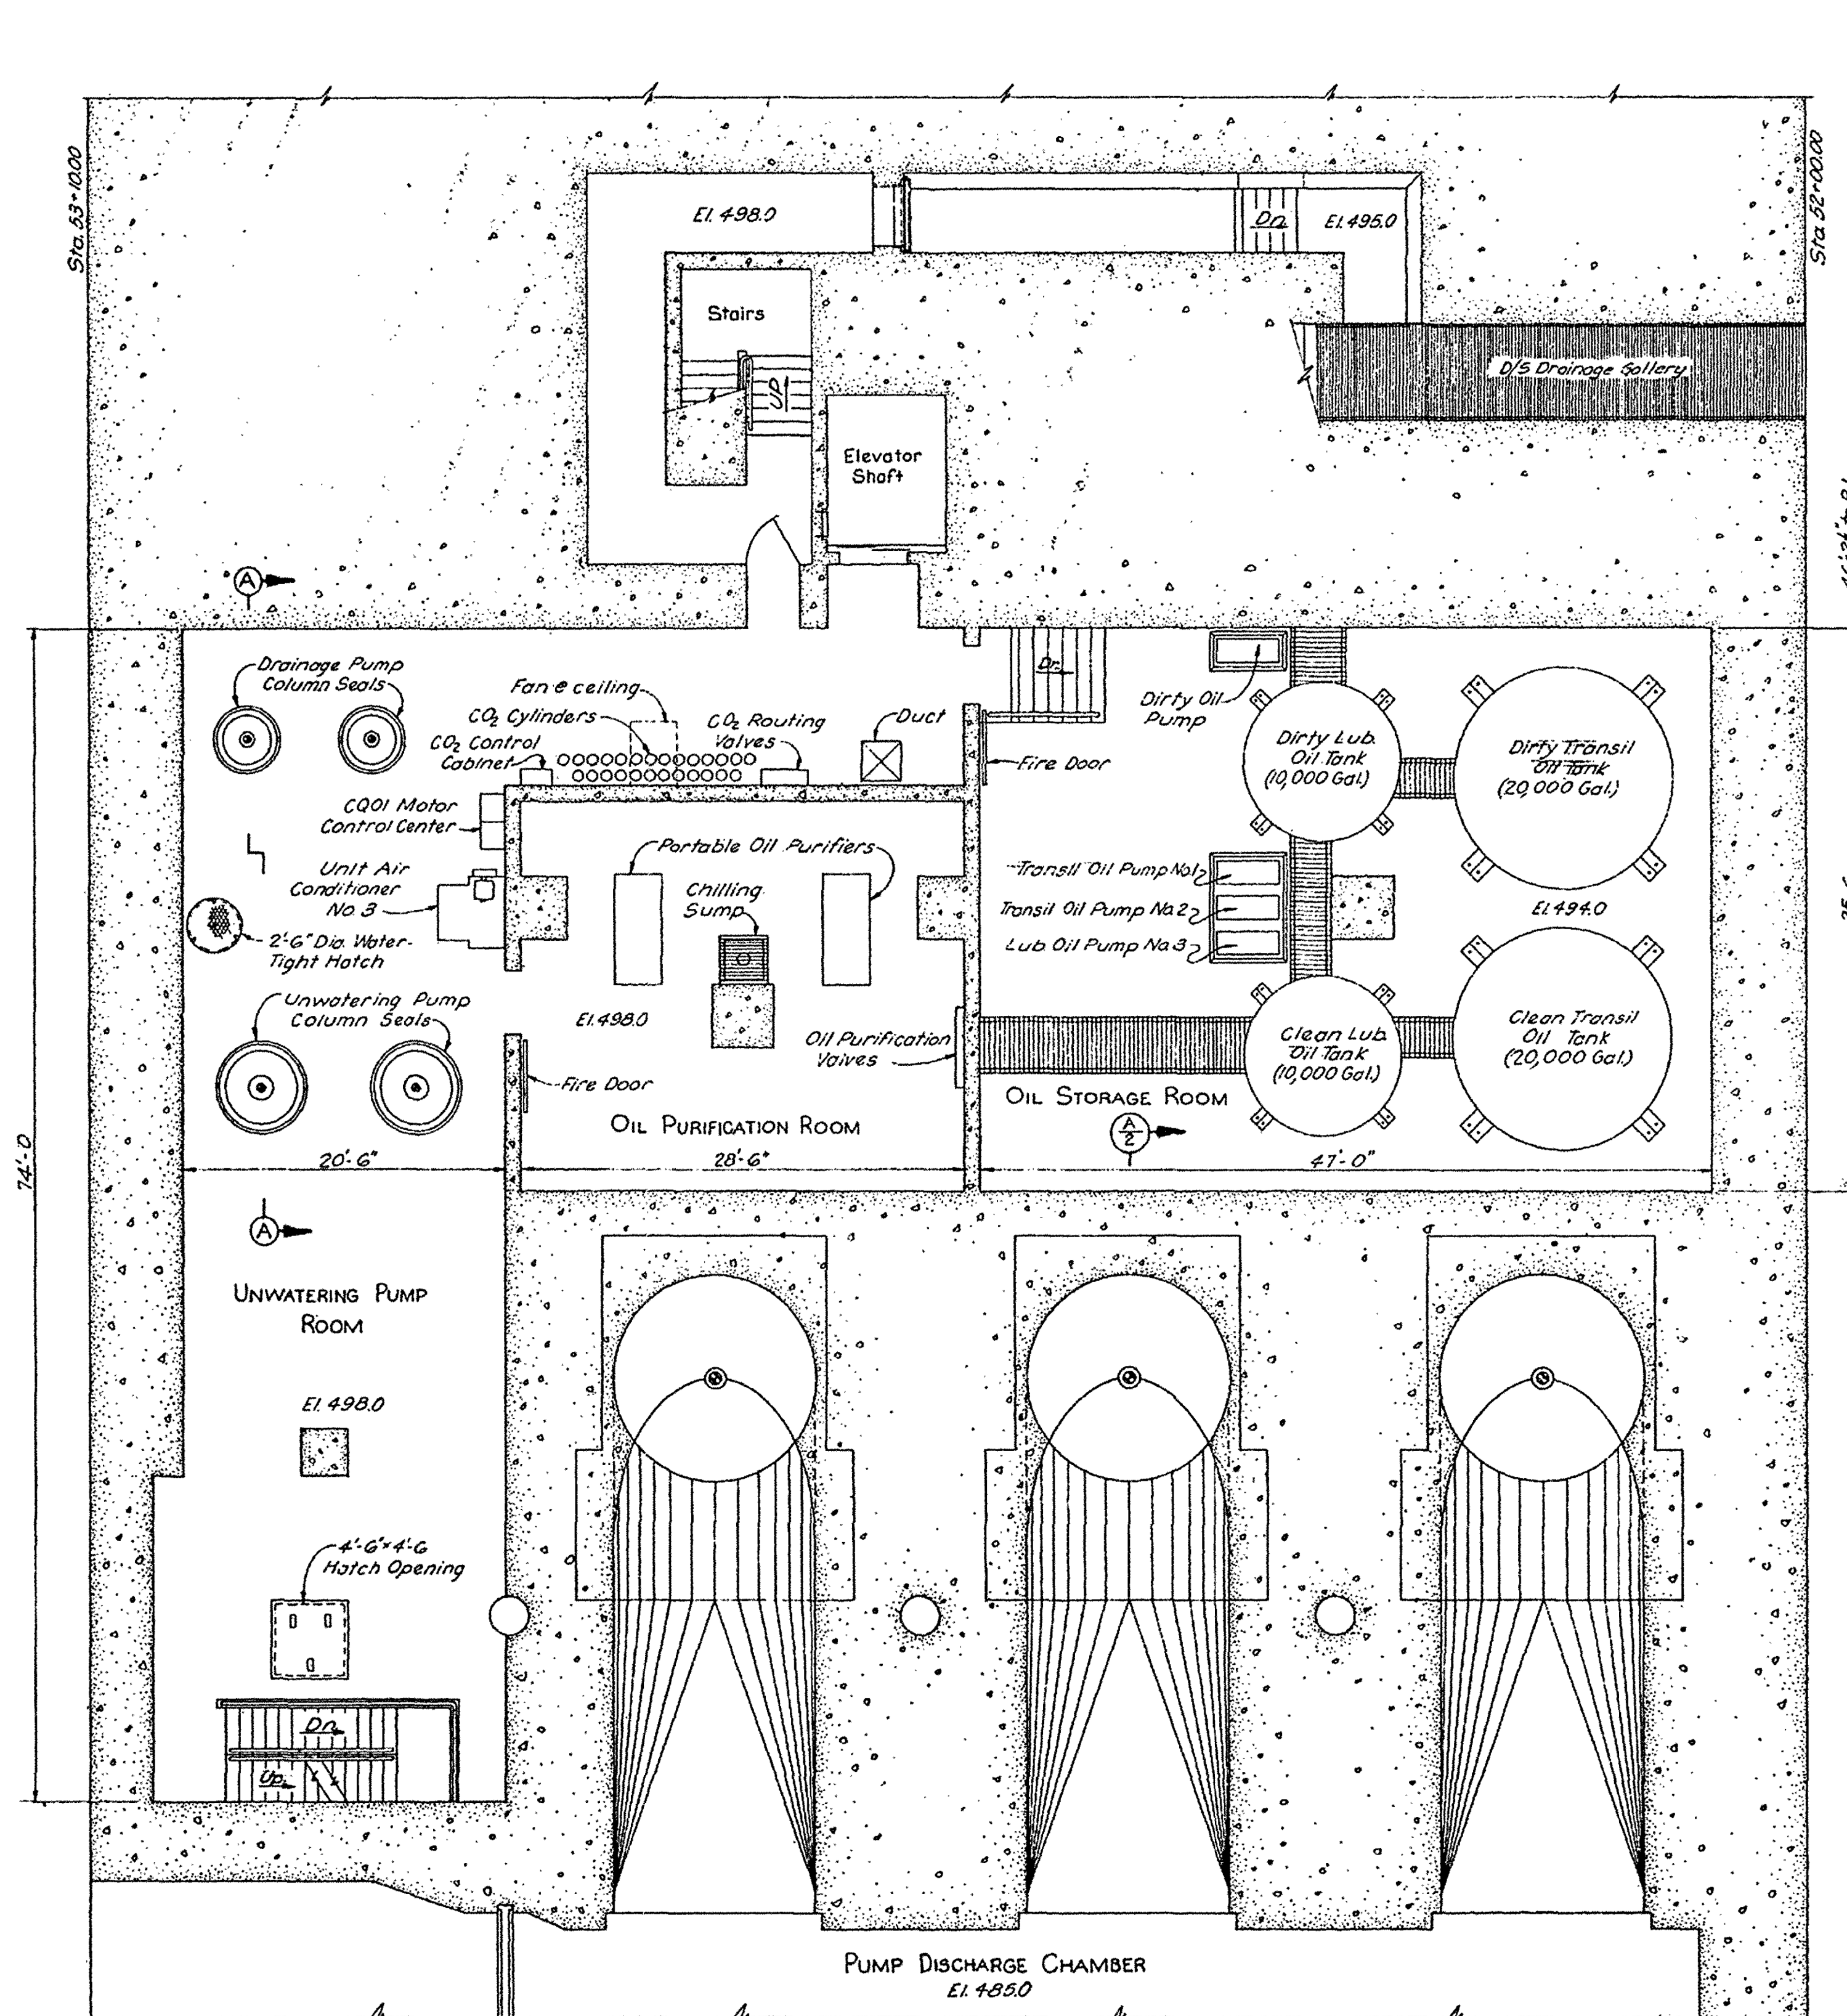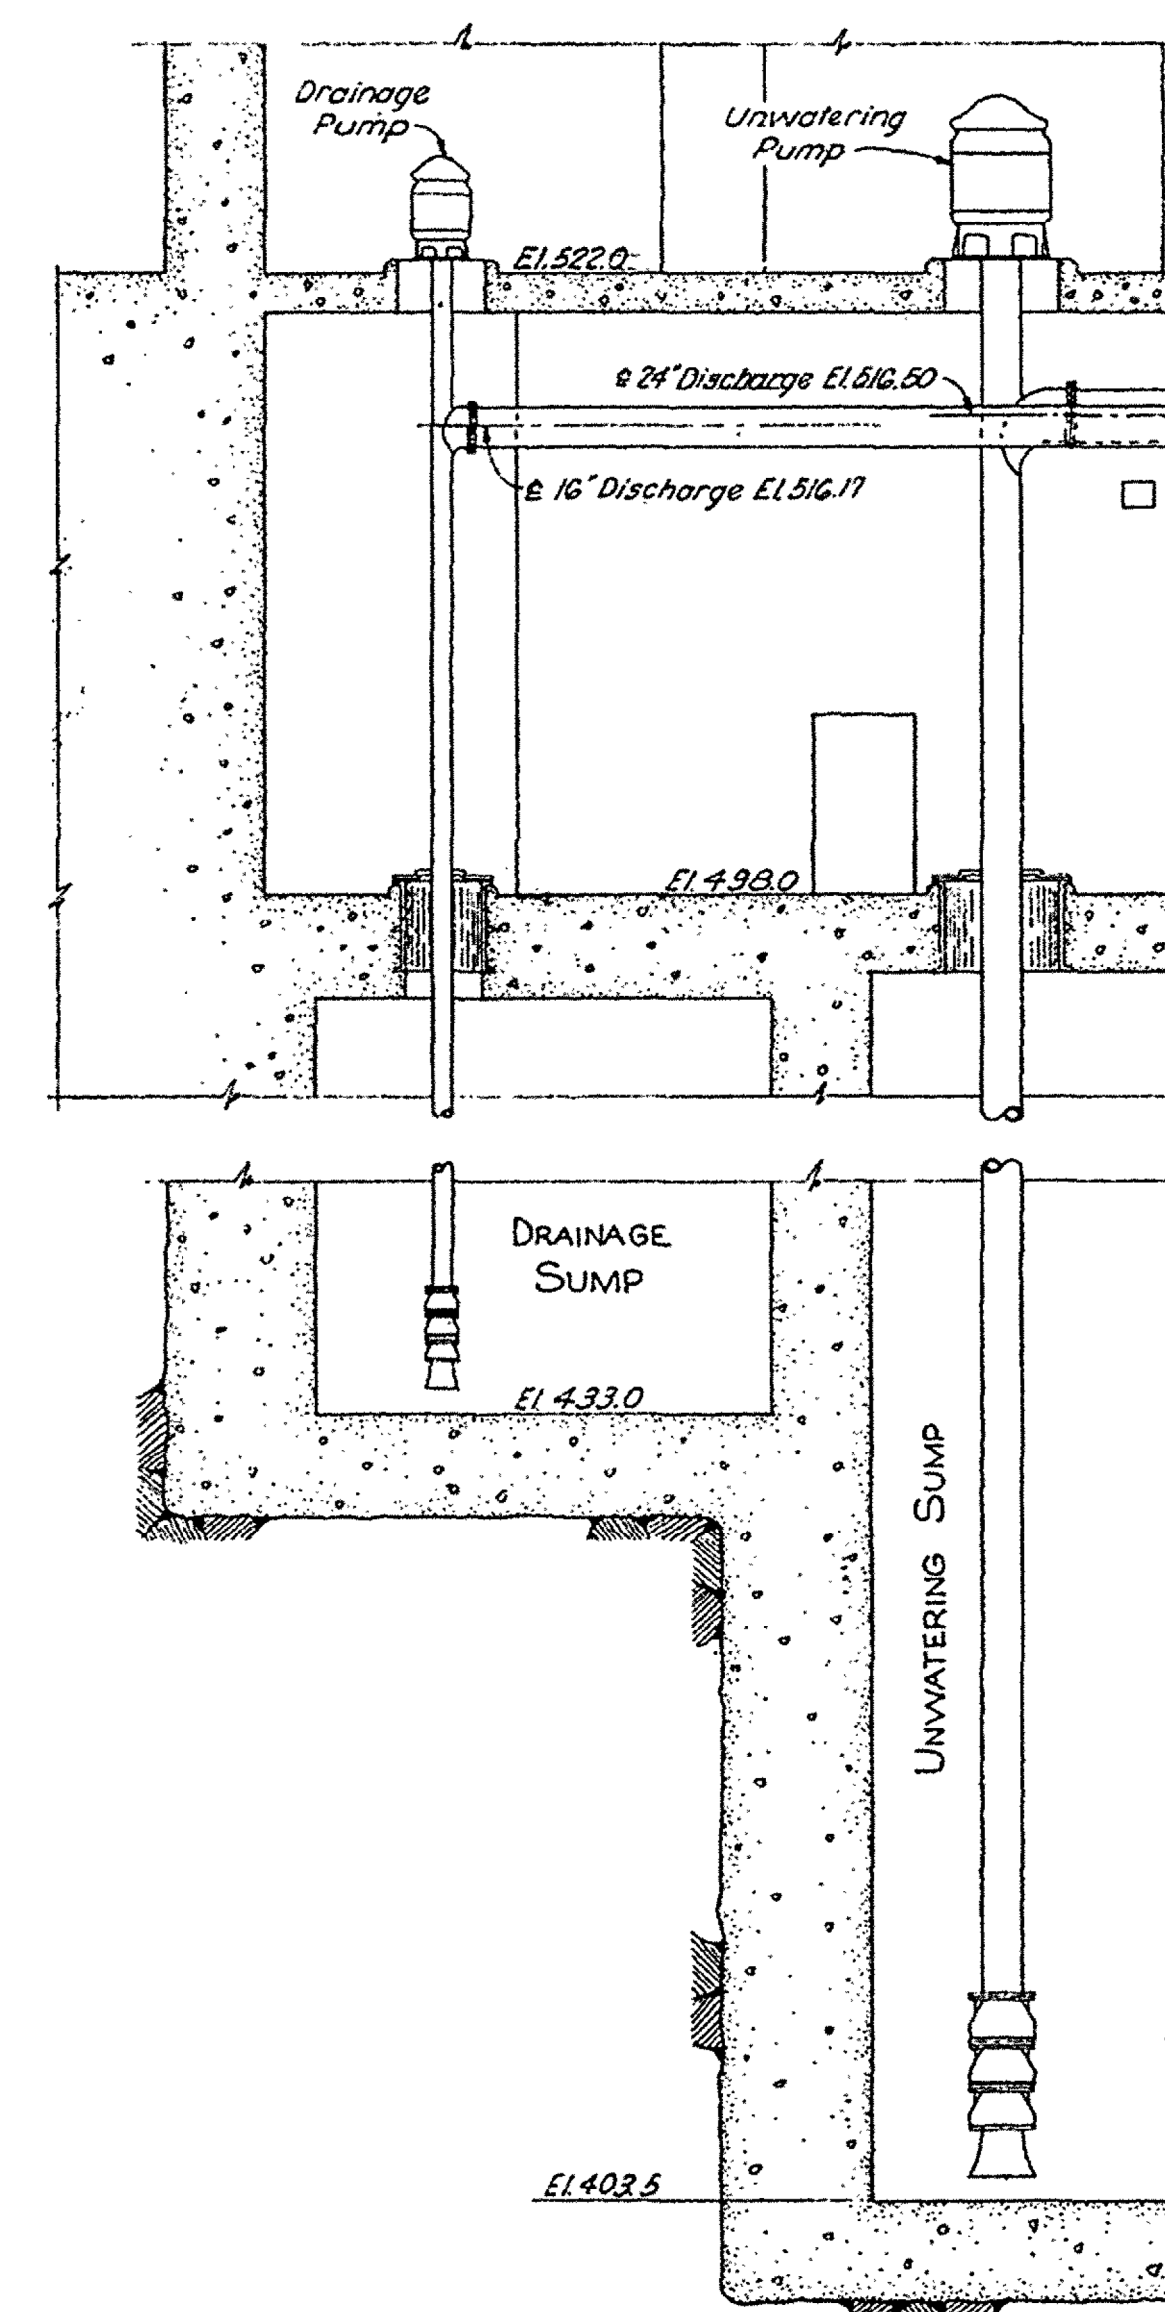PLAN
Scale: 1/8"=1'-0"REFERENCE DRAWING No. 14
FOR INFORMATION ONLYSECTION A-A
Scale: 1/8"=1'-0"THIS PRINT REDUCED
TO ONE-HALF SCALE

REVISION	DATE	DESCRIPTION	BY
U. S. ARMY ENGINEER DIVISION, N. P. PORTLAND, OREGON			
LITTLE GOOSE LOCK AND DAM SNAKE RIVER, OREGON, WASHINGTON & IDAHO POWERHOUSE ARRANGEMENT ERECTION BAY PLAN - ELS 494 & 498			
DESIGNED BY: RDB		DATE: 25 Jan 23	
DRAWN BY: PEP		APPROVED FOR CONSTRUCTION: [Signature]	
CHECKED BY: RDB		SCALE AS SHOWN	
PREPARED BY: [Signature]		SPEC. NO.	
SUBMITTED BY: [Signature]		LGP-6-0-0/8	
STANDARD: [Signature]		SHEET 14 OF 15	

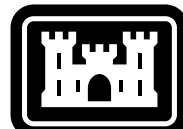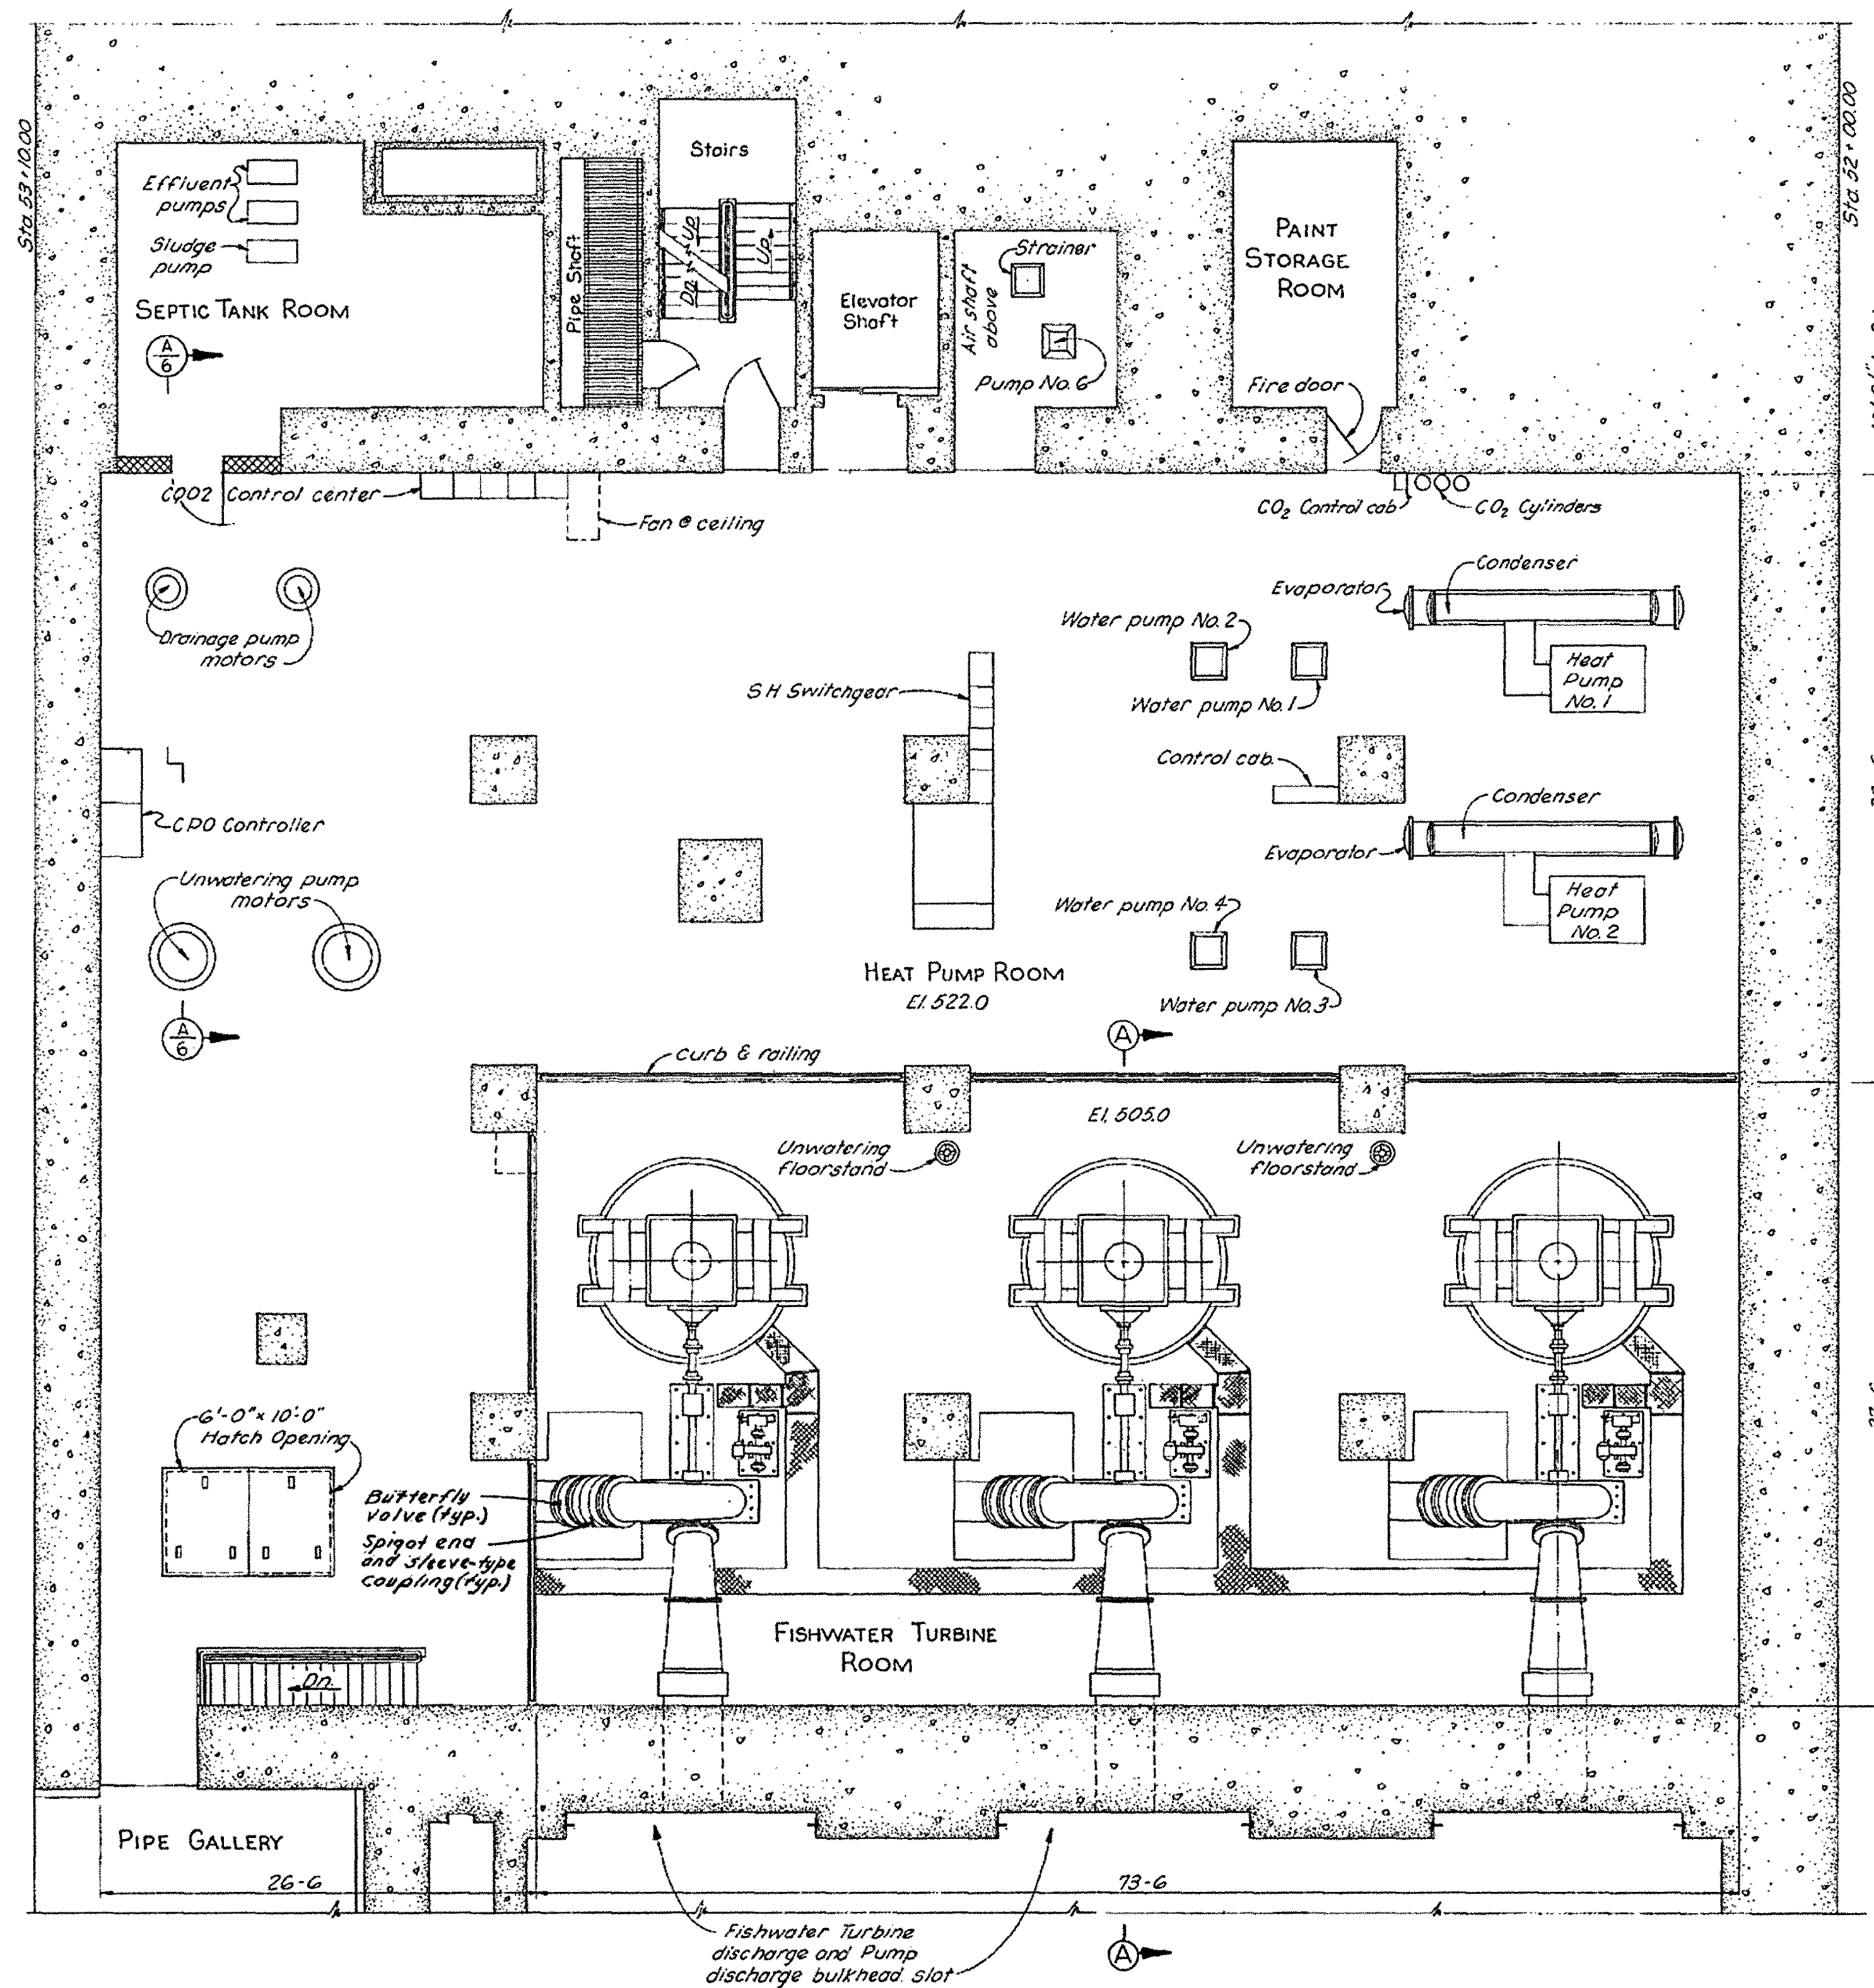US Army Corps
of Engineers®

PLAN

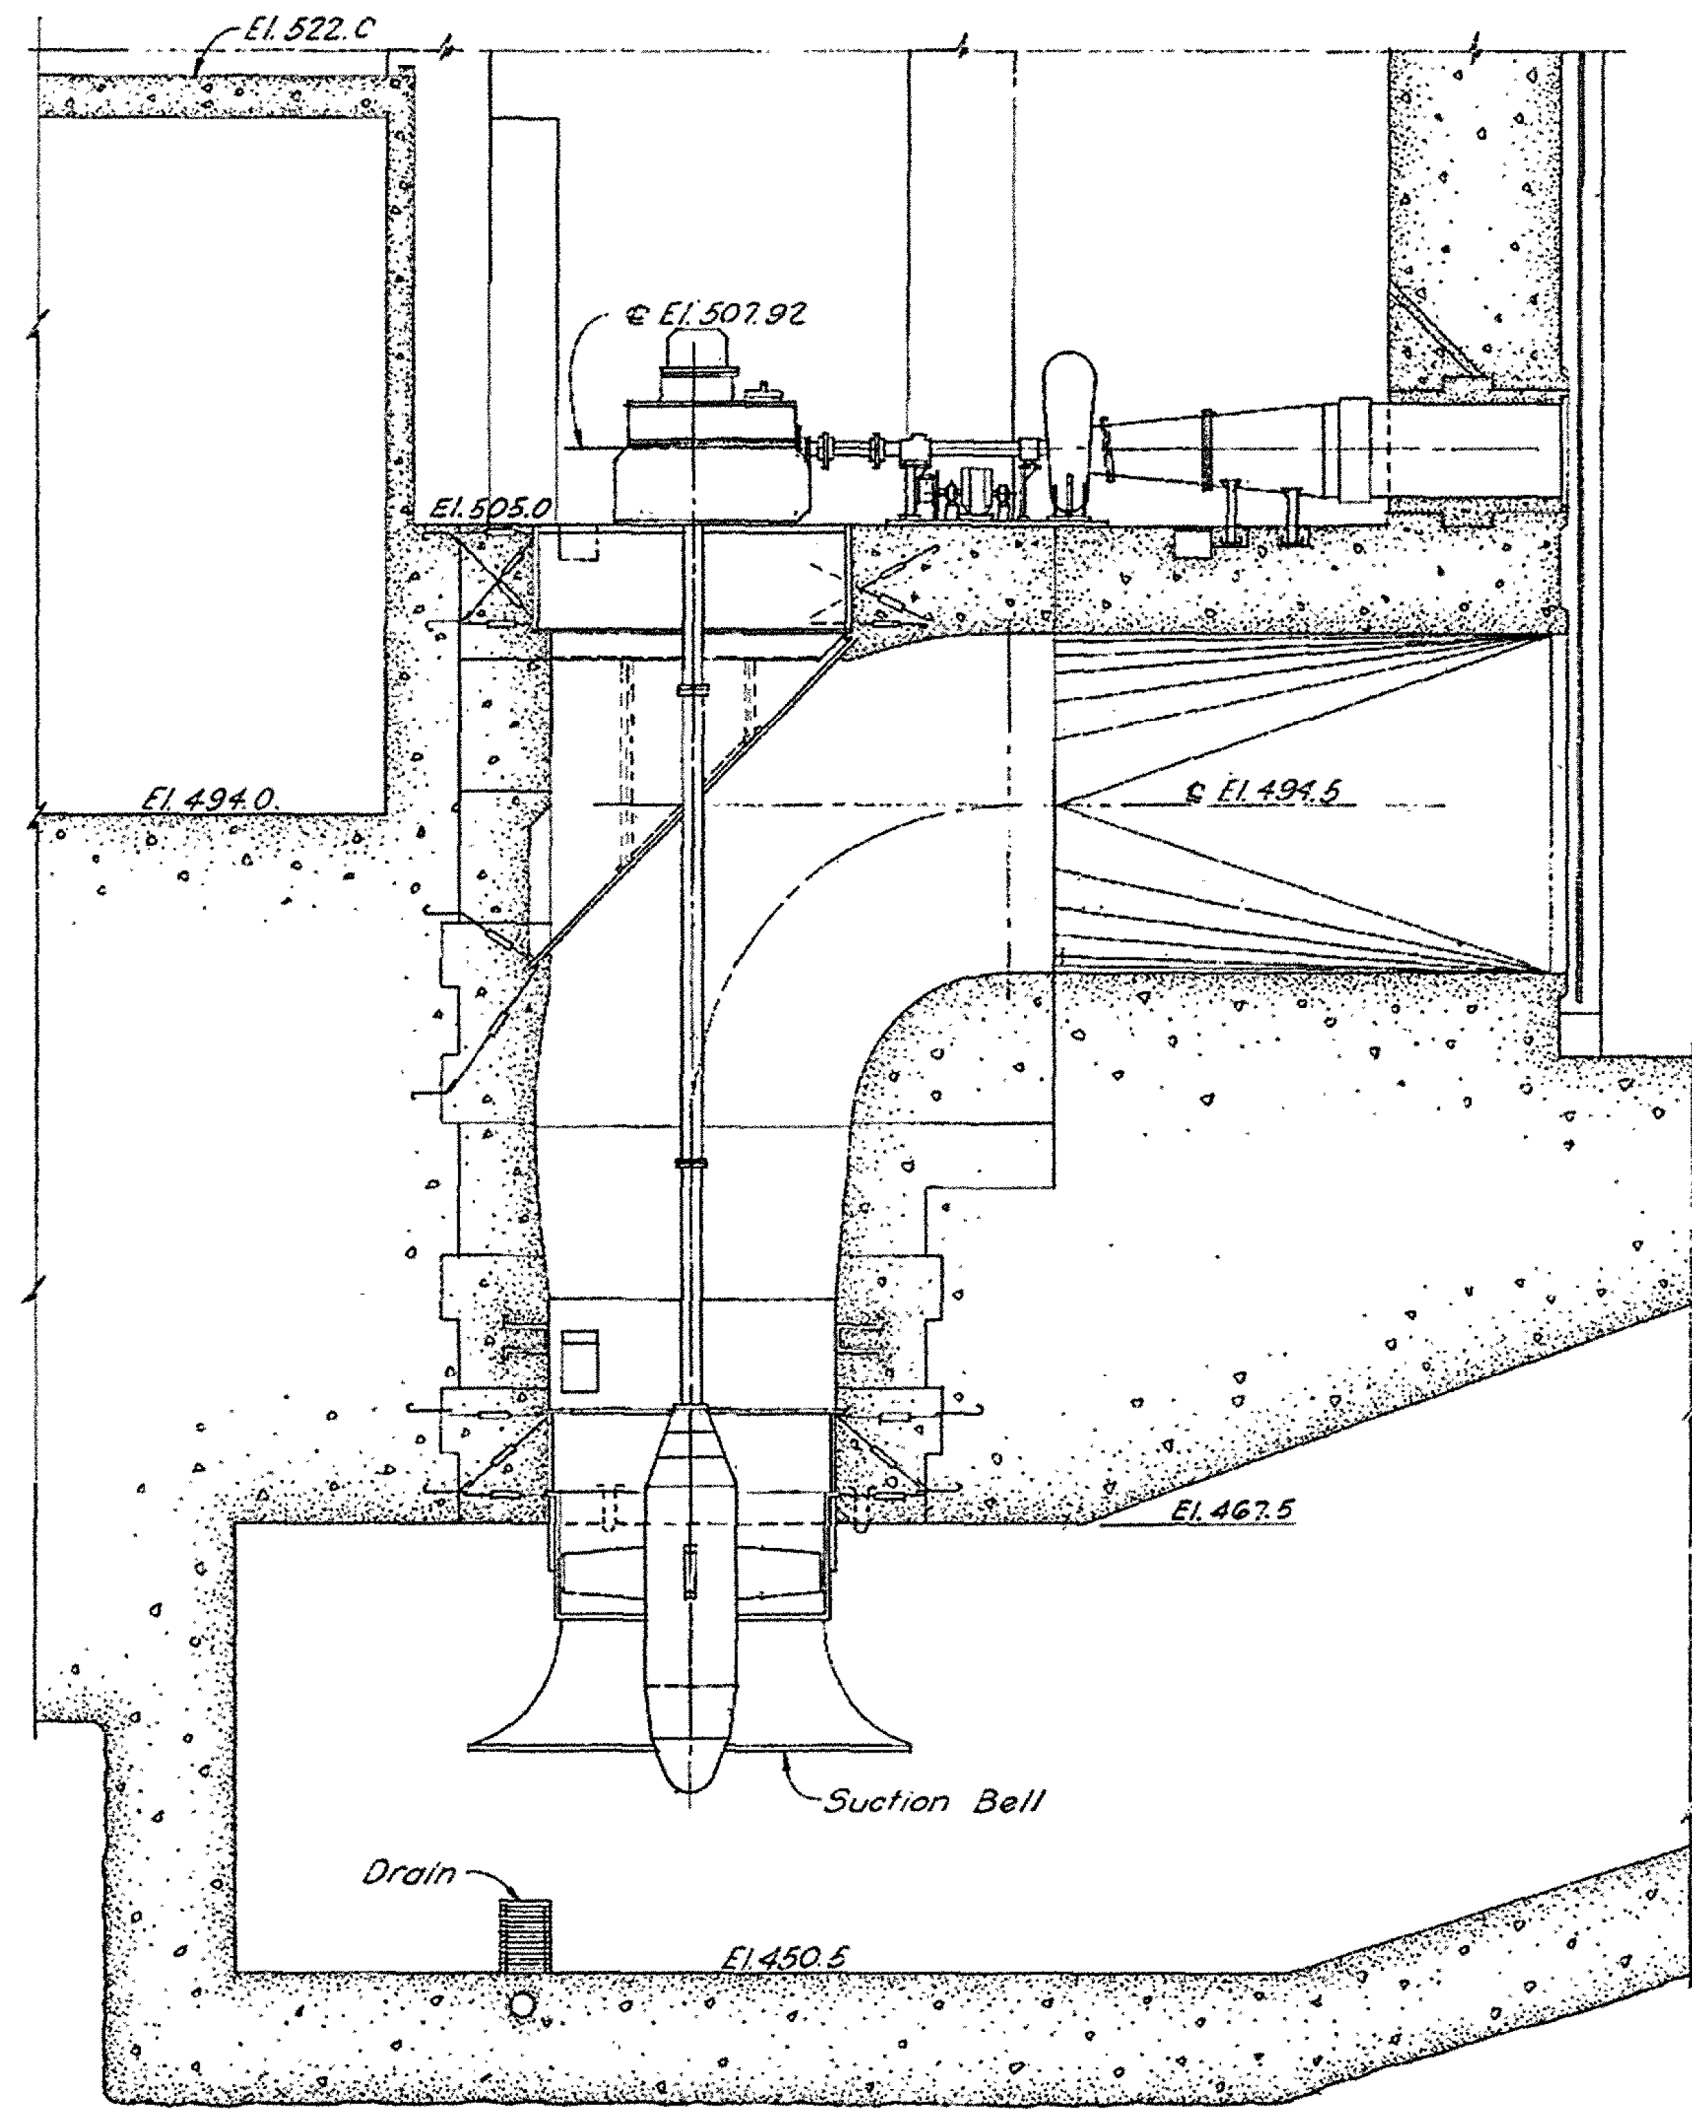

SECTION A-A

AS CONSTRUCTED
HYDRO ELECTRIC DESIGN BRANCH, NPD

DATE 1973 MAY 1

REVISION	DATE	DESCRIPTION	BY
1	31 Aug 72	As Constructed	CJM

U. S. ARMY ENGINEER DIVISION, N. P.
PORTLAND, OREGON

LITTLE GOOSE LOCK AND DAM
SNAKE RIVER, OREGON, WASHINGTON & IDAHO
POWERHOUSE
ARRANGEMENT
ERECTION BAY
PLAN - EL. 522

DESIGNED BY: RDB
DRAWN BY: PER
CHECKED BY: RDB
PREPARED BY: Paul E. Decker
HEADQUARTERS ENGINEERING DIVISION

SUBMITTED BY: J. F. Fisher
CHIEF, HYDRO-ELECTRIC DESIGN BRANCH

APPROVED FOR DIST. ENGINEER DATE 25 Apr 73
BY: [Signature]
CHIEF, HYDRO-ELECTRIC DESIGN BRANCH



SCALE: 3/16" = 1'-0"
SPEC. NO.:
LGP-6-0-0/9
SHEET 15 - VOL. 1

REFERENCE DRAWING No. 15
FOR INFORMATION ONLYISSUE DATE:
AUGUST 1972
SOLICITATION NO.:
W91ZEEZ0001
CONTRACT NO.:
DRAWING NUMBER:
FILE NAME:
R-004.dgnDESIGNED BY:
DRAWN BY:
CHECKED BY:
SUBMITTED BY:U. S. ARMY CORPS OF ENGINEERS
WALLA WALLA DISTRICT
201 NORTH 3RD AVENUE
SEATTLE, WASHINGTONLITTLE GOOSE LOCK AND DAM
SNAKE RIVER
POWERHOUSE
DC SYSTEM AND LOW VOLTAGE SWITCHGEAR
POWERHOUSE ARRANGEMENT
ERECTION BAY
PLAN - EL. 522



SHEET ID

R-004

FINAL

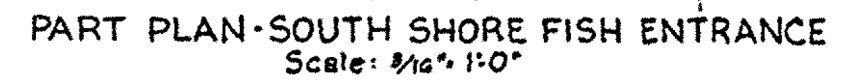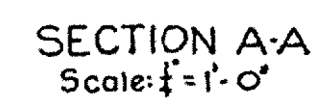

POWERHOUSE ARRANGEMENT
ARRANGEMENT - ERECTION BAY
PLAN - EL. 558

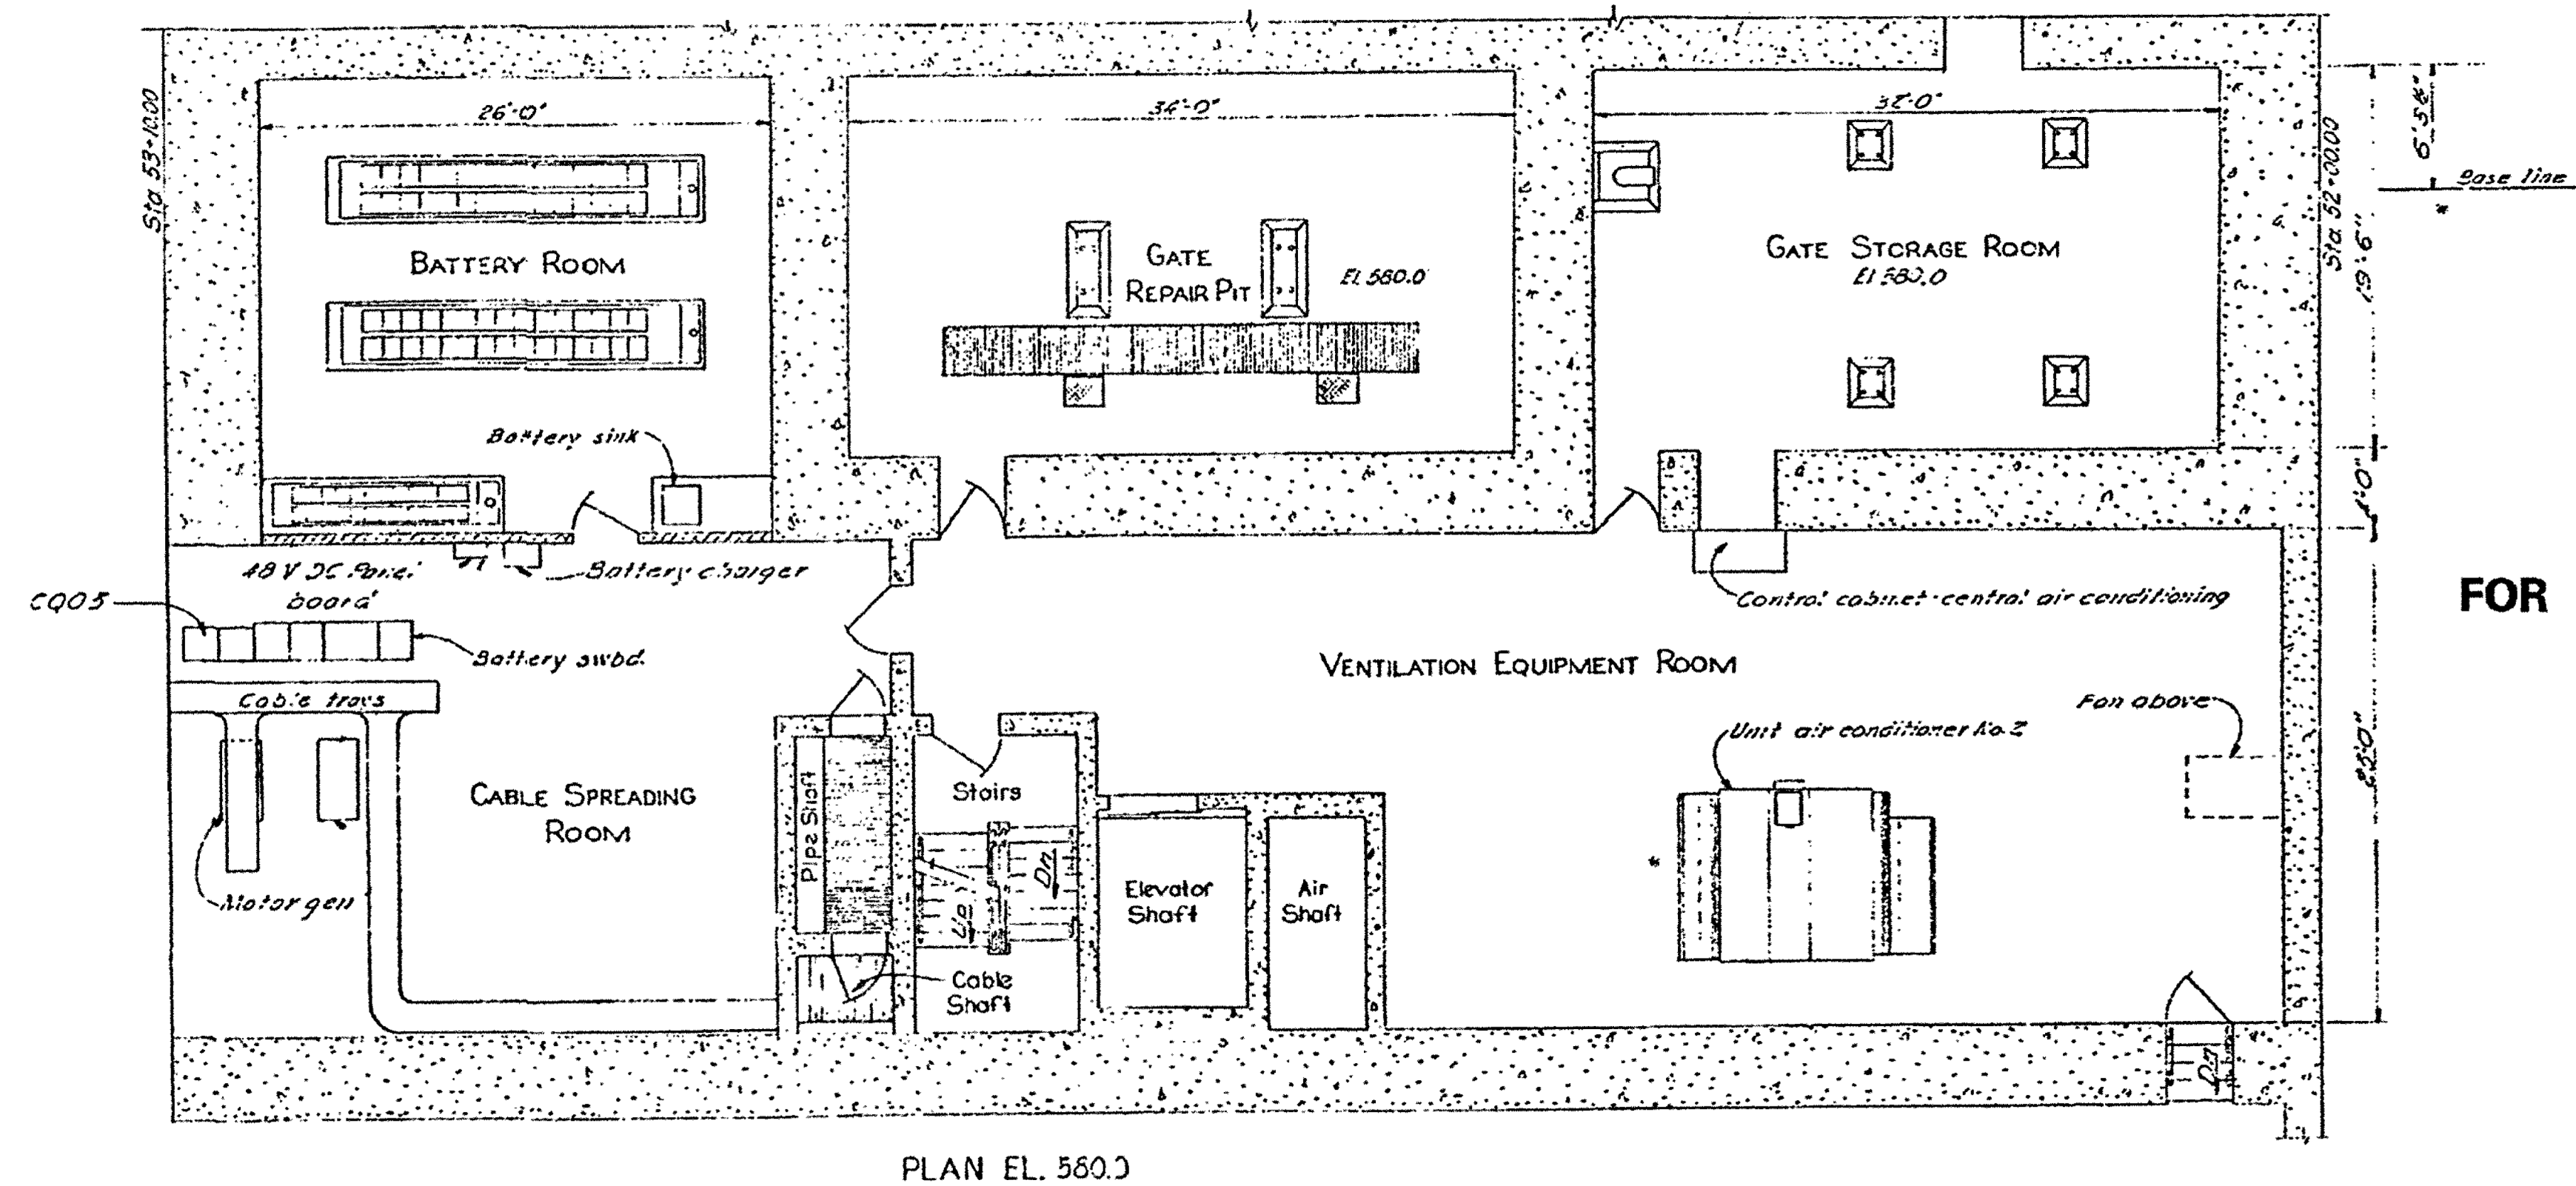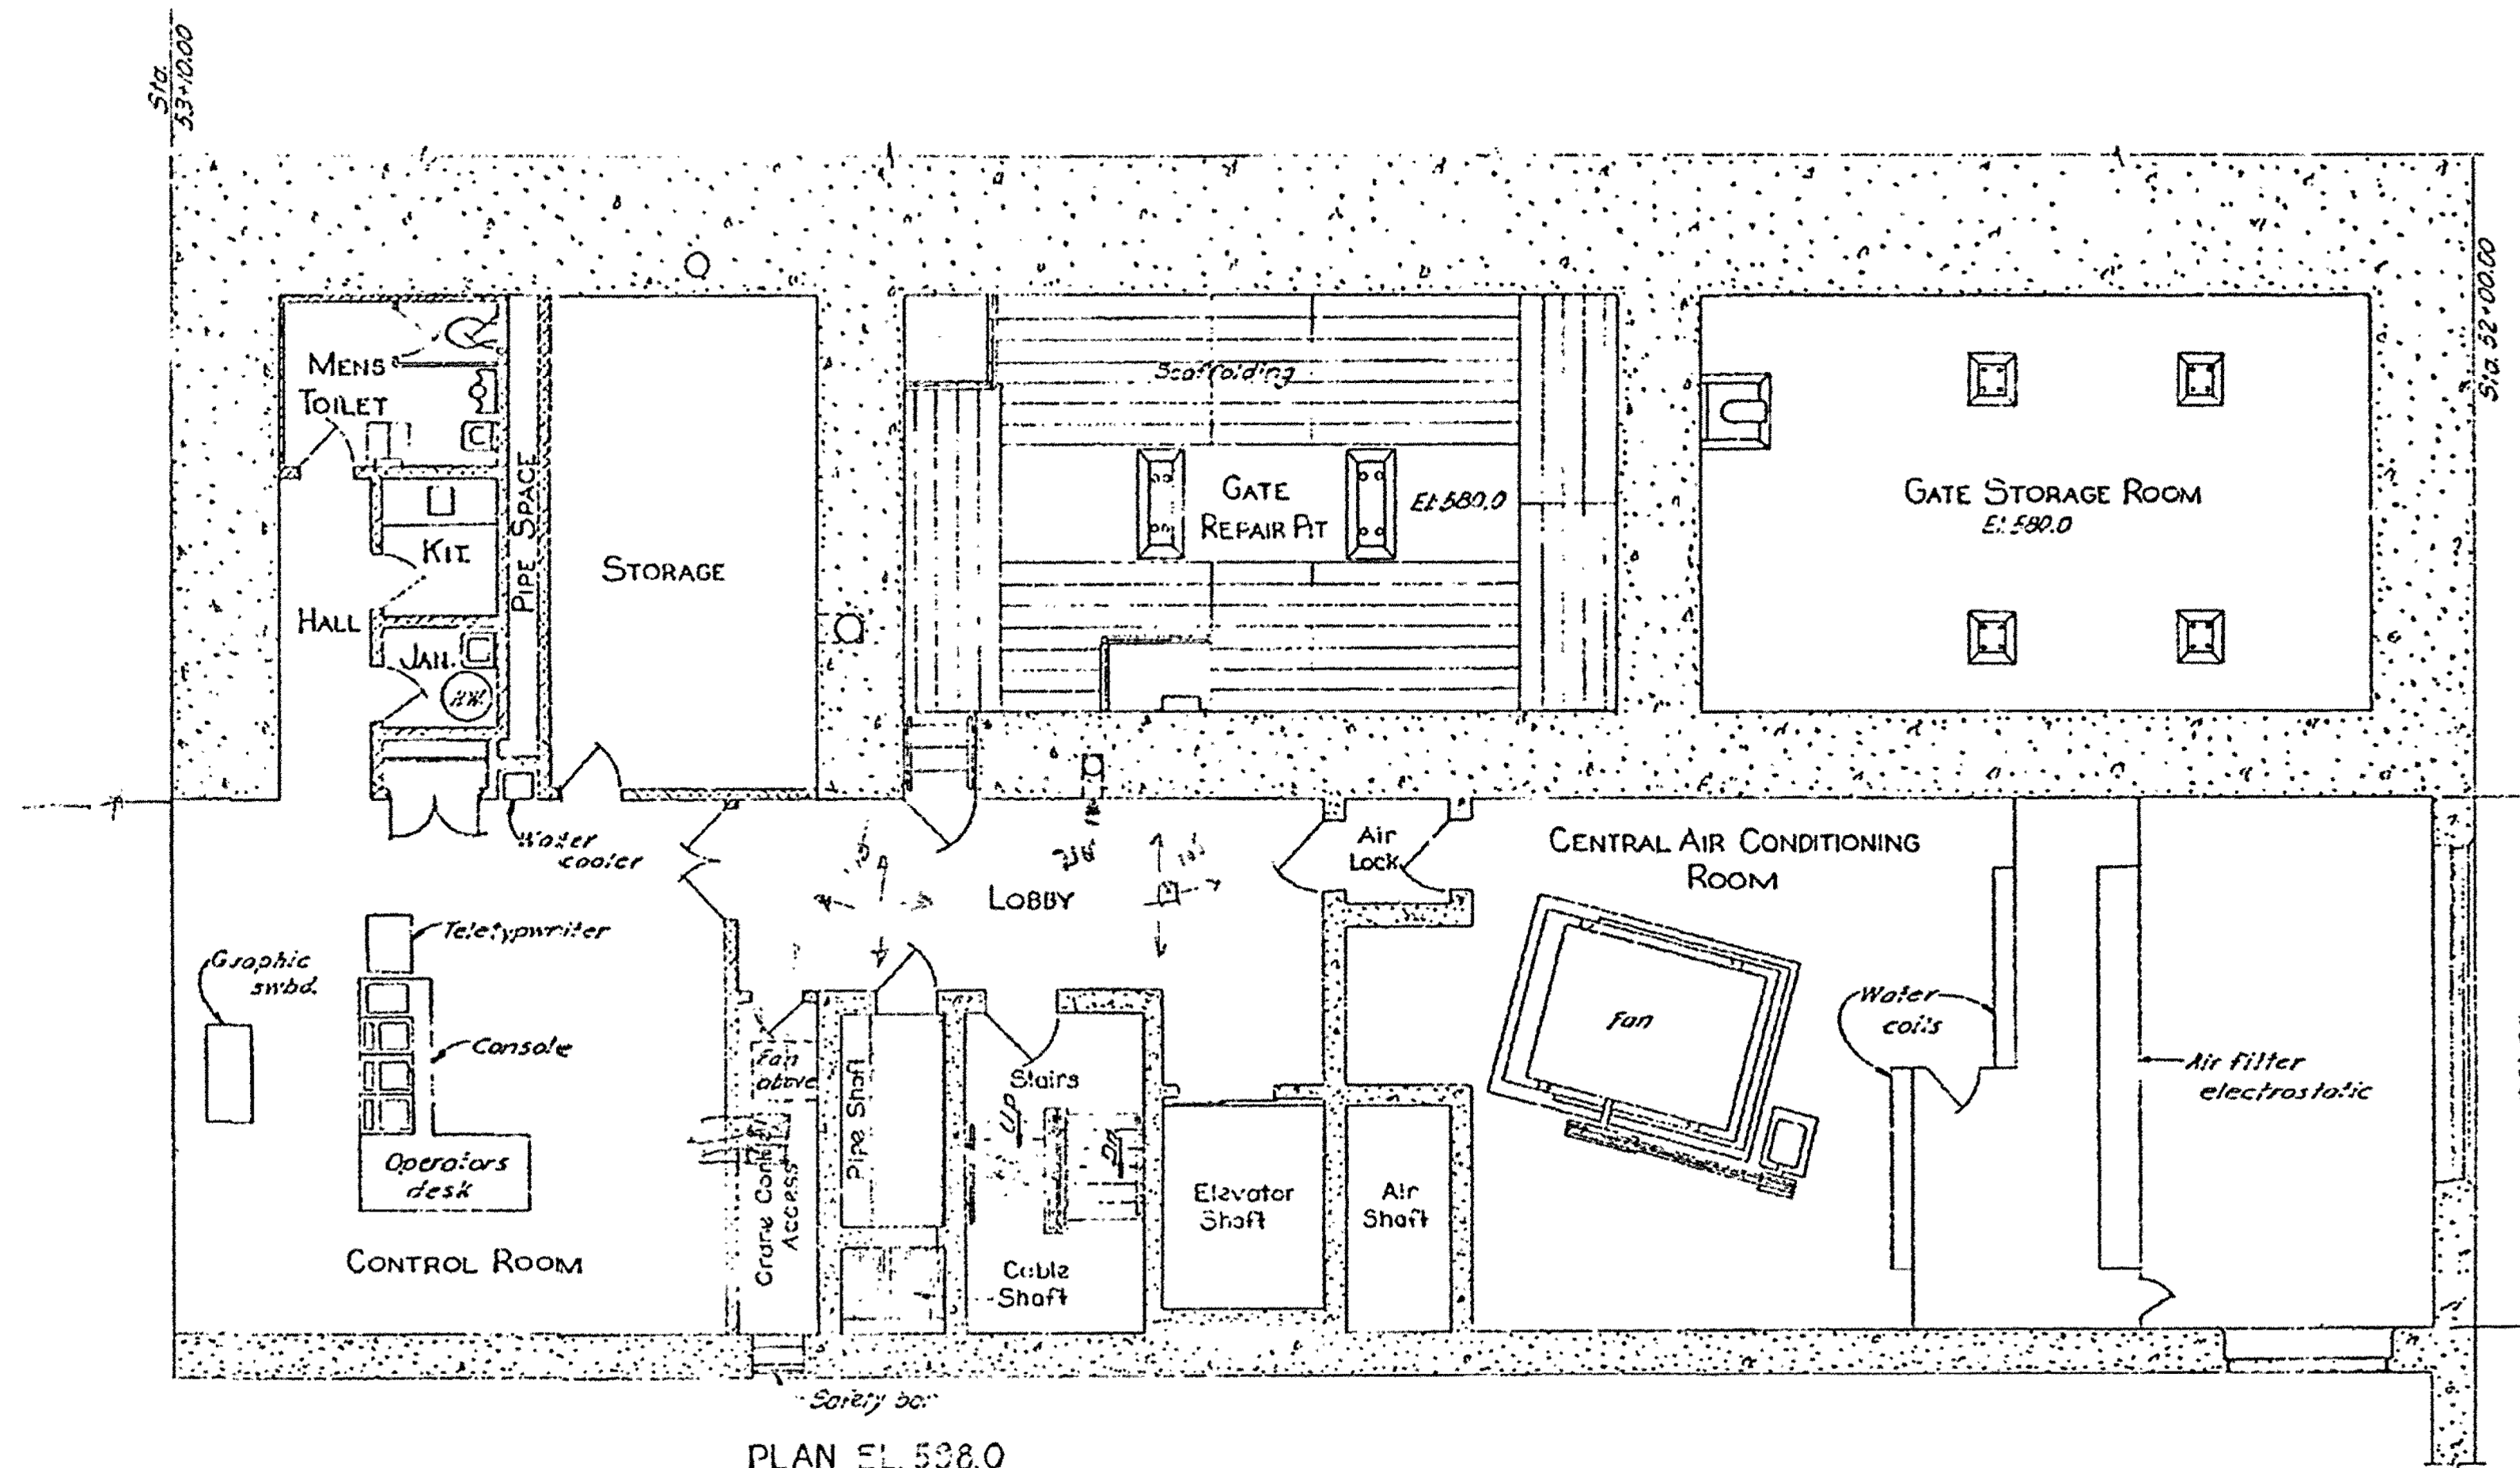

FOR INFORMATION ONLY AS CONSTRUCTED

HYDRO ELECTRIC DESIGN BRANCH, NPD

DATE: 11-1-68 Col. McLean

1		31 MAR 72		As Constructed		CJM	
REVISION	DATE	DESCRIPTION				BY	
<p align="center">U. S. ARMY ENGINEER DIVISION. N. P. PORTLAND, OREGON</p>							
DESIGNED BY <i>RDB</i>		LITTLE GOOSE LOCK AND DAM					
DRAWN BY <i>AP</i>		SNAKE RIVER, OREGON, WASHINGTON & IDAHO					
CHECKED BY <i>RDB</i>		POWERHOUSE ARRANGEMENT					
PREPARED BY <i>AP</i>		ERRECTION BAY					
SCALE: 1" = 10' (SEE DRAWING)		PLAN GALLERY - EL'S 580 & 598					
SUBMITTED <i>LT J. L. L...</i>		APPROVED FOR BY: <i>W. H. L...</i>		DATE: <i>25 APR 72</i>			
CRAZY, HYDRO-ELECTRIC DESIGN DIVISION		SCALE: <i>1" = 10'</i>		SPEC. NO.			
-BUN-NO-BAGNO-NO-DESS-		424		LGP-6-0-0/12			

[illegible]

U.S. ARMY CORPS OF ENGINEERS ATTENTION: DISTRICT ENGINEER 201 NORTH AVENUE SEATTLE, WASHINGTON	DRAWN BY: _____ CHECKED BY: _____ SUBMITTED BY: _____ SIZE: _____ FILENAME: 63027-4801	SOLICITATION NO.: _____ M912EE2F00001 CONTRACT NO.: _____ DRAWING NUMBER: _____	RELEASED BY: _____ DATE: _____ AUGUST 2022
---------------------------------------------------------------------------------------------------------	----------------------------------------------------------------------------------------------------	------------------------------------------------------------------------------------------	--------------------------------------------------

LITTLE GOOSE LOCK AND DAM
 SNAKE RIVER
 POWERHOUSE
 DC SYSTEM AND LOW VOLTAGE SWITCHGEAR
 POWERHOUSE
 ARRANGEMENT - ERECTION BAY
 PLAN GALLERY - EL'S 580 & 598

SHEET ID
R-007

[illegible]

U.S. ARMY CORPS OF ENGINEERS WALLA WALLA DISTRICT ENGINEERING CENTER SEATTLE, WASHINGTON	DESIGNED BY:	ISSUE DATE: AUGUST 2022
	DRAWN BY:	SOLICITATION NO.: W912EF22R0001
	CHECKED BY:	CONTRACT NO.:
	SUBMITTED BY:	DRAWING NUMBER:
SIZE:		FILENAME:

LITTLE GOOSE LOCK AND DAM
SNAKE RIVER
POWERHOUSE
DC SYSTEM AND LOW VOLTAGE SWITCHGEAR

POWERHOUSE
ARRANGEMENT - ERECTION BAY
PLAN GALLIERY - F1'S 618 & 634

SHEET ID

R-008


FINAL




THIS PRINT REDUCED
TO ONE-HALF SCALE

REVISION	DATE	DESCRIPTION	
<p align="center">U. S. ARMY ENGINEER DIVISION. N. P. PORTLAND, OREGON</p>			
<p>DESIGNED BY: <i>ROB</i></p>			
<p>DRAWN BY: <i>PER</i></p>			
<p>CHECKED BY: <i>ROB</i></p>			
<p>PREPARED BY: <i>Paula Deane</i> SEALING INFORMATION</p>			
<p align="center">LITTLE GOOSE LOCK AND DAM SNAKE RIVER, OREGON, WASHINGTON & IDAHO POWERHOUSE ARRANGEMENT ERECTION BAY PLAN GALLERY - EL'S 618 & 630</p>			
<p>SUBMITTED BY: <i>Paula Deane</i></p>		<p>APPROVED FOR: <i>W. J. Deane</i> DATE: <i>2-2-60</i></p>	
<p>CHART, HYDRO, ELEVATION, GEOMETRY</p>		<p>SCALE: 1" = 1'-0" SPEC. NO. _____</p>	
<p align="center">-BN-16-DWG-55-02-B-0000-</p>		<p align="center">LGP-6-0-0/13</p>	

REFERENCE DRAWING No. 19
FOR INFORMATION ONLY

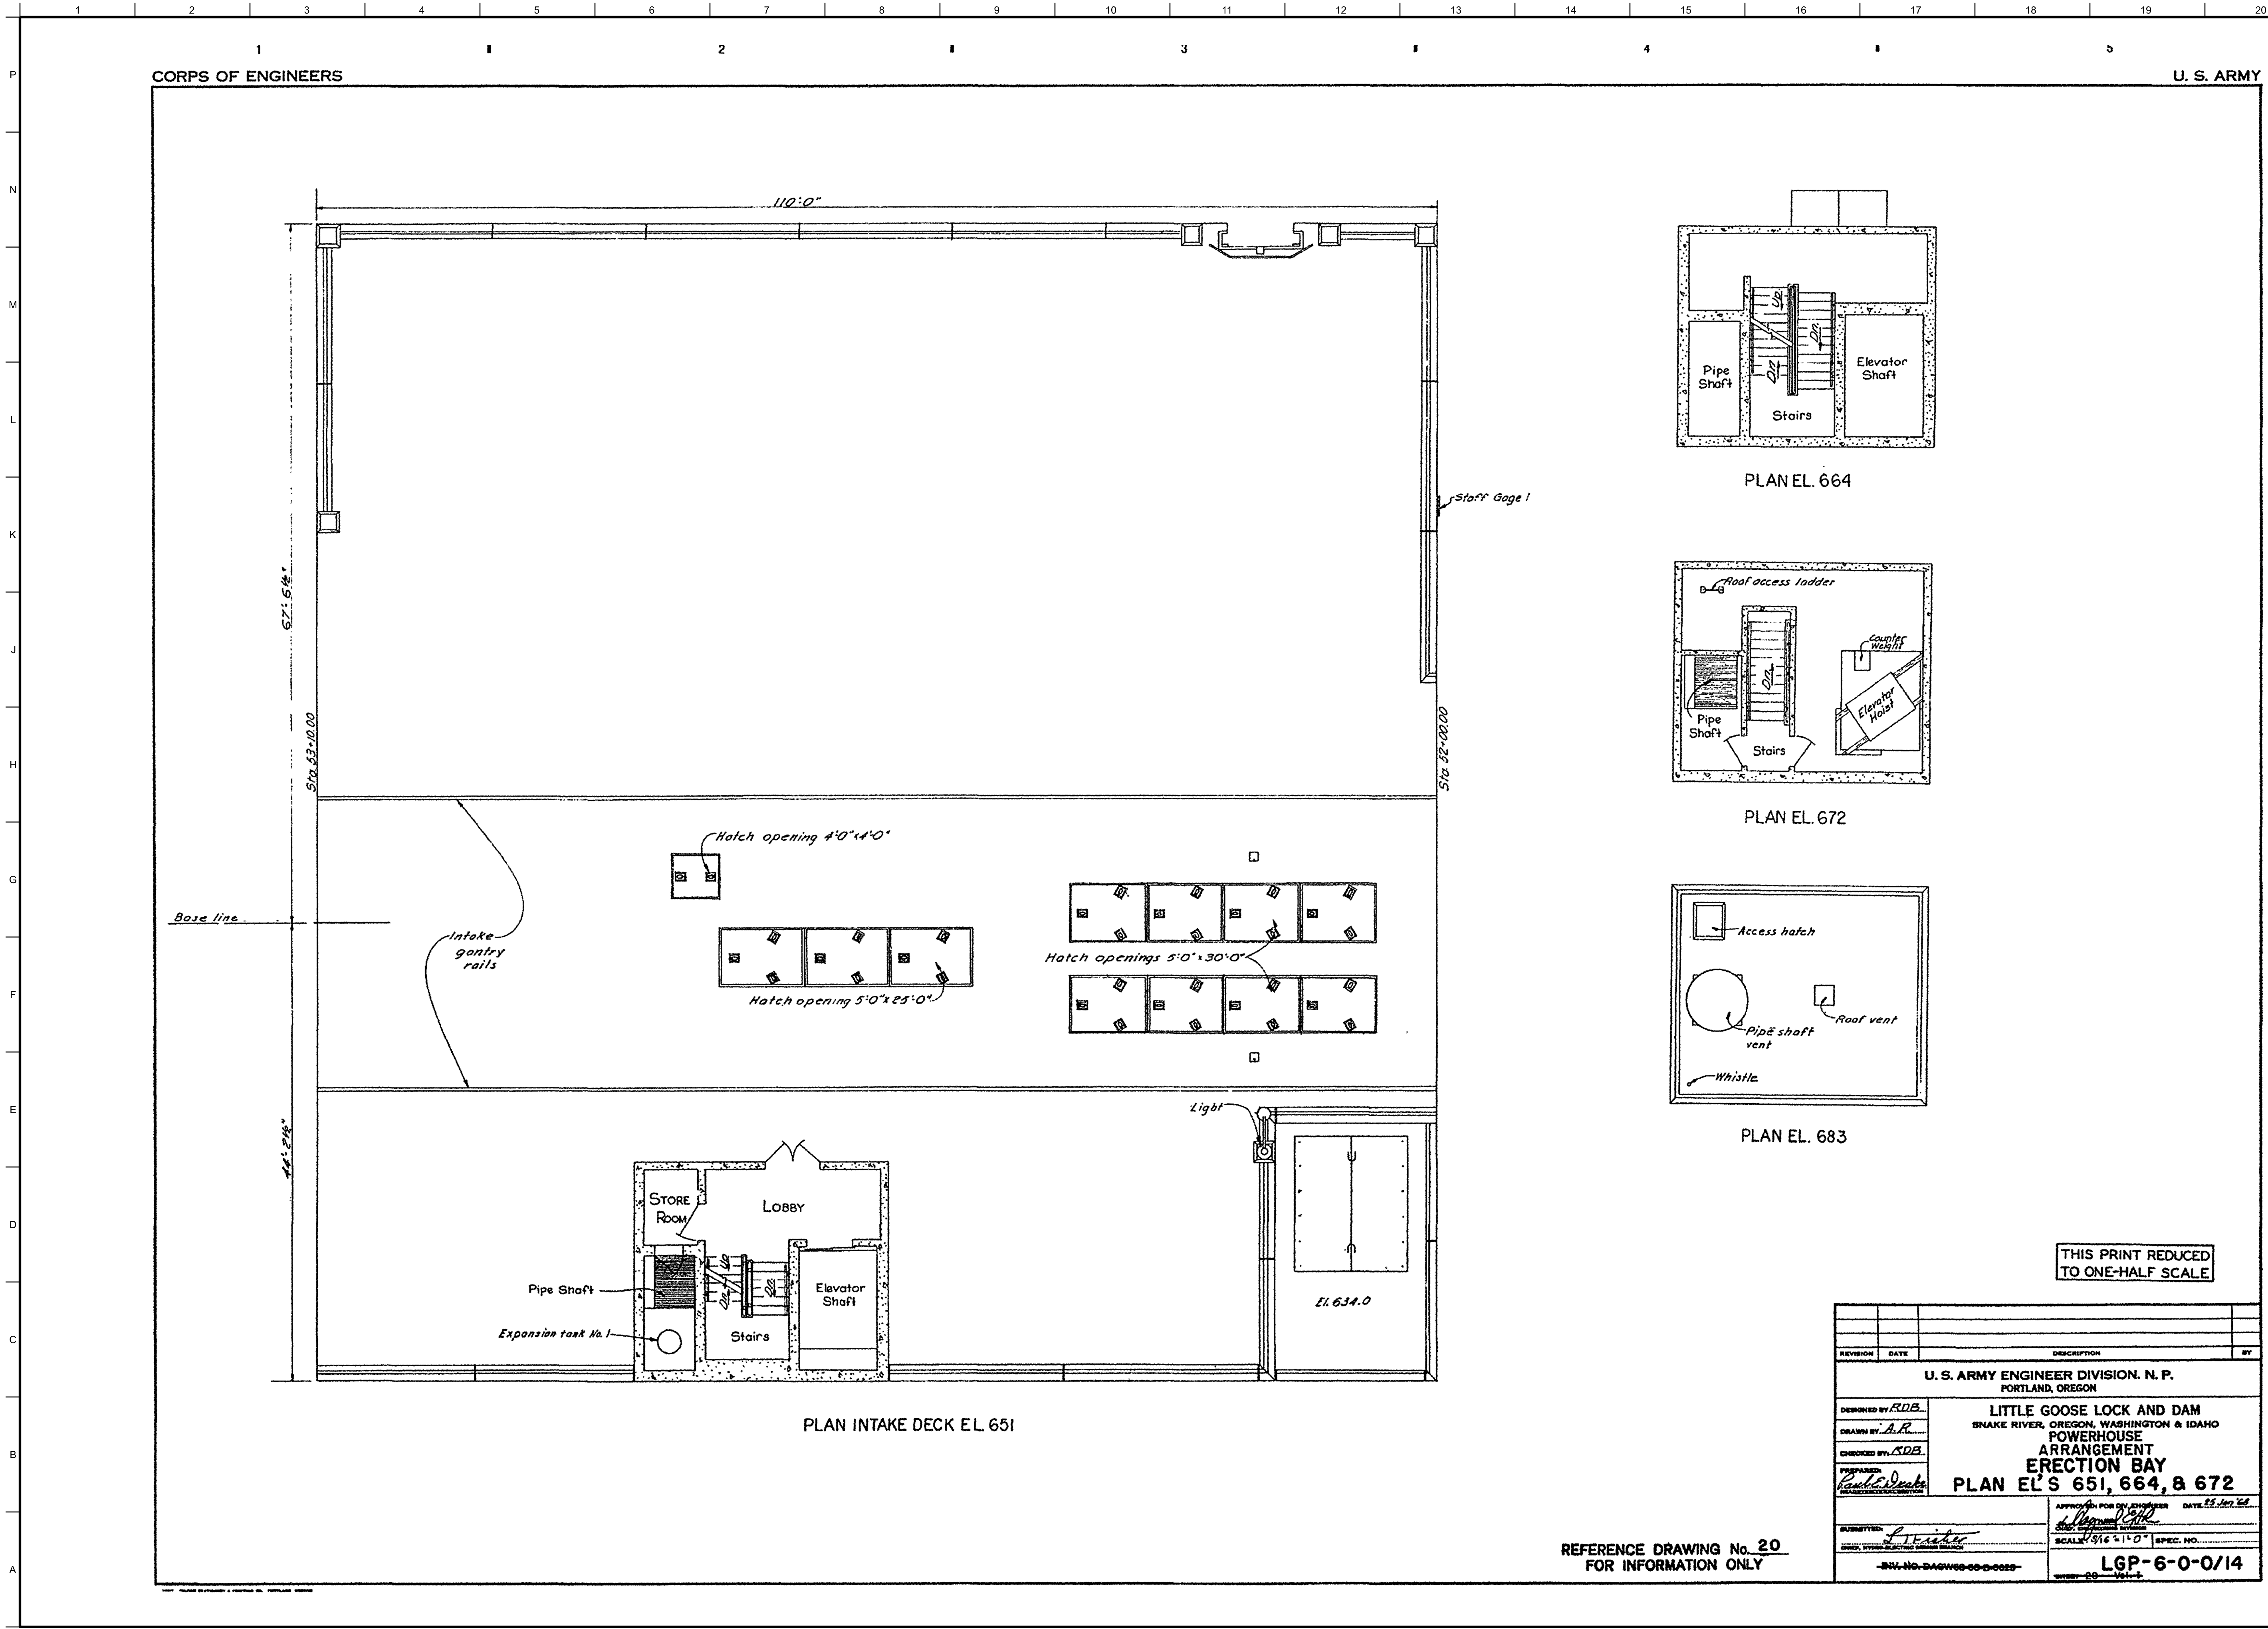

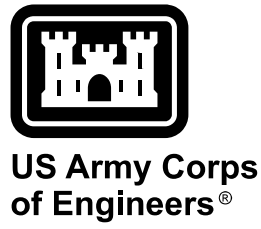

US Army Corps of Engineers®

LEGEND

- Conduit embedded in ceiling
- Conduit embedded in floor or wall
- Conduit turned toward observer
- Conduit turned away from observer
- Embedded ground conductor
- Ground Insert in floor (or ceiling if noted)
- Ground insert in wall
- Conduit outlets as noted
- Embedded cable tray insert in wall as noted

GENERAL NOTES

- GN1 Conduits, boxes and ground inserts are dimensioned to center lines unless otherwise noted.
- GN2 Manufacturer's catalog numbers have been used to indicate desired quality of materials and are not intended to exclude approved equals. Box numbers are Crouse Hinds except as noted.
- GN3 Typical conduit and grounding details are shown on drawing LGP-1-6-1A13/1 and are not necessarily referenced on individual conduit drawings.
- GN4 All telephone conduit (designated TF-11, TF-5, or TF-11-1) shall have minimum radius bends as follows: 1 inch-18" radius, 1 1/4 inch-24" radius, 2 inch-48" radius.
- GN5 Additional grounding connections are shown on the Lift Drawings.

REFERENCE DRAWINGS

DRAWING NO SHEET NO
LGP-1-6-1A13/1 61
LGP-1-6-1D1/2 63

Incl as req'd 250 257 259 296

C 7/10/11 As constructed - minor changes WDR	
B 6/10/66 Rearranged gnd & end, corrected Sec. B-B WHR	
A 1/26/65 Changed end location, added dimension WHR	
REVISION	DATE
CORPS OF ENGINEERS, U. S. ARMY NORTH PACIFIC DIVISION, PORTLAND, OREGON	
DESIGNED BY: EMS	
DRAWN BY: DFR	
CHECKED BY: WLS	
PREPARED BY: T.T. Sater	
HEAD, ELECTRICAL SECTION	
SUBMITTED: [Signature]	
CHIEF, HYDRO-ELECTRIC DESIGN BRANCH	
INW-HO-SWENG-45-164-65-18	
APPROVED: FOR DIVISION ENGINEER DATE 4 DEC 64 [Signature]	
SCALE AS SHOWN SPEC. NO.	
SHEET 62	

AS CONSTRUCTED
HYDRO-ELECTRIC DESIGN BRANCH, NPD

DATE 1071 JUL 01 BY D. D. Koehler
GRAPHIC SCALE
1/4" = 1'-0"

PLAN - EL 498
Scale: 1/4" = 1'-0"

SECTION A-A
No Scale

SECTION B-B
No Scale


SHEET ID

R-010

FINAL

CORPS OF ENGINEERS

U. S. ARMY

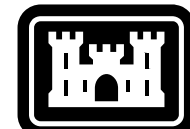US Army Corps
of Engineers®

DATE

MARK DESCRIPTION

ISSUE DATE:
AUGUST 1962SOLICITATION NO.:
W91ZEEZ0001

CONTRACT NO.:

DRAWING NUMBER:

DESIGNED BY:

DRAWN BY:

CHECKED BY:





SUBMITTED BY:

FILE NAME:
R-011.dgnSIZE:
ANSI DU.S. ARMY CORPS OF ENGINEERS
WALLA WALLA DISTRICT
201 NORTH 3RD AVENUE
SEATTLE, WASHINGTONLITTLE GOOSE LOCK AND DAM
SNAKE RIVER
POWERHOUSE
DC SYSTEM AND LOW VOLTAGE SWITCHGEARPOWERHOUSE
EMBEDDED CONDUIT & GROUNDING
ERECTION BAY EL 522

SHEET ID

R-011

FINAL

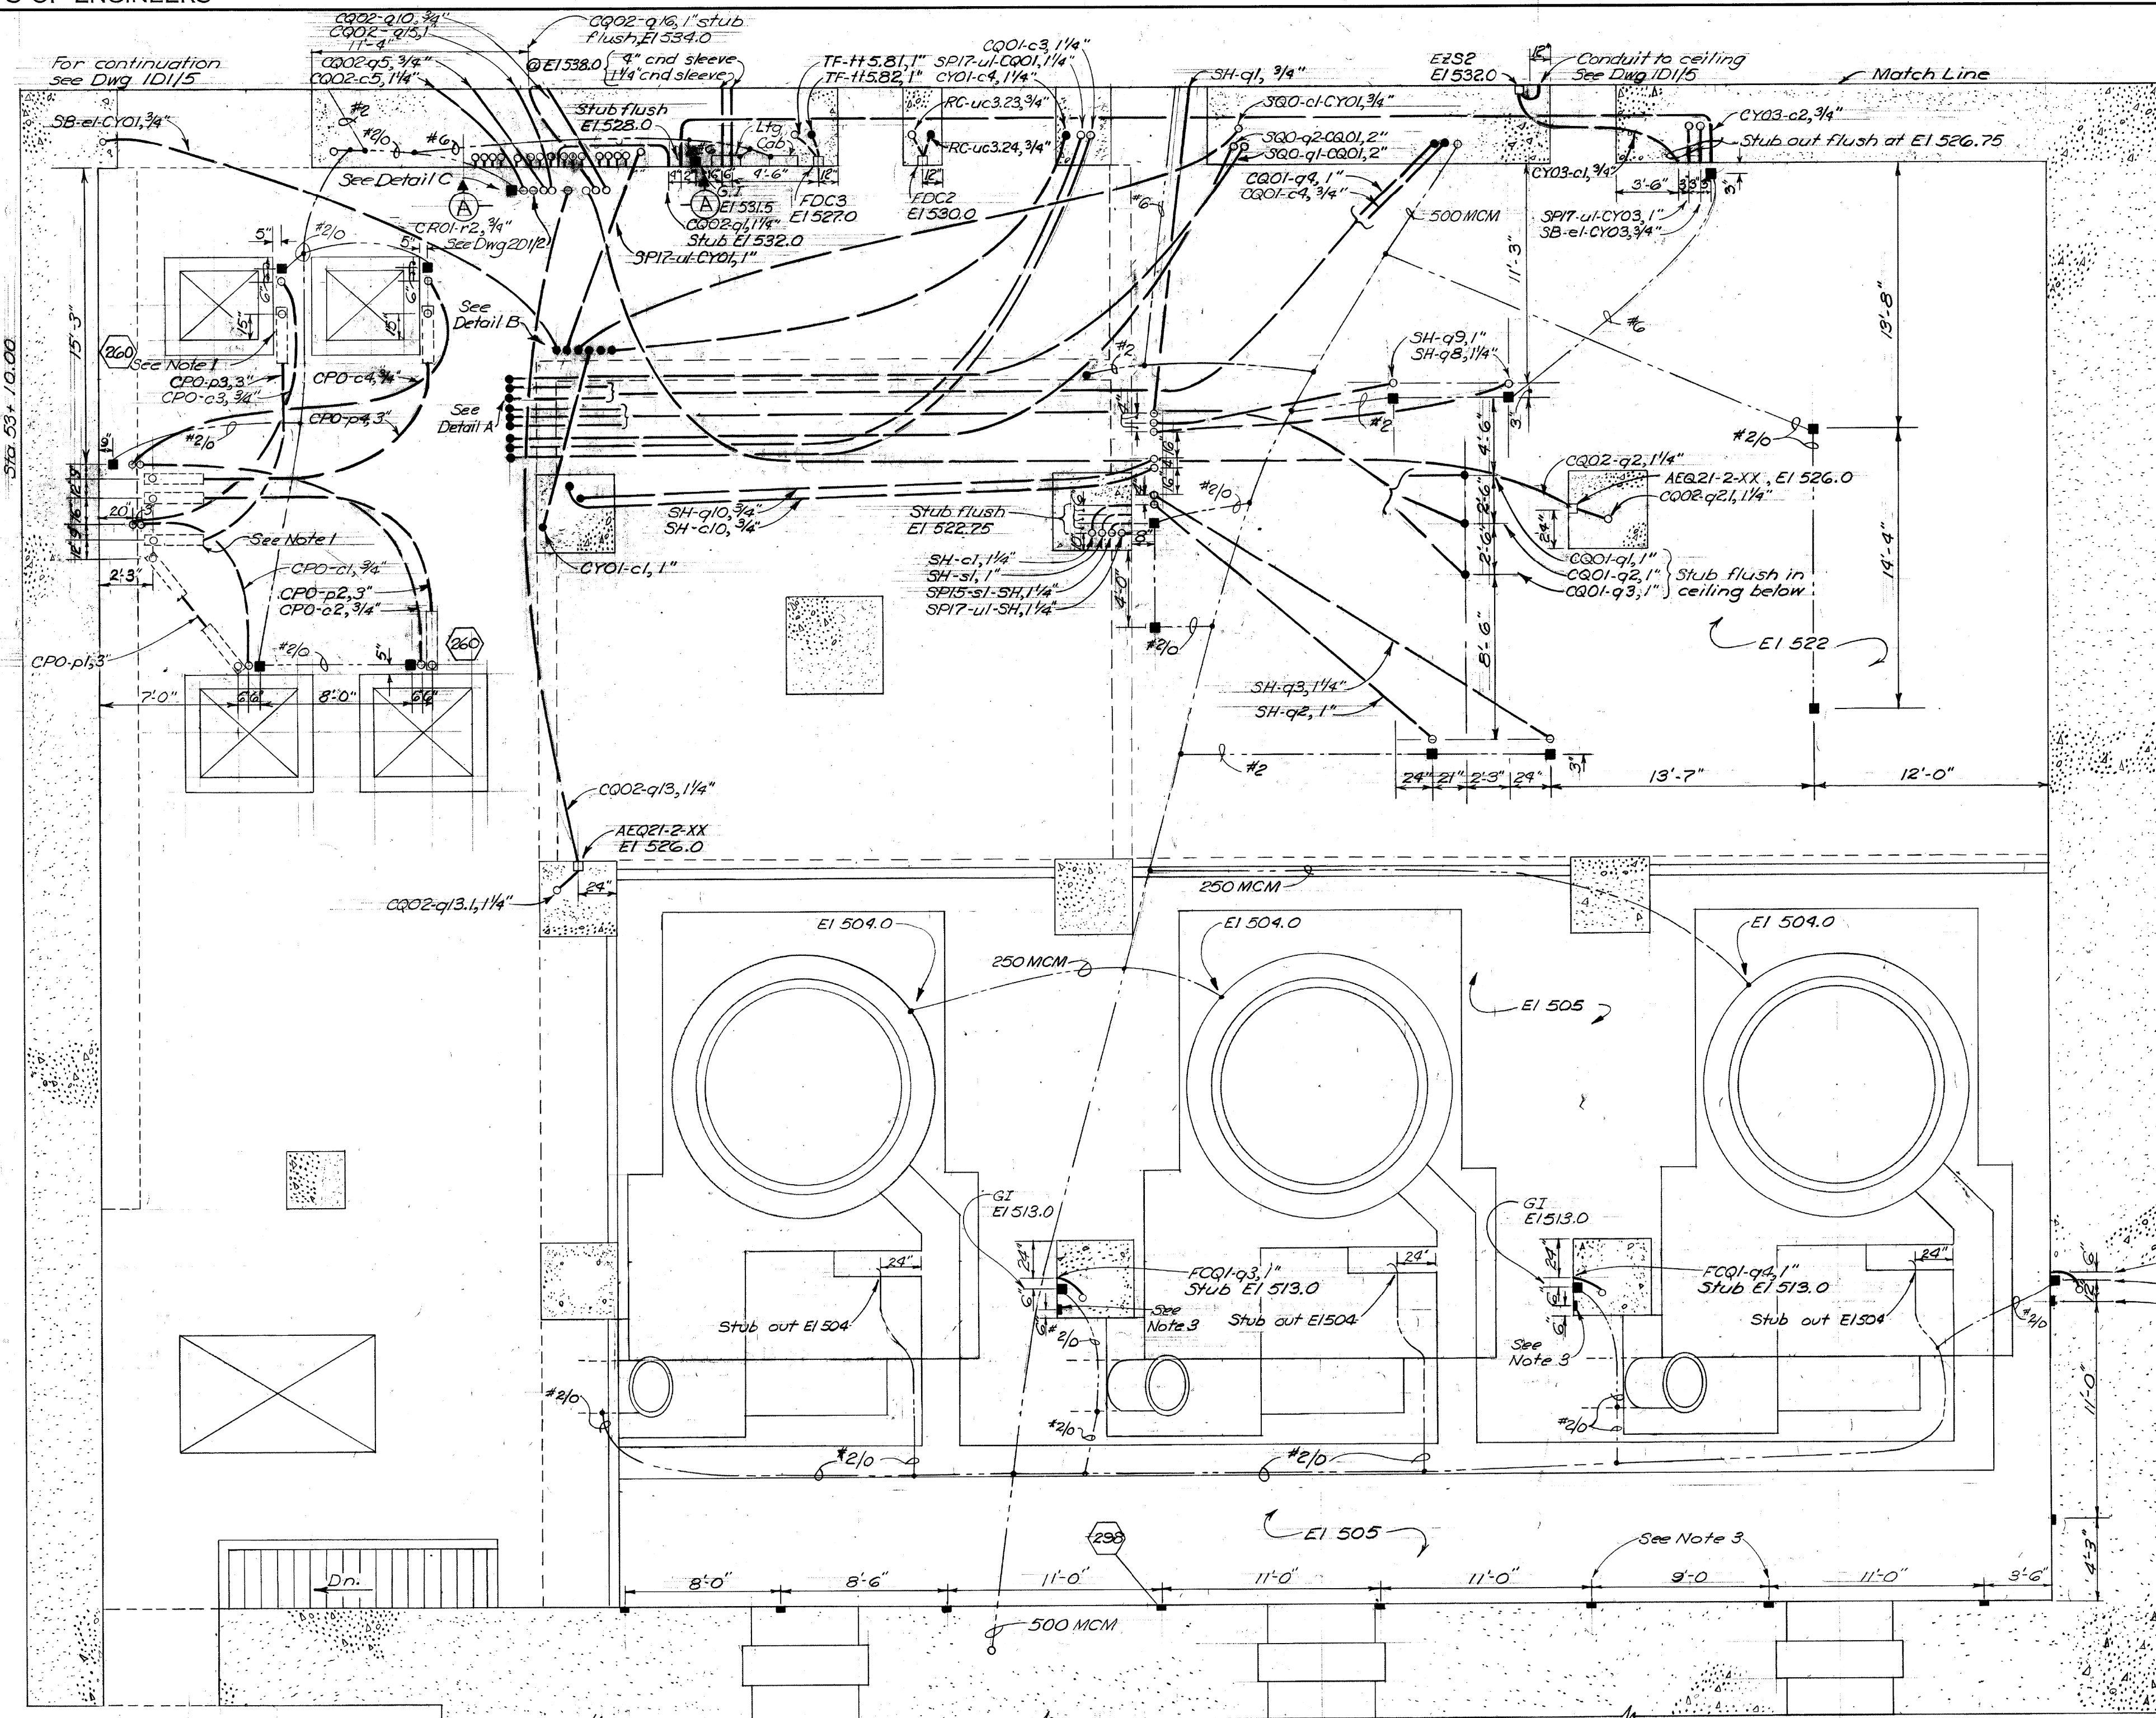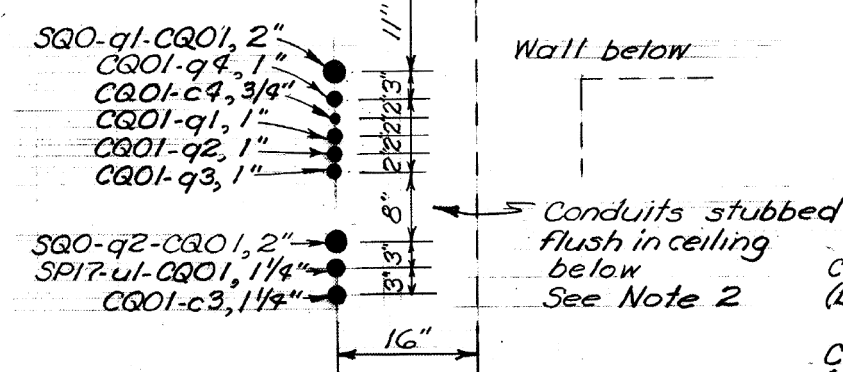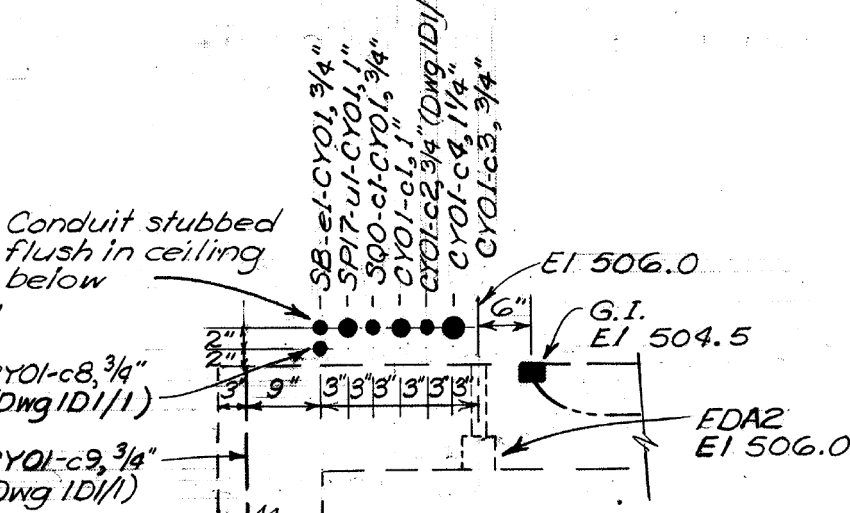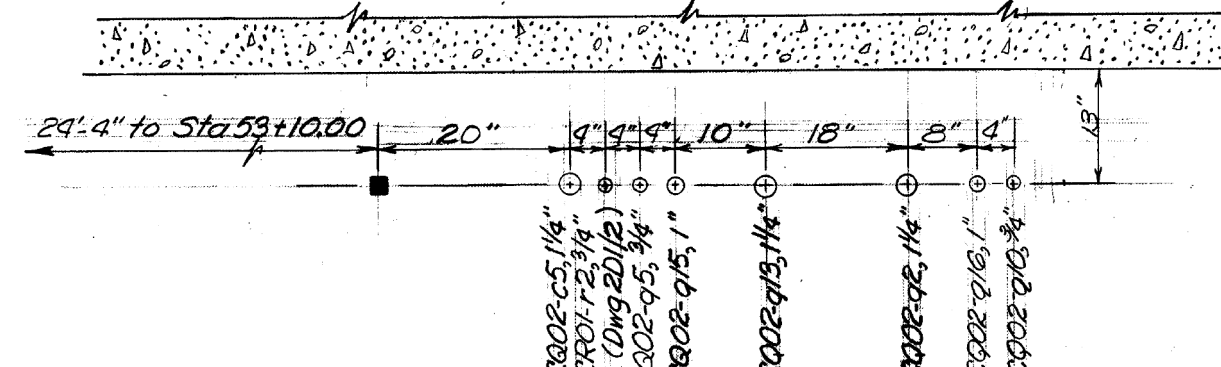
PLAN - EL 522
Scale: 1/4" = 1'-0"DETAIL A
Scale: 3/4" = 1'-0"DETAIL B
Scale: 3/4" = 1'-0"DETAIL C
Scale: 3/4" = 1'-0"AS CONSTRUCTED
HYDRO ELECTRIC DESIGN BRANCH, NPD

DATE 1971 JUL 01 BY H.D. Koehler

GRAPHIC SCALES

1/4" = 1'-0"

3/4" = 1'-0"

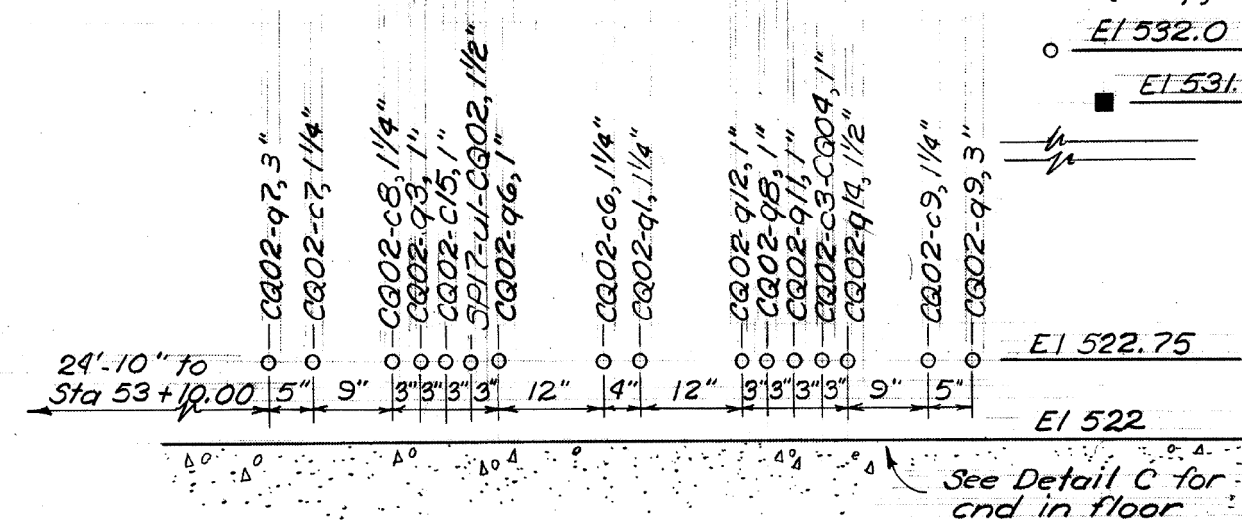SECTION A-A
No Scale

NOTES

1. Mount pull boxes flush in ceiling below. See drawing LGP-1-6-1D1/8, Detail B for pull box details.
2. Conduits to be stubbed flush with ceiling except for sizes 6 inch or larger where a minimum amount of bend may be exposed.
3. All embedded inserts shall be Unistrut Type P-3254 with top at EI 515.75.

REFERENCE DRAWINGS

DRAWING No	SHEET No
LGP-1-6-1A13/1	61
LGP-1-6-1D1/1	62
LGP-1-6-1D1/3	64
LGP-1-6-1D1/5	66
LGP-1-6-1D1/8	69
LGP-1-6-2D1/2	94

REVISION	DATE	DESCRIPTION	BY
F	1/1/62	As Constructed - rerouted conduits	WHR
E	6/1/62	Relocated SH conduits, minor corrections	WHR
D	9/1/62	Added and CQ02 q1/q2, relocated and #2 and	WHR
C	10/1/62	Relocated and # changed concrete out line	WHR
B	3/1/62	Added concrete inserts, minor revisions	WHR
A	1/1/62	Relocated CPO and Changed Detail B.	WHR

CORPS OF ENGINEERS, U. S. ARMY
NORTH PACIFIC DIVISION, PORTLAND, OREGONLITTLE GOOSE LOCK AND DAM
SNAKE RIVER, OREGON, WASHINGTON & IDAHO
POWERHOUSE
EMBEDDED CONDUIT & GROUNDING
ERECTION BAY
EL 522



APPROVED FOR DISTRICT ENGINEER DATE 4 DEC 64

BY H.D. Koehler

SCALE AS SHOWN SPEC. NO.

LGP-1-6-1D1/2

SHEET 63

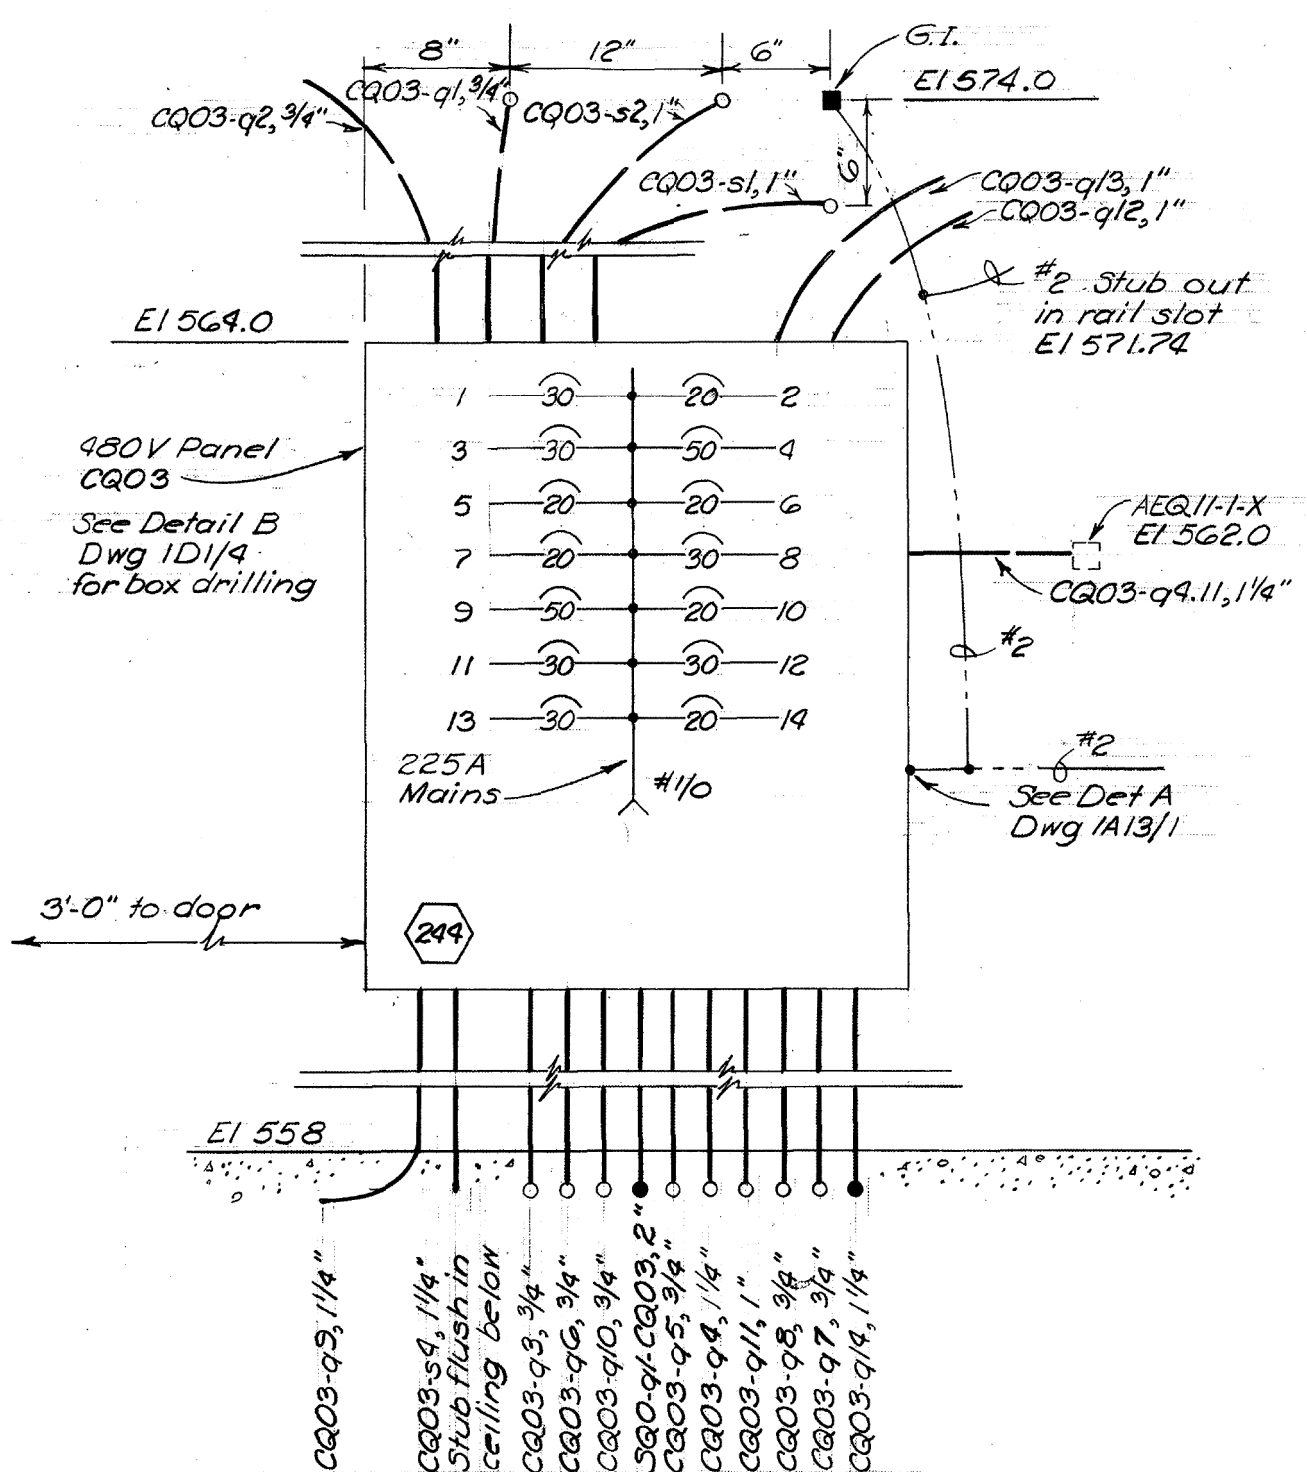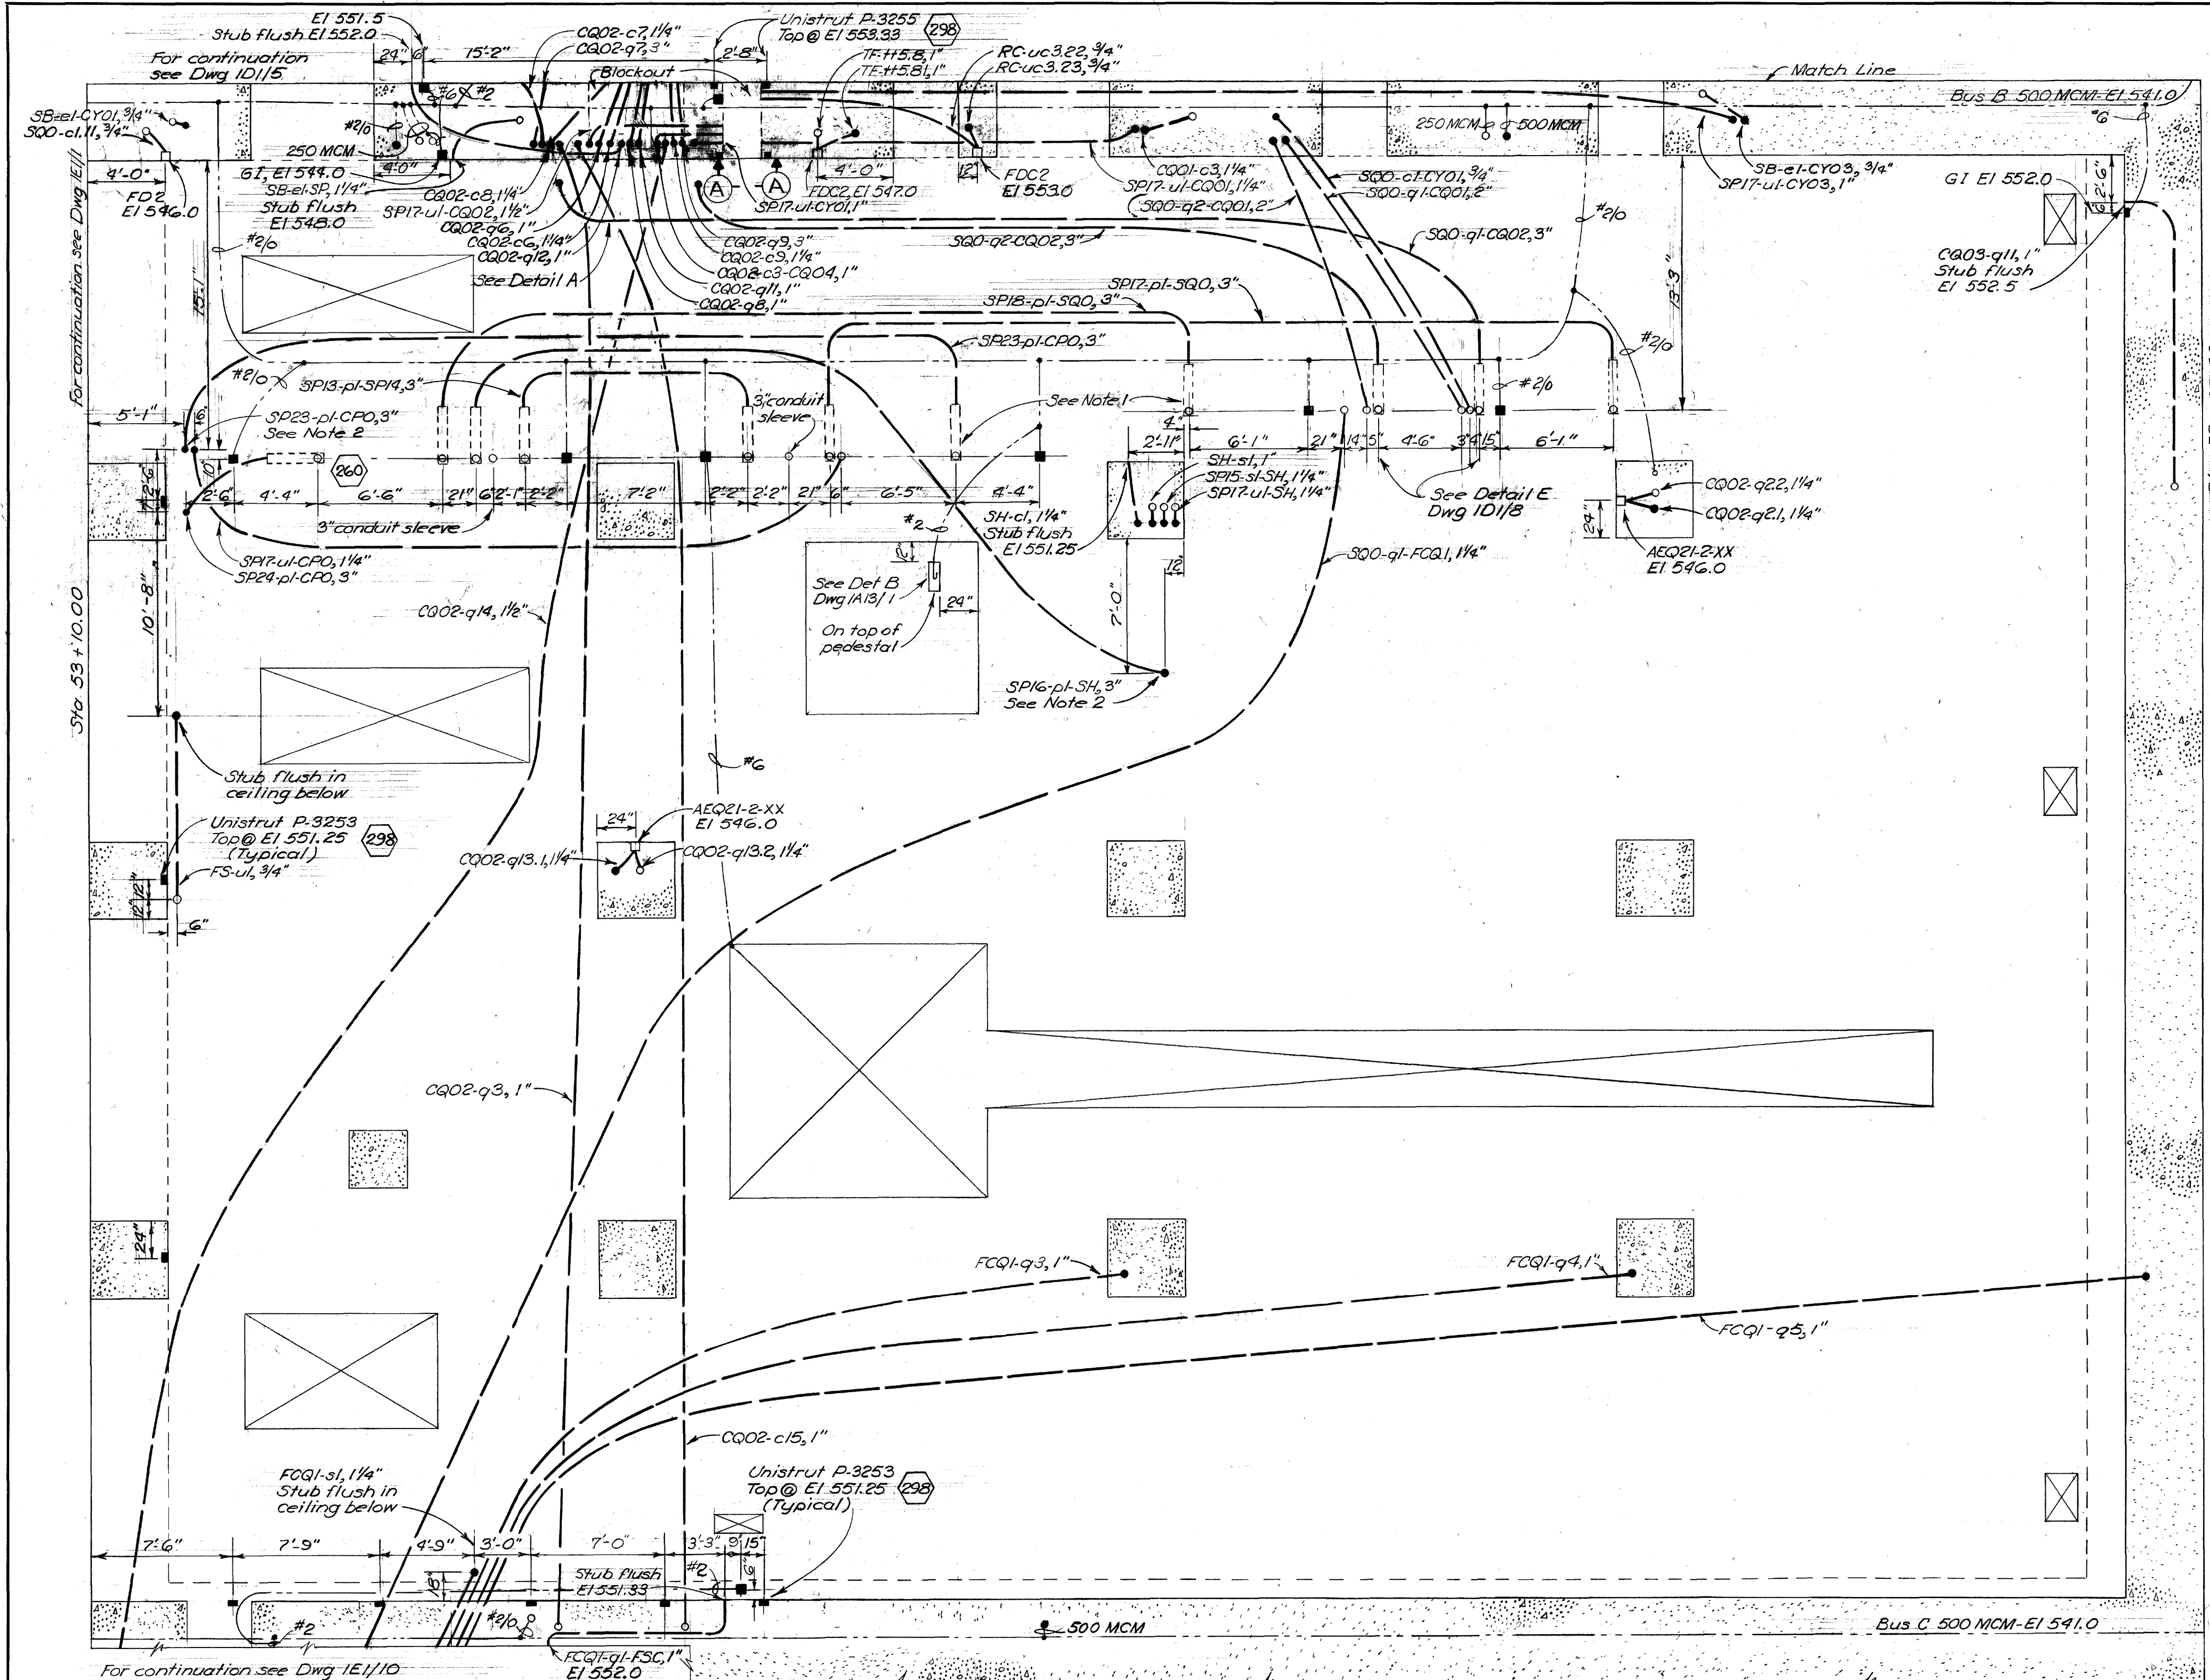US Army Corps
of Engineers®SECTION B-B (IDI/4)
No Scale480 PANEL - CQ03 - CABLE SCHEDULE
(Furnish and install cable as shown)

Circuit	Bkr No	No.	600V Insulated Conductors	AWG Size	Ckt Lg - Ft	Directory
CQ03-q11	11	3	10	45		TR03, El 542
CQ03-q12	12	3	10	70		Hi Bay
CQ03-q13	13	3	10	45		Hi Bay
CQ03-q14	14	3	10	90		TR04, El 558

NOTES

- Mount pull boxes flush in ceiling below. See drawing LGP-I-6-IDI/B, Detail B for box details, except as noted.
- Conduits to be stubbed flush with ceiling except for sizes 2-inch or larger where a minimum amount of bend may be exposed.


REFERENCE DRAWINGS

DRAWING NO.	SHEET NO.
LGP-I-6-IDI/1	61
LGP-I-6-IDI/2	62
LGP-I-6-IDI/3	63
LGP-I-6-IDI/4	64
LGP-I-6-IDI/5	65
LGP-I-6-IEI/1	71
LGP-I-6-IEI/2	72
LGP-I-6-IEI/10	80

244/250 Incl as reqd 257/260/267/290/298

REVISION	DATE	DESCRIPTION	BY
E	7/11/11	As Constructed - minor changes	WDR
D	6/11/11	Relocated and, corrected designations, added and WDR	
C	6/11/11	Relocated and, changed size and size WDR	
B	6/11/11	Relocated and, changed designation WDR	
A	6/11/11	Relocated SP and WDR	

DESIGNED BY: EMS	DRAWN BY: DFR	CHECKED BY: RCM	PREPARED: [Signature]
CORPS OF ENGINEERS, U. S. ARMY NORTH PACIFIC DIVISION, PORTLAND, OREGON			
LITTLE GOOSE LOCK AND DAM SNAKE RIVER, OREGON, WASHINGTON & IDAHO POWERHOUSE EMBEDDED CONDUIT & GROUNDING ERECTION BAY EL 542			
APPROVED: FOR DFL ENGINEER [Signature]		DATE: 4 DEC 64	
SUBMITTED: [Signature]		SCALE AS SHOWN SPEC. NO.	
CHIEF, HYDRO-ELECTRIC DESIGN BRANCH		LGP-I-6-IDI/3	
-REV. NO. CHVING-45-164-88-18		SHEET 64	

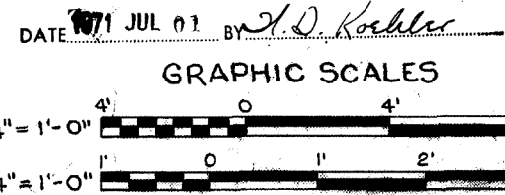AS CONSTRUCTED
HYDRO ELECTRIC DESIGN BRANCH, NPDDETAIL A
Scale: 3/4" = 1'-0"PLAN - EL 542
Scale: 1/4" = 1'-0"SECTION A-A
No ScaleSECTION B-B
No ScaleSECTION C-C
No Scale

SHEET ID

R-012

FINAL



REFERENCE DRAWING No. 19
FOR INFORMATION ONLY

THIS PRINT REDUCED
TO ONE-HALF SCALE

REVISION	DATE				BY

**U. S. ARMY ENGINEER DIVISION. N. P.
PORTLAND, OREGON**

DESIGNED BY RDB

 DRAWN BY PER

 CHECKED BY RDB

 PREPARED BY
Paula Decker
QUALITY CONTROL OFFICER

LITTLE GOOSE LOCK AND DAM

SNAKE RIVER, OREGON, WASHINGTON & IDAHO

POWERHOUSE

ARRANGEMENT

ERECTION BAY

PLAN GALLERY — EL'S 618 & 634

SUBMITTED [Signature]
CHECK, APPROVED

APPROVED FOR DESIGN ENGINEER DATE 27-NOV-68
P. Raymond Clark
DESK ENGINEERING OFFICER
 SCALE: 8" = 1' - 0" SPEC. NO. _____

LGP-6-0-0/13

-SW-NB-DACW60-B-0025-


LITTLE GOOSE LOCK AND DAM
SNAKE RIVER
POWERHOUSE
SYSTEM AND LOW VOLTAGE SWITCHGEAR
POWERHOUSE ARRANGEMENT
ERECTION BAY
PLAN GALLIERY - E1'S 618 & 634

SHEET ID

R-013

CORPS OF ENGINEERS

U. S. ARMY

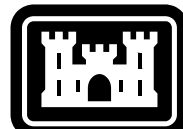

US Army Corps of Engineers®

DATE

MARK

DESCRIPTION

ISSUE DATE: AUGUST 2002
SOLICITATION NO.: W91ZCZ0001
CONTRACT NO.:
DESIGNED BY:
DRAWN BY:
CHECKED BY:
SUBMITTED BY:
FILE NAME: R014.dgn
SIZE: ANSI D




U.S. ARMY CORPS OF ENGINEERS
WALLA WALLA DISTRICT
201 NORTH 3RD AVENUE
SEATTLE, WASHINGTON

LITTLE GOOSE LOCK AND DAM
SNAKE RIVER
POWERHOUSE
DC SYSTEM AND LOW VOLTAGE SWITCHGEAR
POWERHOUSE EMBEDDED CONDUIT & GROUNDING
ERECTION BAY - INTAKE
EL 522, 542 & 558

SHEET ID

R-014

FINAL

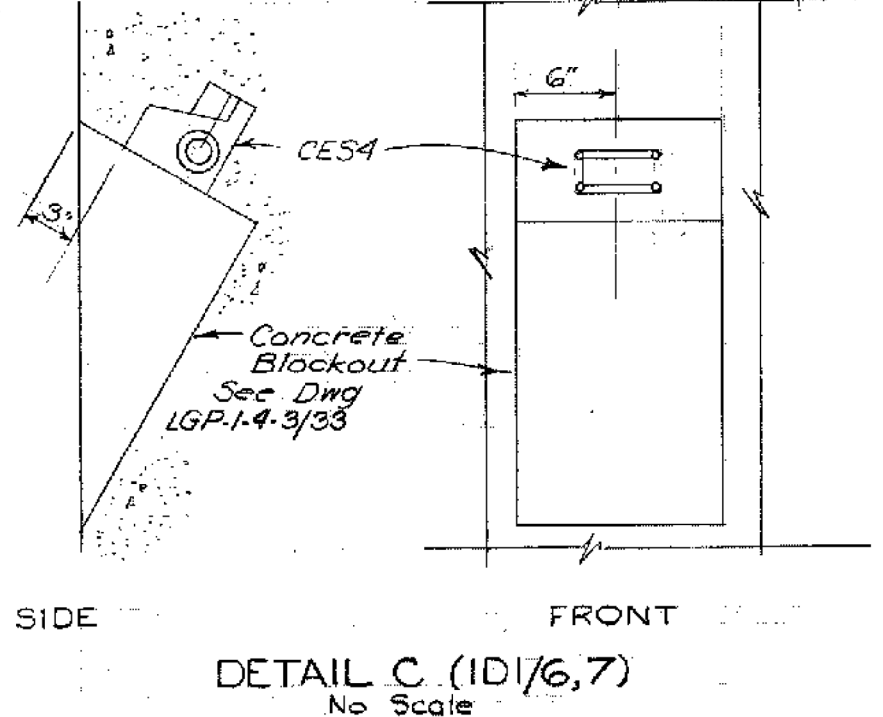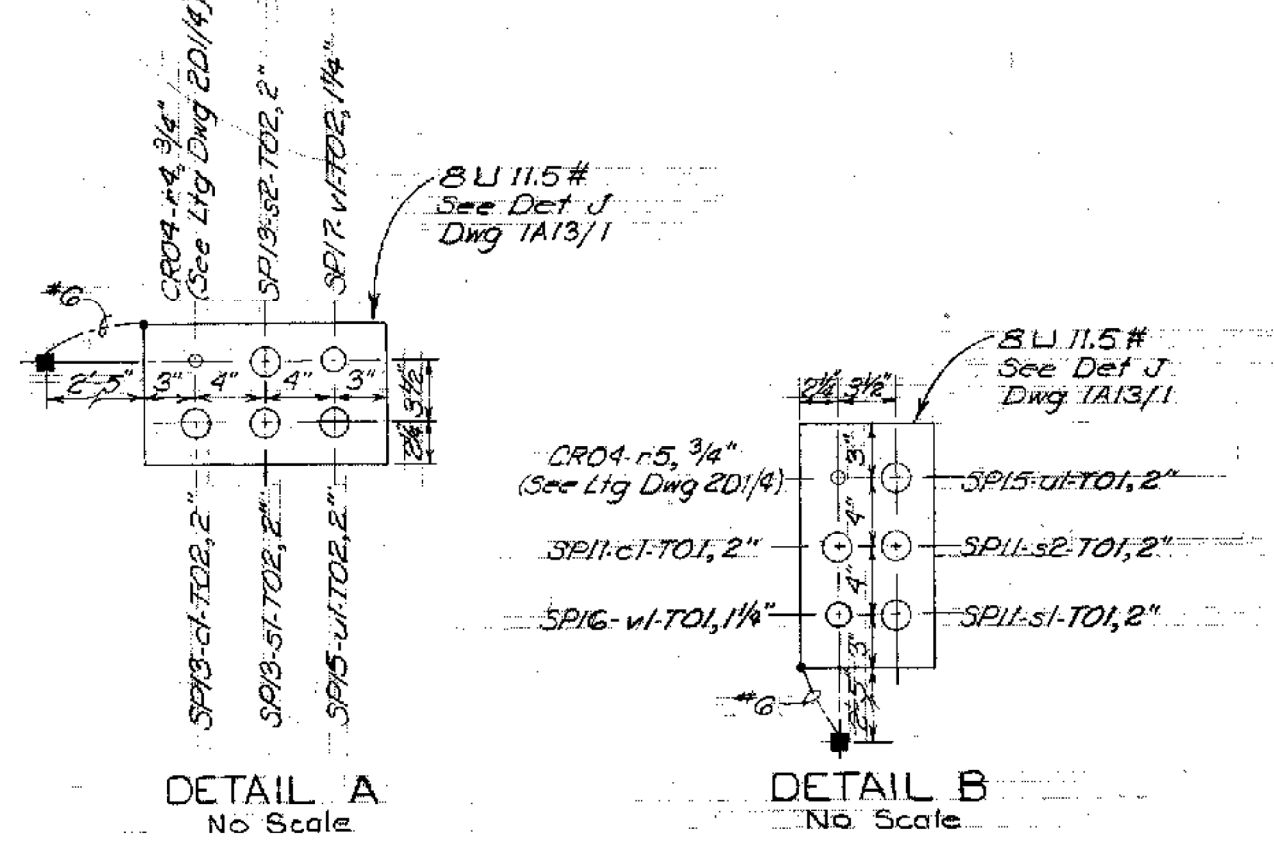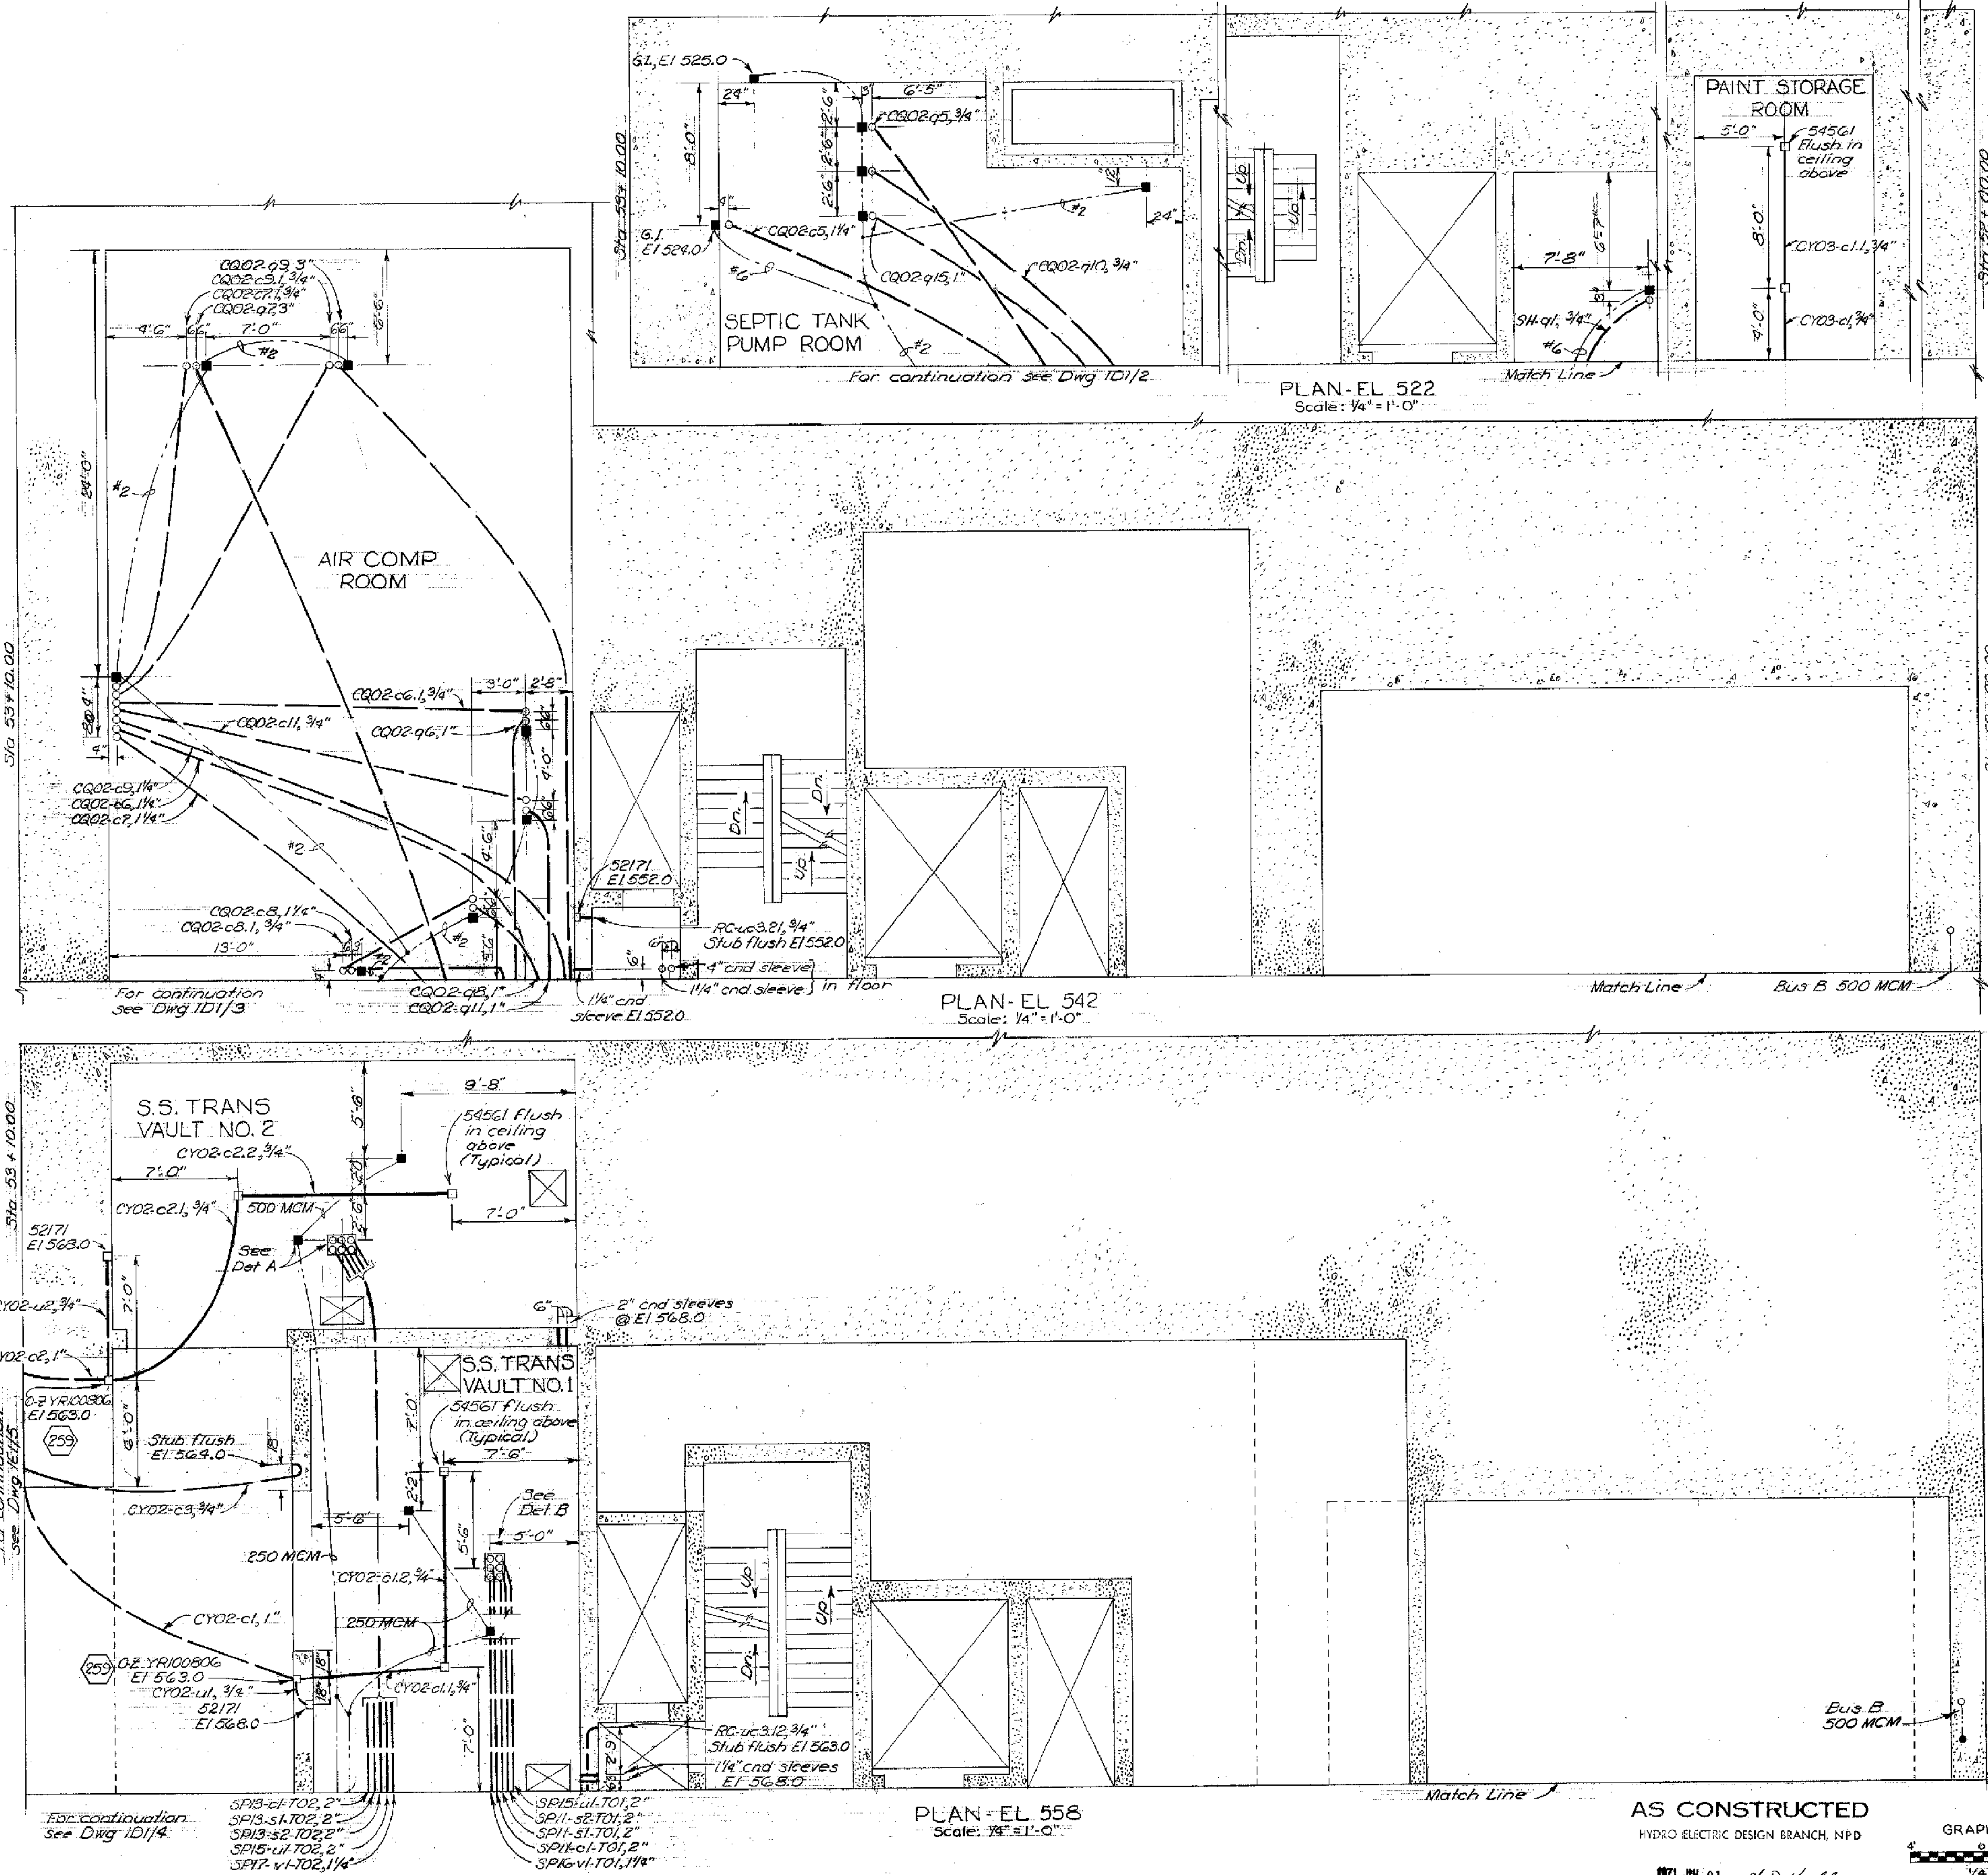

REFERENCE DRAWINGS

- LGP-1-4-3/33 III-VOLV
- LGP-1-6-1A13/1 61
- LGP-1-6-1D1/1 62
- LGP-1-6-1D1/2 63
- LGP-1-6-1D1/3 64
- LGP-1-6-1D1/4 65
- LGP-1-6-1D1/6 67
- LGP-1-6-1D1/7 68
- LGP-1-6-1E1/5 75
- (250) Incl (257) (259) (266) as reqd

REVISION	DATE	DESCRIPTION	BY
0	7/11/1	As Constructed - rerouted conduit	WDR
1	8/1/15	Added grid for sewage tank	WDR




CORPS OF ENGINEERS, U. S. ARMY NORTH PACIFIC DIVISION, PORTLAND, OREGON	
DESIGNED BY: EMS	
DRAWN BY: DFR	
CHECKED BY: PCM	
PREPARED BY: [Signature]	
SUBMITTED: [Signature]	
CHIEF, HYDRO-ELECTRIC DESIGN BRANCH	
DATE: 1 JUL 01 BY: A. D. Koshlitz	
SCALE AS SHOWN SPEC. NO.	
LGP-1-6-1D1/5	
SHEET 68	

AS CONSTRUCTED
HYDRO ELECTRIC DESIGN BRANCH, NPD




CONT NO. 260

VOL NO. IV

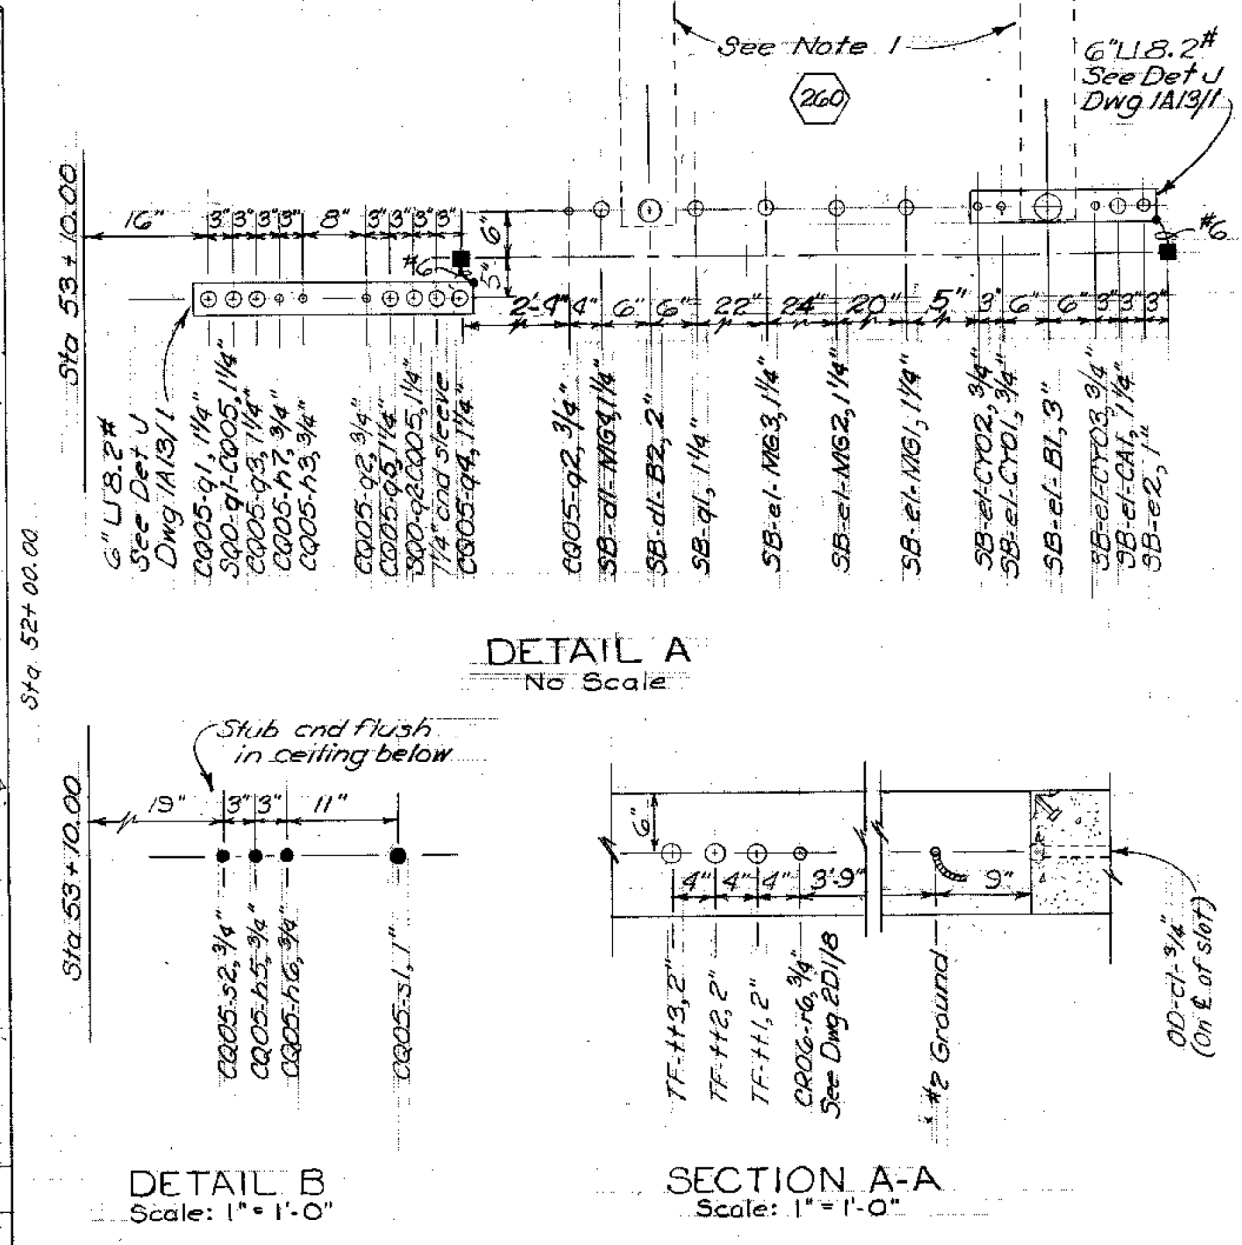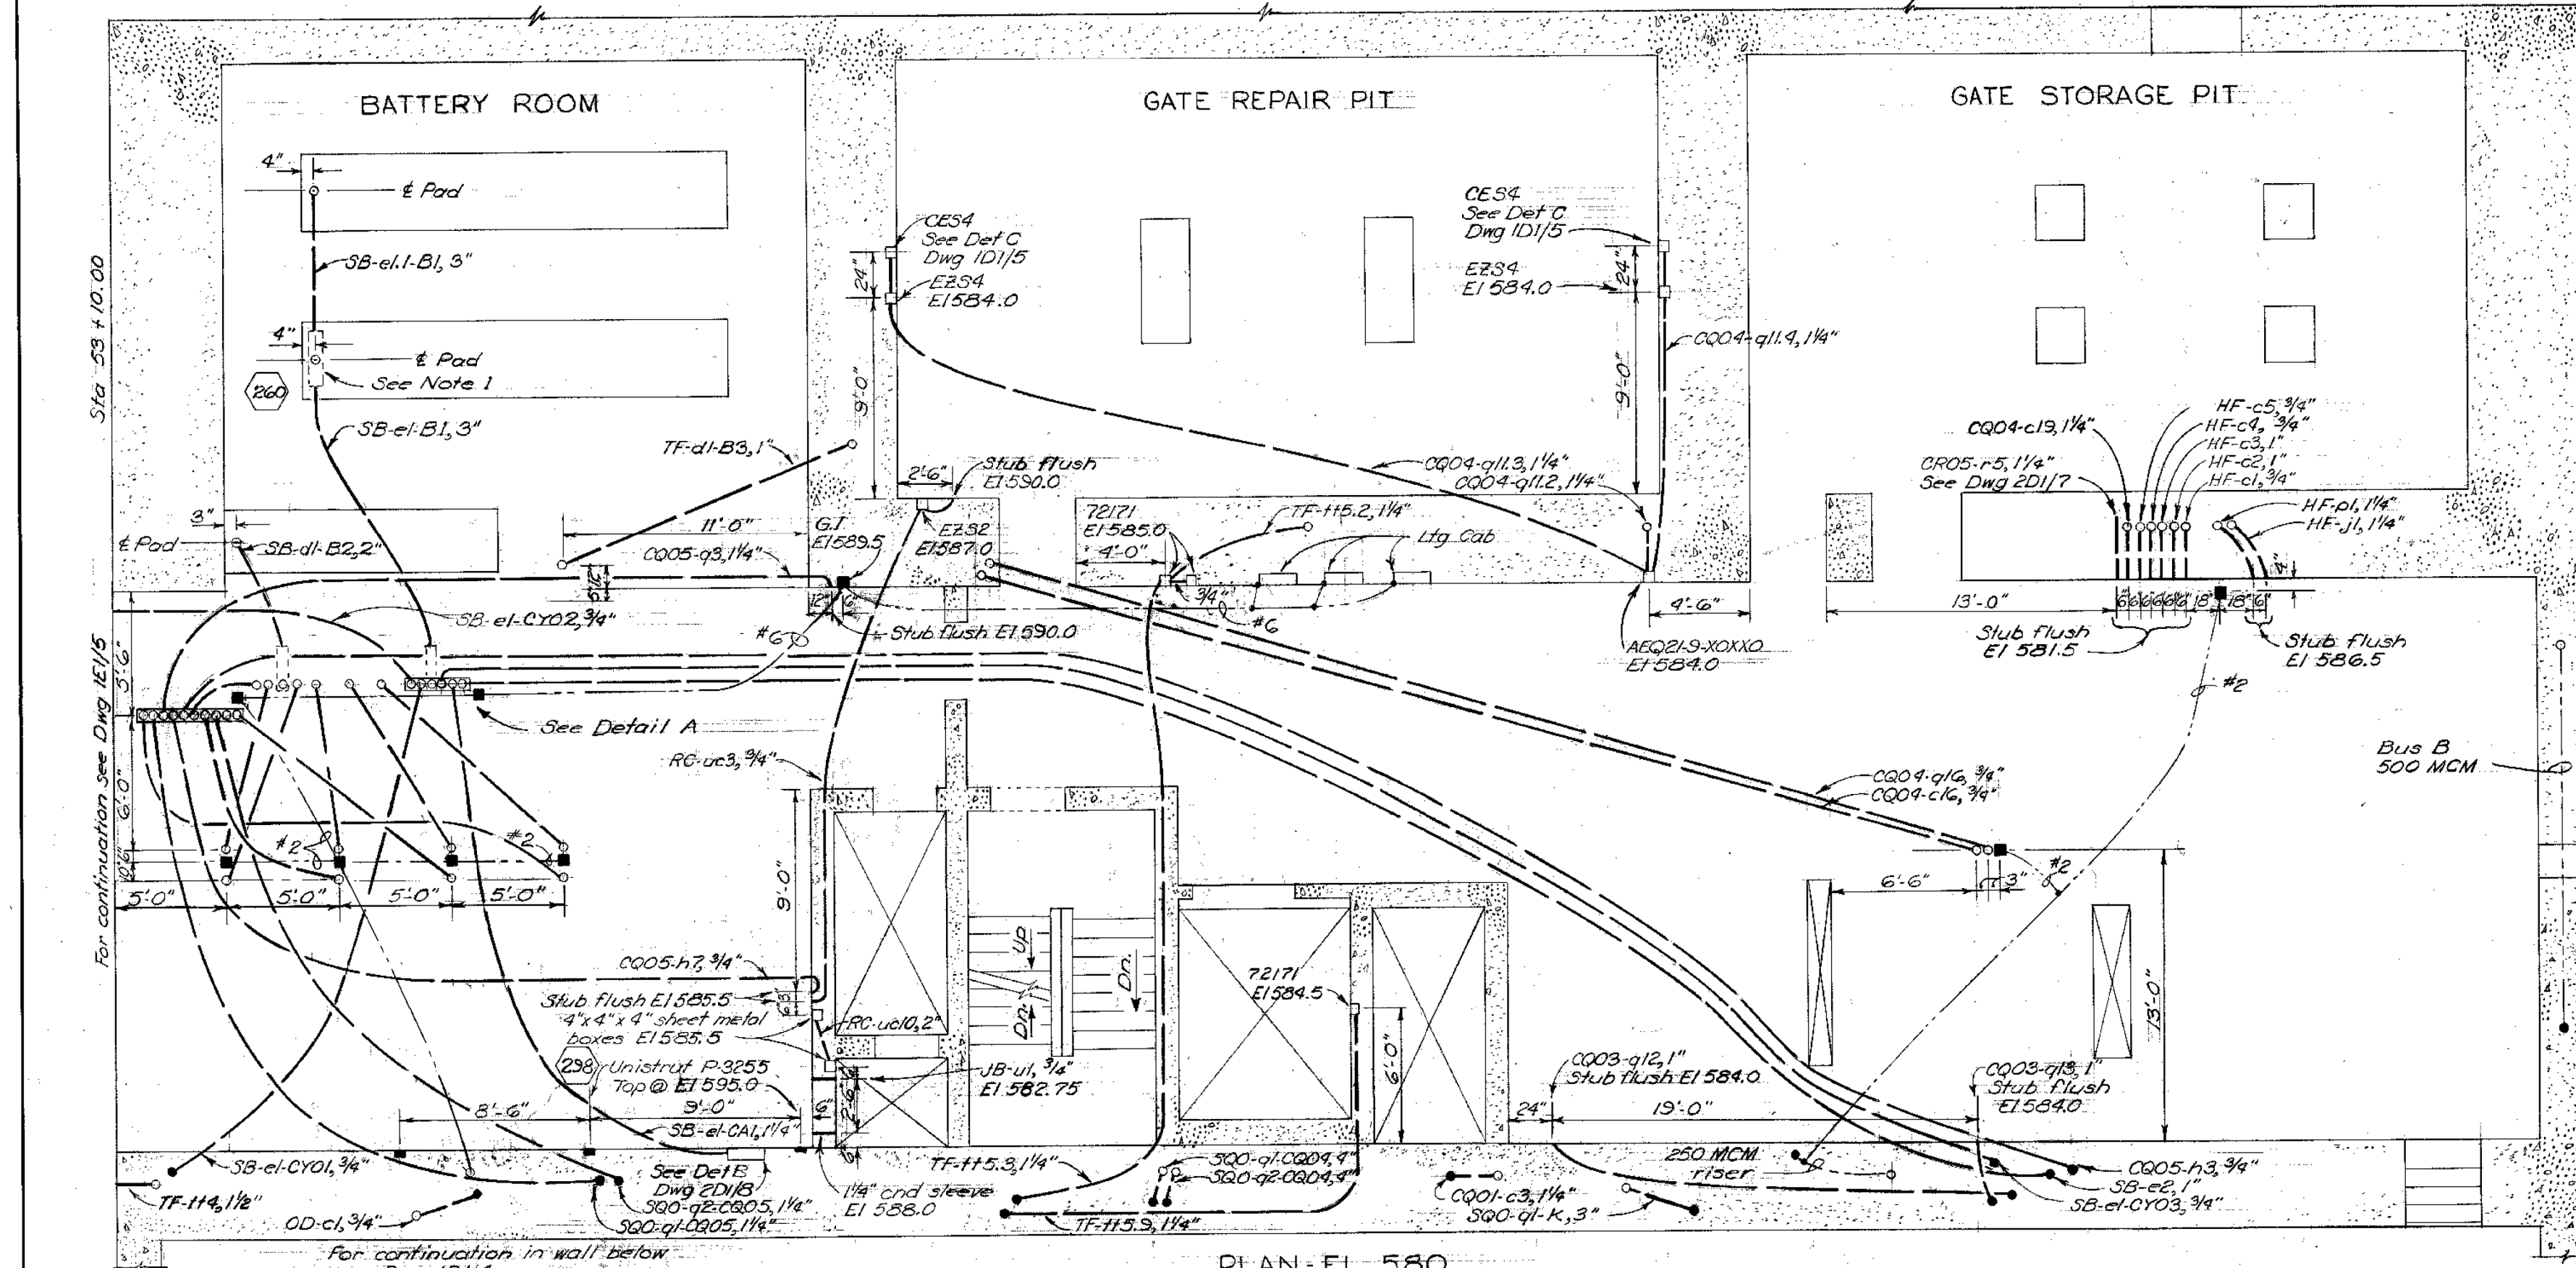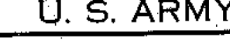

NOTE

1. Mount pull box flush in ceiling below. See Dwg. ID1/8, Detail D and E for box details.

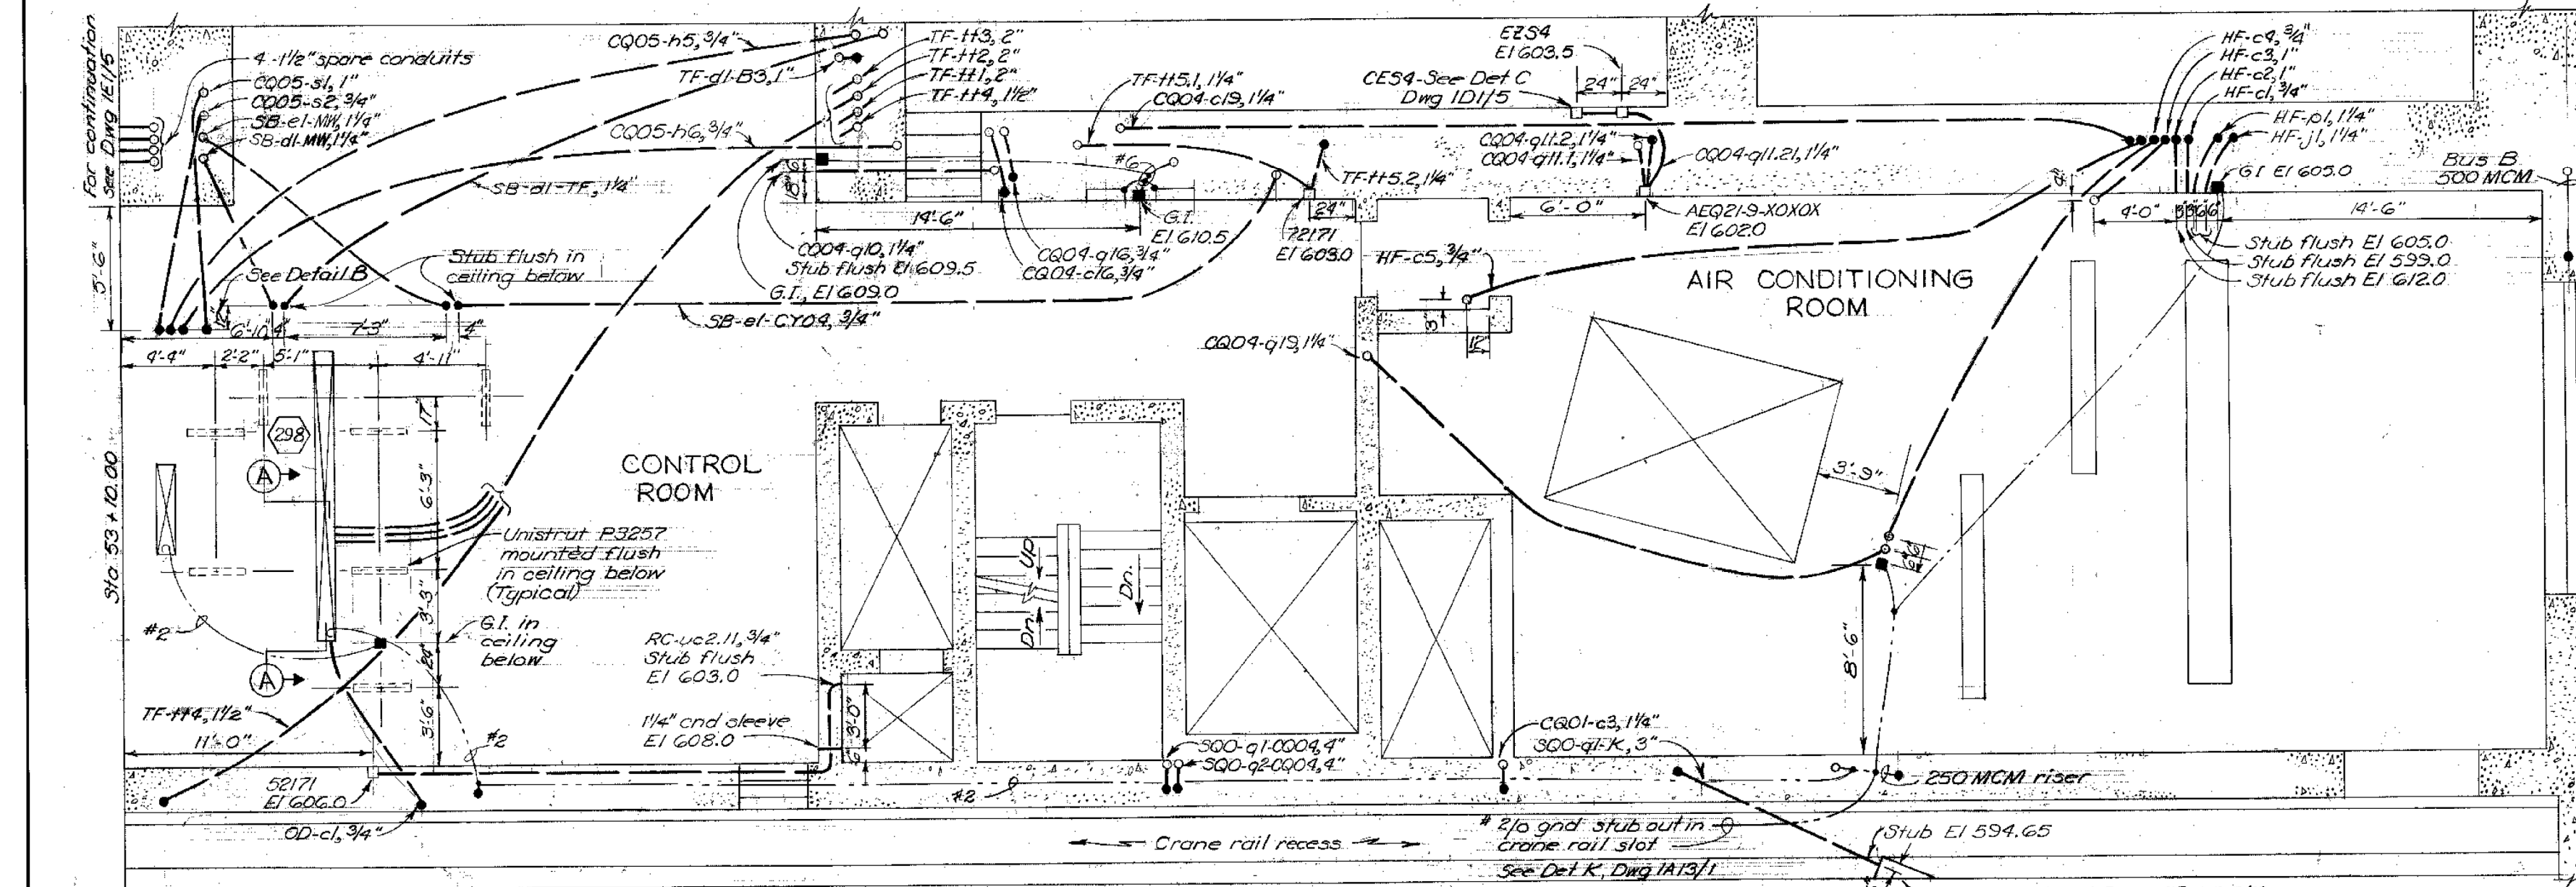

REFERENCE DRAWINGS	
DRAWING NO.	SHEET NO.
LGP-1-4-3/13	31 VOL V
LGP-1-6-1A13/1	61
LGP-1-6-1D1/1	62
LGP-1-6-1D1/4	63
LGP-1-6-1D1/5	66
LGP-1-6-1D1/7	68
LGP-1-6-1D1/8	69
LGP-1-6-1E1/5	75


D	7/11/1	As constructed - minor changes	WOK
C	7/11/1	General revisions & added and	WHR
	7/11/1	Added & referenced and & added designations	WHR
	7/16/65	Added conduit & reference dwg	WHR
REVISION	DATE	DESCRIPTION	BY
<p align="center">CORPS OF ENGINEERS, U. S. ARMY NORTH PACIFIC DIVISION, PORTLAND, OREGON</p> <p align="center">LITTLE GOOSE LOCK AND DAM SNAKE RIVER, OREGON, WASHINGTON & IDAHO POWERHOUSE EMBEDDED CONDUIT & GROUNDING ERECTION BAY - INTAKE EL 580 & 598</p>			
DESIGNED BY: <i>W.S.</i> DRAWN BY: <i>DFR</i> CHECKED BY: <i>PCM</i> PREPARED: <i>W. H. Hester</i> TITLE: ELECTRICAL SECTION			
SUBMITTED: <i>Richardson</i> CHIEF, HYDRO-ELECTRIC DESIGN BRANCH		APPROVED FOR DIV. ENGINEER: <i>W. H. Hester</i> DATE: 4 DEC. 64 DIST. ENGINEERING SECTION	
INV. NO. CIVENG 45-146-318		SCALE: AS SHOWN LGP-1-6-1DI/6	SPEC. NO. _____
CON'T IN 65-560		SHEET 67 VOL NO. IV.	

~~FOR INFORMATION ONLY~~

Sheet number:
FIO-015
VOLUME 1




**S Army Corps
Engineers®**

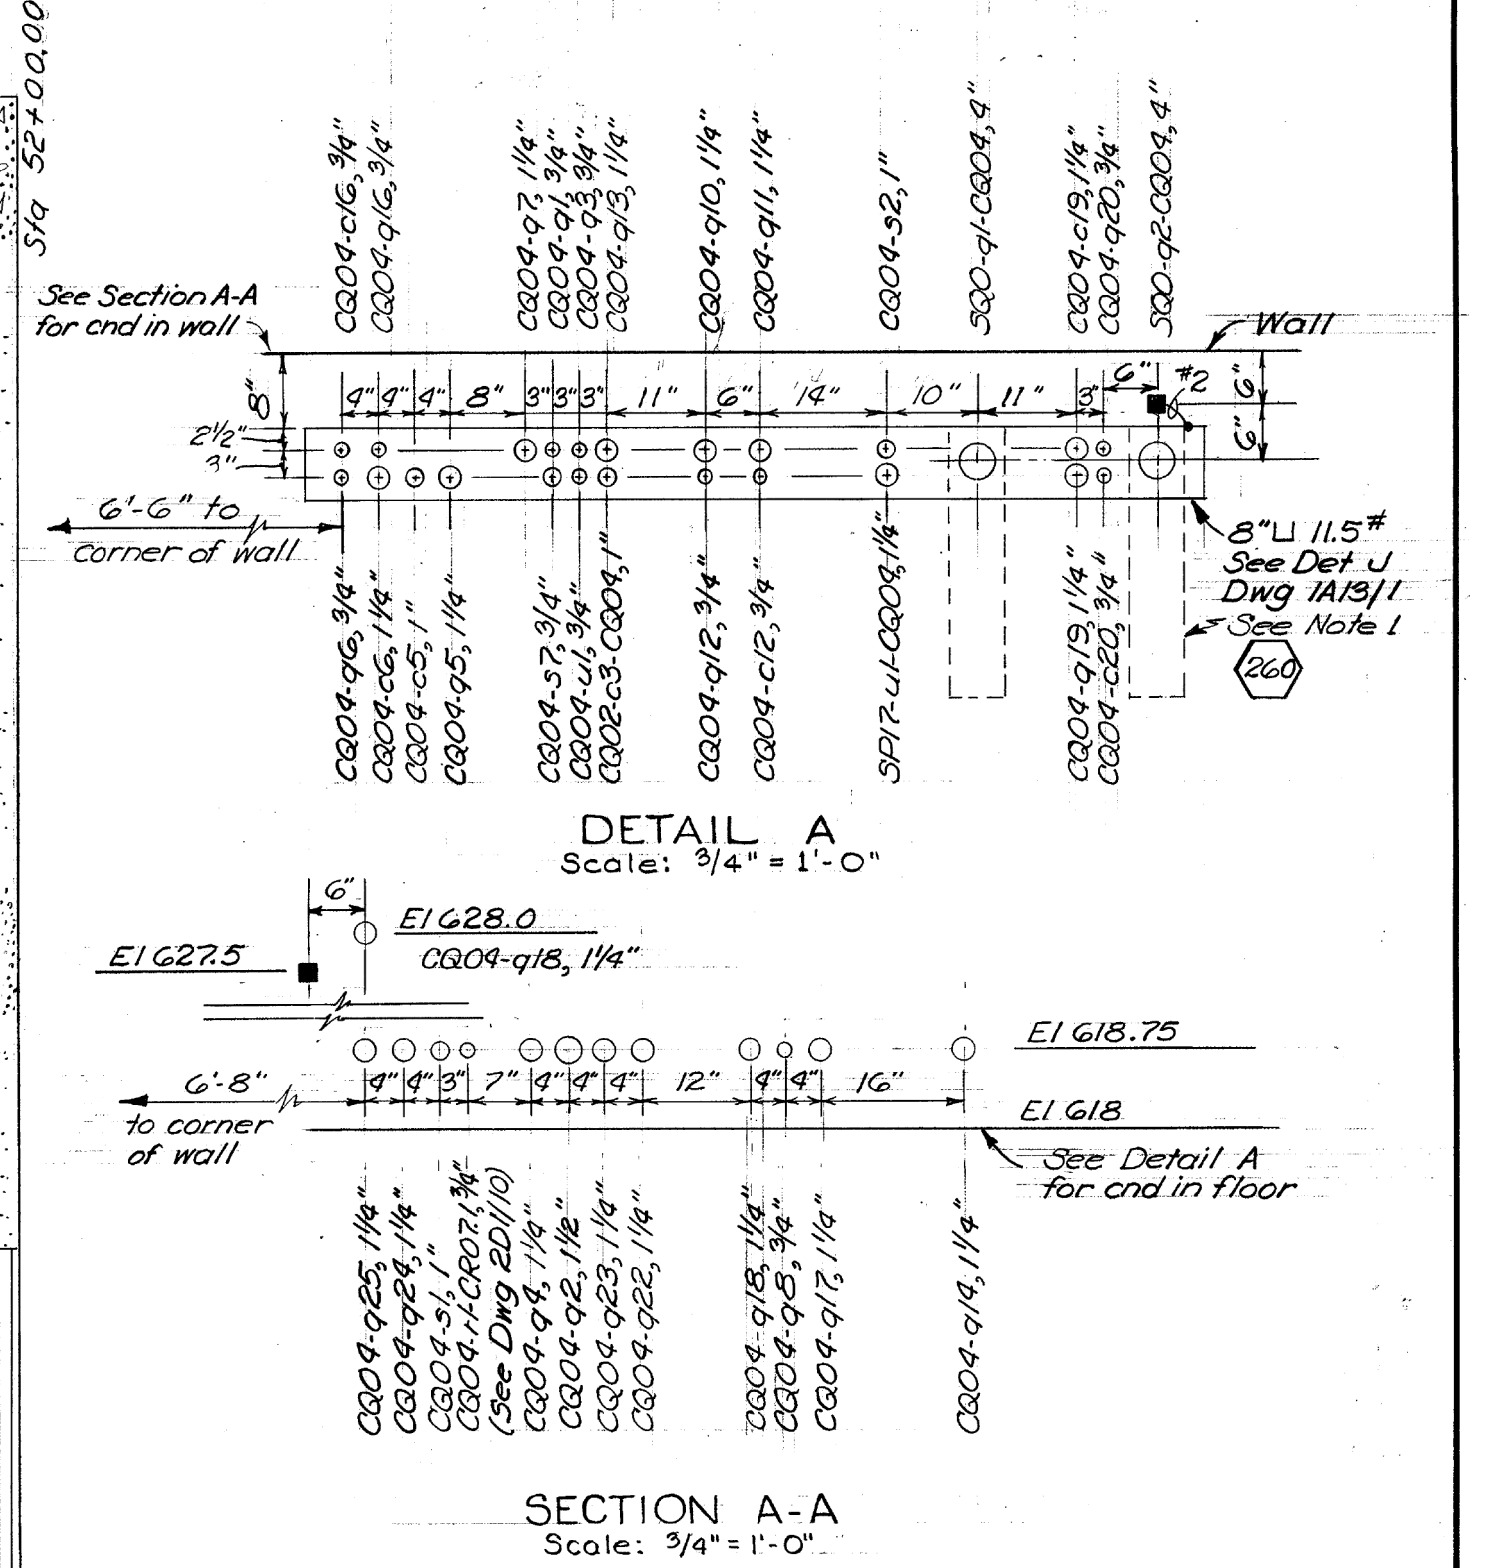

1. Mount pull boxes flush in ceiling below. See drawing LGP-1-6-1D1/3, Detail C for box details.
2. Conduits to be stubbed flush with ceiling except for 1/4" and larger where a minimum amount of bend may be exposed.

FILENAME:	ANSI D R-016.dgn
SIZE:	
SUBMITTED BY:	
CHECKED BY:	
DRAWN BY:	
CONTRACT NO.:	W912EE22R0001
SOLICITATION NO.:	W912EE22R0001
AUGUST 2022	

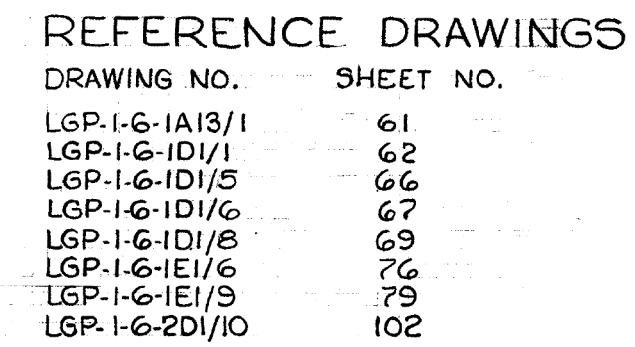


E	7/24/61	As Constructed - minor changes	WDR
D	6/24/62	Relocated and, changed size, corrected gnd	WHR
C	8/24/62	Relocated and, changed designations	WHR
B	3/14/63	Changed and location & designation	WHR
A	1/1/64	Relocated and	WHR
REVISION	DATE	DESCRIPTION	BY
<p align="center">U. S. ARMY ENGINEER DIVISION. N. P. PORTLAND, OREGON</p>			
DESIGNED BY: <u>WLS</u>		<p align="center">LITTLE GOOSE LOCK AND DAM SNAKE RIVER, OREGON, WASHINGTON & IDAHO POWERHOUSE EMBEDDED CONDUIT & GROUNDING ERECTION BAY - INTAKE EL 618 8 634</p>	
DRAWN BY: <u>DFR</u>			
CHECKED BY: <u>RCM</u>			
PREPARED BY: <u>W. E. Carter</u>			
HEAD, ELECTRICAL SECTION			
SUBMITTED: <u>[Signature]</u>		APPROVED FOR DIV. ENGINEER	DATE: <u>4 DEC 64</u>
CHIEF, HYDRO-ELECTRIC DESIGN BRANCH		2ND DIVISION CHIEF <u>[Signature]</u>	
-INV. NO. GIVEN 45-10665-10-		SCALE: <u>As Shown</u>	SPEC. NO.
		LGP-1-6-1D1/7	
		SHEET 68	

POWERHOUSE
DC SYSTEM AND LOW VOLTAGE SWITCHGEAR
POWERHOUSE EMBEDDED CONDUIT & GROUNDING
ERECTION BAY - INTAKE
EL 618 & 634


SHEET ID

R-016

FINAL

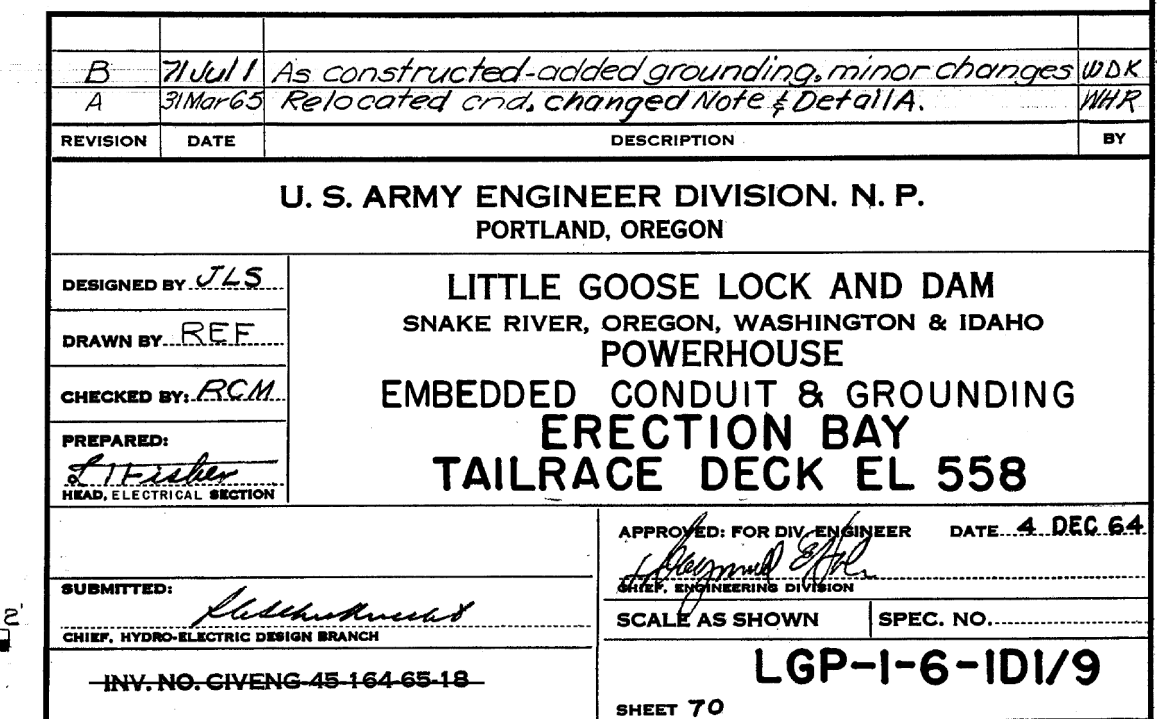


SHEET ID
R-018

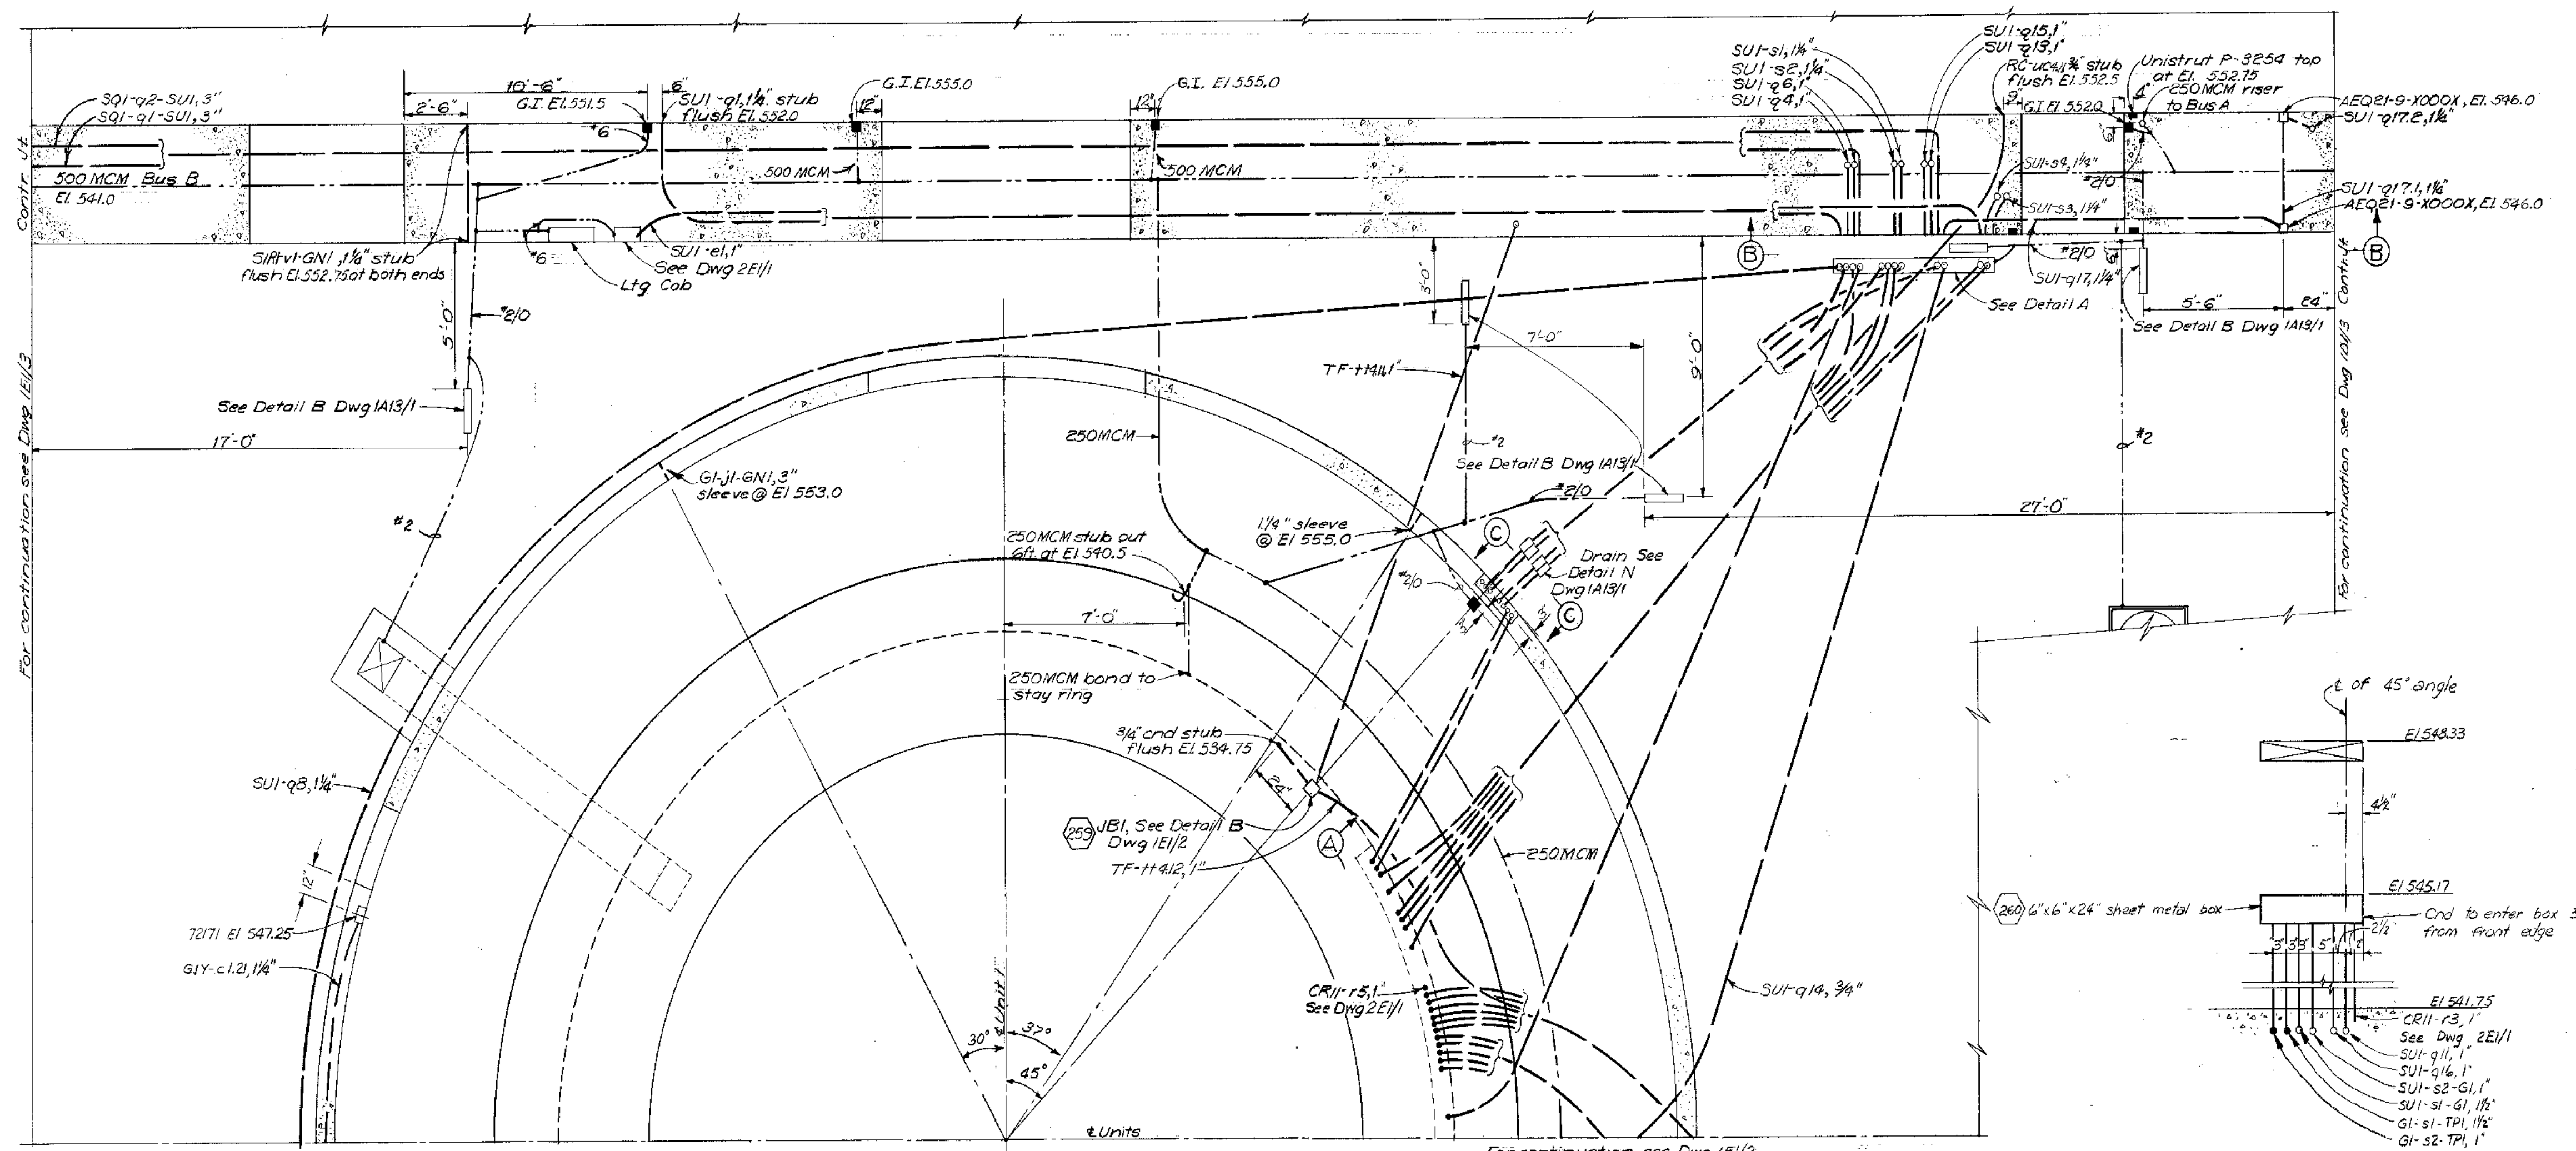


PLAN BAY 1 EL 542
Scale: 3/8"=1'-0"


SECTION C-C
No Scale

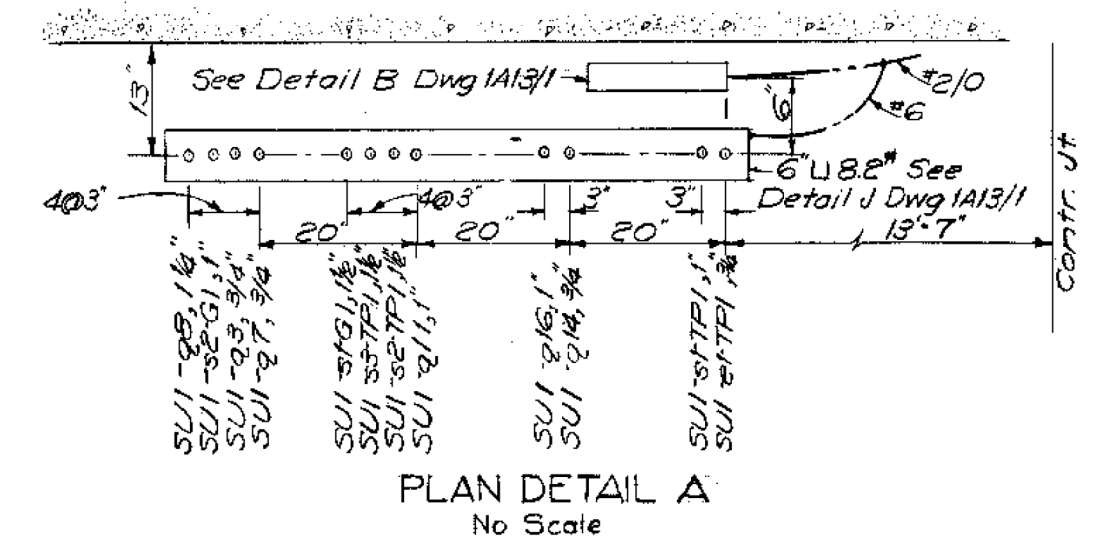

PLAN DETAIL A
No Scale

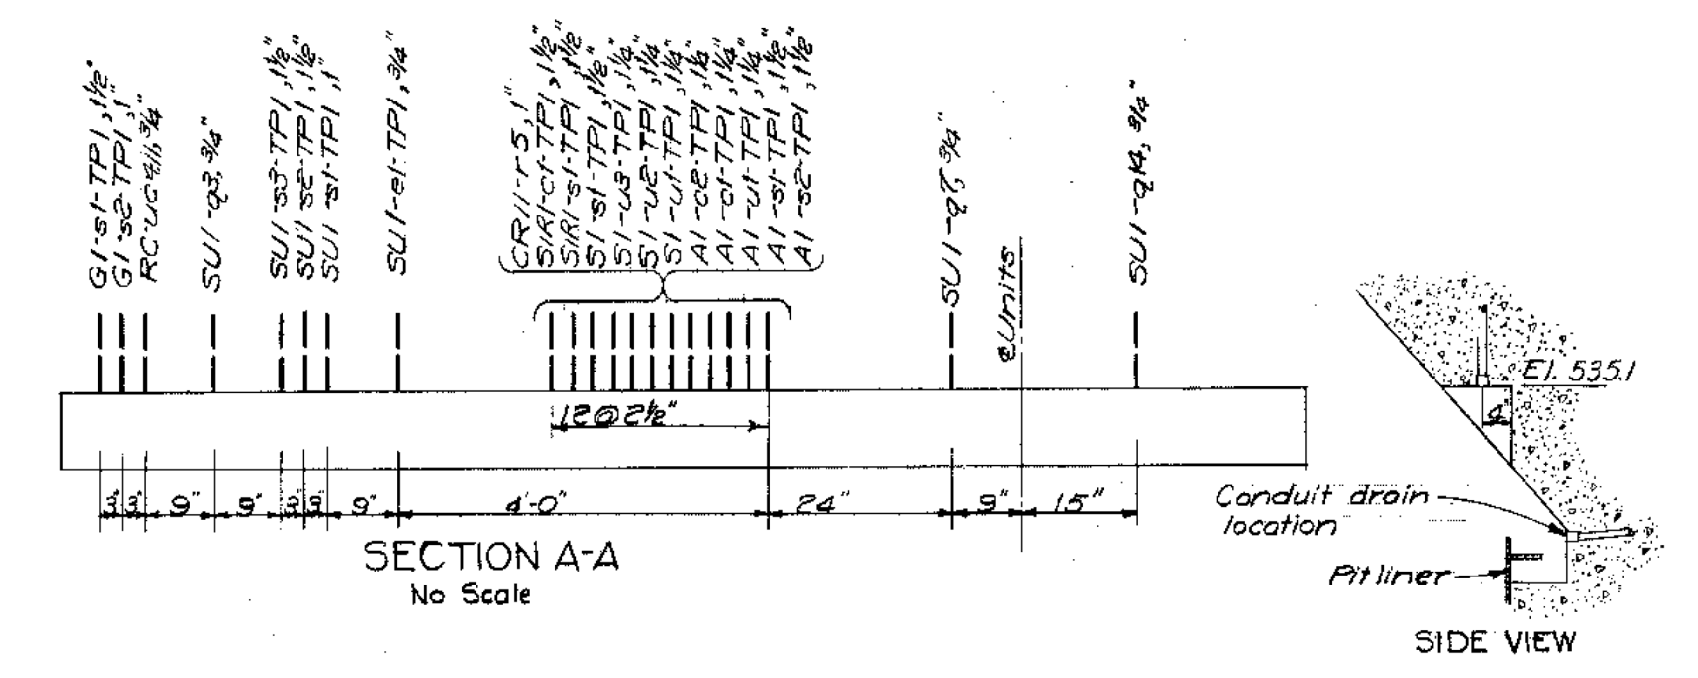

SECTION A-A
No Scale

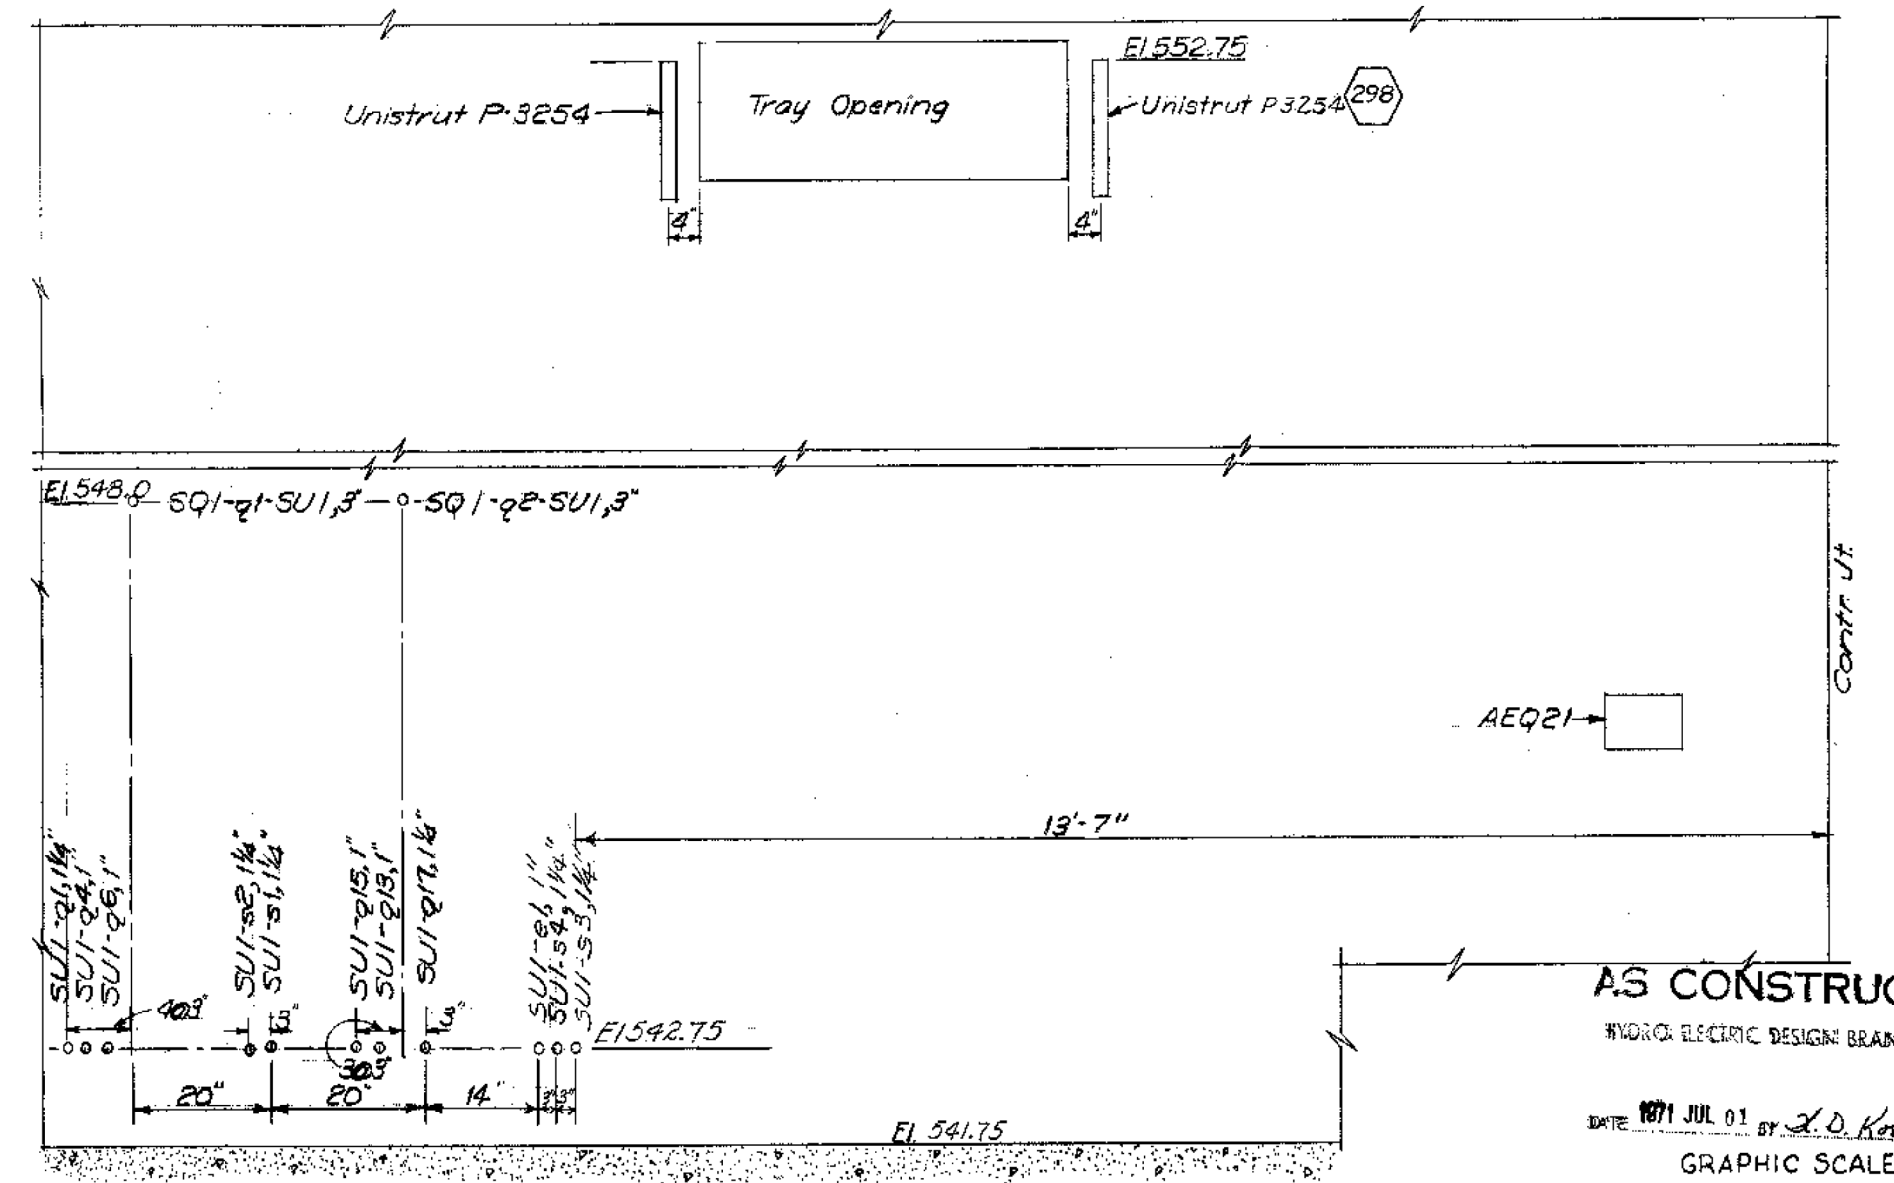

SECTION B-B
No Scale

REFERENCE DRAWINGS

- DRAWING NO. SHEET NO.
- LGP-1-6-1A13/1 61
 - LGP-1-6-1D1/1 62
 - LGP-1-6-1D1/3 64
 - LGP-1-6-1E1/2 72
 - LGP-1-6-1E1/3 73
 - LGP-1-6-1E1/5 75
 - LGP-1-6-2E1/1 106

(250) Incl
as req'd

D		Util 1 As constructed - added grounding		WOK
C		6" Unistrut Relocated Unistrut Section B-B		WHA
B		6" Unistrut Added and sleeves, changed dimensions		WHA
A		31 Mar 65 Relocated and 6" and Added Section C-C Removed Def B		WHA
REVISION	DATE	DESCRIPTION		BY
U. S. ARMY ENGINEER DIVISION, N. P. PORTLAND, OREGON				
DESIGNED BY: JY				
DRAWN BY: REF				
CHECKED BY: EMS				
PREPARED BY: JY				
SUBMITTED BY: JY				
APPROVED FOR THE ENGINEER: JY				
DATE: 4 DEC 64				
LITTLE GOOSE LOCK AND DAM POWERHOUSE DC SYSTEM AND LOW VOLTAGE SWITCHGEAR EMBEDDED CONDUIT & GROUNDING MAIN UNIT BAY 1 UPSTREAM HALF EL 542				
SCALE AS SHOWN SPEC. NO.				
LGP-1-6-1E1/1				
SHEET 71				







US Army Corps of Engineers®

ISSUE DATE: AUGUST 2002	SOLICITATION NO.: W91Z2R001	CONTRACT NO.:	DRAWING NUMBER:
DESIGNED BY:	DRAWN BY:	CHECKED BY:	SUBMITTED BY:
U.S. ARMY CORPS OF ENGINEERS WALLA WALLA DISTRICT 201 NORTH 3RD AVENUE SEATTLE, WASHINGTON			
FILENAME: R019.dgn			
SIZE: ANSI D			

LITTLE GOOSE LOCK AND DAM
POWERHOUSE
DC SYSTEM AND LOW VOLTAGE SWITCHGEAR
EMBEDDED CONDUIT & GROUNDING
MAIN UNIT BAY 1
UPSTREAM HALF EL 542

SHEET ID
R-019

FINAL

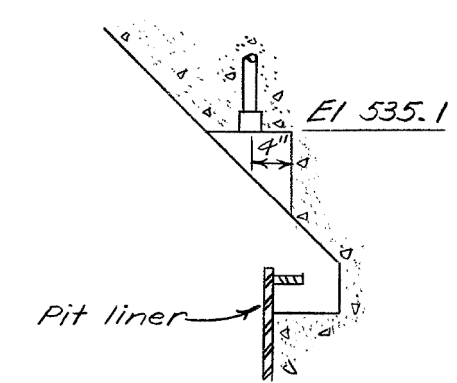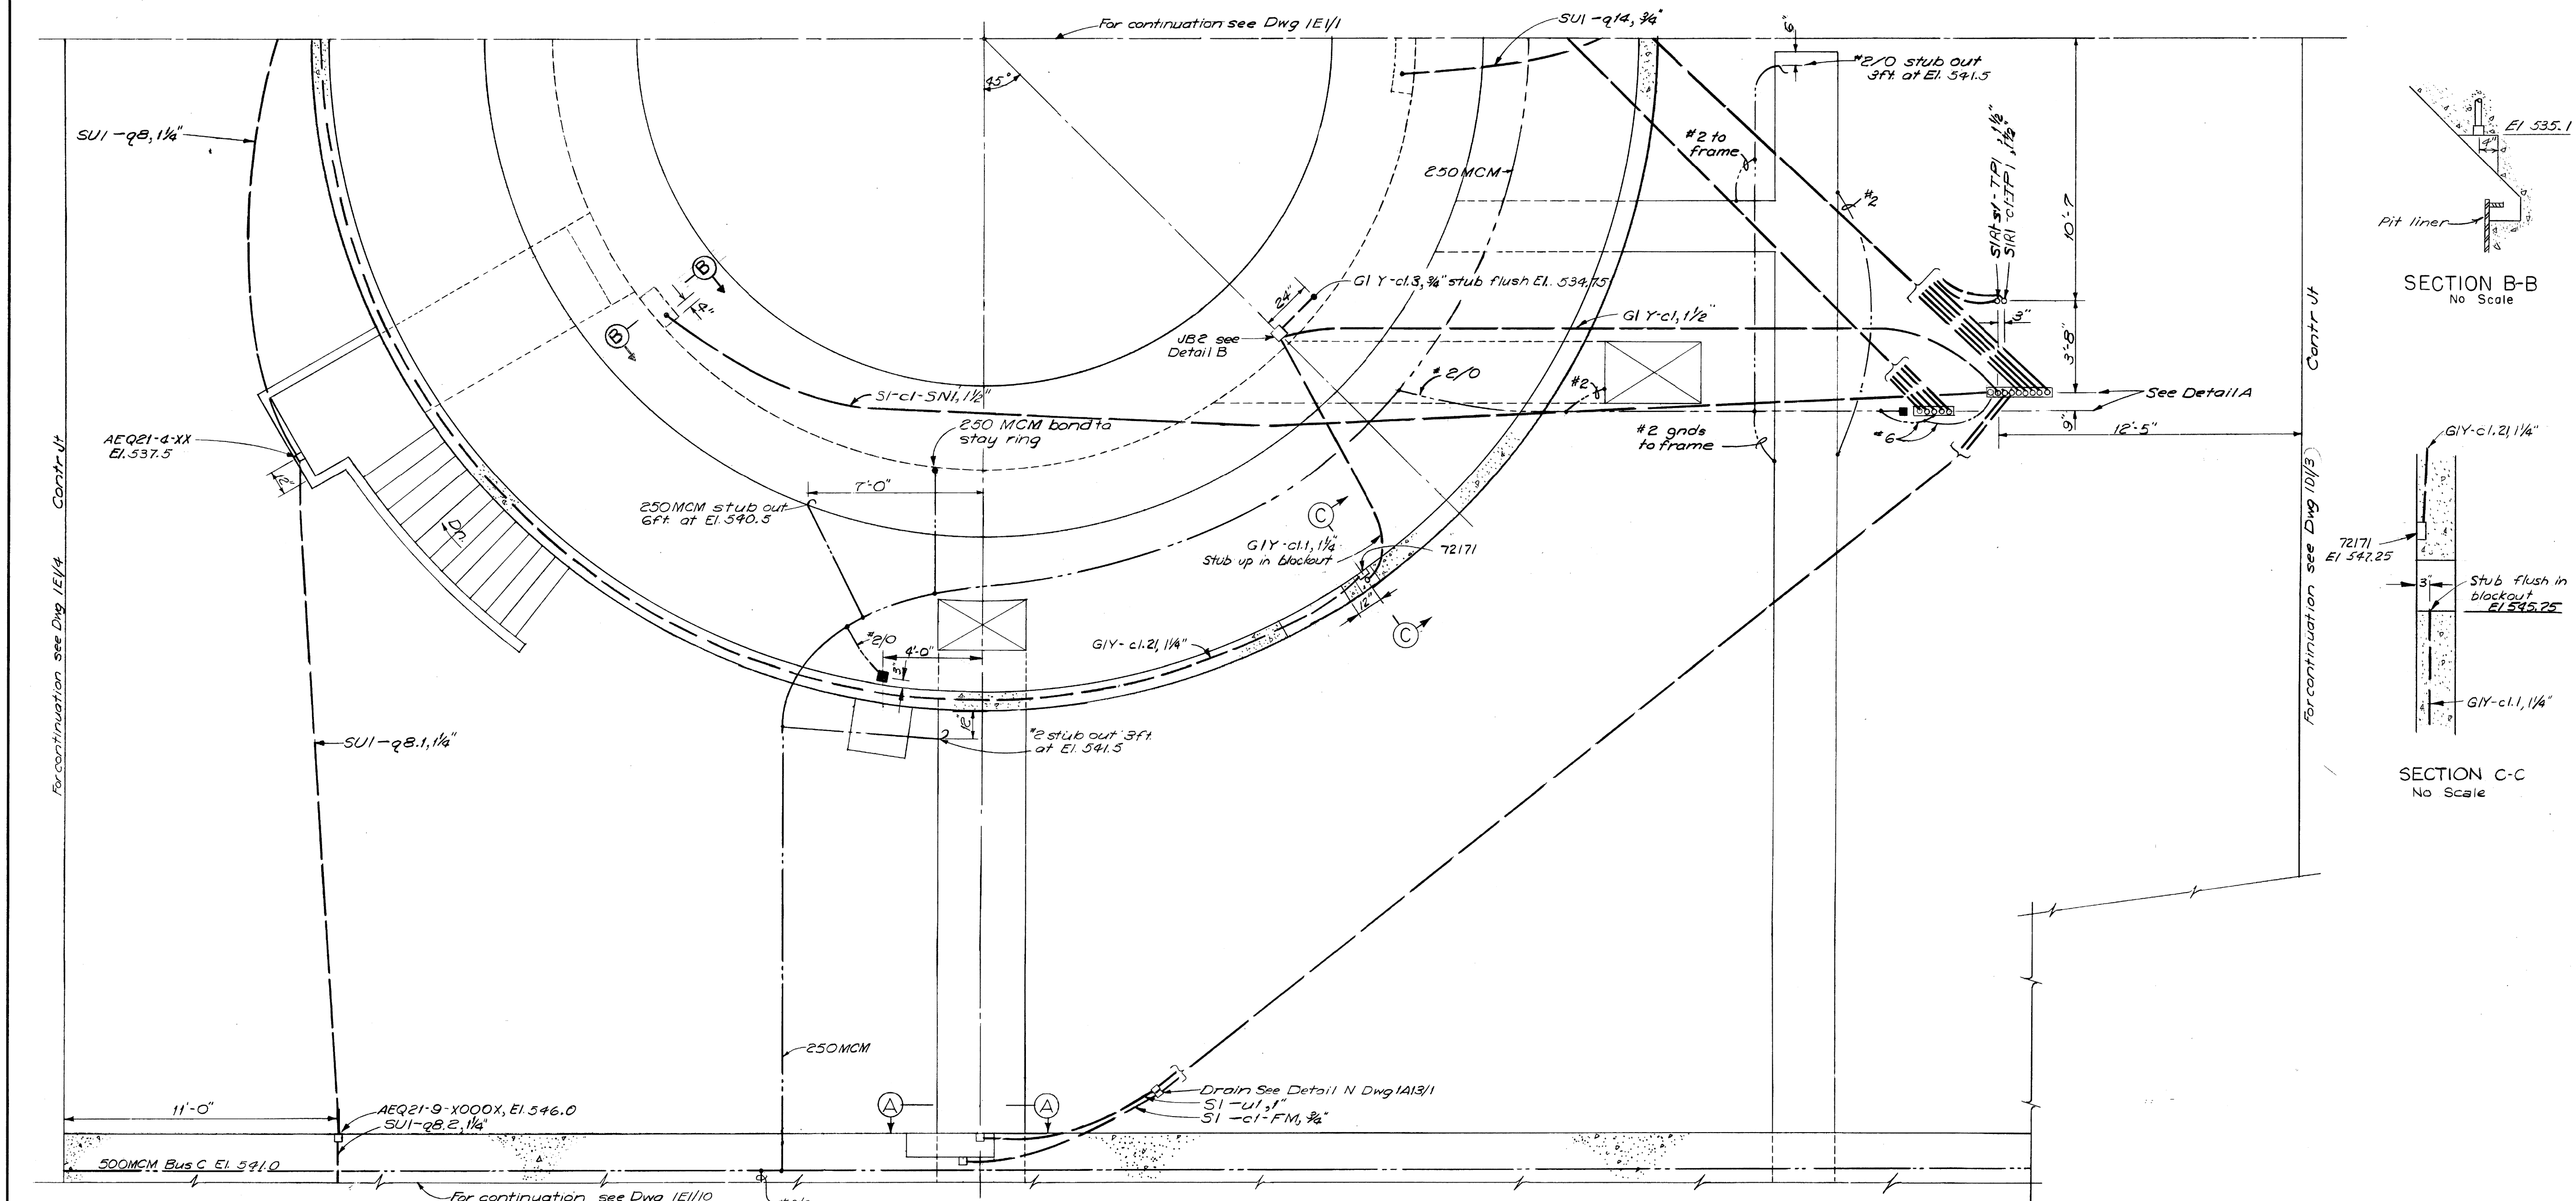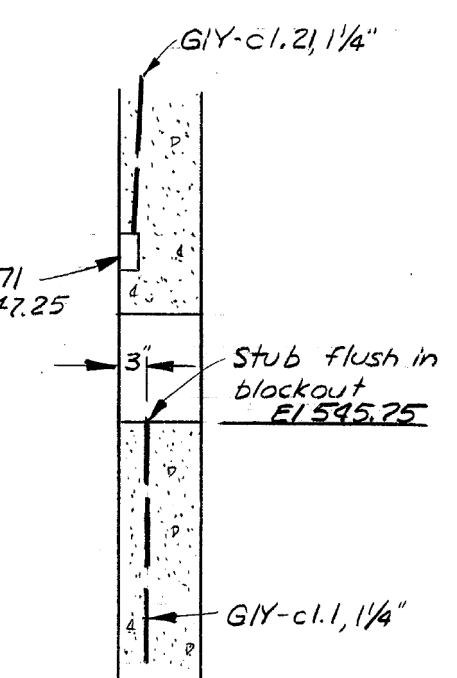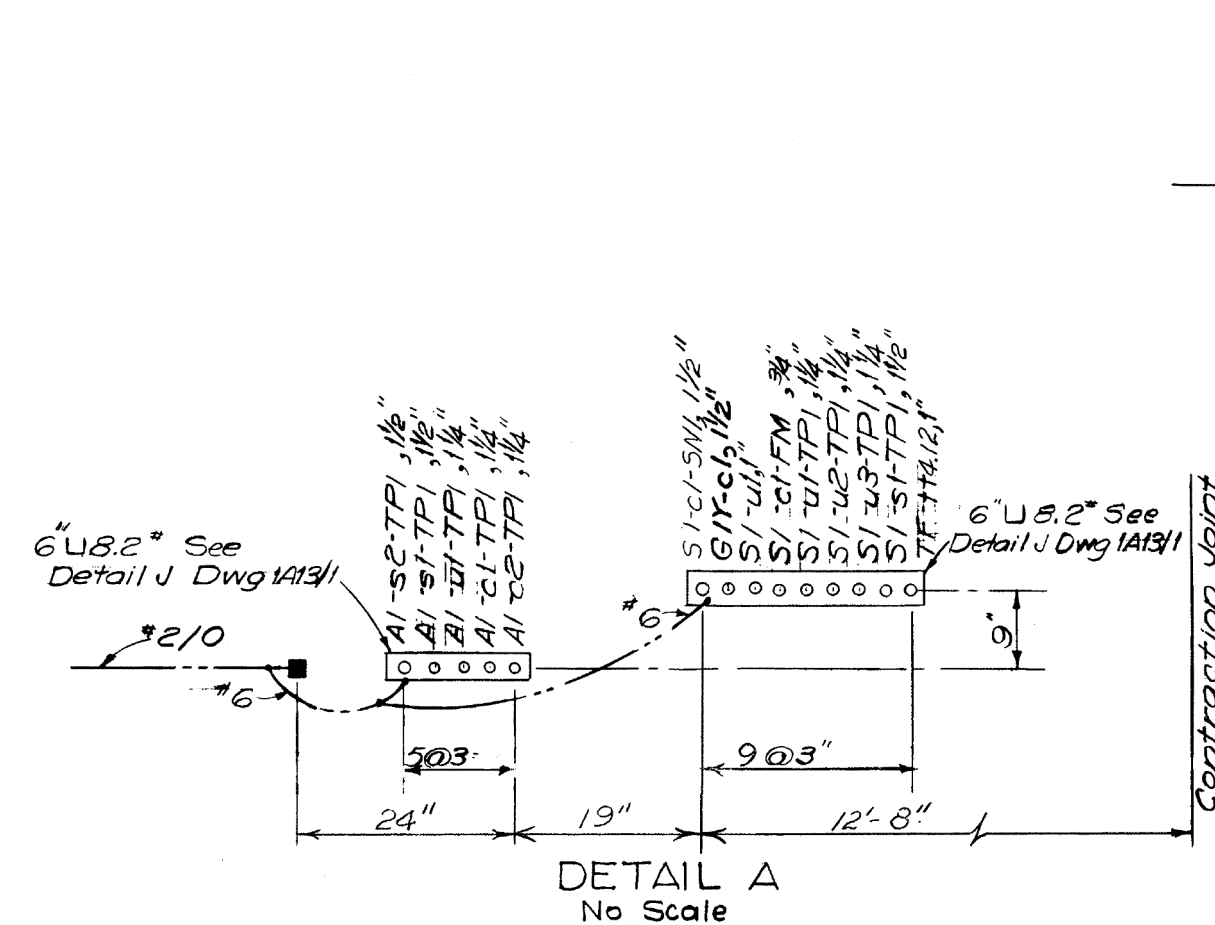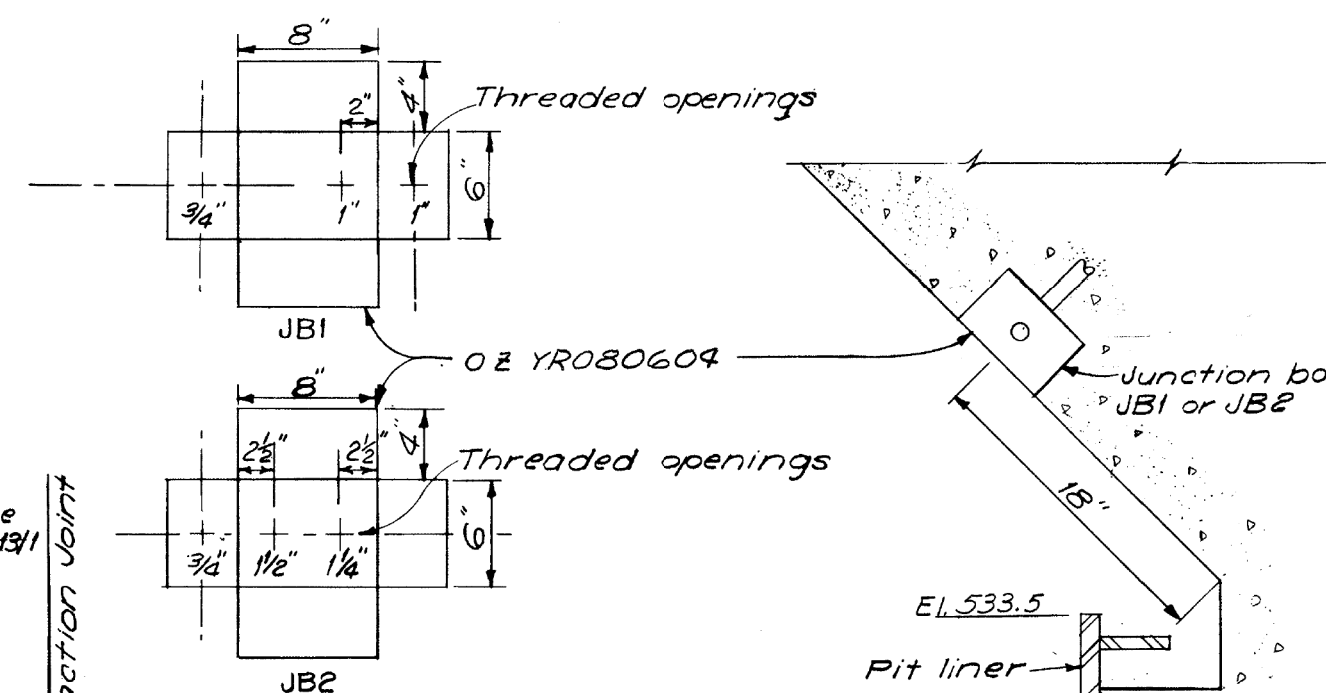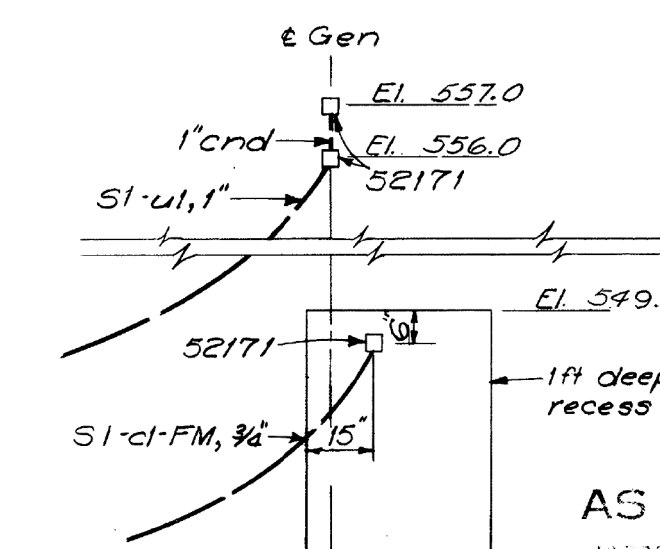US Army Corps
of Engineers®SECTION B-B
No ScaleSECTION C-C
No ScalePLAN-BAY 1 EL.542
Scale: 3/8"=1'-0"DETAIL A
No ScaleDETAIL B
No ScaleSECTION A-A
No ScaleAS CONSTRUCTED
HYDRO-ELECTRIC DESIGN BRANCH, NPD

DATE 1971 JUL 01 BY S.D. Koehler

GRAPHIC SCALE
Scale: 3/8"=1'-0"

REFERENCE DRAWINGS

DRAWING NO.	SHEET NO.
LGP-1-6-1A13/1	61
LGP-1-6-1D1/1	62
LGP-1-6-1D1/3	64
LGP-1-6-1E1/1	71
LGP-1-6-1E1/4	74
LGP-1-6-1E1/10	80

C	7 Jul 71	As constructed added grounding	WDR
B	28 Dec 68	Corrected Sec B-B, C-C, and Ref Dwg	WHR
A	31 Mar 65	Added and Section C-C Relocated gnd	WHR
REVISION	DATE	DESCRIPTION	BY
U. S. ARMY ENGINEER DIVISION, N. P. PORTLAND, OREGON			
DESIGNED BY: J.K.			
DRAWN BY: REF			
CHECKED BY: E.M.S.			
PREPARED BY: J.F. S. (Hydro-Electric Design Branch)			
SUBMITTED BY: [Signature]			
CHIEF, HYDRO-ELECTRIC DESIGN BRANCH			
APPROVED FOR DIV. ENGINEER DATE 4 DEC 64 [Signature]			
SCALE AS SHOWN SPEC. NO.			
INV. NO. CIVENG 45-164-65-16			
SHEET 72			

LITTLE GOOSE LOCK AND DAM
POWERHOUSE
DC SYSTEM AND LOW VOLTAGE SWITCHGEAR
POWERHOUSE EMBEDDED CONDUIT & GROUNDING
MAIN UNIT BAY 1
UPSTREAM HALF EL542


SHEET ID


R-020

FINAL




SHEET ID
R-021

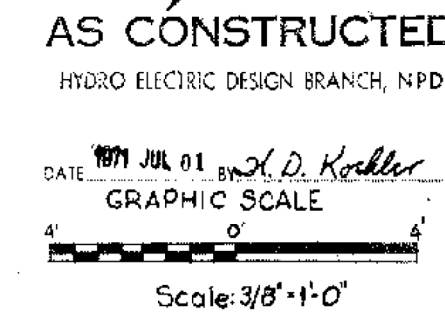

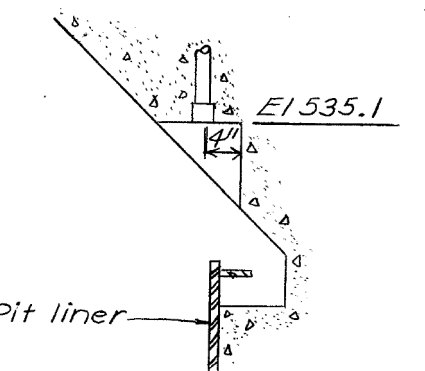

SECTION B-B
No Scale

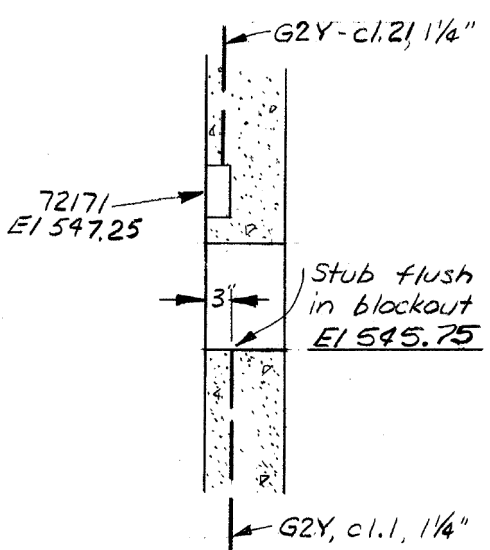


SECTION C-C
No Scale

REFERENCE DRAWINGS

DRAWING NO.	SHEET NO.
LGP-1-G-1A13/1	61
LGP-1-G-1D11/1	62
LGP-1-G-1E11/2	72
LGP-1-G-1E11/3	73
LGP-1-G-1E11/10	80
LGP-1-G-1F11/2	82

250 Incl 257 259 296
as rec'd

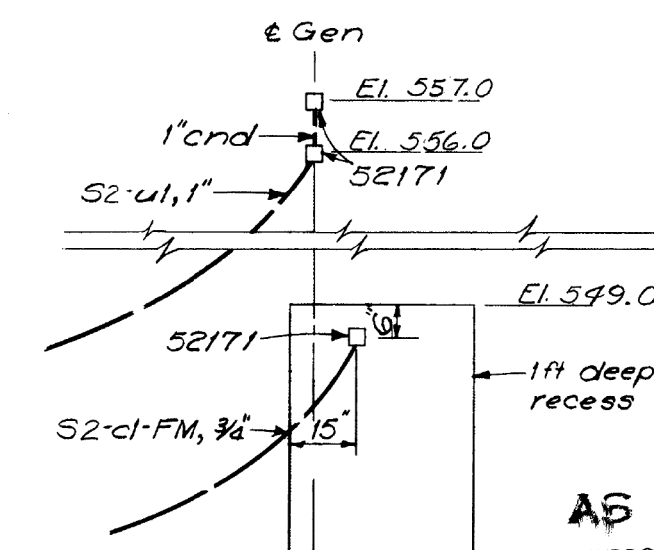


SECTION A-A
No Scale


GRAPHIC SCALE

4' 0'

Scale: $\frac{1}{8}" = 1'-0"$

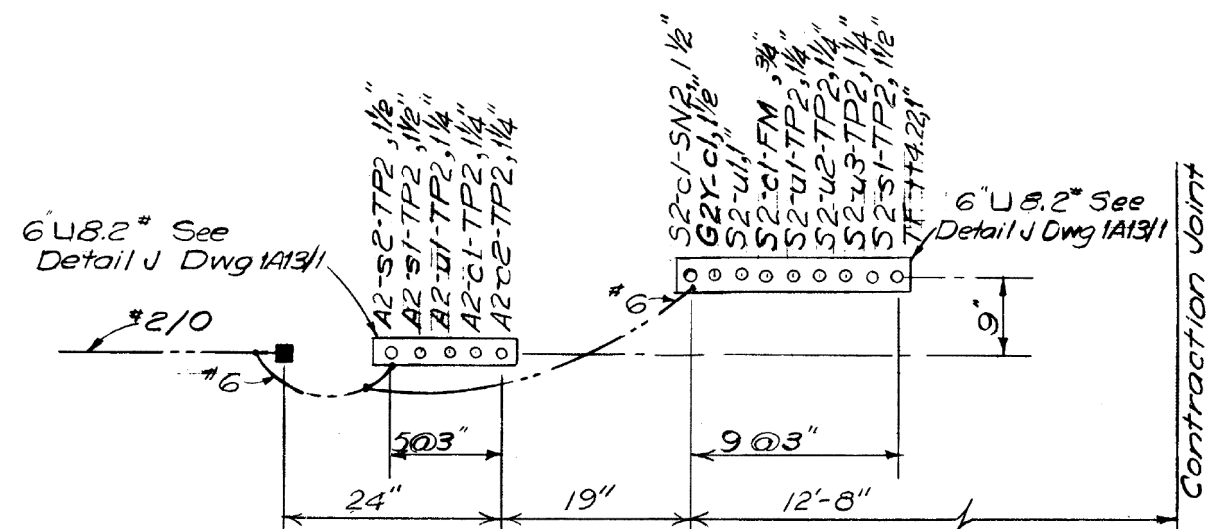

DETAIL A
No Scale

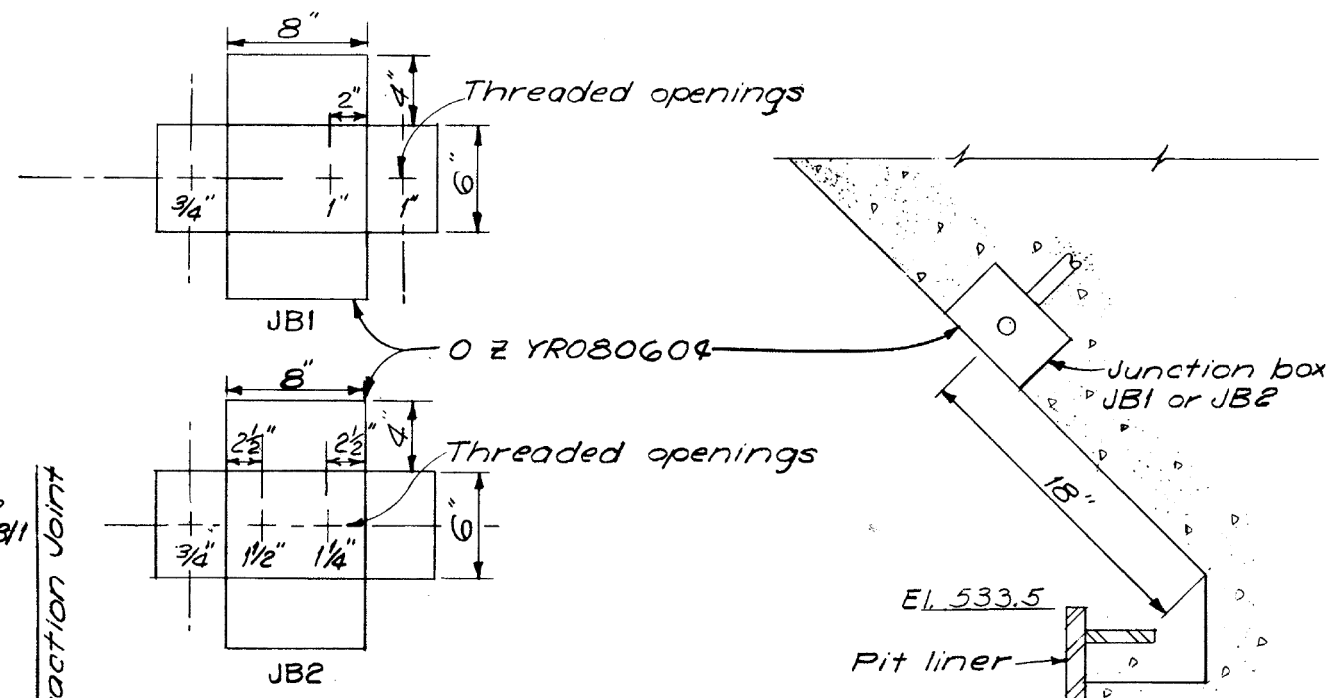

DETAIL B
No Scale


B 28 Dec 68		Corrected Section C-C		WHK	
A 31 May 69		Added end of Sec C-C. Relocated gnd.		WHK	
REVISION	DATE	DESCRIPTION			BY
<p align="center">U. S. AIR ENGINEER DIVISION. N. P. PORTLAND, OREGON</p>					
DESIGNED BY: <i>J.Y.</i>		<p align="center">LITTLE GOOSE LOCK AND DAM SNAKE RIVER, OREGON, WASHINGTON & IDAHO POWERHOUSE</p>			
DRAWN BY: <i>REC</i>		<p align="center">EMBEDDED CONDUIT & GROUNDING MAIN UNIT BAY 2</p>			
CHECKED BY: <i>EMS</i>		<p align="center">DOWNSTREAM HALF EL 542</p>			
PREPARED BY: <i>W. J. Fisher</i> HEAD, ELECTRICAL SECTION		APPROVED FOR DIV. ENGINEER DATE: 4 DEC. 69 <i>W. J. Fisher</i> CHIEF ENGINEERING DIVISION			
SUBMITTED: <i>Richard M. Smith</i> CHIEF, HYDRO-ELECTRIC DESIGN BRANCH		SCALE AS SHOWN		SPEC. NO.	
INV. NO. GIVING 45-104-35-1B		<p align="center">LGP-1-6-IEI/4</p>			

POWERHOUSE
DC SYSTEM AND LOW VOLTAGE SWITCHGEAR




POWERHOUSE EMBEDDED CONDUIT & GROUNDING
MAIN UNIT BAY 2
DOWNSTREAM HALF EL542

SHEET ID

R-022

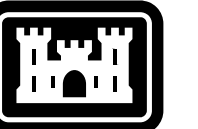

US Army Corps of Engineers®

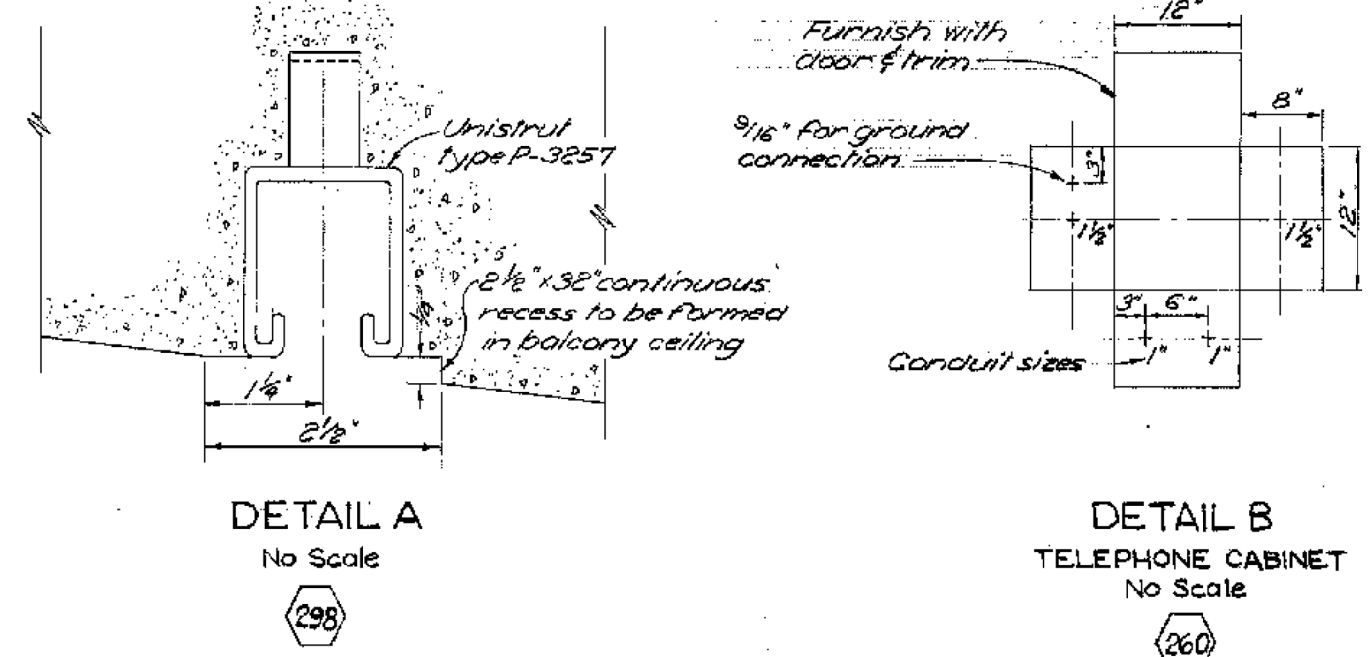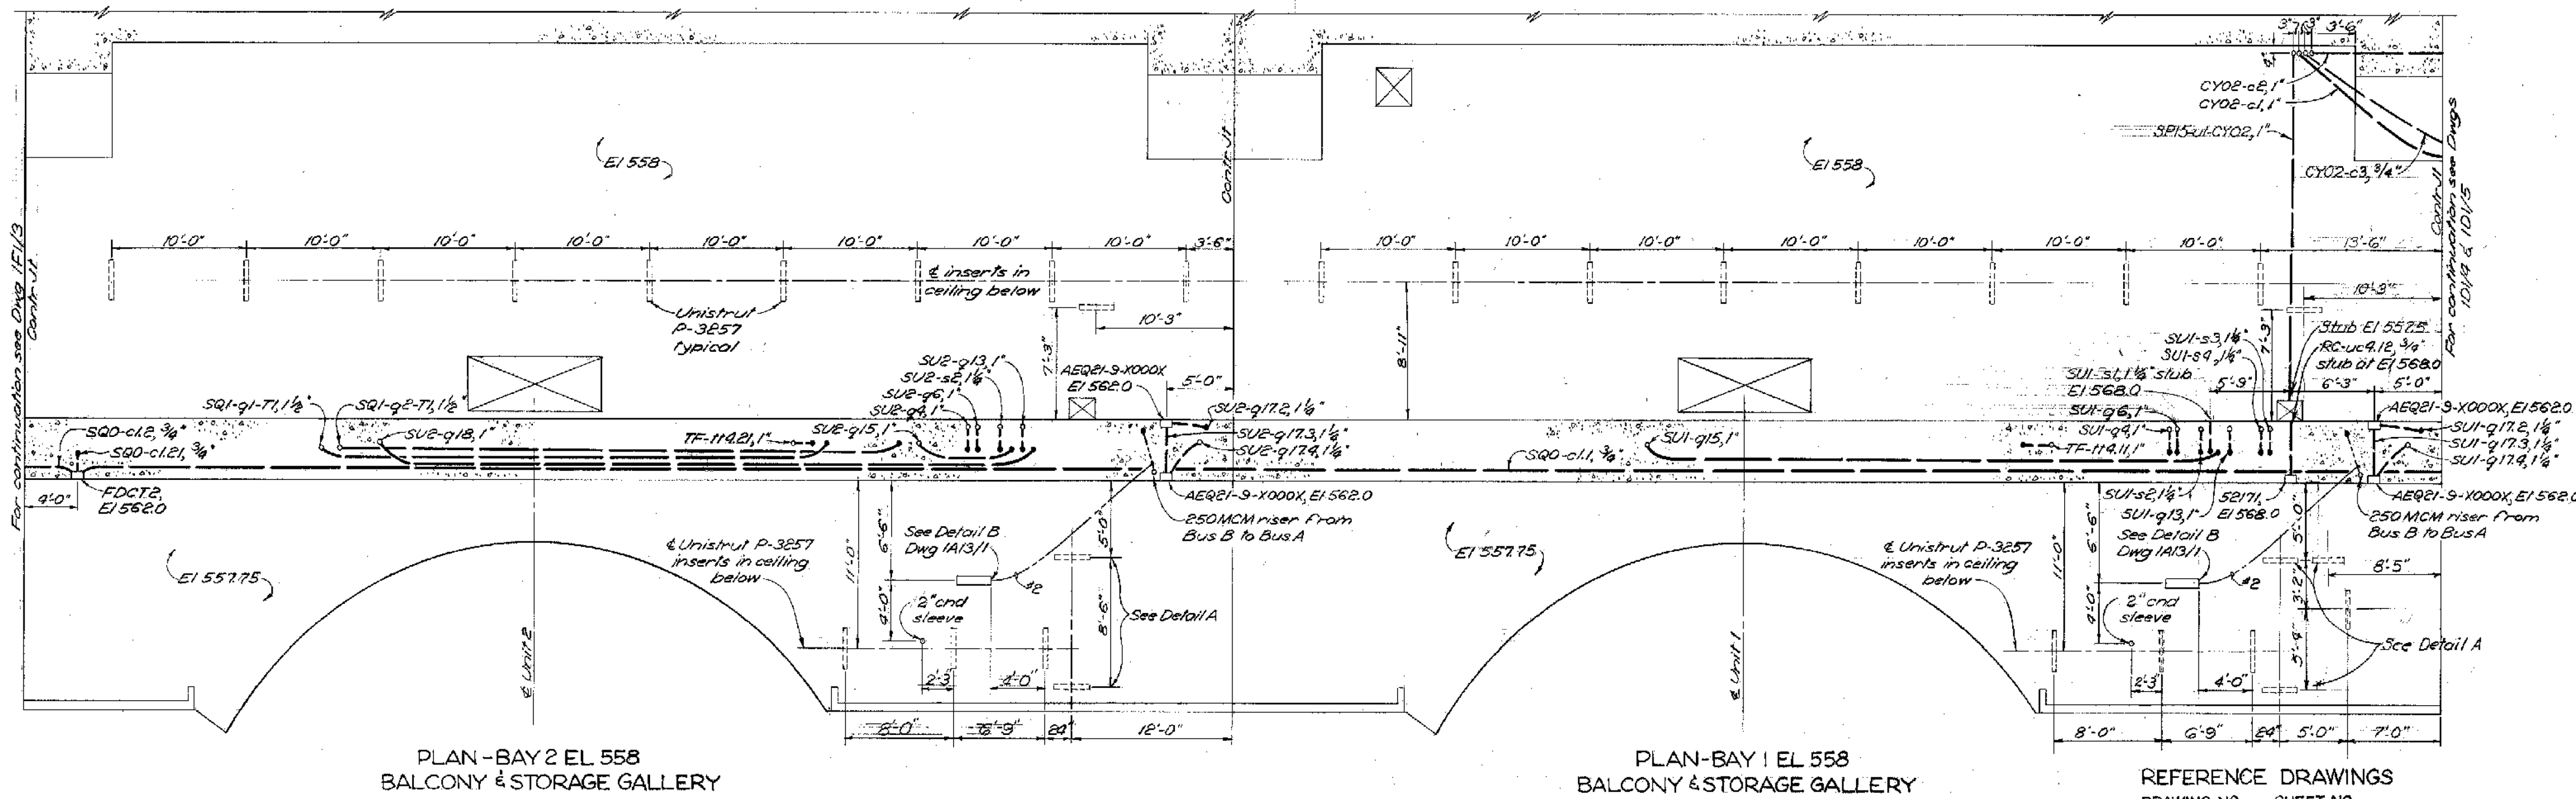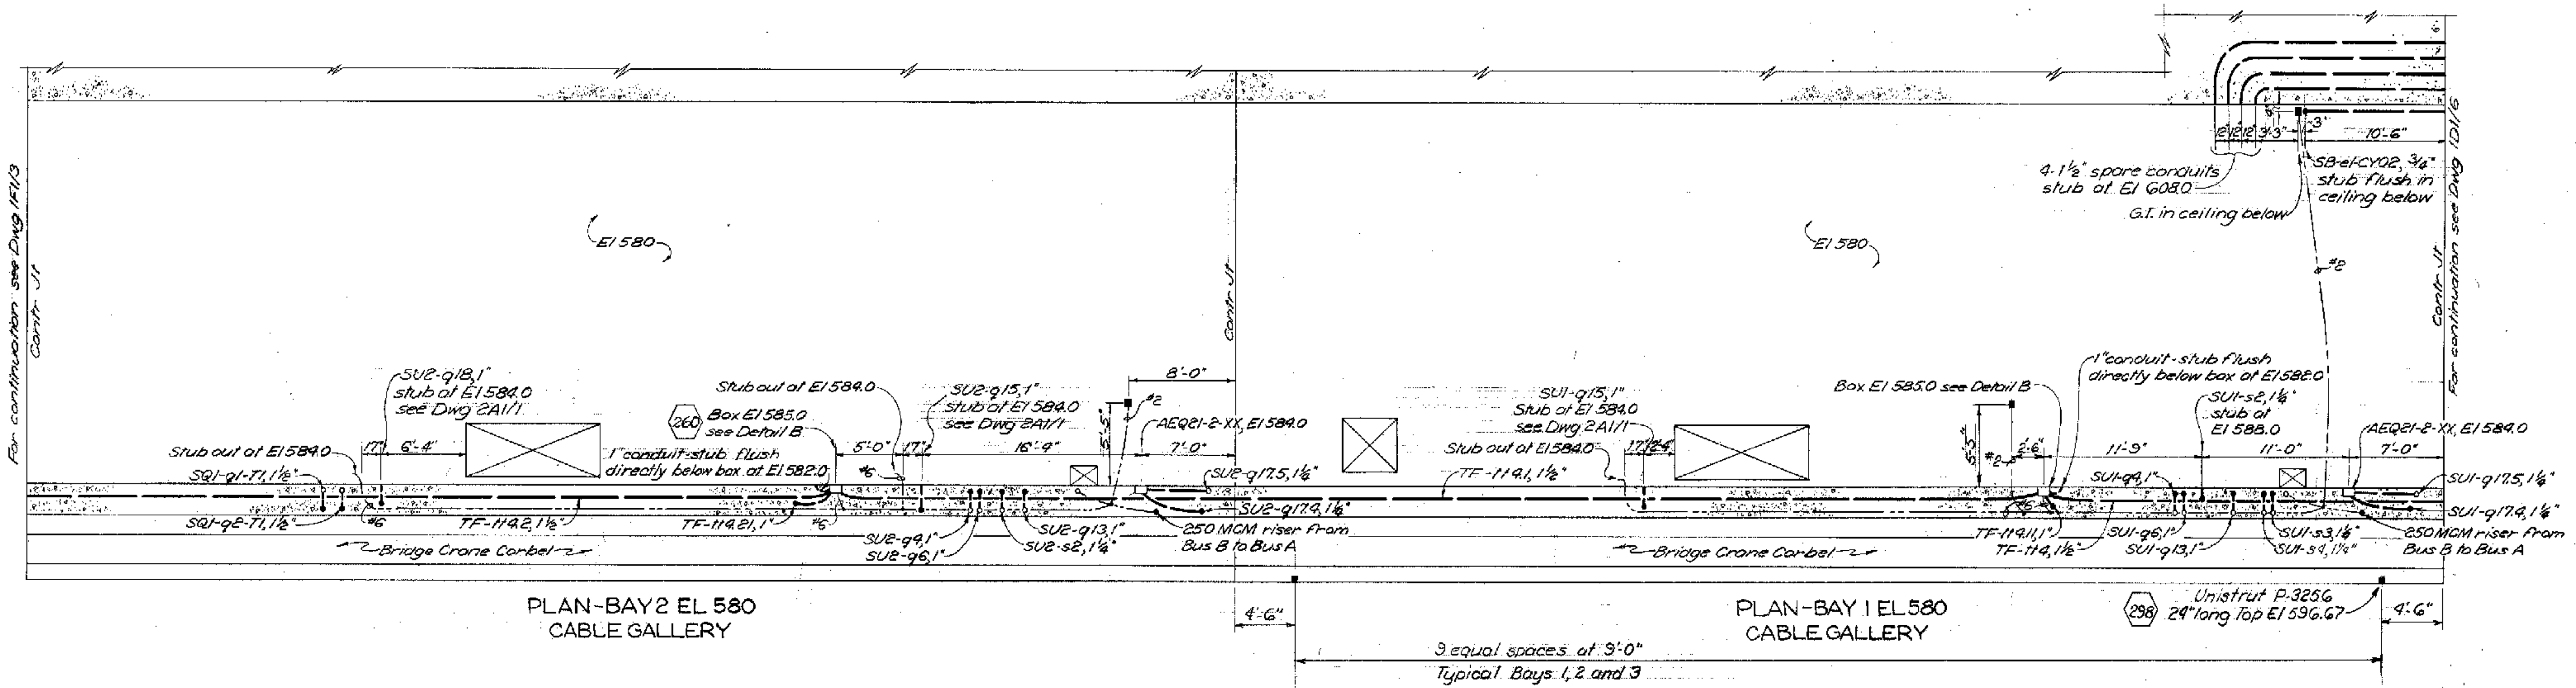

REFERENCE DRAWINGS

DRAWING NO.	SHEET NO.
LGP-1-6-1A13/1	61
LGP-1-6-1D1/1	62
LGP-1-6-1D1/4	65
LGP-1-6-1D1/5	68
LGP-1-6-1D1/6	67
LGP-1-6-1E1/1	71
LGP-1-6-1E1/3	73
LGP-1-6-1E1/6	76
LGP-1-6-1E1/7	77
LGP-1-6-1F1/3	83
LGP-1-6-2A1/1	87

AG CONSTRUCTED
FIELD ELECTRIC DESIGN BRANCH, NPD
DATE 1071 JUL 01 BY J.D. Kishler
GRAPHIC SCALE
3/16" = 1'-0"




C 7/10/1 As constructed added inserts WDX			
B 3/10/65 Relocated inserts, changed end designation WDX			
A 1/6/65 Changed end dimensions WDX			
REVISION	DATE	DESCRIPTION	BY
U. S. ARMY ENGINEER DIVISION, N. P. PORTLAND, OREGON			
DESIGNED BY: J.L.S.			
DRAWN BY: P.J.L.			
CHECKED BY: E.M.S.			
PREPARED BY: J. Kishler			
SUBMITTED BY: J. Kishler			
APPROVED FOR DIV. ENGINEER DATE: 4 DEC 64			
SCALE AS SHOWN SPEC. NO.			
INV. NO. CIVENS 45-104-65-18			
LGP-1-6-1E1/5			
SHEET 75			

ISSUE DATE: AUGUST 1962	DESIGNED BY: J.L.S.
SOLICITATION NO.: W91ZELZ0001	DRAWN BY: P.J.L.
CONTRACT NO.:	CHECKED BY: E.M.S.
DRAWING NUMBER:	SUBMITTED BY: J. Kishler
FILENAME: R-023.dgn	SIZE: ANSI D

U.S. ARMY CORPS OF ENGINEERS
WALLA WALLA DISTRICT
201 NORTH 3RD AVENUE
SEATTLE, WASHINGTON

LITTLE GOOSE LOCK AND DAM
POWERHOUSE
DC SYSTEM AND LOW VOLTAGE SWITCHGEAR
POWERHOUSE EMBEDDED CONDUIT & GROUNDING
MAIN UNIT GALLERIES 1 & 2
EL 558 & 580

SHEET ID
R-023

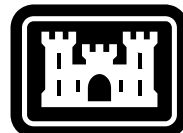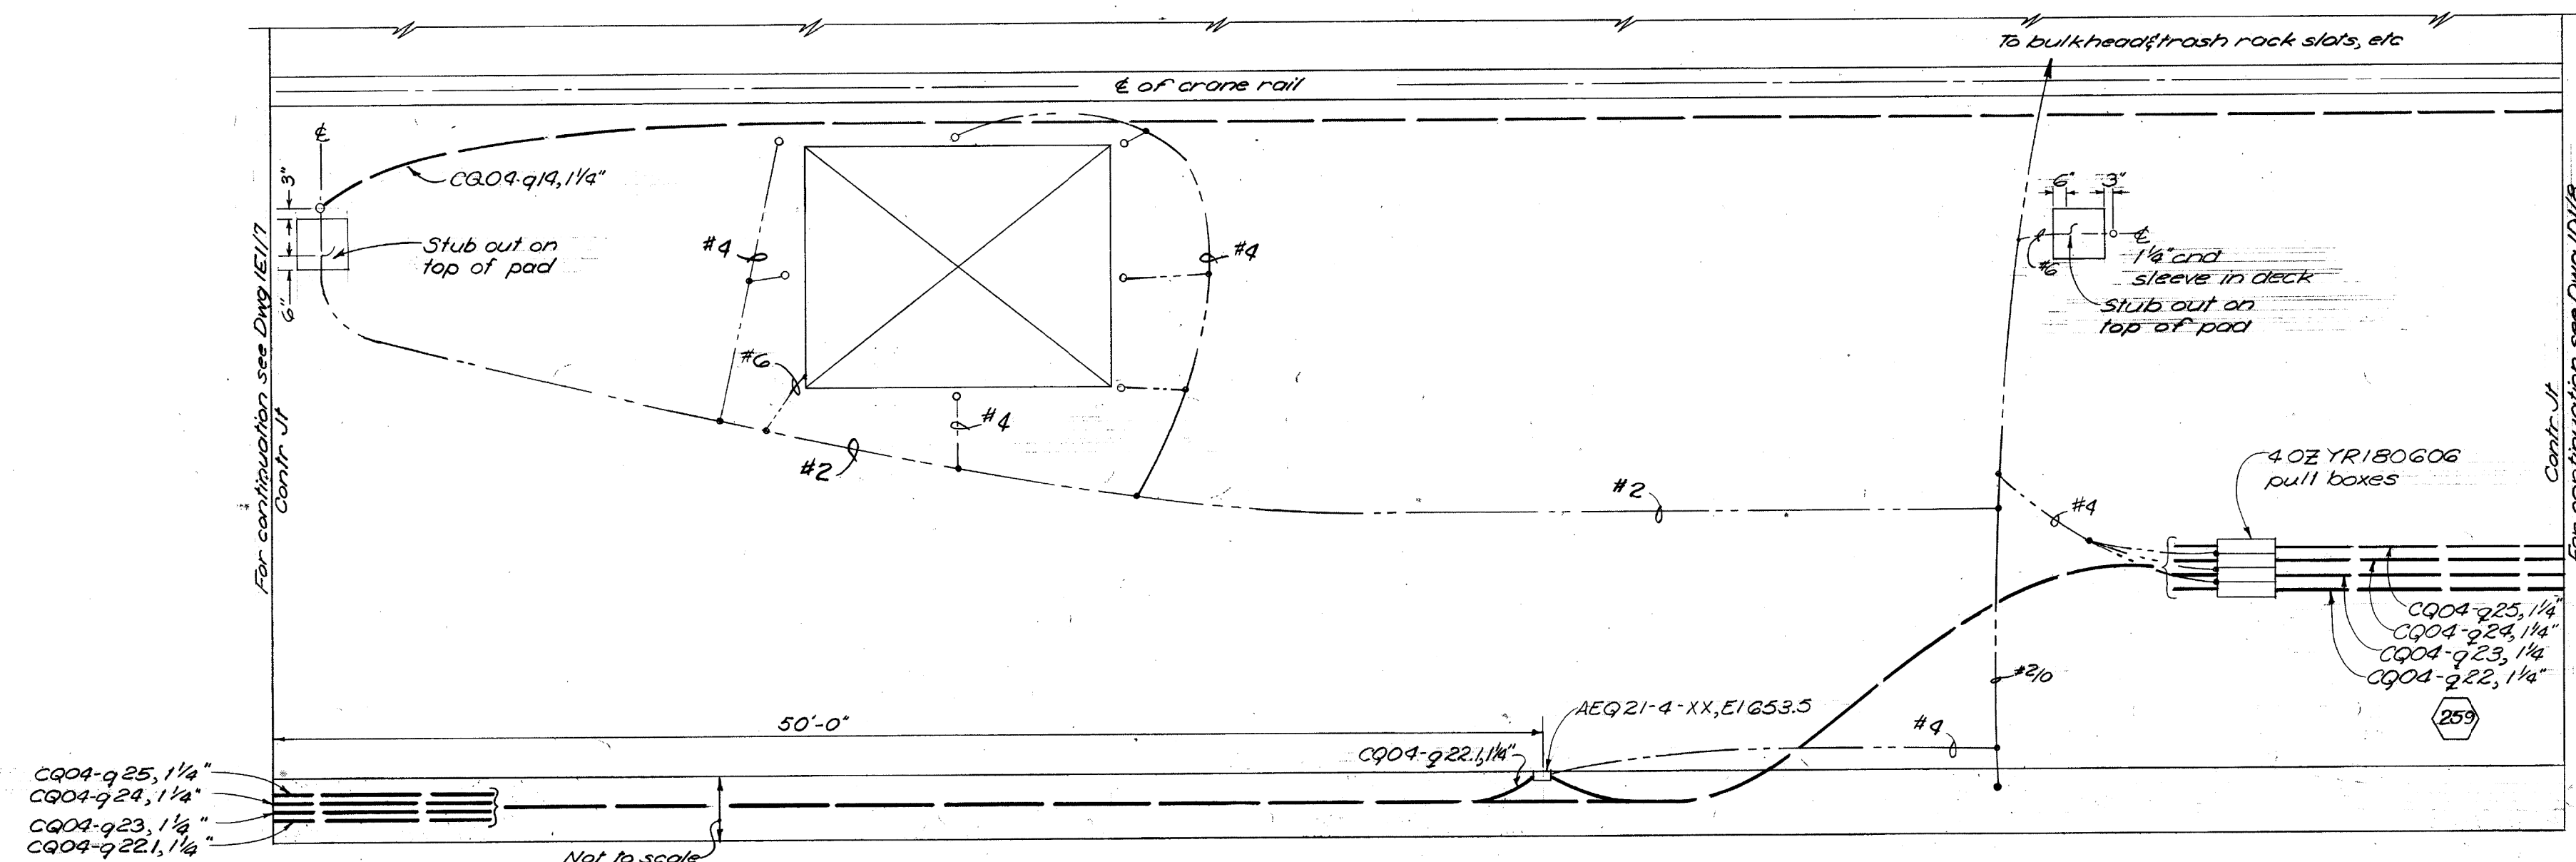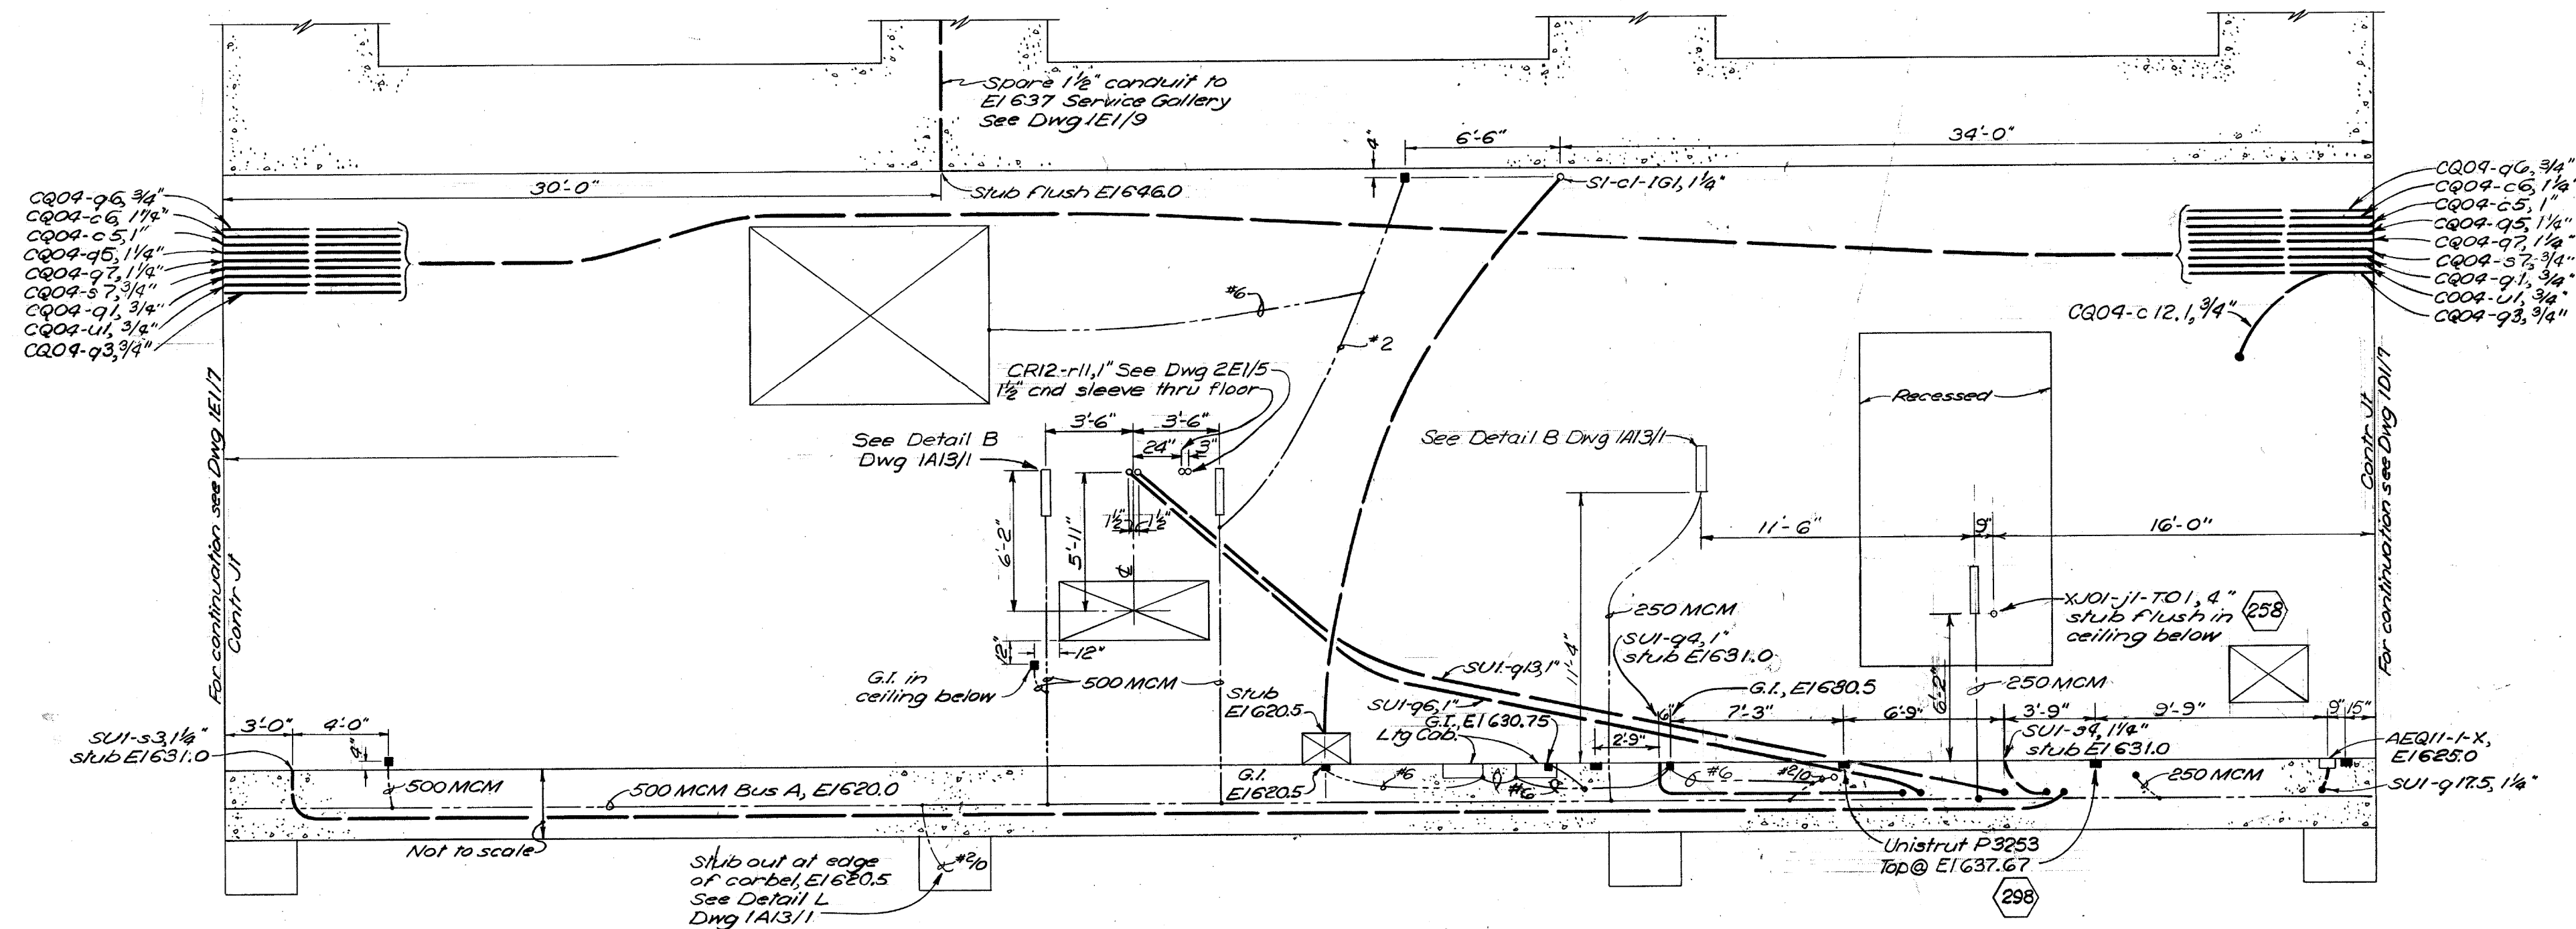
US Army Corps
of Engineers®PLAN-BAY 1 EL 651
INTAKE DECKPLAN - BAY 1 EL 621
CIRCUIT BREAKER GALLERY

REFERENCE DRAWINGS

DRAWING NO.	SHEET NO.
LGP-1-6-1A13/1	61
LGP-1-6-1D1/1	62
LGP-1-6-1D1/7	68
LGP-1-6-1D1/8	69
LGP-1-6-1E1/5	75
LGP-1-6-1E1/7	77
LGP-1-6-1E1/9	79

250 Incl
as req'dAS CONSTRUCTED
HYDRO-ELECTRIC DESIGN BRANCH, NPD

1971 JUL 1 BY J.D. Korhonen

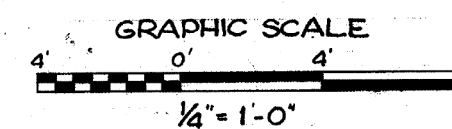


C	17 Jul 71	As constructed add grounding, conduit	WJK
B	17 Jul 71	Relocated and changed end & size	WJR
A	17 Jul 71	Relocated and changed	WJR
REVISION	DATE	DESCRIPTION	BY
U. S. ARMY ENGINEER DIVISION, N. P. PORTLAND, OREGON			
DESIGNED BY: JLS			
DRAWN BY: PJL			
CHECKED BY: EMS			
PREPARED BY: J.F. Fisher HEAD, ELECTRICAL SECTION			
SUBMITTED BY: [Signature]			
CHIEF, HYDRO-ELECTRIC DESIGN BRANCH			
INV. NO. CIVENG-45-164-65-18			
APPROVED FOR DDA BY ENGINEER DATE 4 DEC 64 [Signature] CHIEF, ENGINEERING DIVISION			
SCALE AS SHOWN SPEC. NO.			
LGP-1-6-1E1/6			
SHEET 76			

LITTLE GOOSE LOCK AND DAM
POWERHOUSE
DC SYSTEM AND LOW VOLTAGE SWITCHGEAR
POWERHOUSE EMBEDDED CONDUIT & GROUNDING
MAIN UNIT GALLERY & INTAKE DECK
BAY 1 EL 621 & 651


SHEET ID

R-024

FINAL

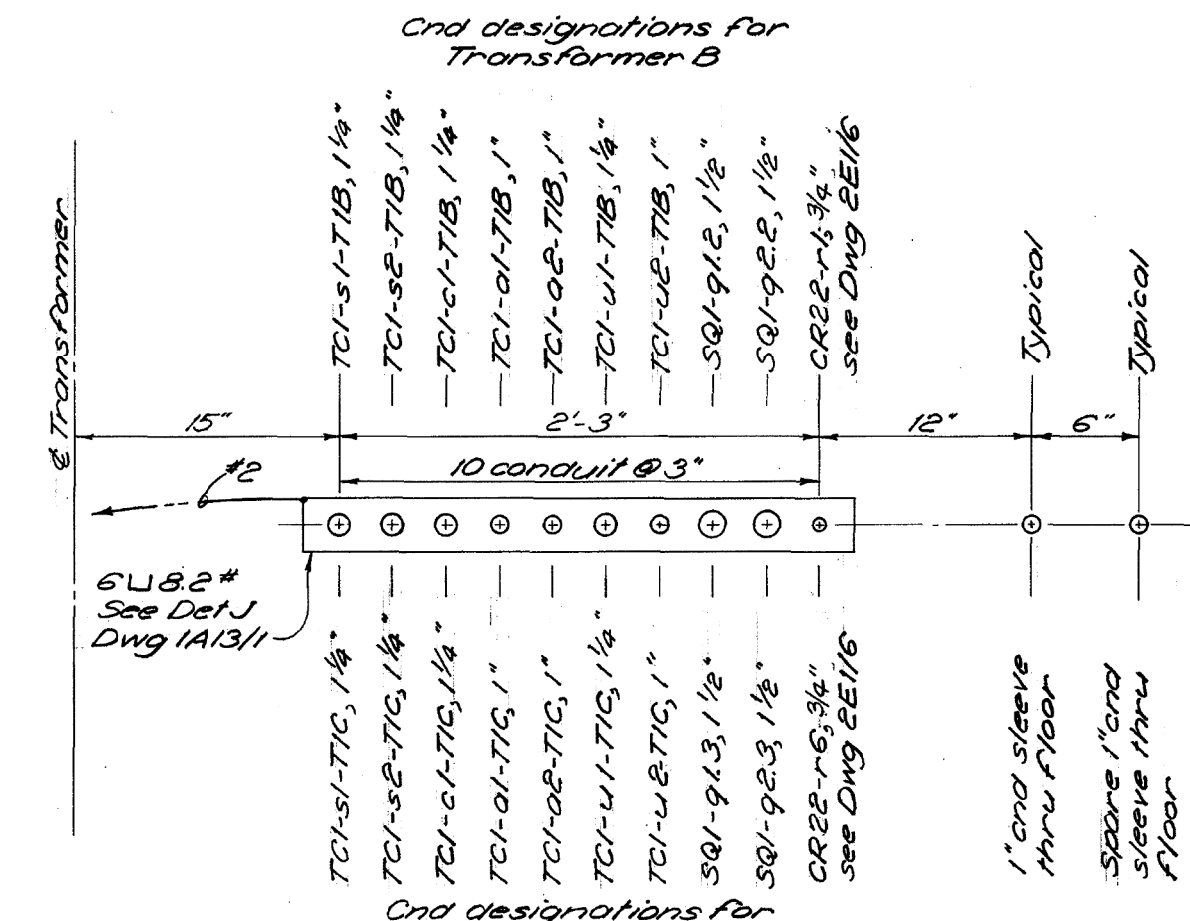


DETAIL A
No Scale

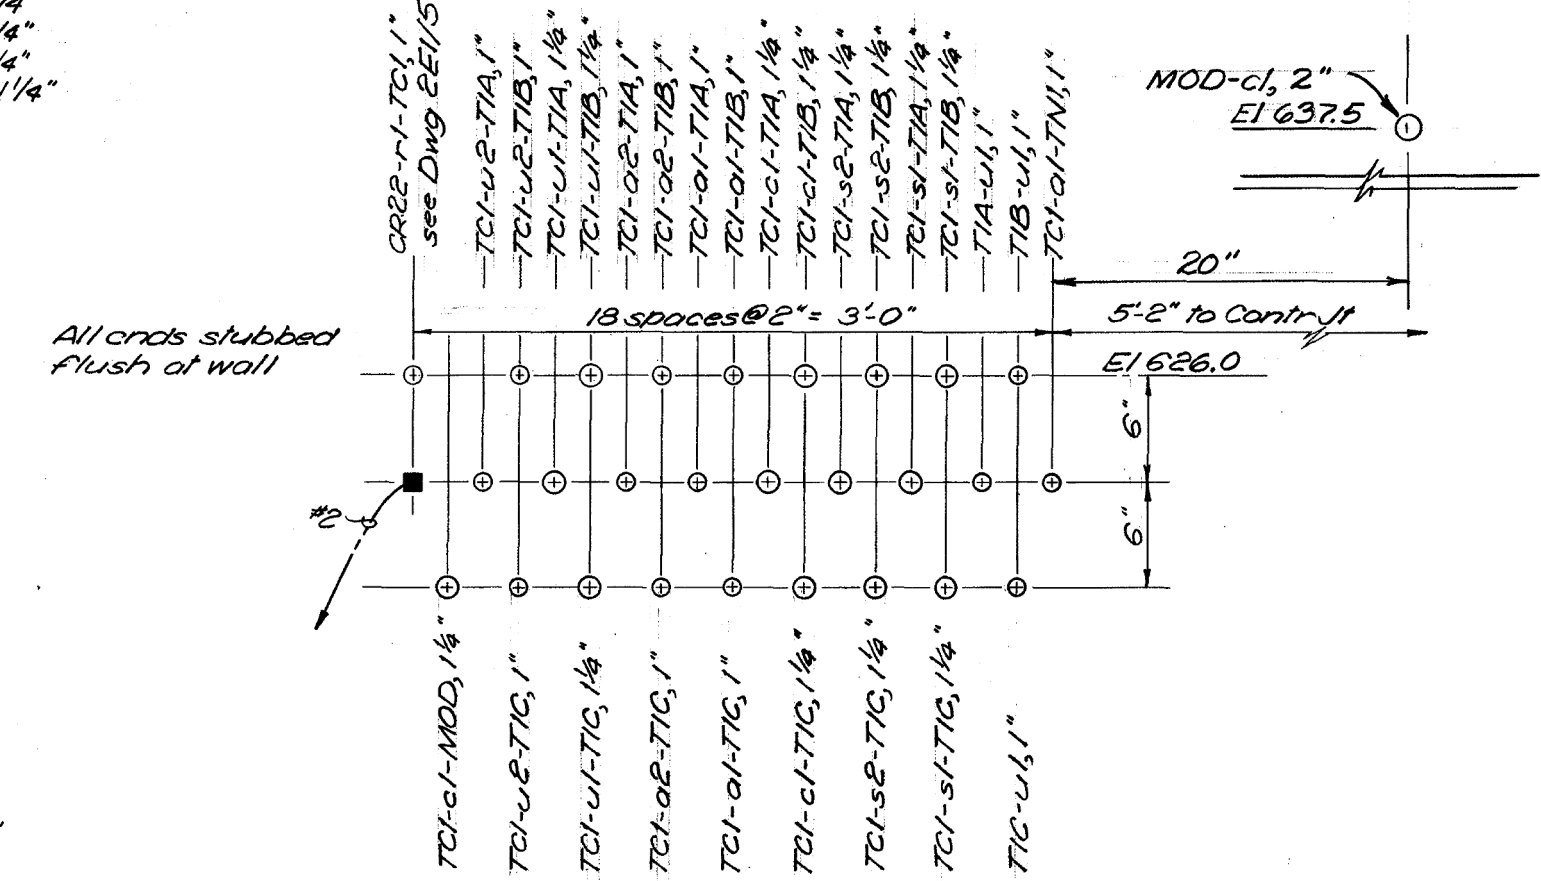

SECTION A-A
No Scale

LGP-1-6-1A13/1	61
LGP-1-6-1D1/1	62
LGP-1-6-1E1/5	75
LGP-1-6-1E1/6	76
LGP-1-6-1F1/4	84
LGP-1-6-2E1/5	110
LGP-1-6-2E1/6	111

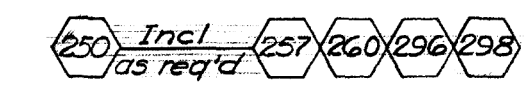

D	7Jul61	As constructed - minor changes	WDR
C	8Feb67	Relocated cnd	WDR
B	6Jun66	Relocated cnd & gnd, changed cnd size	WHR
A	31Mar63	Relocated cnd & gnd, added gnd.	WHR
REVISION	DATE	DESCRIPTION	BY

~~INV. NO. CIVENG~~

LGP-1-6-1E1/7

VOL. NO. IV

GRAPHIC SCALE
4' 0' 4'

$$1/4^{\circ} = 1' - 0''$$

VOL. NO. IV


POWERHOUSE
DC SYSTEM AND LOW VOLTAGE SWITCHGEAR

POWERHOUSE EMBEDDED CONDUIT & GROUNDING
MAIN UNIT GALLERY & INTAKE DECK
BAY 2 EL 621 & 651


SHEET ID

R-025

FINAL

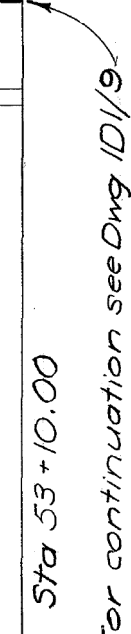

BAY 1

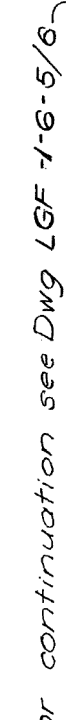

BAY 4



1. Stub out conduits at El 558.25 and cap GI to be installed flush with top surface of finished grout fill.

REFERENCE DRAWINGS	
DRAWING NO.	SHEET NO.
LGP-1-G-1A1/3	61
LGP-1-G-1D1/1	62
LGP-1-G-1D1/9	70
LGP-1-G-1E1/10	80
LGP-1-G-1F1/5	85
LGP-1-G-2A1/4	90

250 *incl as rec'd* 257 259 256

B	31 Mar 62	Relocated end, changed Note & Detail A.	W
A	1 Feb 63	Added grd cable and relocated end.	W
REVISION	DATE	DESCRIPTION	
<p align="center">U. S. ARMY ENGINEER DIVISION. N. P. PORTLAND, OREGON</p>			
DESIGNED BY: <i>JLS</i>		LITTLE GOOSE LOCK AND DAM	
DRAWN BY: <i>REF</i>		SNAKE RIVER, OREGON, WASHINGTON & IDAHO	
CHECKED BY: <i>ATO</i>		POWERHOUSE	
PREPARED:		EMBEDDED CONDUIT & GROUNDING	
HEAD, ELECTRICAL SECTION		TAILRAKE DECK EL 558	
		MAIN UNIT BAYS	
SUBMITTER: <i>[Signature]</i> CHIEF, HYDRO-ELECTRIC DESIGN BRANCH		APPROVED FOR CHIEF, ENGINEER DATE: 4 DEC 62 <i>[Signature]</i> CHIEF, HYDRO-ELECTRIC DIVISION SCALE AS SHOWN SPEC. NO. _____ SHEET 78 LGP-1-6-1E1/8	


~~CONT NO. 65 560~~

VOL NO. IV


SHEET ID

R-026

FINAL

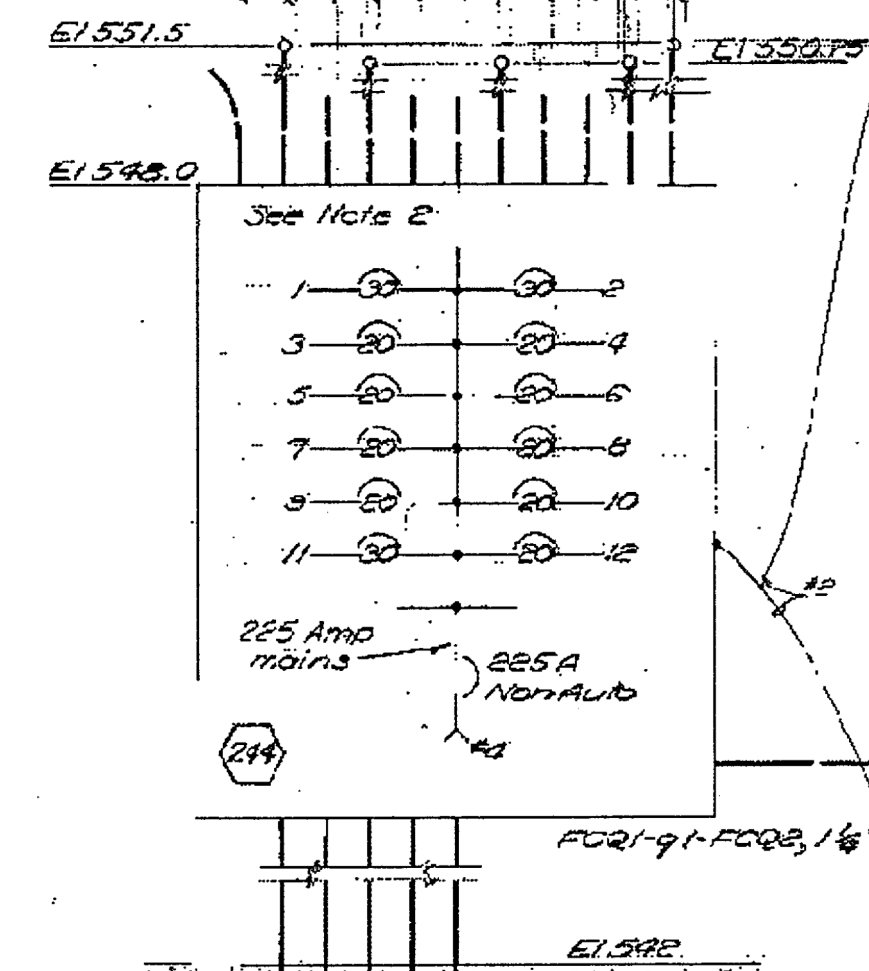


SECTION A-A (FCQI)
No Scale

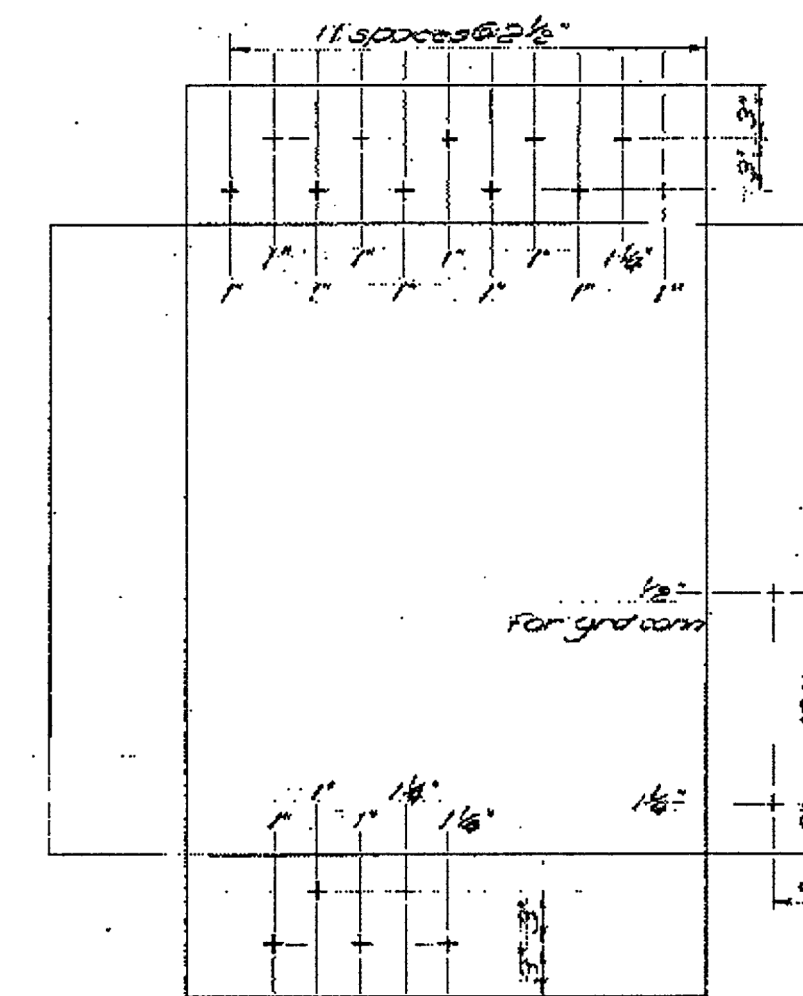


FCQI DRILLING
(Conduit Sizes Shown)
No. Scale

1. Furnish and install cable for FCQ1 & FCQ2 as shown in schedule.


2. All breakers shall be equipped with ball alarm contacts.

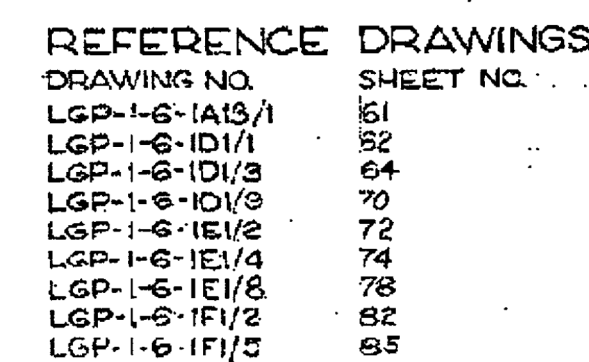

REFERENCE DRAWINGS

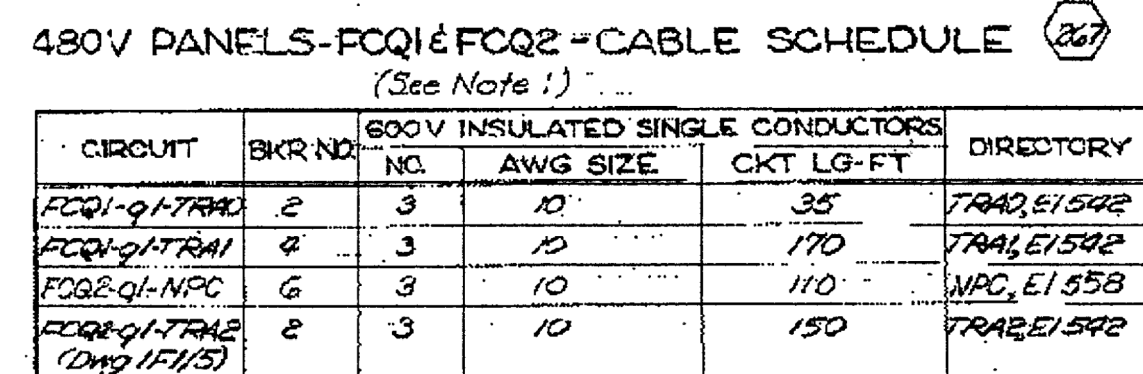


480V PANEL S-FC01&FC02-CABLE SCHEDULE 267

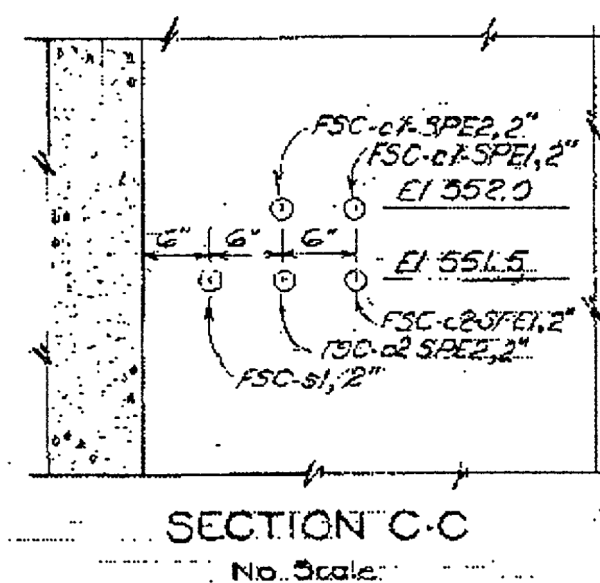

SECTION C-C
No. 5 Scale

AS CONSTRUCTED
LWDSO ELECTRIC DESIGN BRANCH, MPD

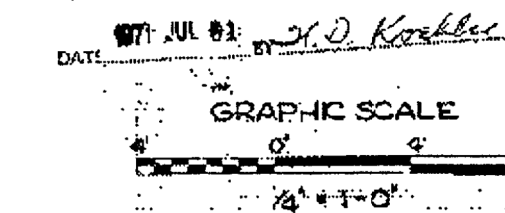

A 7/16/11 As constructed-Added PC22-gt-NPC		WDR
REVISION	DATE	DESCRIPTION
U. S. AIR ENGINEER DIVISION. N. P. PORTLAND, OREGON		
DESIGNED BY: JLS DRAWN BY: DJL CHECKED BY: RTZ PREPARED BY: Hester RECD. & EXTRAL SECTION		
LITTLE GOOSE LOCK AND DAM SNAKE RIVER, OREGON, WASHINGTON & IDAHO POWERHOUSE EMBEDDED CONDUIT & GROUNDING FISHWAY GALLERY EL. 542 ERECTION BAY & BAYS 1 THRU 3		
APPROVED FOR CONSTRUCTION <i>[Signature]</i> DATE: 4 DEC. 68 SCALE AS SHOWN SPEC. NO.		LGP-1-6-1E1/10
SUMMARY: <i>[Signature]</i> CONN. TIEING-BLOCKED (SEESE) BLOCKS		
INT. NO. GIVEN 40-154-23-10		


DESIGNED BY:	ISSUE DATE:
DRAWN BY:	AUGUST 2022
CHECKED BY:	SOLICITATION NO.:
	W912EF22R0001
	CONTRACT NO.:
SUBMITTED BY:	DRAWING NUMBER:







U.S. ARMY CORPS OF ENGINEERS
WALLA WALLA DISTRICT
201 NORTH 3RD AVENUE
SEATTLE, WASHINGTON

LITTLE GOOSE LOCK AND DAM
POWERHOUSE
DC SYSTEM AND LOW VOLTAGE SWITCHGEAR
POWERHOUSE EMBEDDED CONDUIT & GROUNDING
FISHWAY GALLERY EL 542
FRICTION RAY & RAYS 1 THRU 13

SHEET ID

R-028

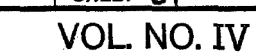

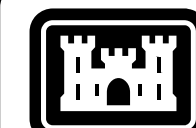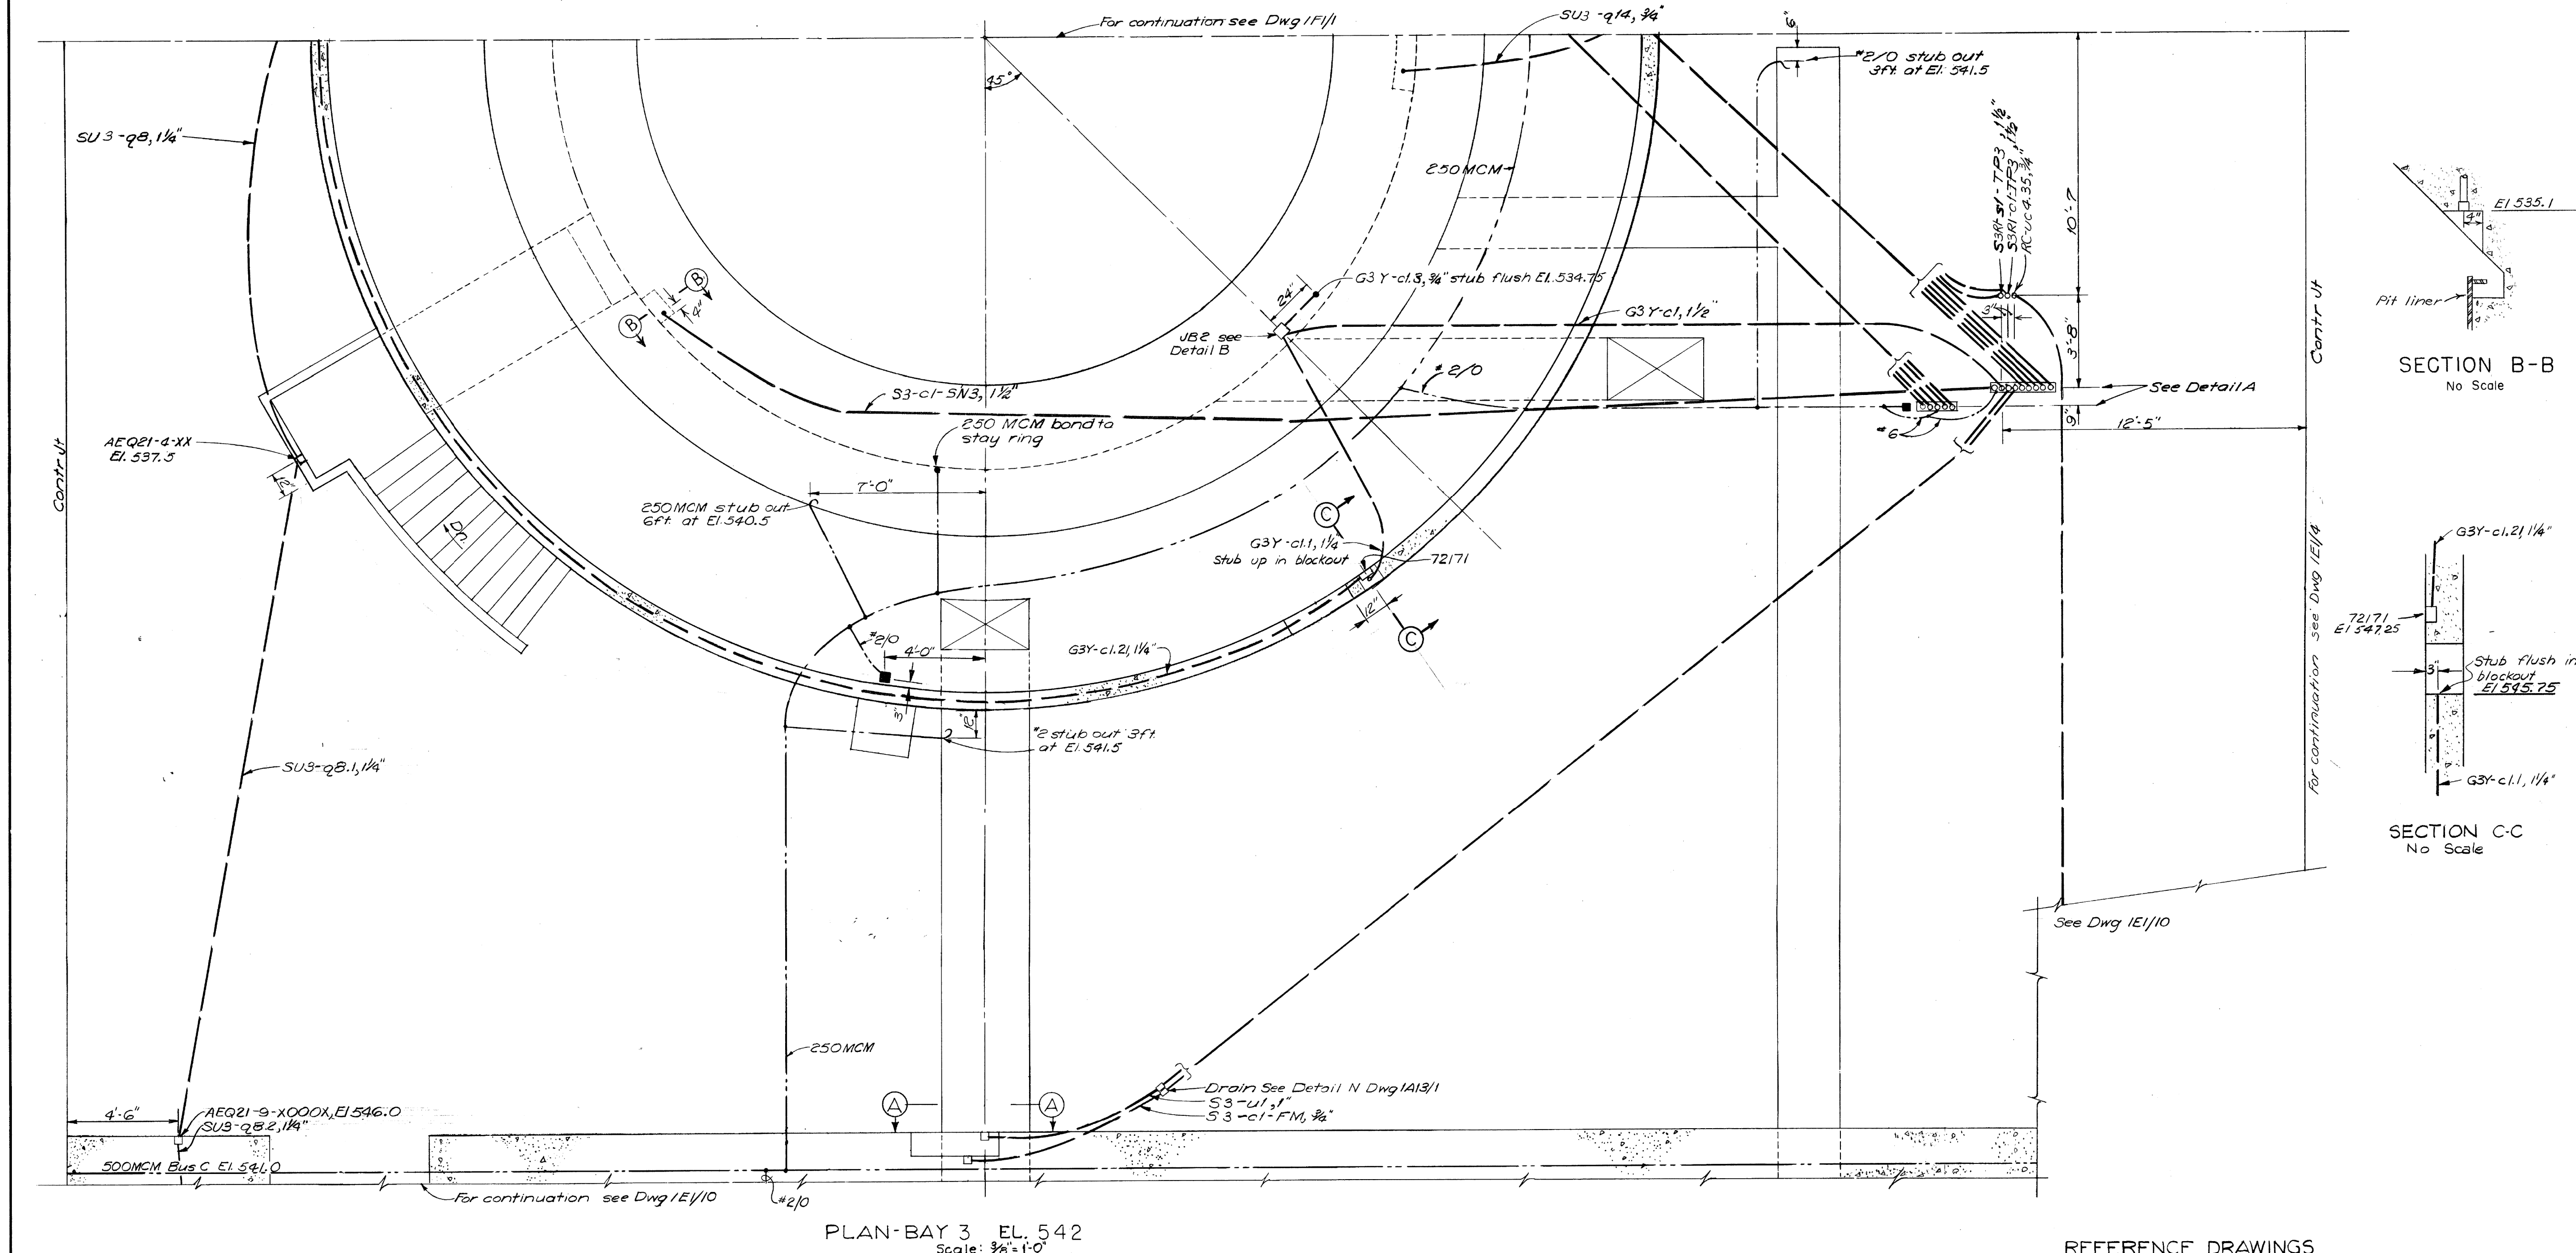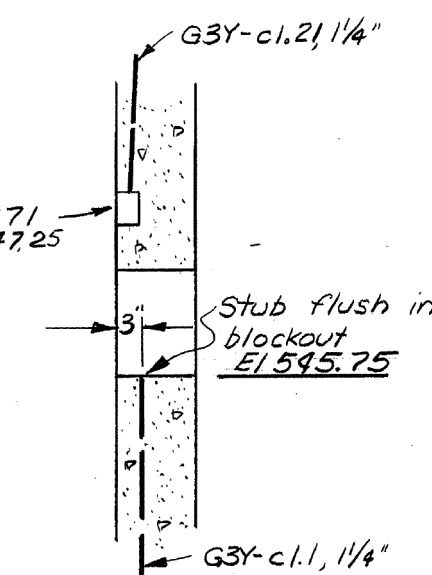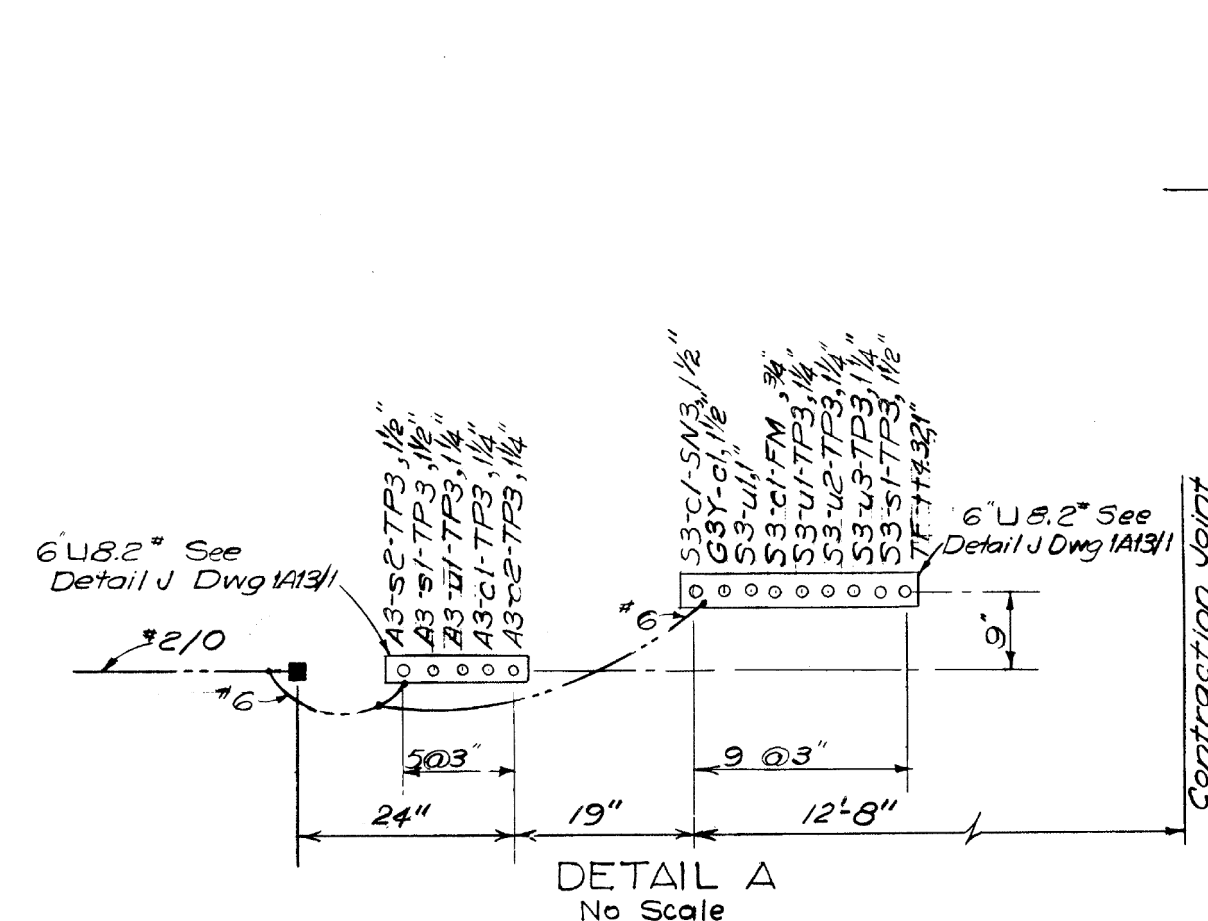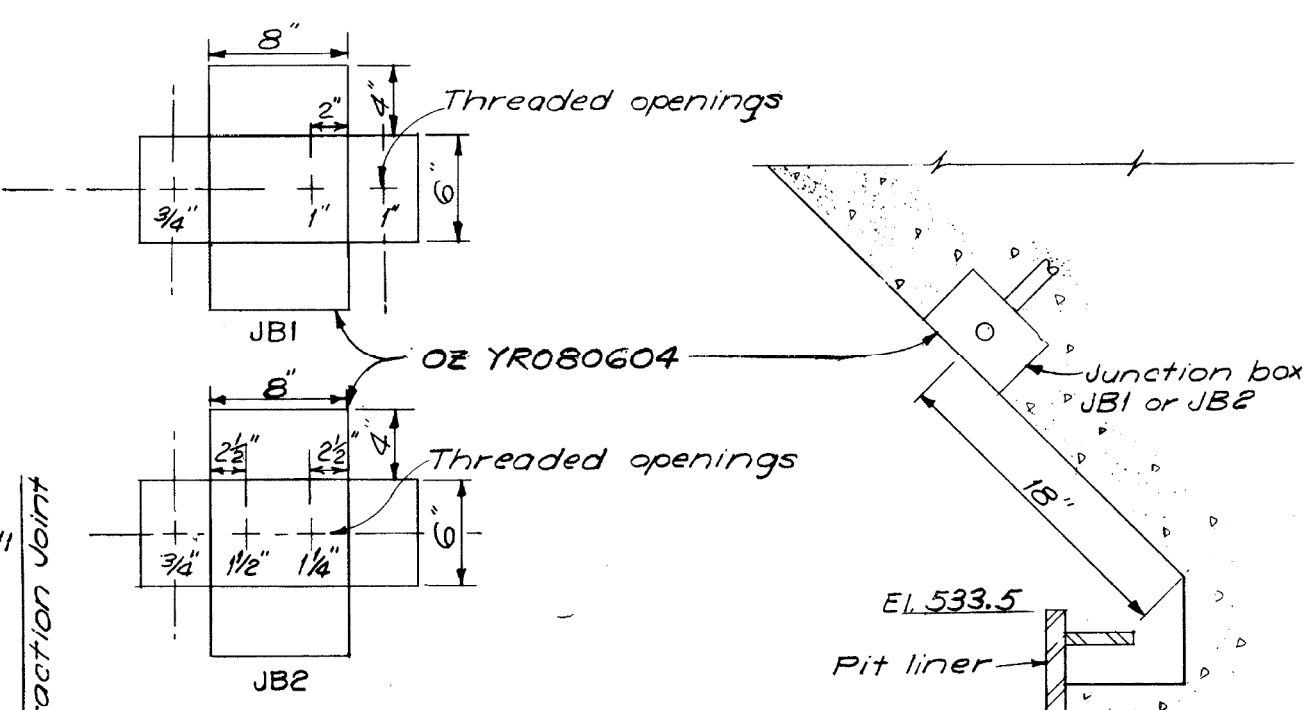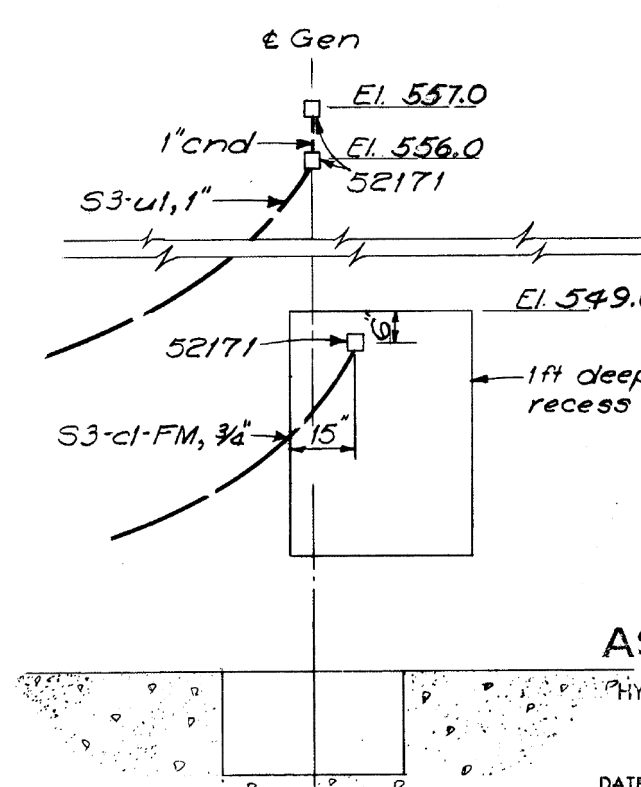US Army Corps
of Engineers®SECTION B-B
No ScaleSECTION C-C
No ScalePLAN-BAY 3 EL. 542
Scale: 3/8\"/>DETAIL A
No ScaleDETAIL B
No ScaleSECTION A-A
No Scale

REFERENCE DRAWINGS

DRAWING NO.	SHEET NO.
LGP-1-6-1A13/1	61
LGP-1-6-1D1/1	62
LGP-1-6-1E1/4	74
LGP-1-6-1E1/10	80
LGP-1-6-1F1/1	81

(250 Incl 257 258 259)

B 28 Dec 66 Corrected Section C-C		WHR
A 31 Mar 65 Added and Section C-C. Relocated gnd		WHR
REVISION	DATE	DESCRIPTION
U. S. ARMY ENGINEER DIVISION, N. P. PORTLAND, OREGON		
DESIGNED BY: J.K.		
DRAWN BY: R.E.F.		
CHECKED BY: E.M.S.		
PREPARED BY: J.L. Fisher		
HEAD, ELECTRICAL SECTION		
SUBMITTED: [Signature]		
CHIEF, HYDRO-ELECTRIC DESIGN BRANCH		
INV. NO. GIVENG-45-124-65-18		
DATE: 1971 JUL 01		
BY: S.D. Koshler		
AS CONSTRUCTED		
HYDRO-ELECTRIC DESIGN BRANCH, NPD		
GRAPHIC SCALE		
Scale: 3/8\"/>		

APPROVED FOR DIV. ENGINEER	DATE: 4 DEC 64
[Signature]	
SCALE AS SHOWN	SPEC. NO.
LGP-1-6-1F1/2	
SHEET 82	

CONT. NO. 65-560

VOL. NO. IV


LITTLE GOOSE LOCK AND DAM

POWERHOUSE
DC SYSTEM AND LOW VOLTAGE SWITCHGEARPOWERHOUSE EMBEDDED CONDUIT & GROUNDING
MAIN UNIT BAY 3
DOWNSTREAM HALF EL 542

SHEET ID

R-030

FINAL

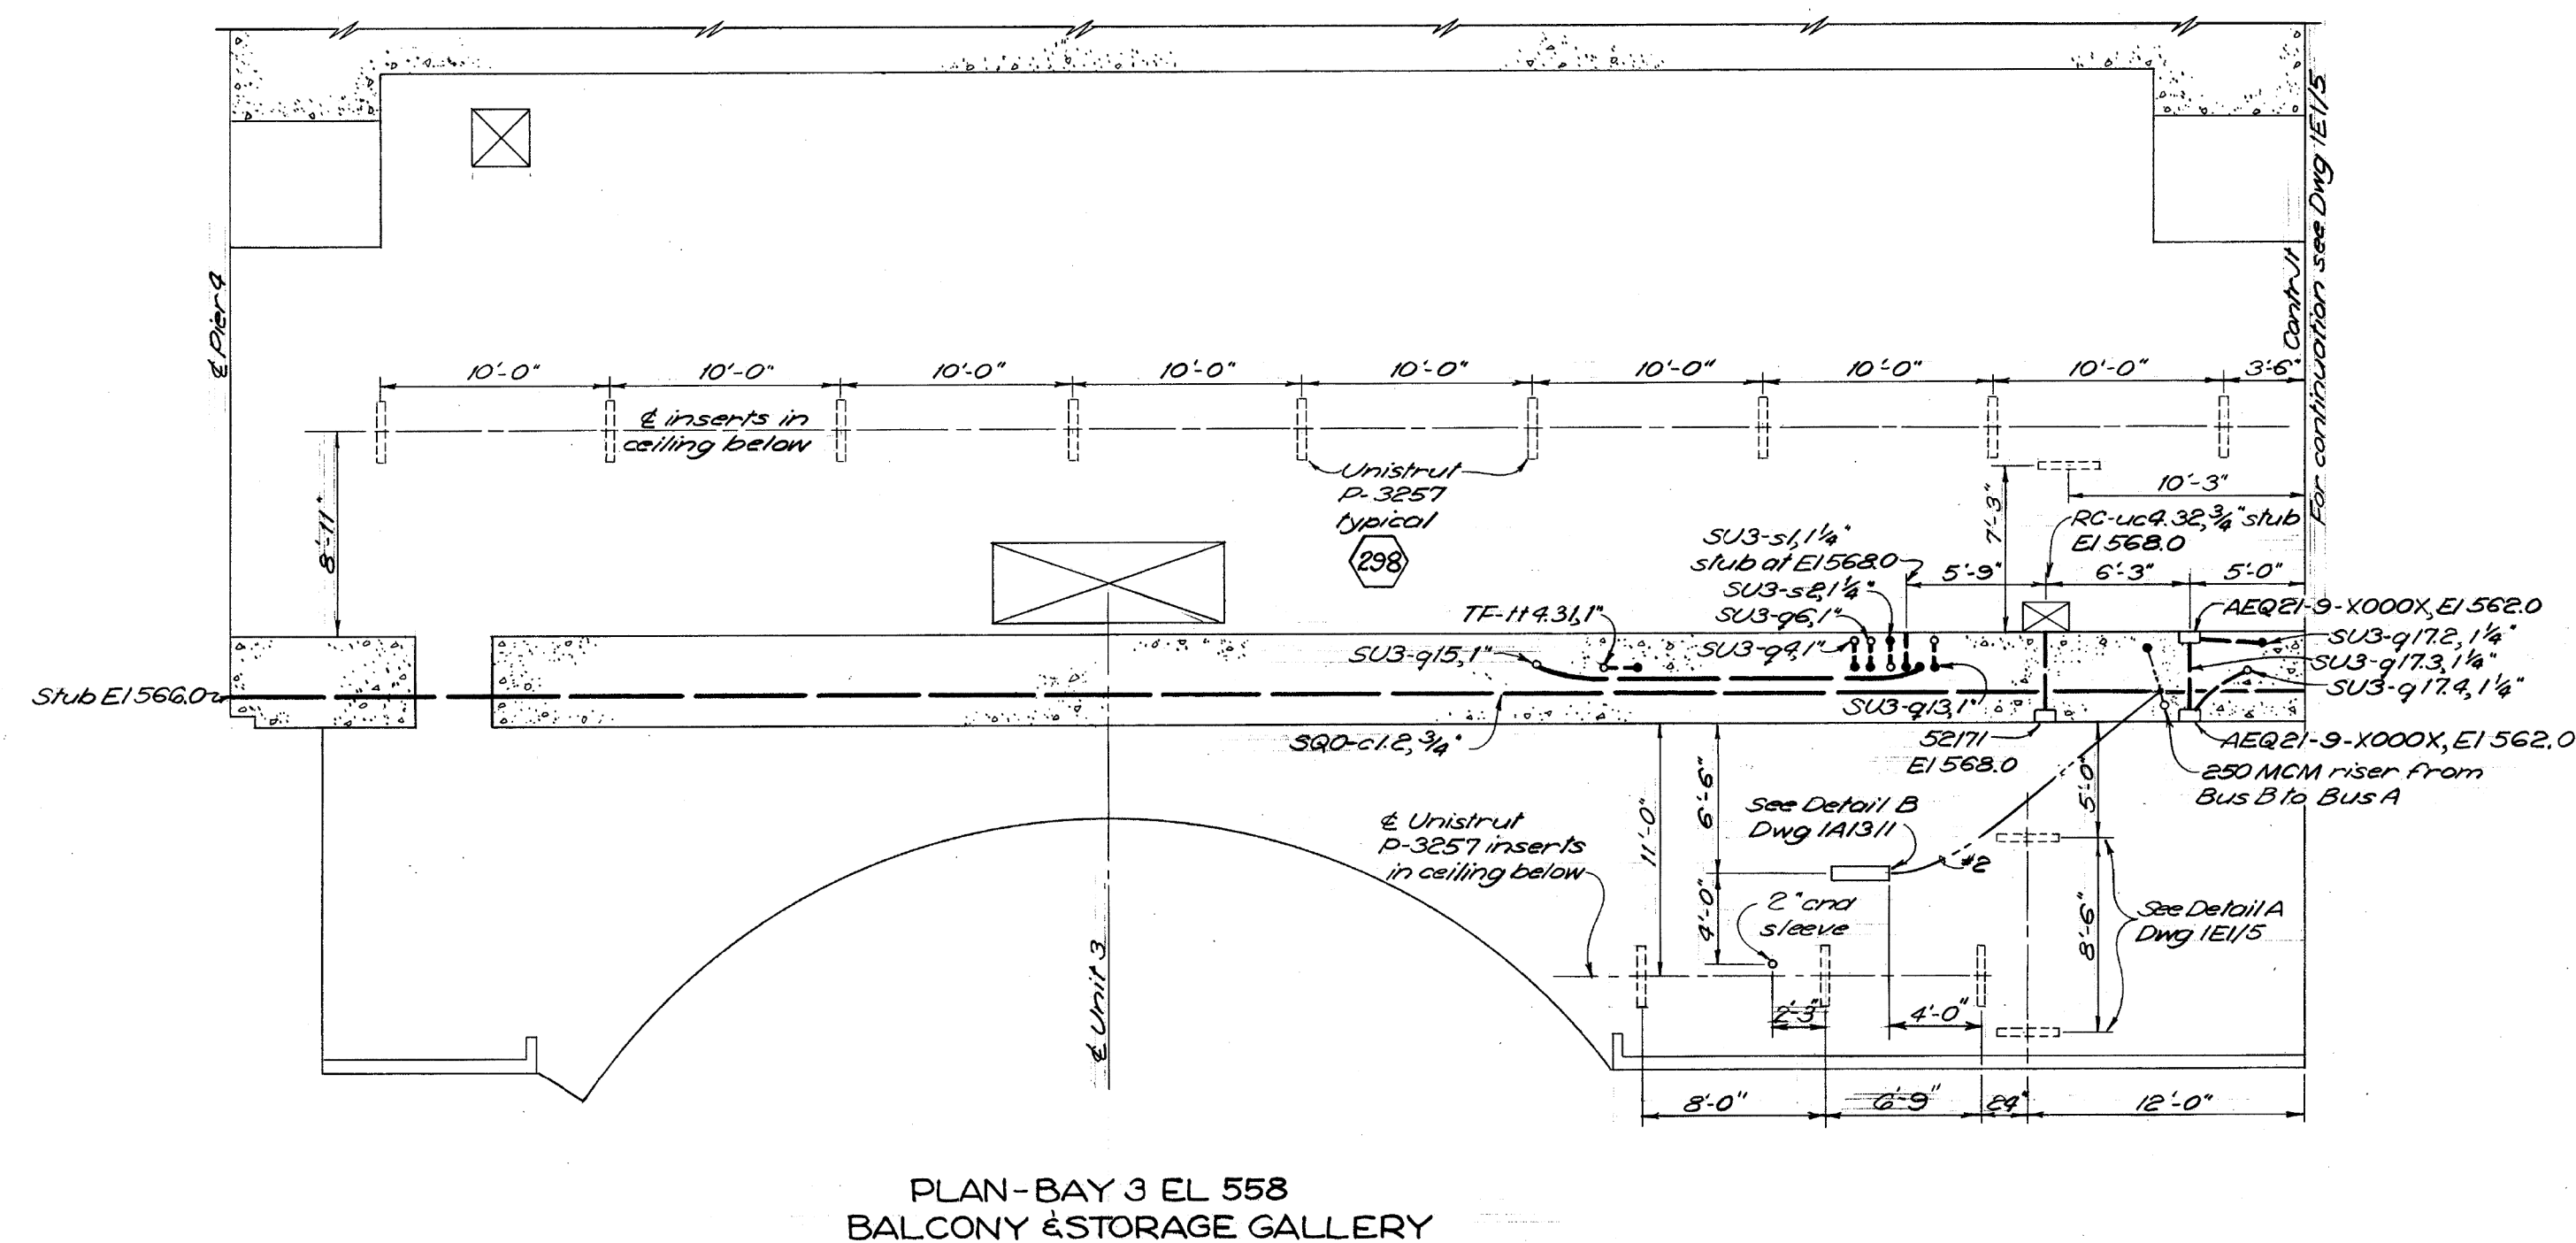

250 Incl
as req'd 257 260 296 298

A	31 Mar 65	<i>Changed insert location</i>			W
REVISION	DATE	DESCRIPTION			S
U. S. ARMY ENGINEER DIVISION. N. P. PORTLAND, OREGON					
LITTLE GOOSE LOCK AND DAM SNAKE RIVER, OREGON, WASHINGTON & IDAHO POWERHOUSE EMBEDDED CONDUIT & GROUNDING MAIN UNIT GALLERY 3 EL 558 & 580					
DESIGNED BY:	<i>JLS</i>				
DRAWN BY:	<i>PJL</i>				
CHECKED BY:	<i>EMS</i>				
PREPARED:	<i>[Signature]</i>				
HEAD, ELECTRICAL SECTION					
SUBMITTED: <i>[Signature]</i>			APPROVED FOR DRY DOCK INSPECTION DATE: <u>4 DEC 65</u> <i>[Signature]</i>		
CHIEF, HYDRO-ELECTRIC DESIGN BRANCH			SCALE AS SHOWN SPEC. NO. _____ ENCLOSURE		
INV. NO. CIVENG-AS-164-61-B			LGP-1-6-IF1/3		

AS CONSTRUCTED

HYDRO ELECTRIC DESIGN BRANCH, NFD






1971 JUL 01

DATE BY *J.D. Koehler*

GRAPHIC SCALE

4' 0' 4' 8'

3/16" = 1'-0"

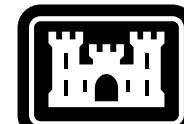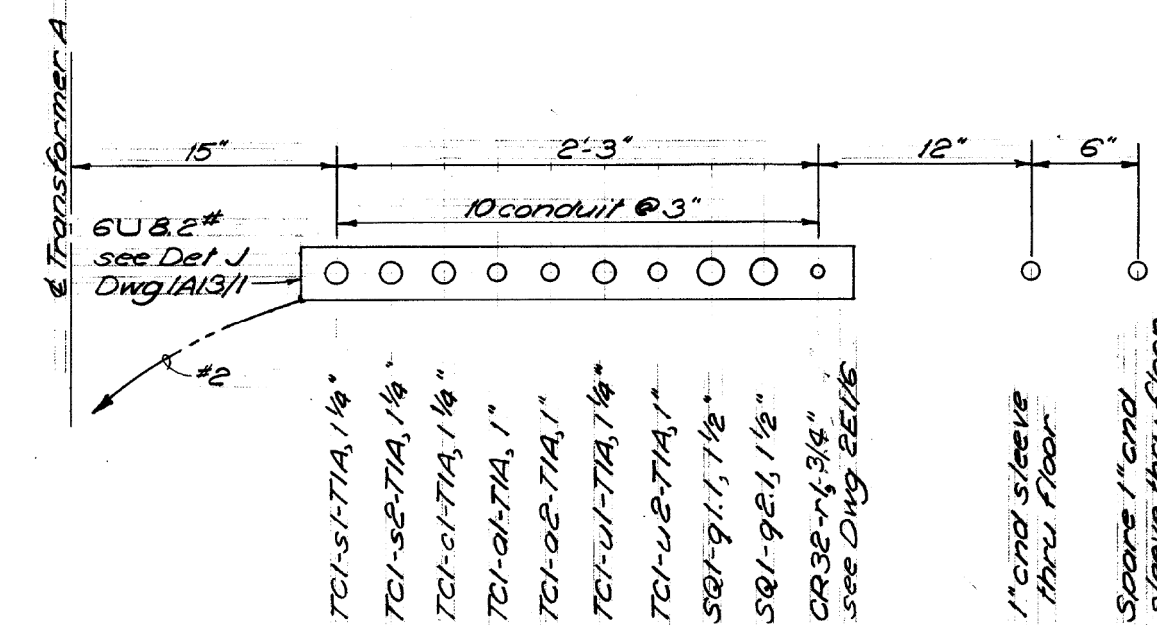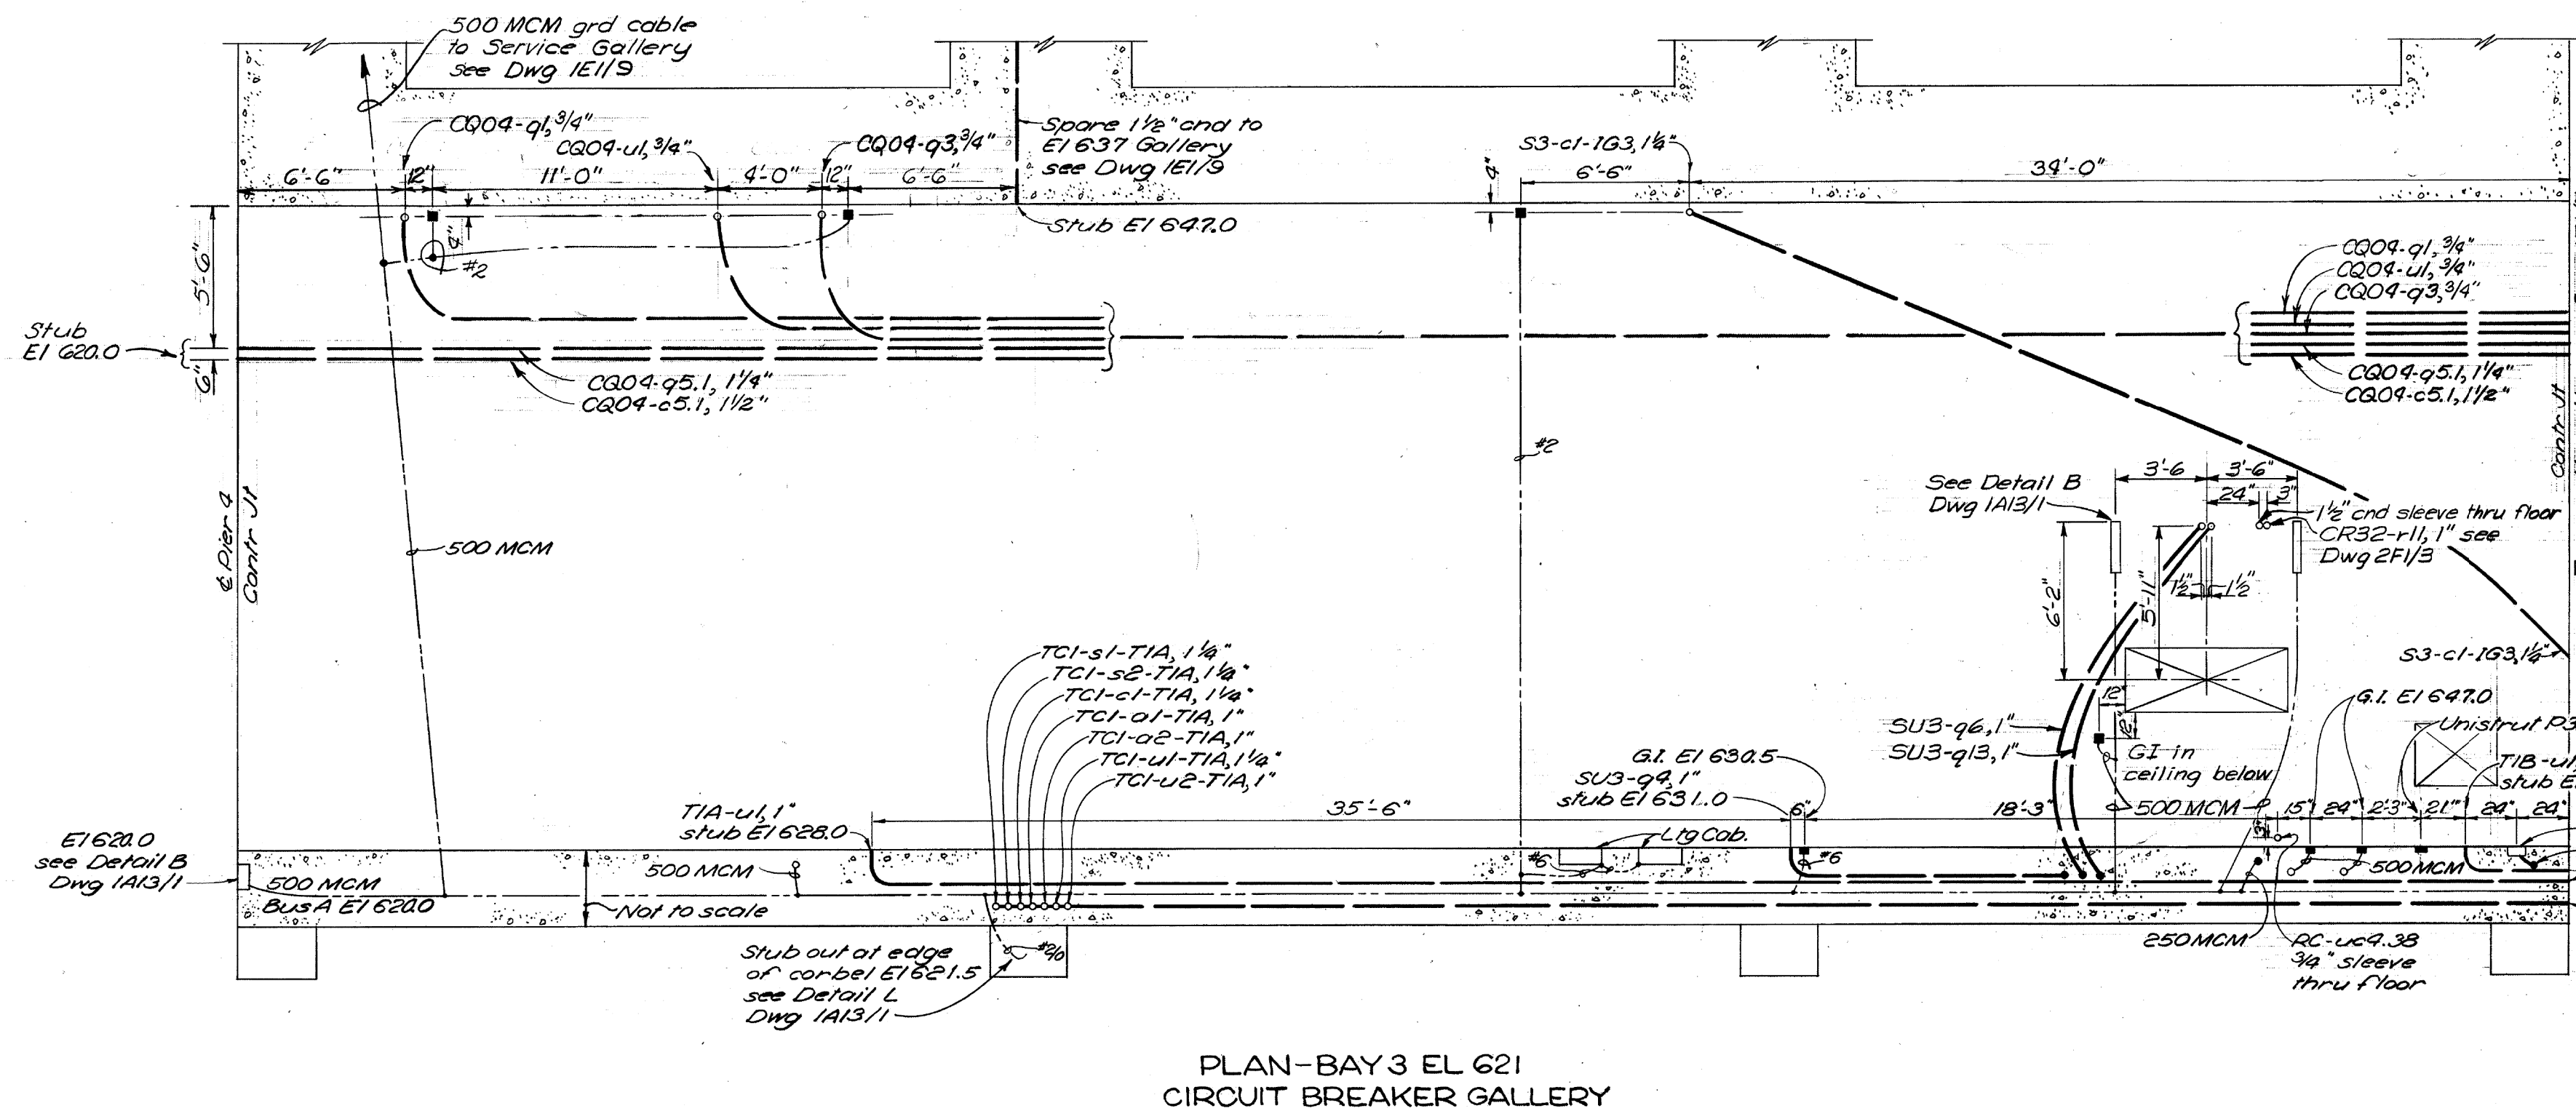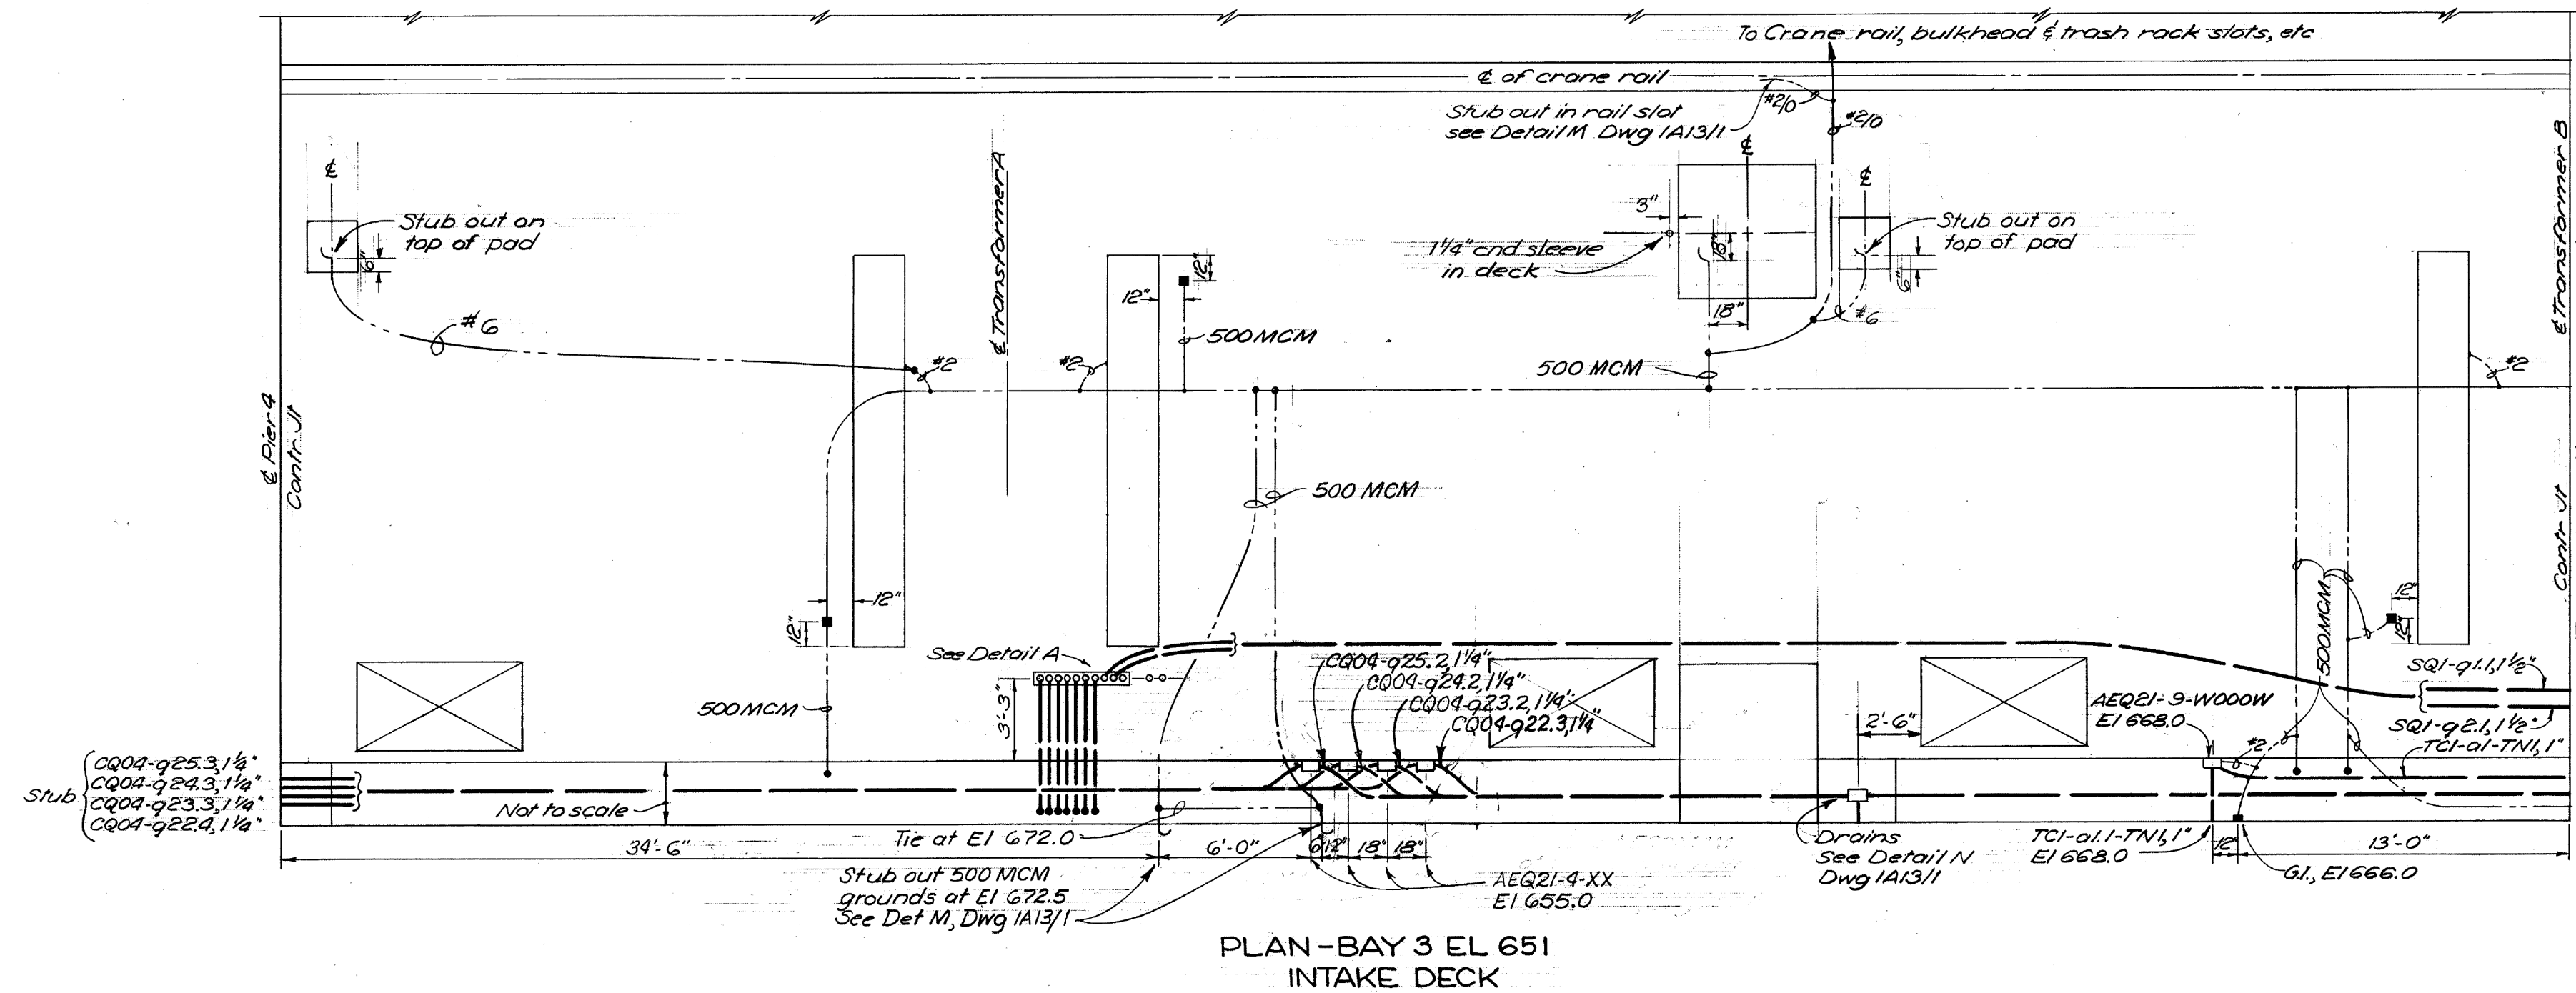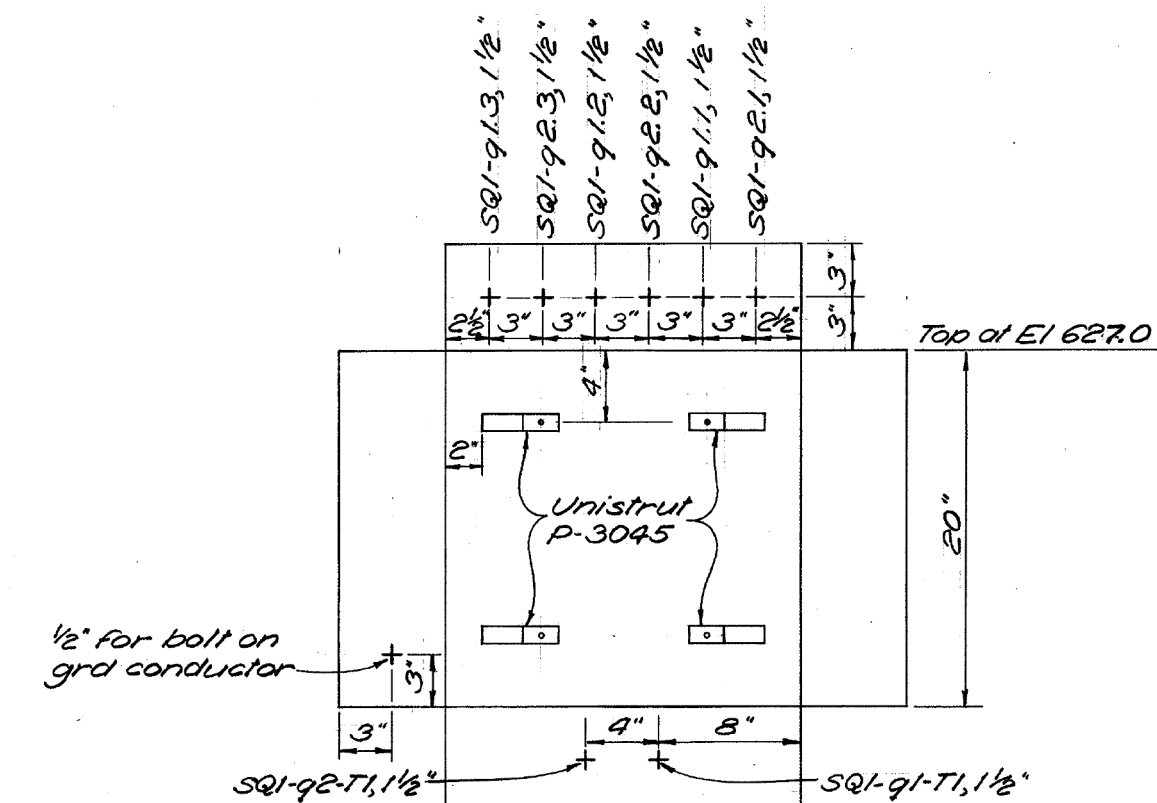US Army Corps
of Engineers®DETAIL A
No ScaleDETAIL B (E1/7)
No Scale

REFERENCE DRAWINGS

DRAWING NO.	SHEET NO.
LGP-1-6-1A13/1	61
LGP-1-6-1D1/1	62
LGP-1-6-1E1/1	77
LGP-1-6-1E1/3	79
LGP-1-6-1E1/6	83
LGP-1-6-2E1/6	111
LGP-1-6-2E1/3	116

250 Incl
as reqdAS CONSTRUCTED
HYDRO ELECTRIC DESIGN BRANCH, NPD

DATE 1871 JUL 01 BY J.D. Koehler


GRAPHIC SCALE
1/4" = 1'-0"


B 7/1/1 As constructed - minor changes		WDR
A 6/1/1 Relocated and 4gnd, changed end size		WDR
REVISION	DATE	DESCRIPTION
U. S. ARMY ENGINEER DIVISION, N. P. PORTLAND, OREGON		
DESIGNED BY: JLS	LITTLE GOOSE LOCK AND DAM POWERHOUSE DC SYSTEM AND LOW VOLTAGE SWITCHGEAR	
DRAWN BY: PJL	EMBEDDED CONDUIT & GROUNDING MAIN UNIT GALLERY & INTAKE DECK BAY 3 EL 621 & 651	
CHECKED BY: EMS	APPROVED FOR DIV. ENGINEER DATE 4 DEC 64	
PREPARED BY: JLS	SCALE AS SHOWN SPEC. NO.	
HEAD ELECTRICAL SECTION	SHEET 84	
INV. NO. CIVENG-45-164-65-18		LGP-1-6-1F1/4

SHEET ID


R-032

FINAL

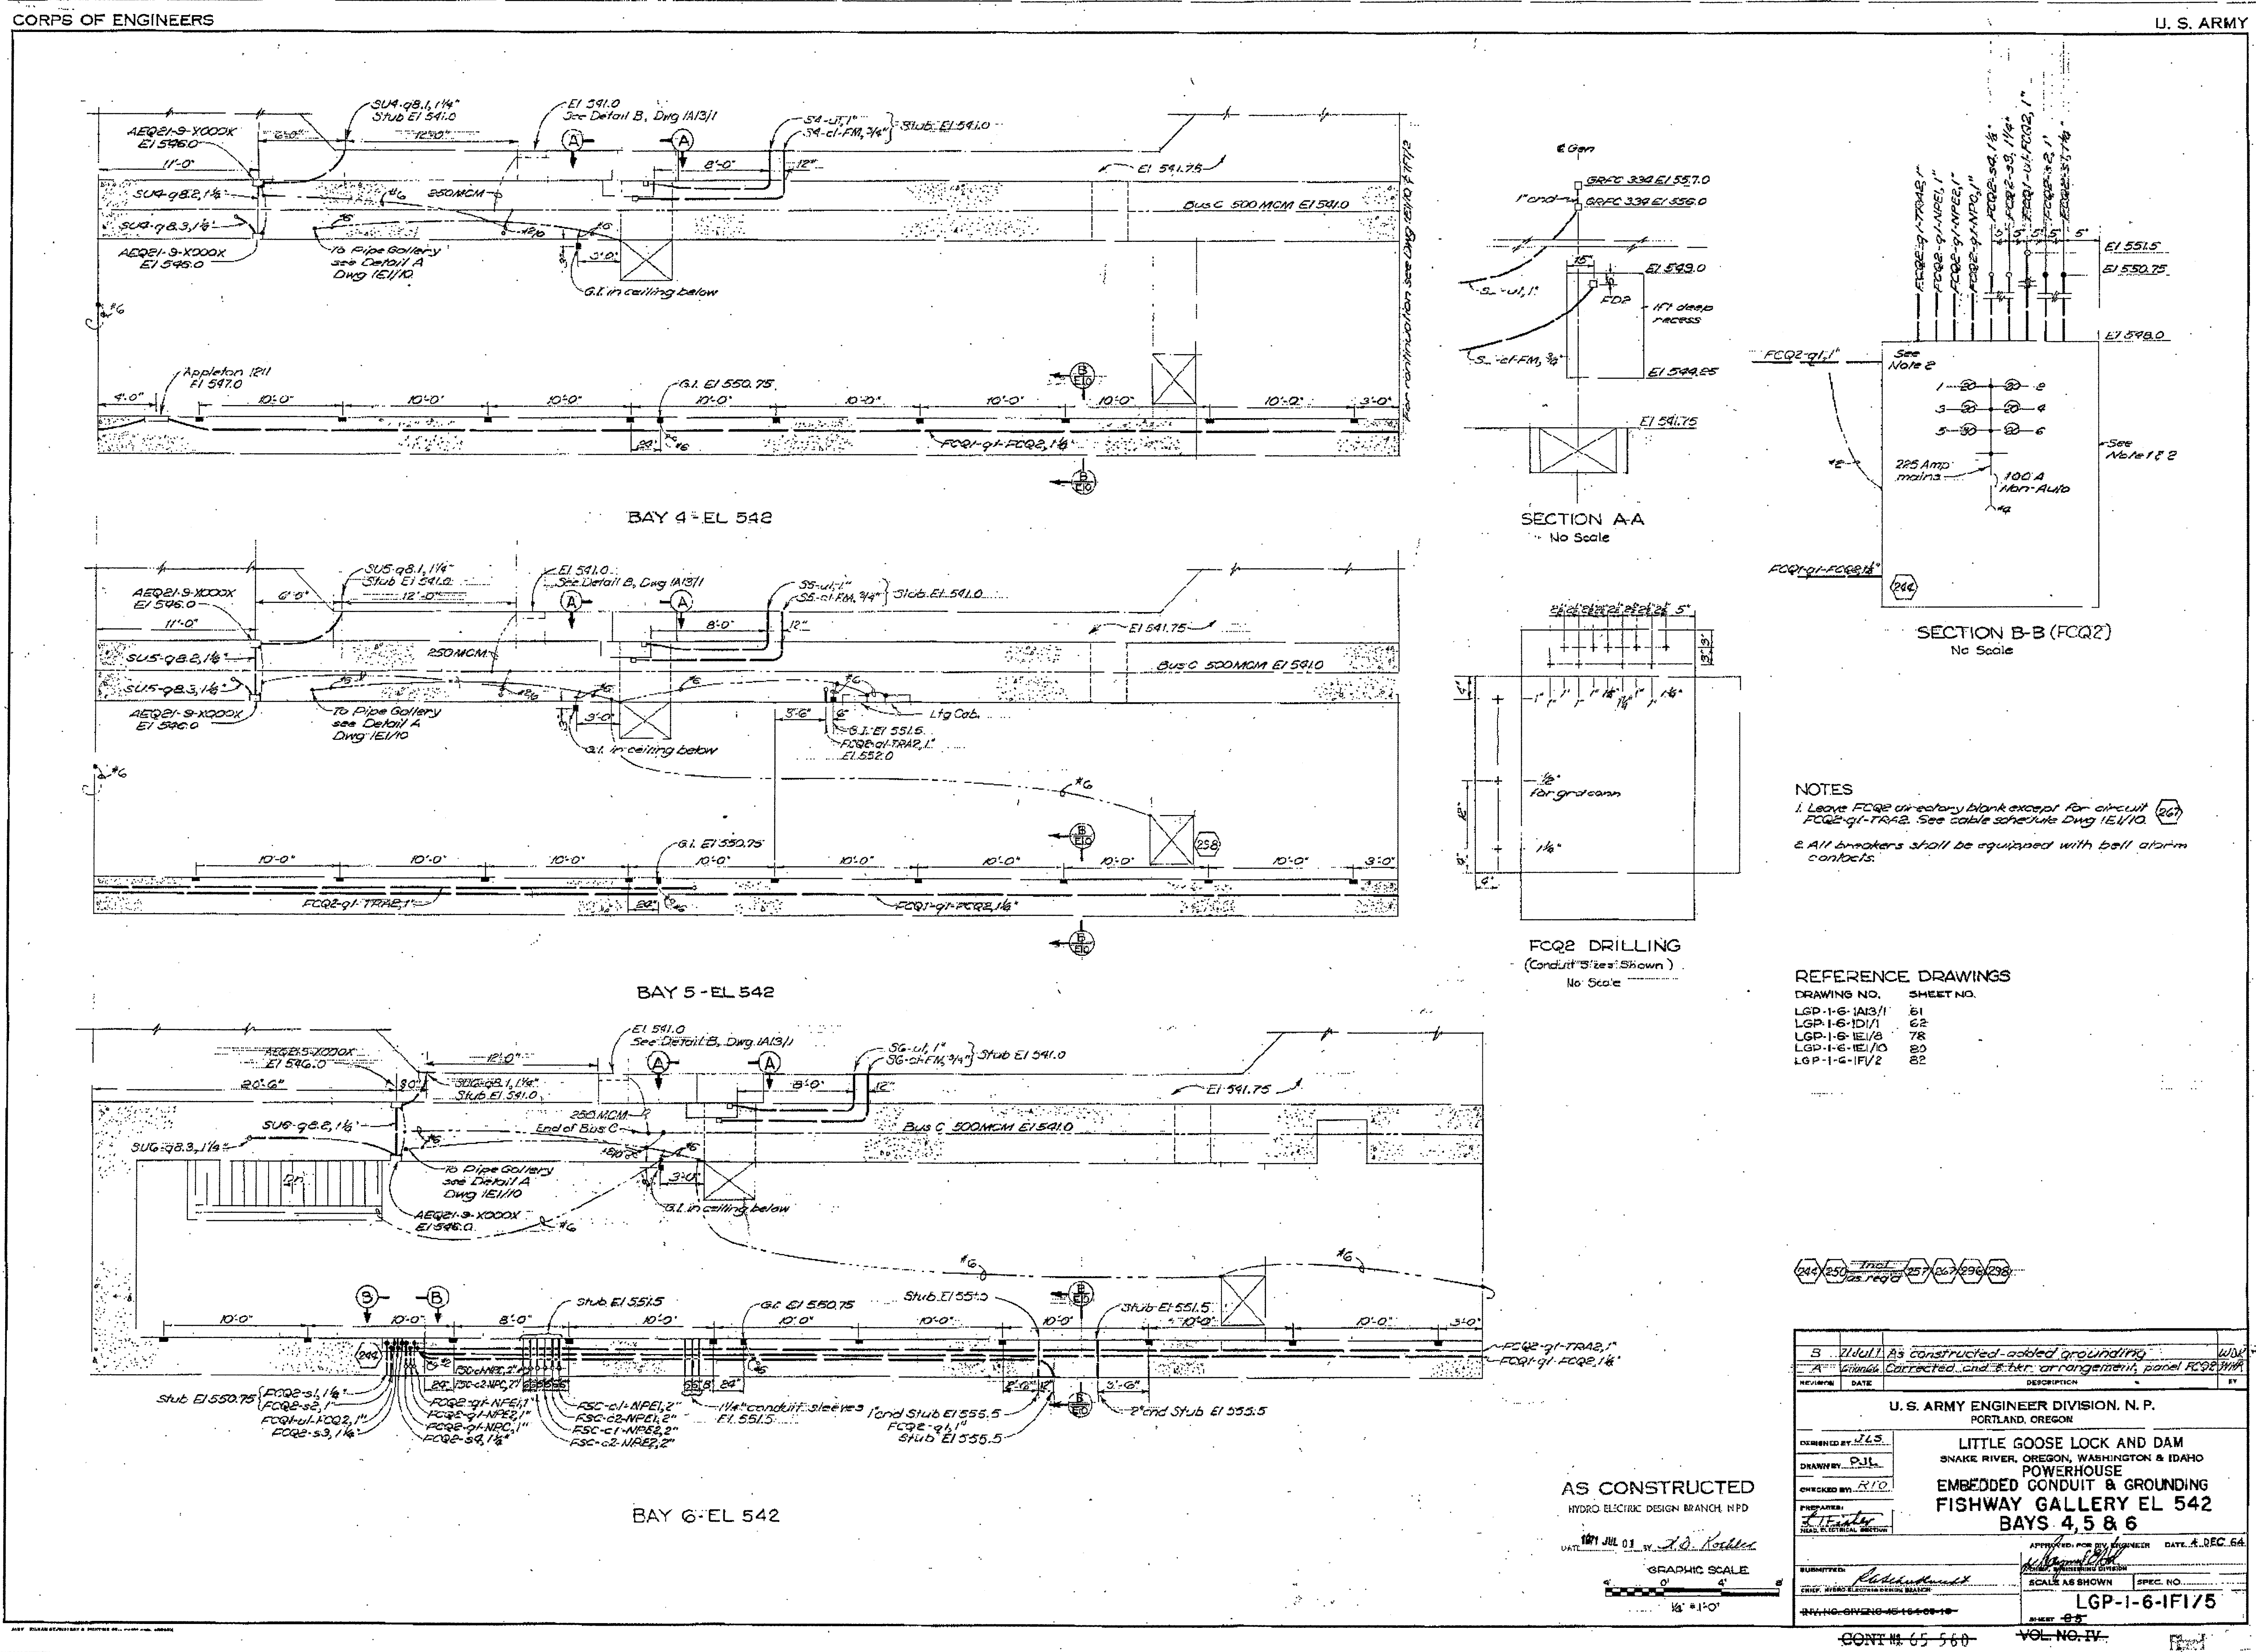

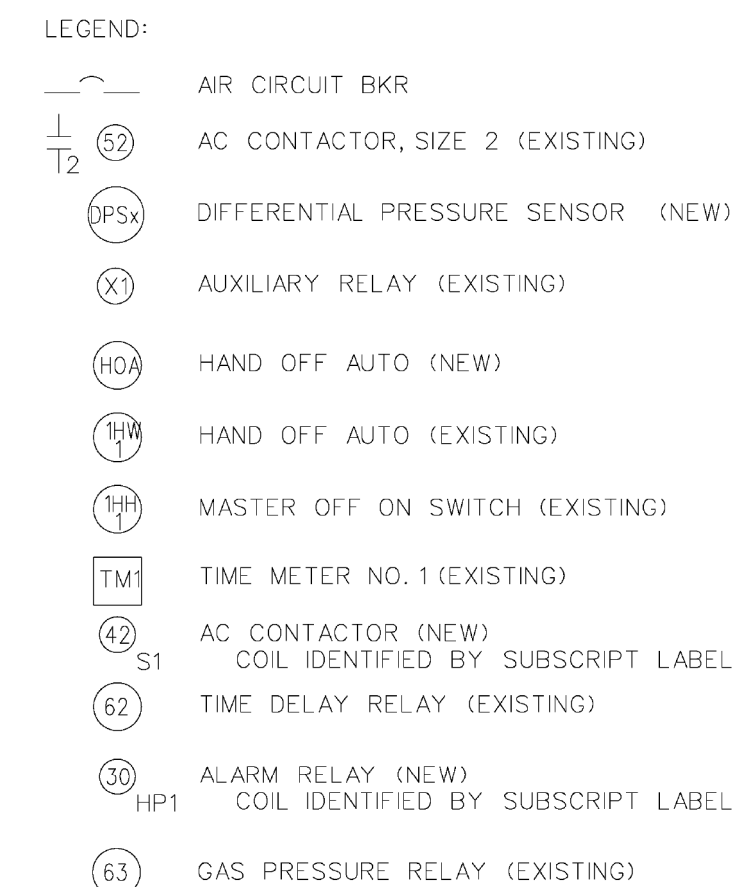

MCC SH SINGLE LINE DIAGRAM (DEMOLITION)

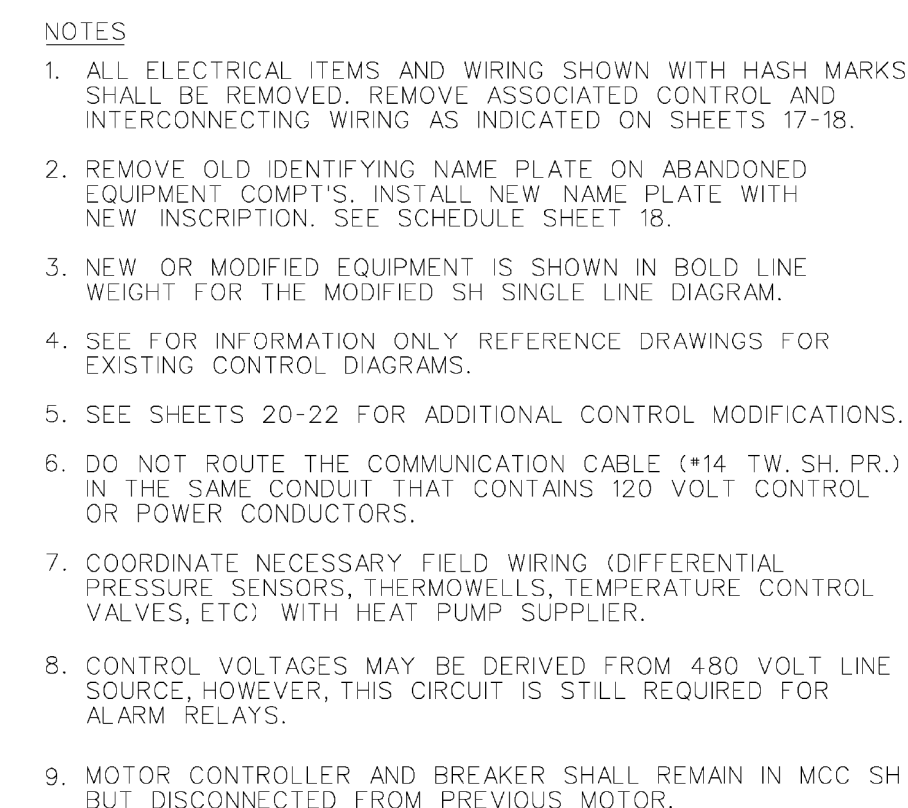

MCC SH SINGLE LINE DIAGRAM (MODIFIED)

B	10/4/18	AS-BUILT PER PROJECT PERSONNEL		ZB	
A	12/5	AS CONSTRUCTED			
REVISION	DATE	DESCRIPTION		CHKD.	APP'D.
U . S . ARMY ENGINEER DISTRICT WALLA WALLA, WASHINGTON					
NGUYEN/EMPRREE... DESIGNED BY					
JH					
DRAWN BY					
CHECKED BY					
SUPERVISED					
CHIEF ELECT. DES. SEC.					
SUBMITTED:					DATE: 30 SEP.
CHIEF DESIGN BRANCH		SCALE AS SHOWN INV. NO. 05-B-00			
APPROVED:		SYSTEM H 480V Substation SHALGP-1-6-18, 480V			
Little GooseP PowerhouseS Station Power/SO 480V		19 GP-1-6-18/4			



NOTES

1. FOR LEGEND SEE DWG LCP-1-6-1A8/1.
2. FOR SCHEMATIC DIAGRAMS OF ELECTRICAL BREAKER CONTROL, AUTOMATIC BUS TRANSFER AND BREAKER ALARM LIGHTS, AND WIRING OF ANNUNCIATION CONTACTS SEE DWG LCP-1-6-1A8/1.
3. VARIATIONS IN EQUIPMENT ARRANGEMENT AND BREAKER CONTROL WILL BE ALLOWED TO FIT MANUFACTURERS STANDARD CONSTRUCTION SUBJECT TO THE APPROVAL OF THE CONTRACTING OFFICER.
4. COMPARTMENTS SHALL BE CONSTRUCTED TO ACCOMMODATE FUTURE BREAKERS.
5. PROVIDE NAMEPLATES LABELED AS INDICATED BY CONTROL SOURCE DISTRIBUTION DIAGRAM.
- 6 THIS DRAWING, INCLUDING NOTES 1 THROUGH 5, WAS ISSUED AS LCP-1-6-1A8/1 FOR PROCUREMENT OF GOVERNMENT-FURNISHED 480 VOLT SUBSTATION SQ1. DESIGN IS SUBJECT TO MODIFICATION IN ACCORDANCE WITH NOTE 3. WESTINGHOUSE ELECTRIC CORPORATION IS THE CONTRACTOR.



DATE 1971 SEP 7 BY

FINAL

[illegible]

U.S. ARMY CORPS OF ENGINEERS WALLA WALLA DISTRICT 201 NORTH 3RD AVENUE SEATTLE, WASHINGTON	DESIGNED BY:	ISSUE DATE: AUGUST 2022
	DRAWN BY:	SOLICITATION NO.: W912EE22R0001
	CHECKED BY:	CONTRACT NO.:
	SUBMITTED BY:	DRAWING NUMBER:
	SIZE:	FILENAME: R307L.dgn
	ANSID:	

LITTLE GOOSE LOCK AND DAM


POWERHOUSE
DC SYSTEM AND LOW VOLTAGE SWITCHGEAR

POWERHOUSE
480 VOLT CONTROL CENTERS
SU1 THRU SU3

SHEET ID

R-037

FINAL

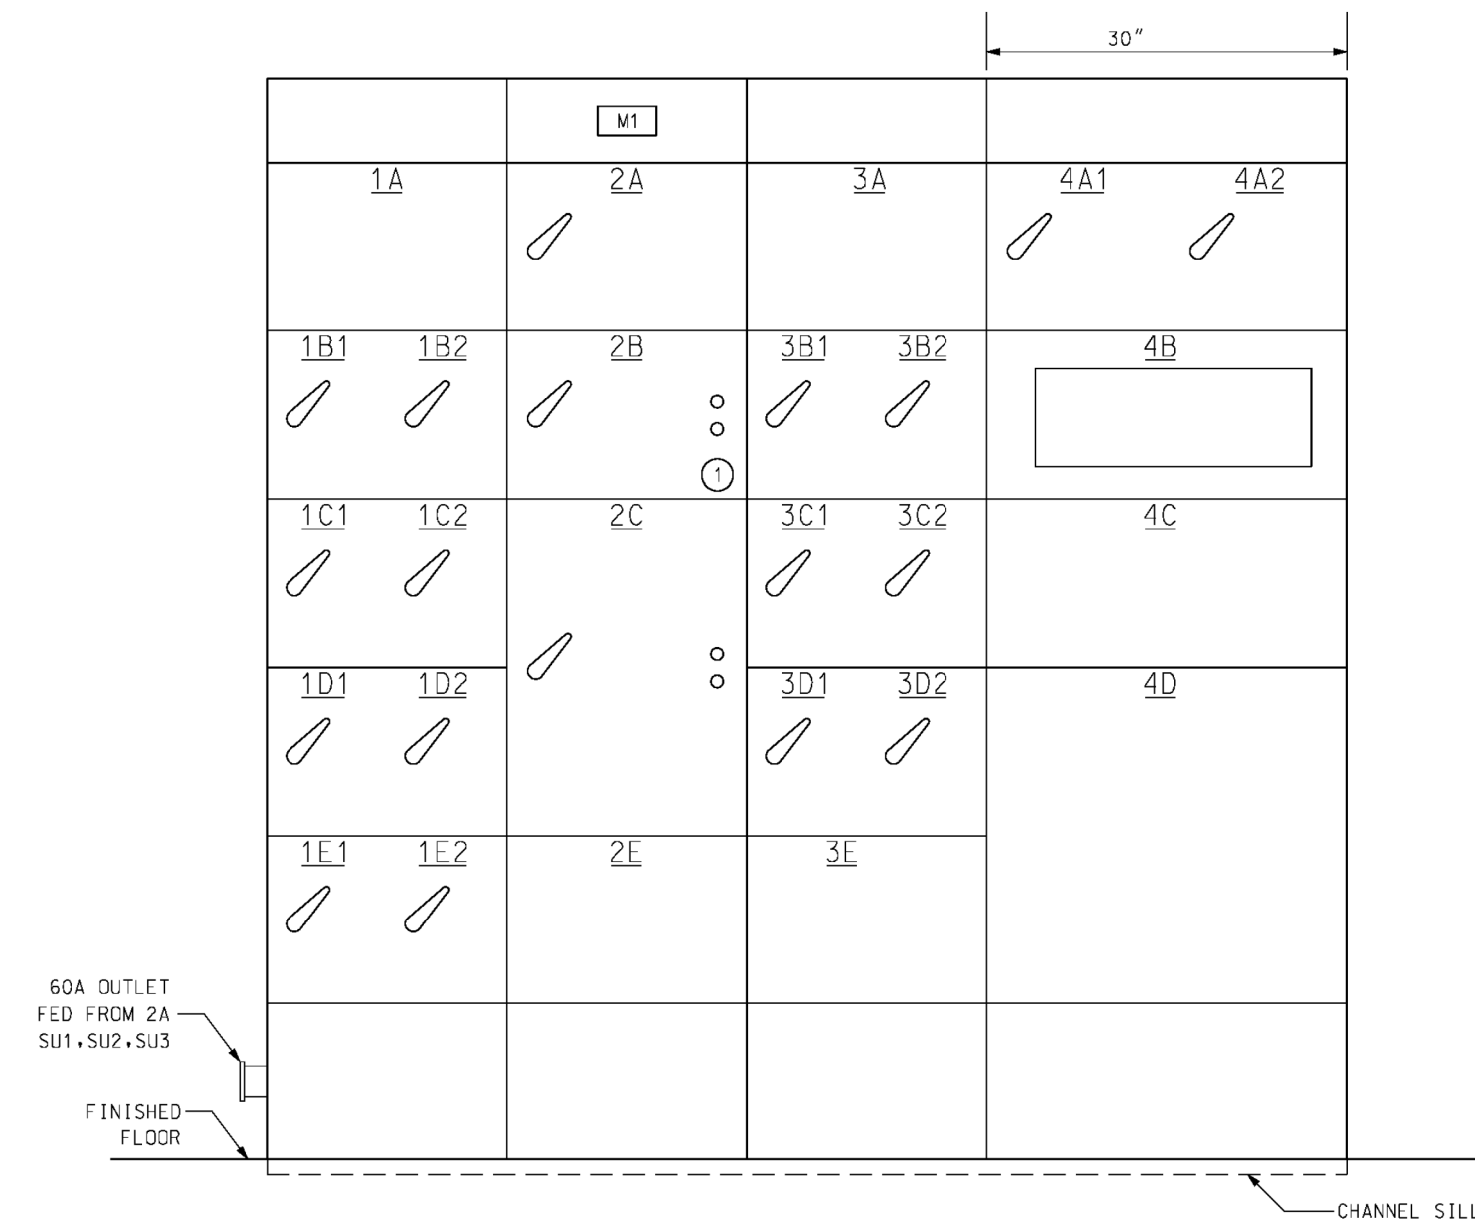


FRONT VIEW

NAMEPLATE SCHEDULE

NO.	FIRST LINE	SECOND LINE
W1	SU1 480V	CONTROL CENTER
1A	NONE (SEE NOTE 3)	
1B1	3RD FLOOR UPSTREAM	GALLERY WORKSHOP
1B2	GEN BKR	COOLER NO.1
1C1	HEAD COVER	PUMP NO.1
1C2	480 VOLT	OUTLETS
1D1	AC TURBINE	BRG OIL PUMP
1D2	LIGHT TRANS	TR12
1E1	LIGHT TRANS	TR11
1E2	BLANK	
2A	60 AMP	OUTLET
2B	GENERATOR	HEATERS
2C	GOVERNOR OIL	PUMP NO.1
2E	NONE (SEE NOTE 3)	

BKR NO.	COMPARTMENT 4B DIRECTORY SCHEDULE
1	DC TURBINE BRG OIL PUMP (SU1)
2	
3	DC TURBINE BRG OIL PUMP (SU2,SU3)
4	125V EMERG LTG

NO.	FIRST LINE	SECOND LINE
M1	SU1 480V	CONTROL CENTER
3A	NONE (SEE NOTE 3)	
3B1	GOV. OIL	FILTER PUMP
3B2	BLANK	
3C1	HEAD COVER	PUMP NO.2
3C2	HIGH BAY	LIGHTS
3D1	THRUST BRG	OIL PUMP
3D2	480 VOLT	OUTLETS
3E	NONE (SEE NOTE 3)	
4A1	125 VOLT DC	SUPPLY NO.1
4A2	125 VOLT DC	SUPPLY NO.2
4B	125 VOLT DC	PANEL
4C	EMERG LTG	CONTACTOR
4D	NONE	

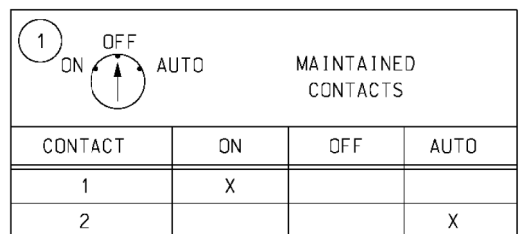

NAMEPLATE SCHEDULE


NO.	FIRST LINE	SECOND LINE
MT	SUZ 480V	CONTROL CENTER
1A	NONE (SEE NOTE 3)	
1B1	ODV. OIL	FILTER PUMP
1B2	BLANK	
1C1	HEAD COVER	PUMP NO.1
1C2	480 VOLT	OUTLETS
1D1	AC TURBINE	BRG OIL PUMP
1D2	LIGHT TRANS	1122
1E1	LIGHT TRANS	TR21
1E2	BLANK	
2A	60 AMP	OUTLET
2B	GENERATOR	HEATERS
2C	GOVERNOR OIL	PUMP NO.1
2E	NONE (SEE NOTE 3)	

NO.	FIRST LINE	SECOND LINE
MI	SU2 #80V	CONTROL CENTER
3A	NONE (SEE NOTE 3)	
3B1	HIGH BAY	LIGHTS
3B2	GEN. BKR	COOLER NO.1
3C1	HEAD COVER	PUMP NO.2
3C2	HIGH BAY	LIGHTS
3D1	THRUST BRG	OIL PUMP
3D2	480 VOLT	OUTLETS
3E	NONE (SEE NOTE 3)	
4A1	125 VOLT DC	SUPPLY NO.1
4A2	125 VOLT DC	SUPPLY NO.2
4B	125 VOLT DC	PANEL
4C	EMERG LTG	CONTACTOR
4D	NONE	


NAMEPLATE SCHEDULE

NO.	FIRST LINE	SECOND LINE
M*	SU3 480V	CONTROL CENTER
1A	NONE (SEE NOTE 3)	
1B1	BLANK	
1B2	GEN. BKR.	COOLER NO.1
1C1	HEAD COVER	PUMP NO.1
1C2	480 VOLT	OUTLETS
1D1	AC TURBINE	BRG OIL PUMP
1D2	LIGHT TRANS	TR32
1E1	LIGHT TRANS	TR31
1E2	BLANK	
2A	60 AMP	OUTLET
2B	GENERATOR	HEATERS
2C	GOVERNOR OIL	PUMP NO.1
2E	NONE (SEE NOTE 3)	




NO.	FIRST LINE	SECOND LINE
M1	SU3 480V	CONTROL CENTER
3A	NONE (SEE NOTE 3)	
3B1	GOV. OIL	FILTER PUMP
3B2	BLANK	
3C1	HEAD COVER	PUMP NO.2
3C2	HIGH BAY	LIGHTS
3D1	THRUST BRG	OIL PUMP
3D2	480 VOLT	OUTLETS
3E	NONE (SEE NOTE 3)	
4A1	125 VOLT DC	SUPPLY NO.1
4A2	125 VOLT DC	SUPPLY NO.2
4B	125 VOLT DC	PANEL
4C	EMERG LTG	CONTACTOR
4D	NONE	

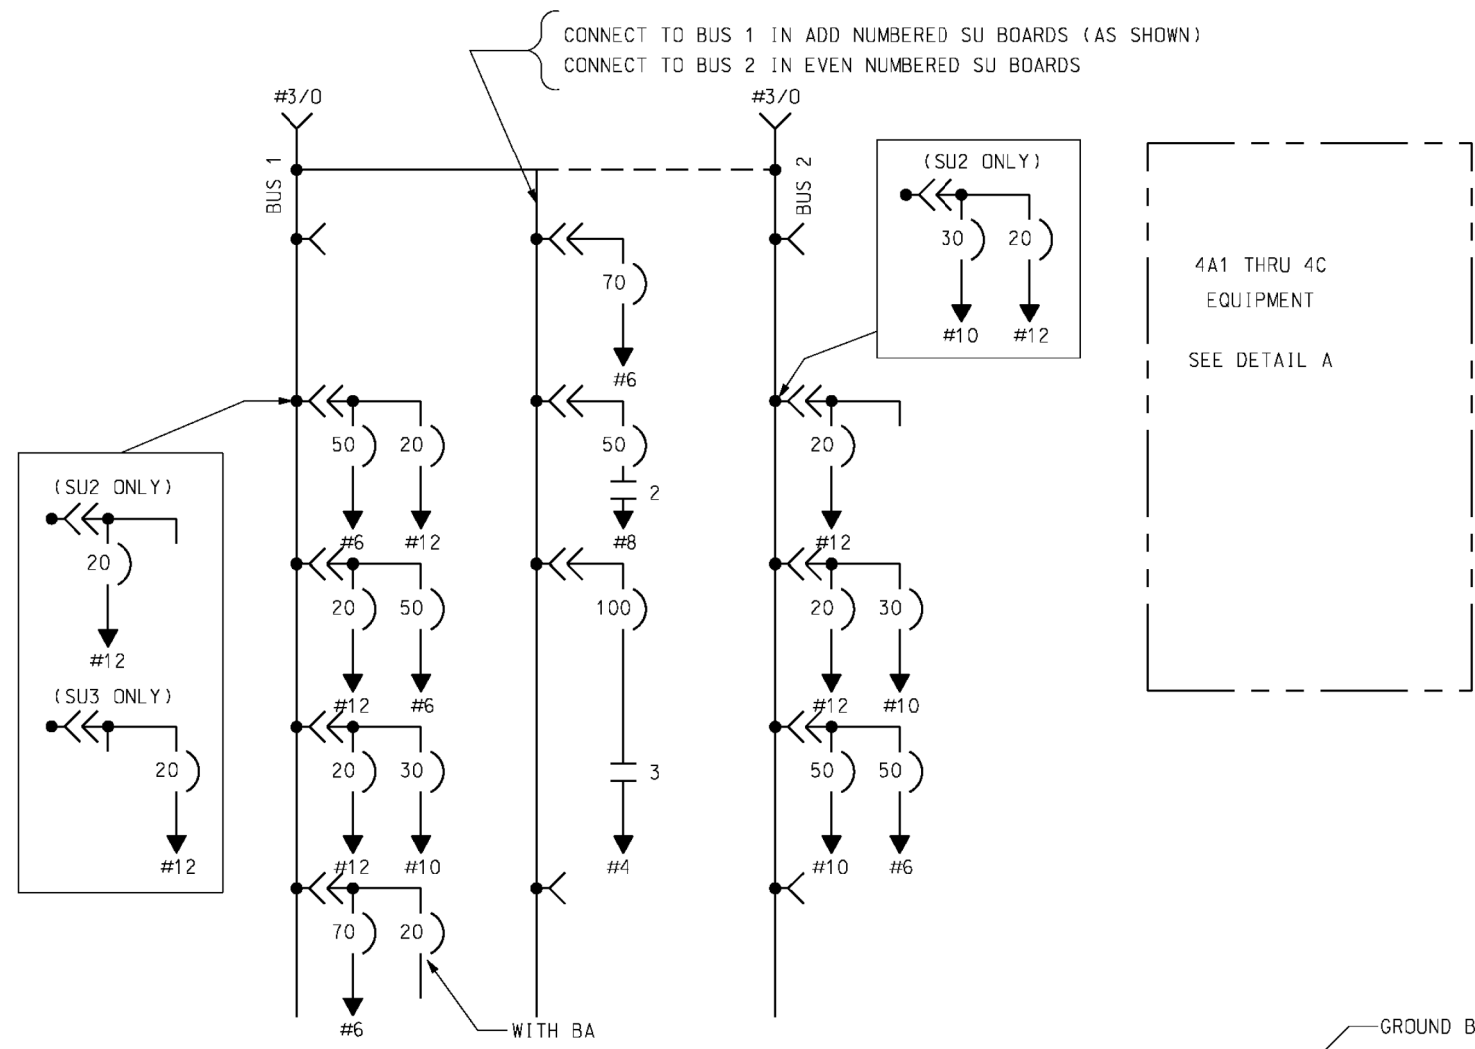


ONE LINE DIAGRAM

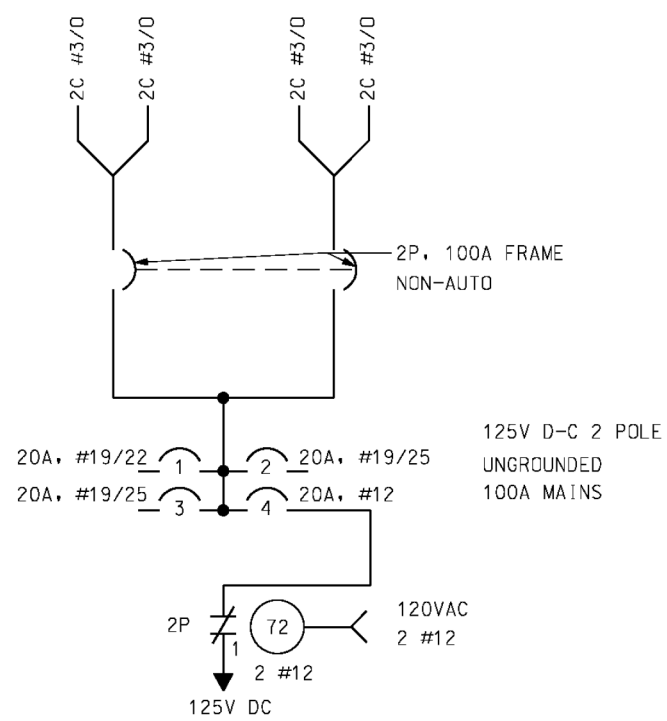

DETAIL A

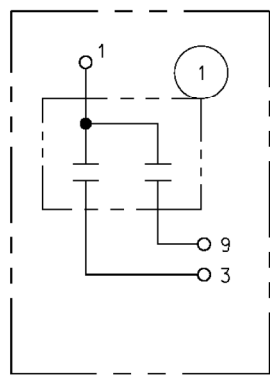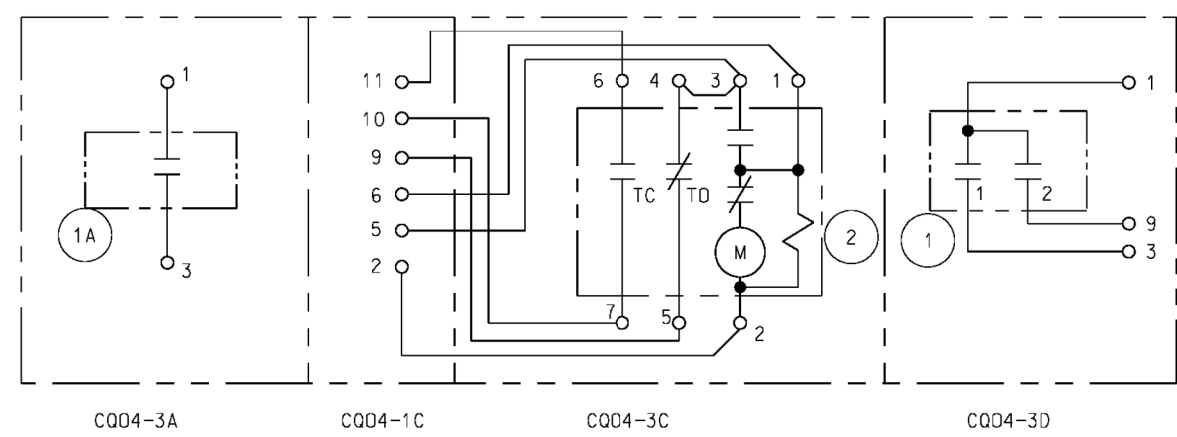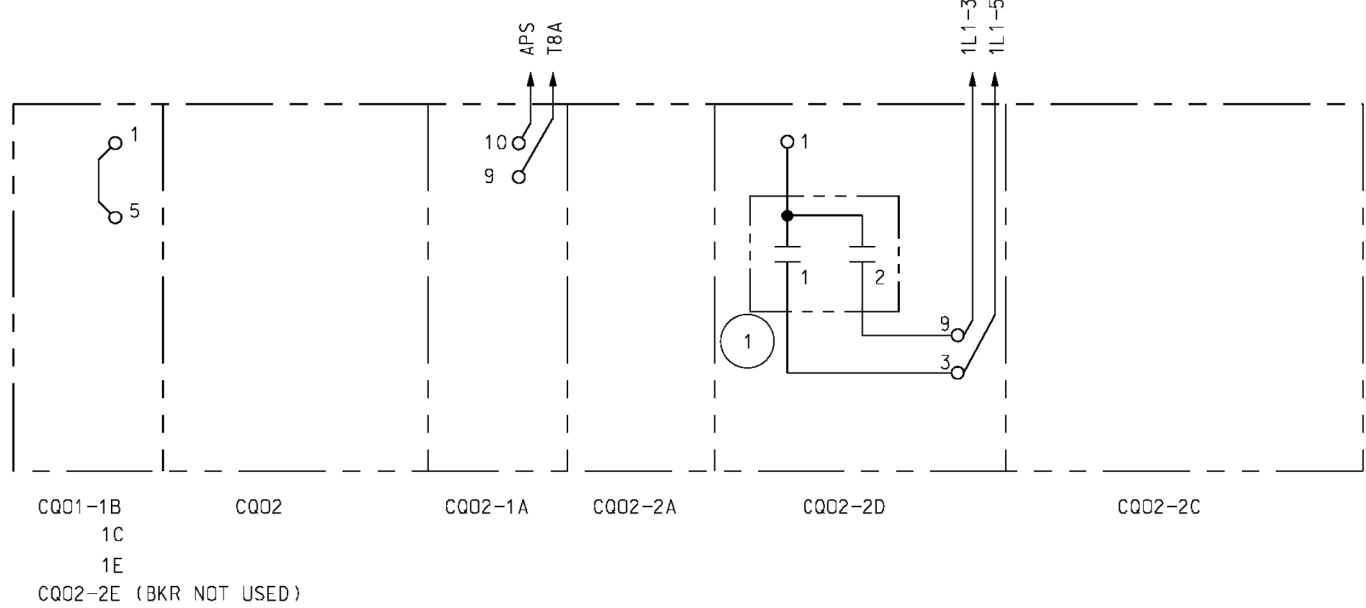

2B
HAND/OFF/AUTO
SU1, SU2, SU3

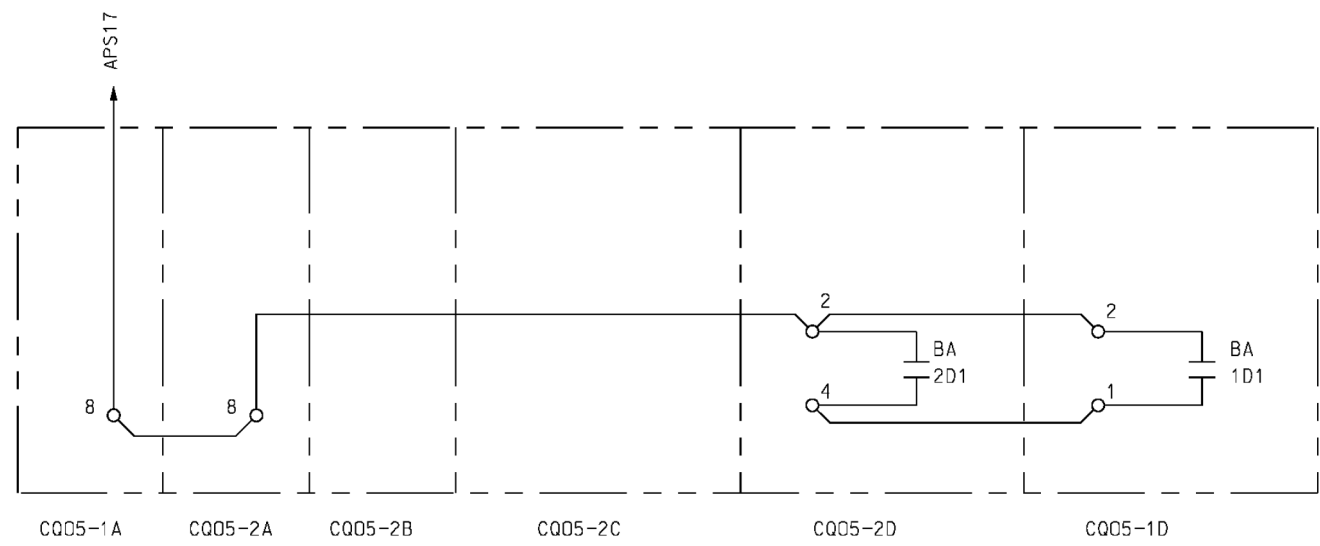

CONTROL CONNECTIONS
SEE NOTE 6



AS CONSTRUCTED
HYDRO ELECTRIC DESIGN BRANCH, N

DATE 1971 SEP 7 BY _____




1. FOR LEGEND SEE DWG LGP-1-6-1A8/3.
2. THE NUMBER OF VERTICAL SECTIONS SHALL BE AS SHOWN; OTHERWISE, VARIATIONS IN EQUIPMENT ARRANGEMENT WILL BE ALLOWED TO FIT MANUFACTURERS STANDARD CONSTRUCTION SUBJECT TO APPROVAL OF THE CONTRACTING OFFICER.
3. ALL EMPTY COMPARTMENTS SHALL HAVE BLANK COVERS AND BE CONSTRUCTED TO ACCOMMODATE FUTURE OPERATING UNITS.
4. THIS DRAWING IS REPRESENTATIVE OF CONTROL CENTERS SU1 THRU SU3 WITH VARIATIONS IN BUS CONNECTIONS AND NAMEPLATES AS INDICATED.
5. EACH CONTROL CENTER SHALL BE SHIPPED IN ONE PIECE.
6. SEE DWG LGP-1-6-1A8/3 FOR ARRANGEMENTS OF CONTROL CENTERS C001, C002, C004, AND C005.
7. NO OVERLOAD DEVICES ARE REQUIRED FOR CONTACTORS IN C002-2D, C004-3D, C005-1C AND SU1, SU2, SU3, COMPARTMENTS 2B AND 4C.
8. THIS DRAWING, INCLUDING NOTES 1 THROUGH 7, WAS ISSUED AS LGP-1-6-1A8/4 FOR PROCUREMENT OF GOVERNMENT-FURNISHED 480 VOLT CONTROL CENTERS SU1, SU2 AND SU3 DESIGN IS SUBJECT TO MODIFICATION IN ACCORDANCE WITH NOTE 2. WESTINGHOUSE ELECTRIC CORPORATION IS THE CONTRACTOR.


[illegible]

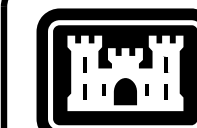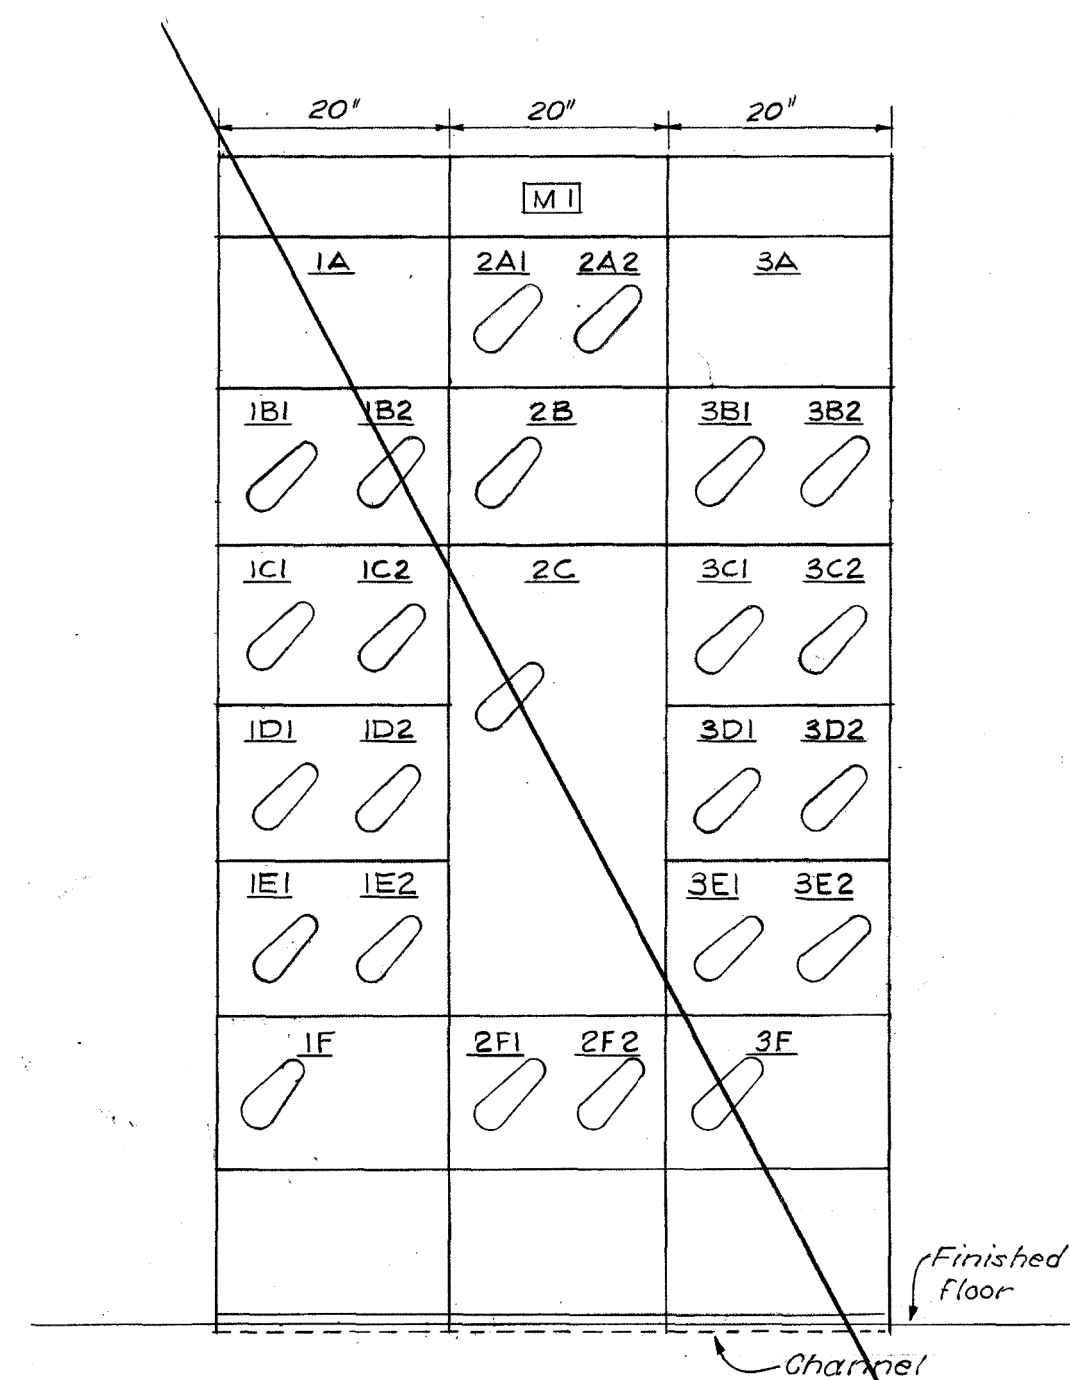US Army Corps
of Engineers®

FRONT VIEW

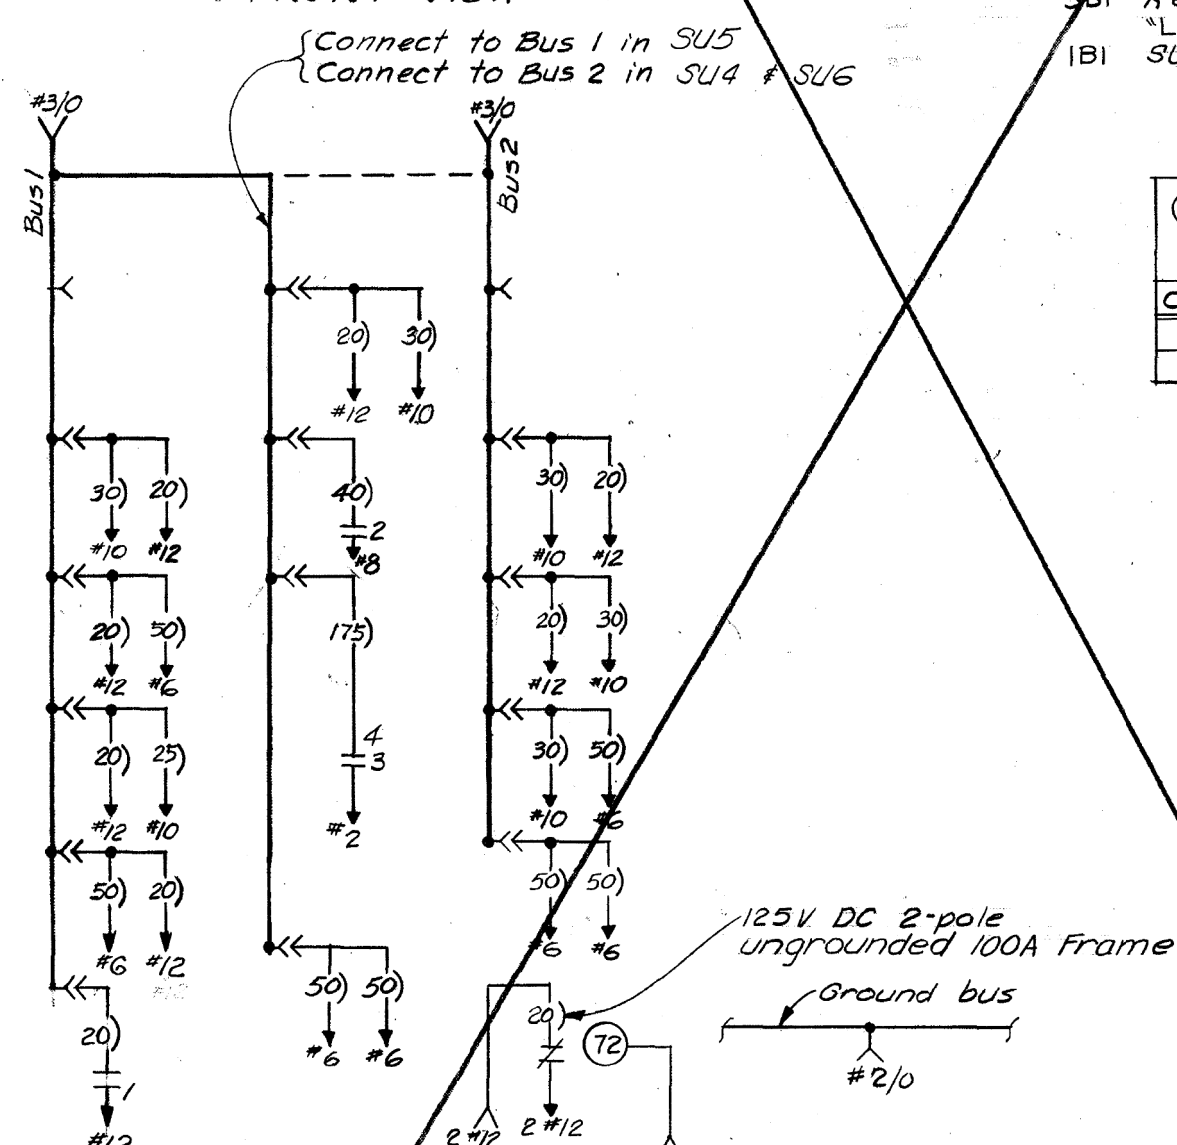

ONE LINE DIAGRAM

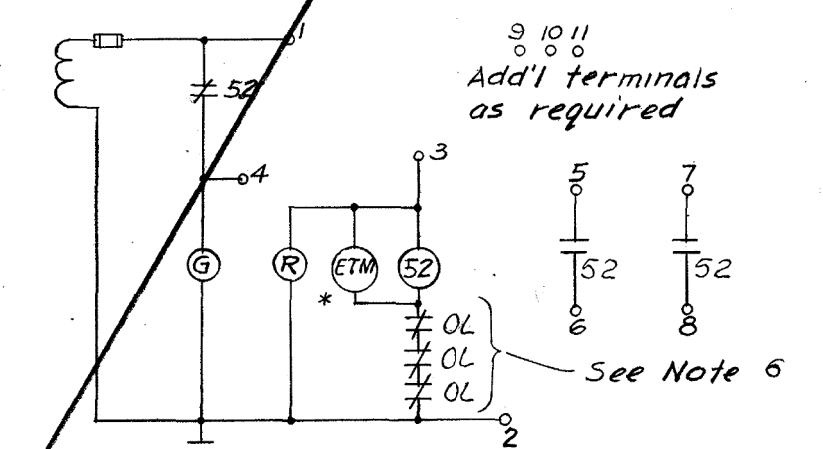TYPICAL SCHEMATIC DIAGRAM
(See control connections for variations and interconnections)
* (See comp't layout for ETM location)


NAMEPLATE SCHEDULE		
NO	FIRST LINE	SECOND LINE
* M1	SU4 480V	CONTROL CENTER
1A	None (See Note 3)	
* 1B1	AIR CKT BKR	COMPRESSOR NO.1
1B2	GEN BKR	COOLER A
1C1	HEAD COVER	PUMP NO.1
1C2	480 VOLT	OUTLETS
1D1	TURBINE BRG	OIL SUMP PUMP
1D2	LIGHT TRANS	TR42
* 1E1	LIGHT TRANS	TR41
1E2	Blank	
* 1F	GOVERNOR AIR	COMPRESSOR
2A1	Blank	
* 2A2	AIR CKT BKR	COMPRESSOR NO.2
2B	GENERATOR	HEATERS
2C	GOVERNOR OIL	PUMP NO.1
2F1	480 VOLT	OUTLETS
2F2	480 VOLT	OUTLETS
3A	None (See Note 3)	
* 3B1	Blank	
3B2	GEN BKR	COOLER B
3C1	HEAD COVER	PUMP NO.2
3C2	HIGH BAY	LIGHTS
3D1	THRUST BRG	OIL PUMP
3D2	480 VOLT	OUTLETS
3E1	480 VOLT	OUTLETS
3E2	480 VOLT	OUTLETS
3F	125V DC	EMERG. LIGHTING

* Nameplates are shown for SU4 and are same for other boards except as noted below


M1 Replace SU4 with SU5, SU6
1D2 Replace TR42 with TR52 in SU5, TR62 in SU6
1E1 Replace TR41 with TR51 in SU5, TR61 in SU6
1F SU4 only, blank on SU5 & SU6
2A2 SU4 only, blank on SU5 & SU6
3B1 Replace blank with "HIGHBAY" (first line) "LIGHTS" (second line) in SU5 only, SU4 only, blank on SU5 & SU6
1B1 SU4 only, blank on SU5 & SU6

CONTACT	OFF ON AUTO Maintained Contacts			
	ON	OFF	AUTO	
1		X		
2			X	


Refer to 480V Equipment Drawings
Contract No. DACW-76-C-0247
ER Queen Co.

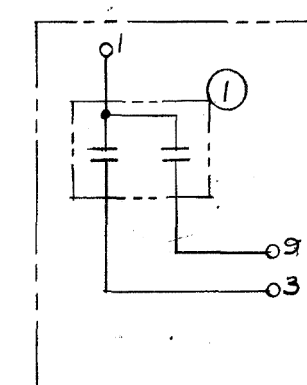

CONTROL CONNECTIONS

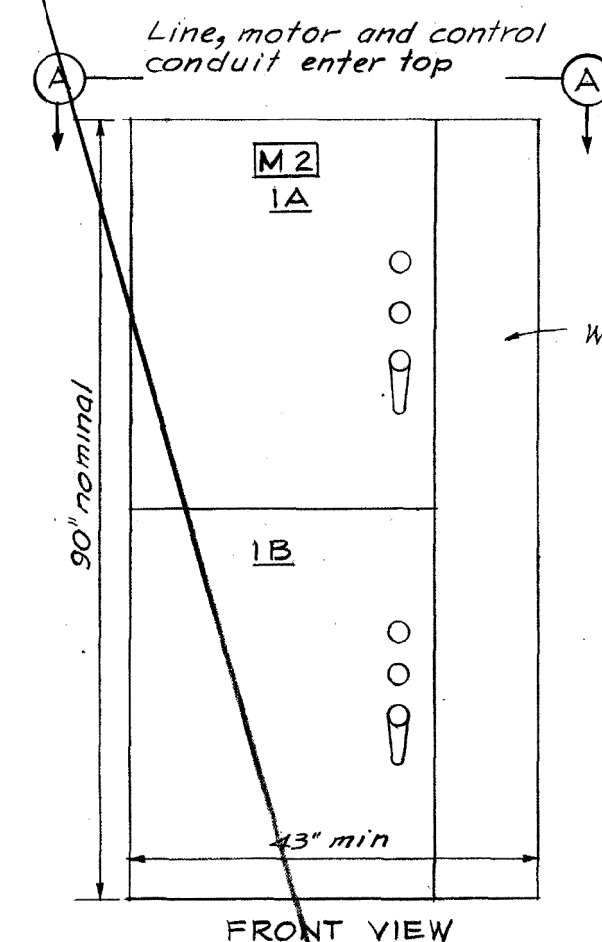FRONT VIEW
CP- CONTROLLER
(TYPICAL)

NAMEPLATE SCHEDULE		
NO.	FIRST LINE	SECOND LINE
* M2	CP- 4160V	CONTROLLER
1A	60V OIL PUMP	NO. 2
1B	60V OIL PUMP	NO. 3
* CP4 THRU CP6		

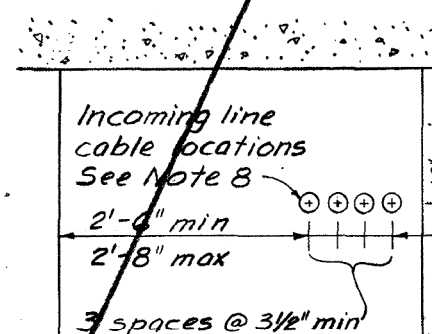

SECTION A - A

THIS DRAWING WAS PREPARED FOR PROCUREMENT OF GOVERNMENT-FURNISHED EQUIPMENT AND REPRESENTS THE LATEST AVAILABLE INFORMATION. THIS DRAWING WILL BE SUPERSEDED BY MANUFACTURER'S SHOP DRAWINGS FOR INSTALLATION PURPOSES.

LEGEND

In accordance with ANSI standards C37.2-1969 (rev. 1974) & Y32.2-1970 except as noted:

- Power fuse with disconnect means.
- Outgoing cable; number indicates wire size.
- Indicating lights; R-red, G-green.
- OL Overload relay
- Selector switch. See development.
- A-C contactor operating coil.
- Auxiliary relay
- Circuit or compartment no. See nameplate schedules.
- Master nameplate
- Terminal block point for external connections
- Elapsed time meter

NOTES

- For Legend see Dwg. LGR-19-6-1A8/7.
- The number of vertical sections shall be as shown; otherwise, variations in equipment arrangement will be allowed to fit manufacturer's standard construction subject to approval of the Contracting Officer.
- All empty compartments shall have blank covers and be constructed to accommodate future operating units.
- This drawing is representative of control centers SU4 thru SU6 and controllers CP4 thru CP6 with variations in bus connections and nameplates as indicated.
- Each control center and controller shall be shipped in one piece.
- No overload devices are required for contactors in SU4, SU5, SU6 compartments 2B and 3F.
- Controllers shall be rated 4.6KV and 250 mva interrupting capacity.
- The CP- controllers and wireway shall accommodate the entrance of 4 line armor cables. A pullbox with a maximum height of 10 inches shall be furnished if required to meet the limitations shown.
- Control transformer for operating unit 1F shall have an additional 100 VA capacity for continuous operation of electro-magnetic devices.

98/99

SUPERSEDED
BY EQUIPMENT MANUFACTURERS
SHOP DRAWINGS
SEP 30 1980

C	805894	Superseded by Shop Drawings	RCM
B	75M45	Bid item number	EMS
A	15Apr84	General revisions	EMS
REVISION	DATE	DESCRIPTION	BY
DESIGNED BY:	RCM		
DRAWN BY:	SMT. 1218		
CHECKED BY:	UMX		
PREPARED BY:	RCM		
APPROVED BY:	RCM		
CHIEF, HYDRO-ELECTRIC DESIGN BRANCH			
DATE 1975 MAR 9 1			
SCALE AS SHOWN	SPEC. NO. 75-B-55		
SHEET 227			

U. S. ARMY ENGINEER DIVISION, N. P.
PORTLAND, OREGON

LITTLE GOOSE LOCK AND DAM
SNAKE RIVER, OREGON, WASHINGTON & IDAHO
POWERHOUSE UNITS 4-6
ELECTRICAL EQUIPMENT
480 VOLT CONTROL CENTERS
SU4-SU6 & 4.16 KV CONTROLLERS


APPROVED FOR DIV. ENGINEER
CHIEF, HYDRO-ELECTRIC DESIGN BRANCH

LITTLE GOOSE LOCK AND DAM
POWERHOUSE
DC SYSTEM AND LOW VOLTAGE SWITCHGEAR
POWERHOUSE
480 VOLT CONTROL CENTERS
SU4-SU6 & 4.16KV CONTROLLERS

SHEET ID

R-038

FINAL

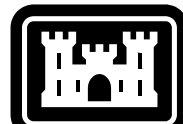US Army Corps
of Engineers®

LEGEND

In accordance with ASA standards C37.2-1962 and Y32.2-1962 except as noted.

20 Air circuit breaker; 3 pole with thermal and magnetic overload devices except as noted; number indicates trip rating.

1/2 Contactor; 3 pole with manual reset overload relays except as noted; number indicates NEMA size.

1/2 Outgoing cable; number indicates wire size.

⊙ (R) Indicating lights; R-red, G-green.

OL Overload relay contact

① (A) Selector switch. See developments.

52 AC contactor operating coil

72 DC contactor operating coil

2 Time delay relay

TC Time clock

+ Key interlock

1A Circuit or compartment number; see nameplate schedule.


MI Master nameplate

Terminal block point for external connection.


BA Breaker alarm contact; closes on automatic trip.

NOTES


- The number of vertical sections shall be as shown; otherwise, variations in equipment arrangement will be allowed to fit manufacturers standard construction subject to approval of the Contracting Officer.
- All empty compartments shall have blank covers and be constructed to accommodate future operating units.
- Control transformers for operating units 1D in CQ01, 1A, 2B, 4B, 4C & 5A in CQ02 and 5C in CQ04 shall each have sufficient capacity for an external continuous load of 100va consisting of solenoid valves, magnetic unloaders, etc.
- No overload devices are required for contactors in CQ02-2D, CQ04-3D and CQ05-1C.
- Each control center shall be shipped in one piece.
- Typical Schematic Diagrams and Control Connections are shown on Dwg LGP-1-6-1A8/4.

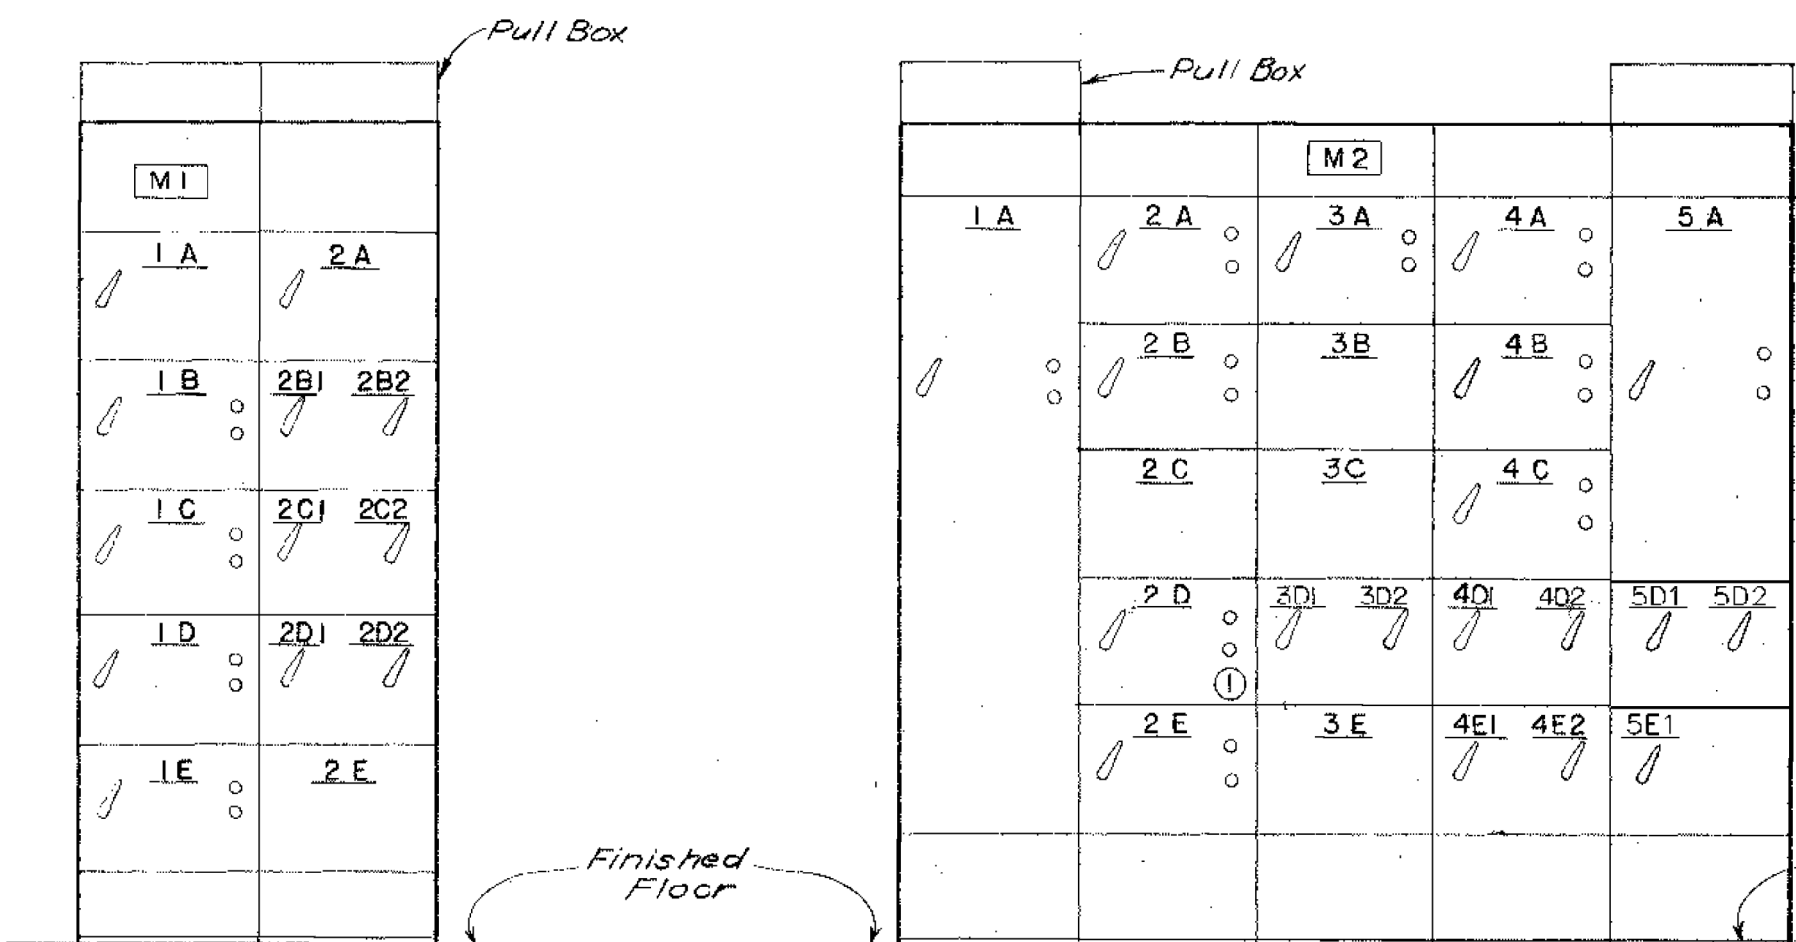


FRONT VIEW

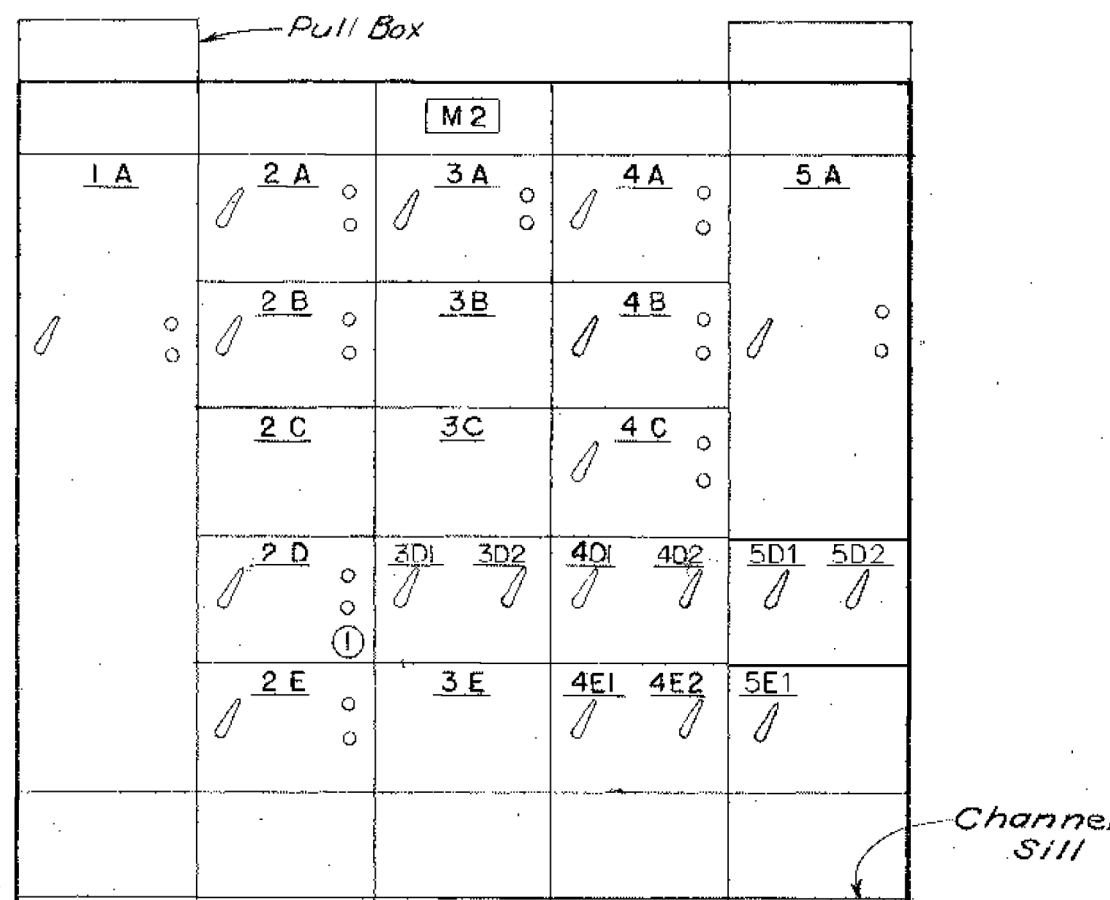


FRONT VIEW

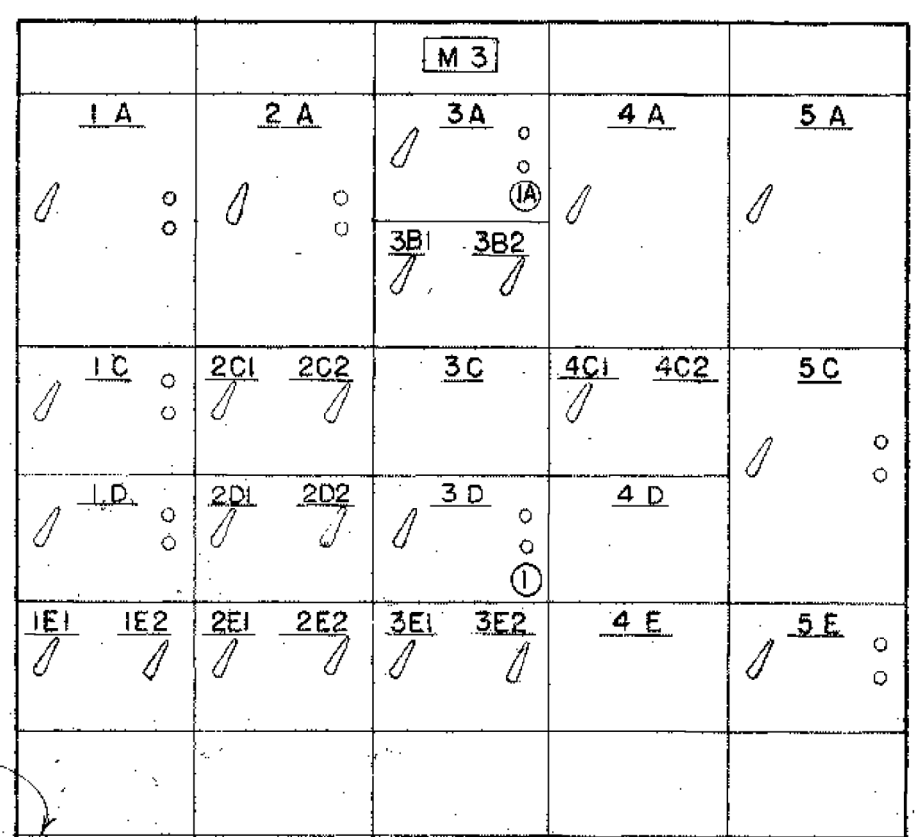


FRONT VIEW

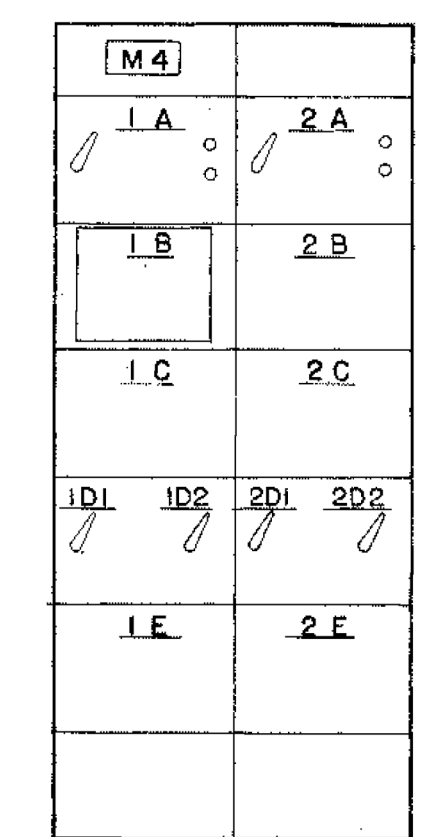


FRONT VIEW

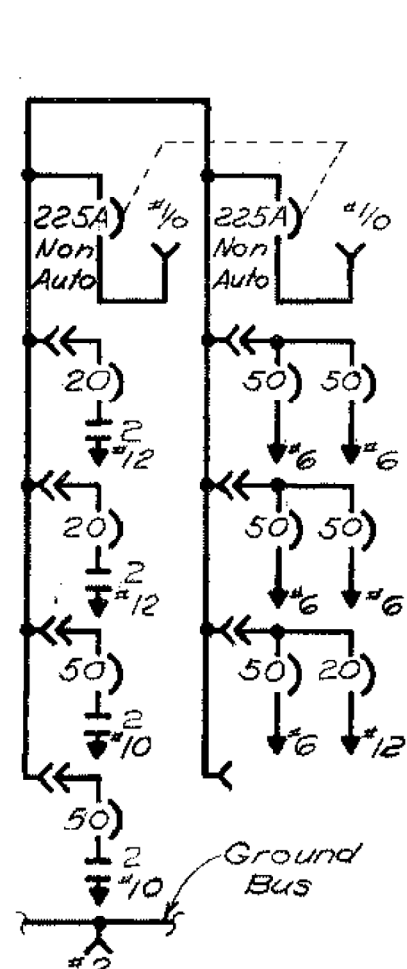


ONE LINE

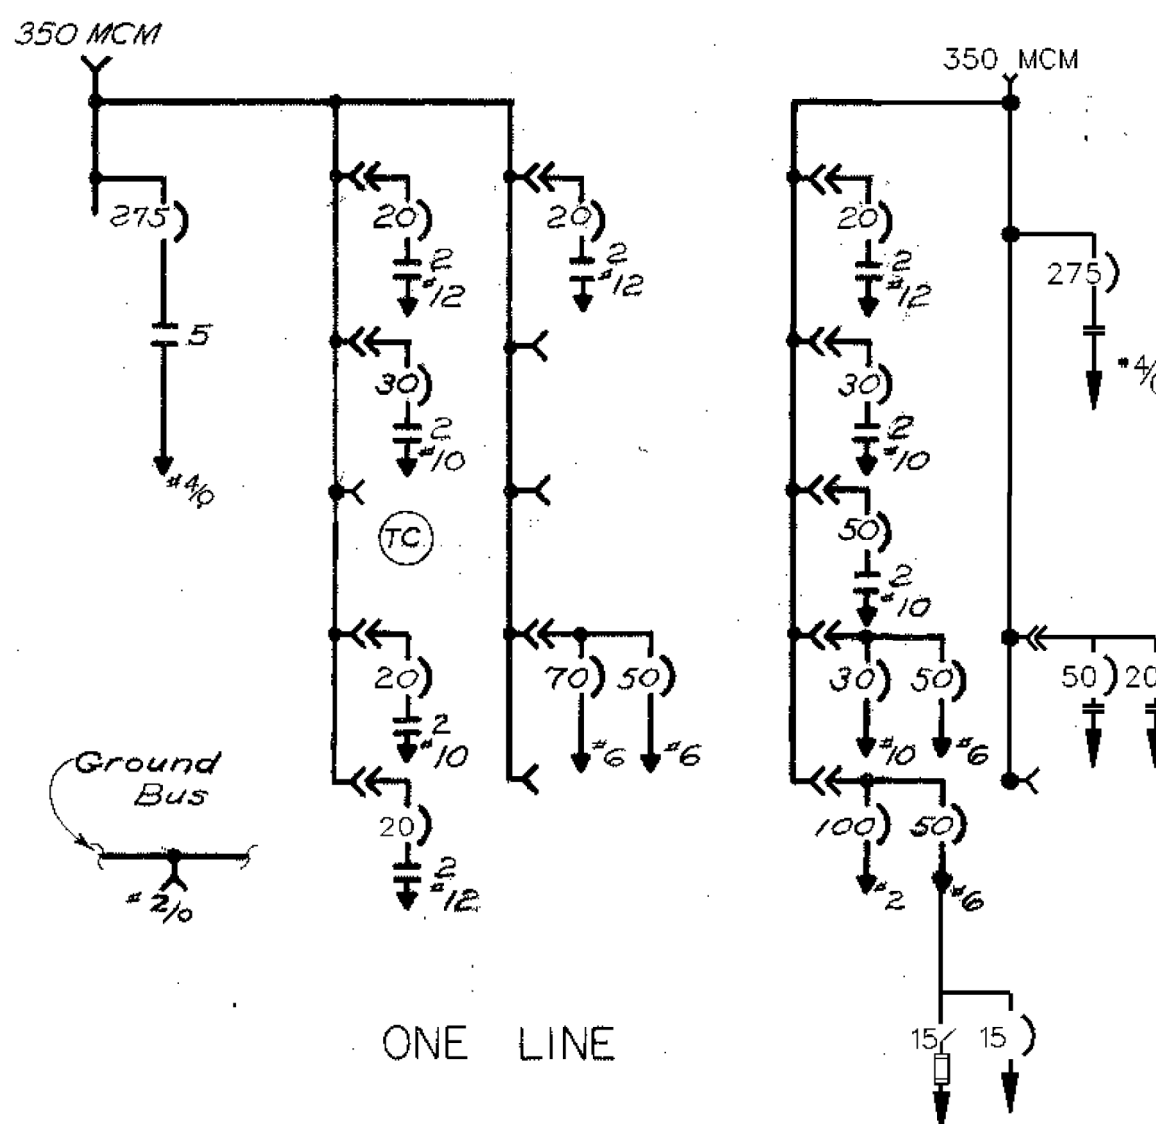

ONE LINE

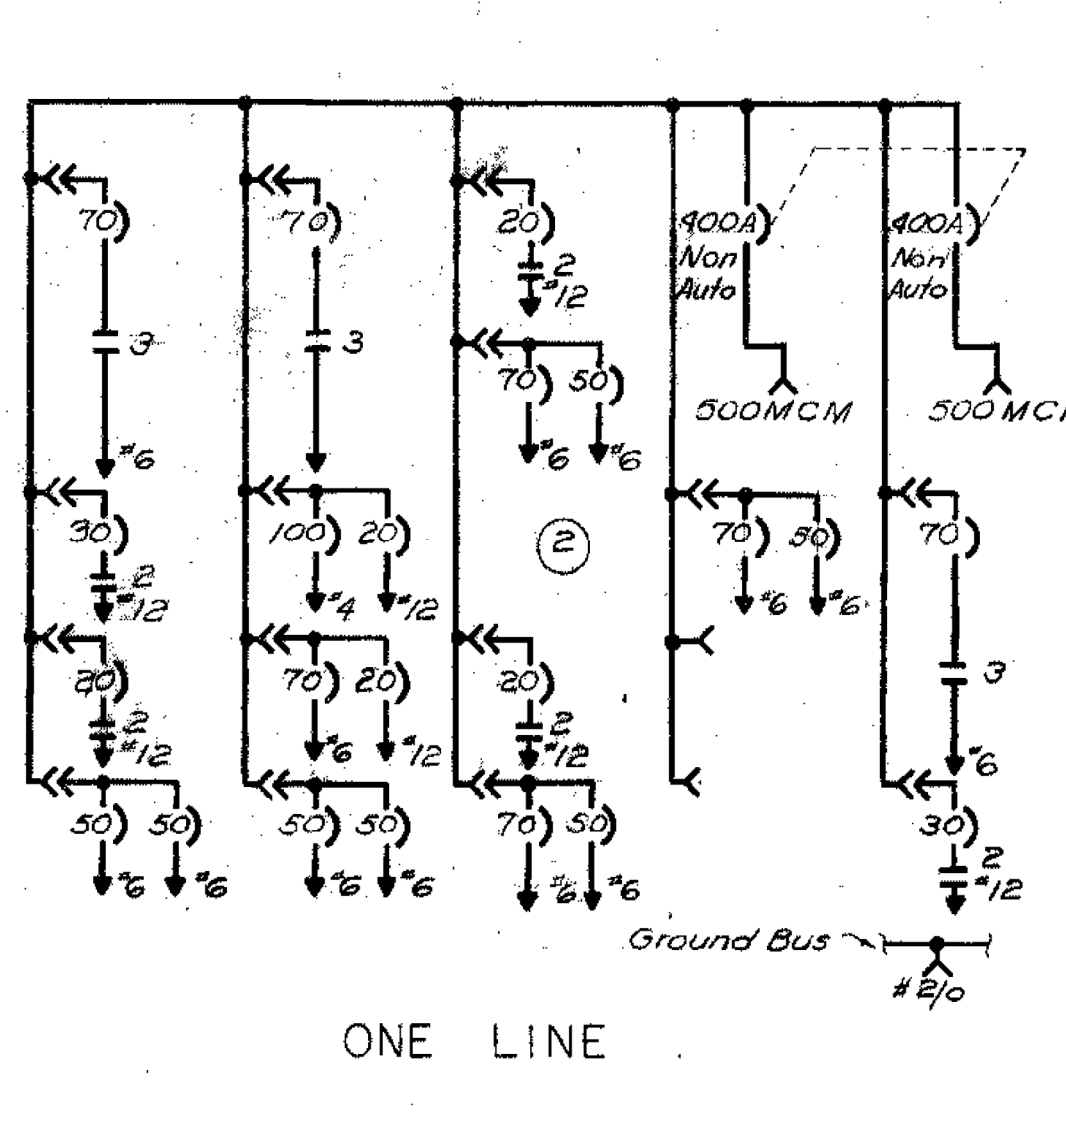

ONE LINE

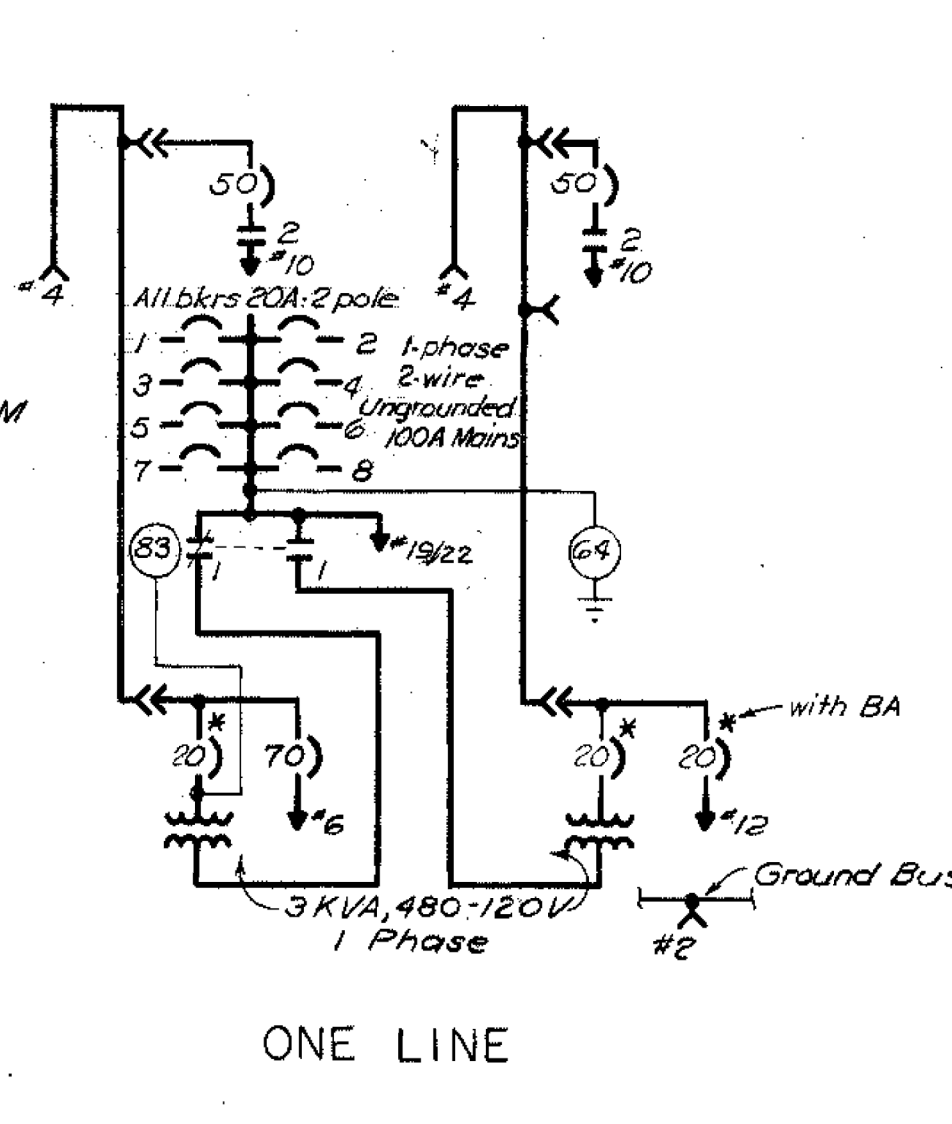

ONE LINE

NAMEPLATE SCHEDULE

NO.	FIRST LINE	SECOND LINE
MI	CQ01 480 VOLT	CONTROL CENTER
1A	MAIN BREAKER	BUS 1
1B	TRANSIL OIL	PUMP NO.1
1C	TRANSIL OIL	PUMP NO.2
1D	LUBE OIL	PUMP NO.3
1E	DIRTY OIL	PUMP NO.4
2A	MAIN BREAKER	BUS 2
2B	OIL PURIFIER	OUTLET NO. 1
2C	OIL PURIFIER	OUTLET NO. 2
2D	OIL PURIFIER	OUTLET NO. 3
2E	Blank	OUTLET NO. 4
2D1	Blank	
2D2	Blank	
2E	None (See Note 2)	

CQ01

NAMEPLATE SCHEDULE

NO.	FIRST LINE	SECOND LINE
M2	CQ02 480 VOLT	CONTROL CENTER
1A	STATION AIR	COMPRESSOR NO. 4
2A	SEWAGE	PUMP NO.1
2B	STATION AIR	COMPRESSOR NO.1
2C	NONE (SEE NOTE 2)	
2D	TAILRACE	DECK LIGHTS
2E	SEWAGE	SLUDGE PUMP
3A	Blank	
3B	None (See Note 2)	
3C	None (See Note 2)	
3D1	LIGHT TRANS	TRO1
3D2	480 VOLT	OUTLETS
3E	None (See Note 2)	
4A	STATION AIR	PUMP NO. 2
4C	GOVERNOR AIR	COMPRESSOR NO. 2
4D1	LIGHT TRANS	TRO2
4D2	480 VOLT	OUTLETS
4E1	CRANE	COMPRESSOR, 4E2, COMMUNUTER
4E2	SEWAGE AIR	COMPRESSOR NO. 3
5A	STATION AIR	
5D1	SPARE	
5D2	FISH PUMP ROOM	120V RECEPTACLES
5E	NONE (SEE NOTE 2)	

CQ02

NAMEPLATE SCHEDULE

NO.	FIRST LINE	SECOND LINE
M3	CQ04 480 VOLT	CONTROL CENTER
1A	INTAKE GATE	HYD PUMP NO.1
1C	INTAKE GATE	HYD PUMP NO.3
1D	UNIT CONDITIONER	UC-2
1E1	OIL PURIFIER	OUTLETS
1E	OIL PURIFIER	OUTLETS
2A	INTAKE GATE	HYD PUMP NO.2
2C1	ELEVATOR	COMPRESSOR NO.1
2C2	AIR CKT BRK	CRANE
2D1	AIR CKT BRK	COMPRESSOR NO.2
2E1	OIL PURIFIER	OUTLETS
2E2	OIL PURIFIER	OUTLETS
3A	UNIT CONDITIONER	UC-1
3B1	LIGHT TRANS	TRO6
3B2	480 VOLT	OUTLETS
3C	INTAKE GATE	HYD PUMP RELAY
3D	INTAKE DECK	LIGHTS
3E1	LIGHT TRANS	TRO7
3E2	480 VOLT	OUTLETS
4A	MAIN BREAKER	BUS 1
4C1	HOT WATER	BOILER
4C2	INTAKE CRANE	HEATER
4D	None (See Note 2)	
4E	None (See Note 2)	
5A	MAIN BREAKER	BUS 2
5C	CENTRAL COND FAN	SF-1
5E	RECIRCULATING FAN	RF-1

CQ04

NAMEPLATE SCHEDULE

NO.	FIRST LINE	SECOND LINE
M4	CQ05 480 VOLT	CONTROL CENTER
1A	MG-1	MOTOR SUPPLY
1B	PREF AC	120 PANEL
1C	PREF AC	TRANSFER SW
1D1	PREF AC	BUS 1
1D2	LIGHT TRANS	TRO5
1E	PREF AC	TRANS-BUS 1
2A	MG 2	MOTOR SUPPLY
2B	None (See Note 2)	
2C	PREF AC	GND DETECTOR
2D1	PREF AC	BUS 2
2D2	48 VOLT	BATTERY CHARGER
2E	PREF AC	TRANS-BUS 2

CQ05

PREFERRED AC PANELBOARD
DIRECTORY SCHEDULE

BKR NO.	
1	
2	
3	
4	METER SHOP
5	TELEPHONE ROOM
6	OFFICES
7	CODE CALL
8	

OFF	ON	MAINTAINED
1	X	
2		X

OFF	ON	MAINTAINED
1	X	
2		X

NO.1 LEAD	NO.2 LEAD	MAINTAINED
1	X	
2		X
3	X	
4		X
5	X	
6		X
7	X	
8		X

NO SCALE

U. S. ARMY ENGINEER DIVISION, N. P.
PORTLAND, OREGONLITTLE GOOSE LOCK AND DAM
SNAKE RIVER, OREGON, WASHINGTON & IDAHO
POWERHOUSE
480 VOLT CONTROL CENTERS
CQ01, CQ02, CQ04 & CQ05APPROVED FOR DIV. ENGINEER DATE 10 MAR 68
BY [Signature]
SHEET 3
SCALE AS SHOWN SPEC. NO. C 65-0
LGP-1-6-1A8/3

SHEET ID

R-039

FINAL

[illegible]

U.S. ARMY ENGINEER DISTRICT CORPS OF ENGINEERS WALLA WALLA WASHINGTON	DESIGNED BY:	DATE:
	DWN BY:	16 JULY 2009
	CHECKED BY:	SOLICITATION NO.
		09-R-0043
	SUBMITTED BY:	CONTRACT NO.
		10-C-0005
	FILE NO.:	
	LGP-1.1-6-1AB/5	

POWERHOUSE HVAC CONTROLS UPGRADE
POWERHOUSE
AIR CONDITIONING SYSTEM
480 VOLT SUBSTATION SH

Sheet number:

1-018


SHEET ID

R-040


FINAL

CORPS OF ENGINEERS

U. S. ARMY

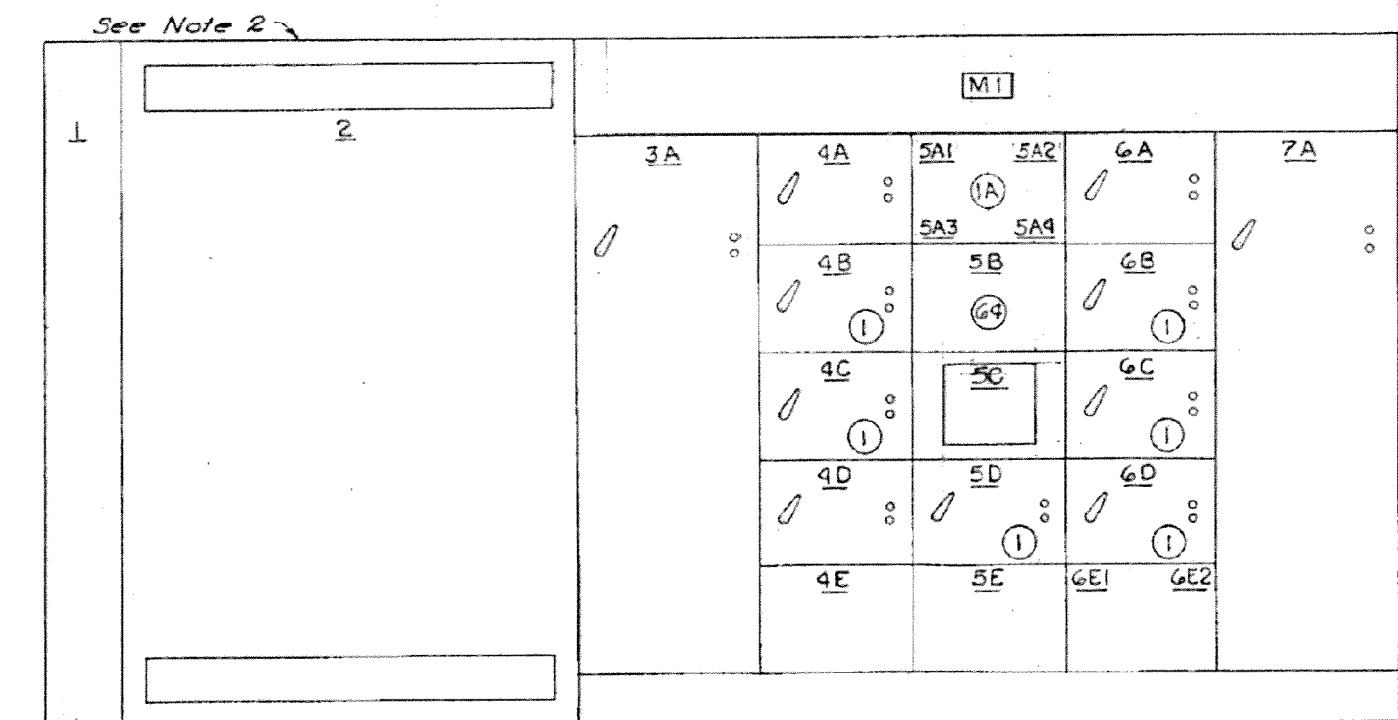


FRONT VIEW

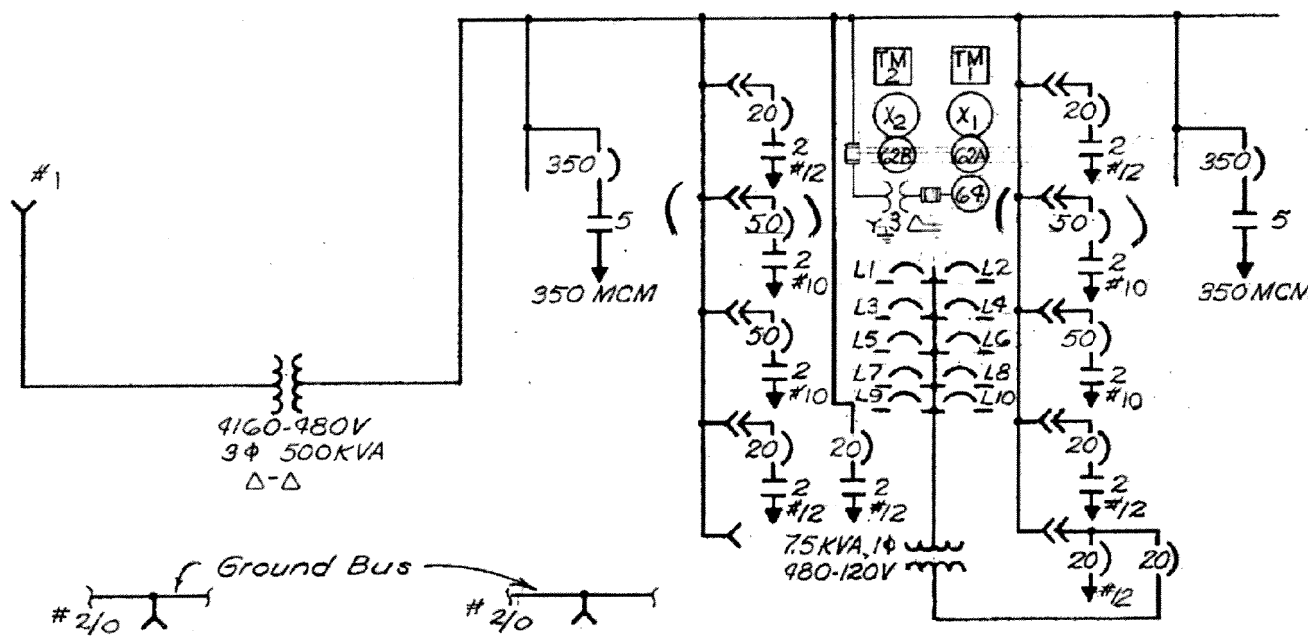



ONE LINE DIAGRAM

NAME PLATE SCHEDULE		
NO.	FIRST LINE	SECOND LINE
1	TERMINAL	SECTION
2	TRANSFORMER	SECTION
3A	COMPRESSOR	UNIT NO. 2
4A	OIL PUMP	UNIT NO. 2
4B	CIRCULATING	WATER PUMP P-4
4C	HEAT PUMP SUPPLY	WATER PUMP P-3
4D	UNIT CONDITIONER	UC-3
4E	<i>None (See Note 4)</i>	
5A1	TIME METER	WATER PUMP 2
5A2	TIME METER	HEAT PUMP 1
5A3	AUXILIARY RELAY	X 2
5A4	AUXILIARY RELAY	X 1
5B	POT TRANS	GROUND RELAY
5C	CONTROL	BREAKERS
5D	BOOSTER	WATER PUMP P-5
5E	480 - 120 V	TRANSFORMER
6A	OIL PUMP	UNIT NO. 1
6B	CIRCULATING	WATER PUMP P-2
6C	HEAT PUMP SUPPLY	WATER PUMP P-1
6D	INTER COOLING	WATER PUMP P-6
6E1	<i>Blank</i>	
6E2	CONTROL TRANS	SUPPLY
7A	COMPRESSOR	UNIT NO. 1
M1	SH 480V	SWITCHGEAR


120 VOLT PANEL (3C) NAMEPLATE SCHEDULE	
NO.	FIRST LINE
L1	UNIT NO. 2
L2	UNIT NO. 1
L3	COMPRESSOR NO. 2
L4	COMPRESSOR NO. 1
L5	PURGE UNIT NO. 2
L6	PURGE UNIT NO. 1
L7	INTER-COOLING PUMP
L8	MASTER CONTROL
L9	UNIT COND. UC=3
L10	(BLANK)

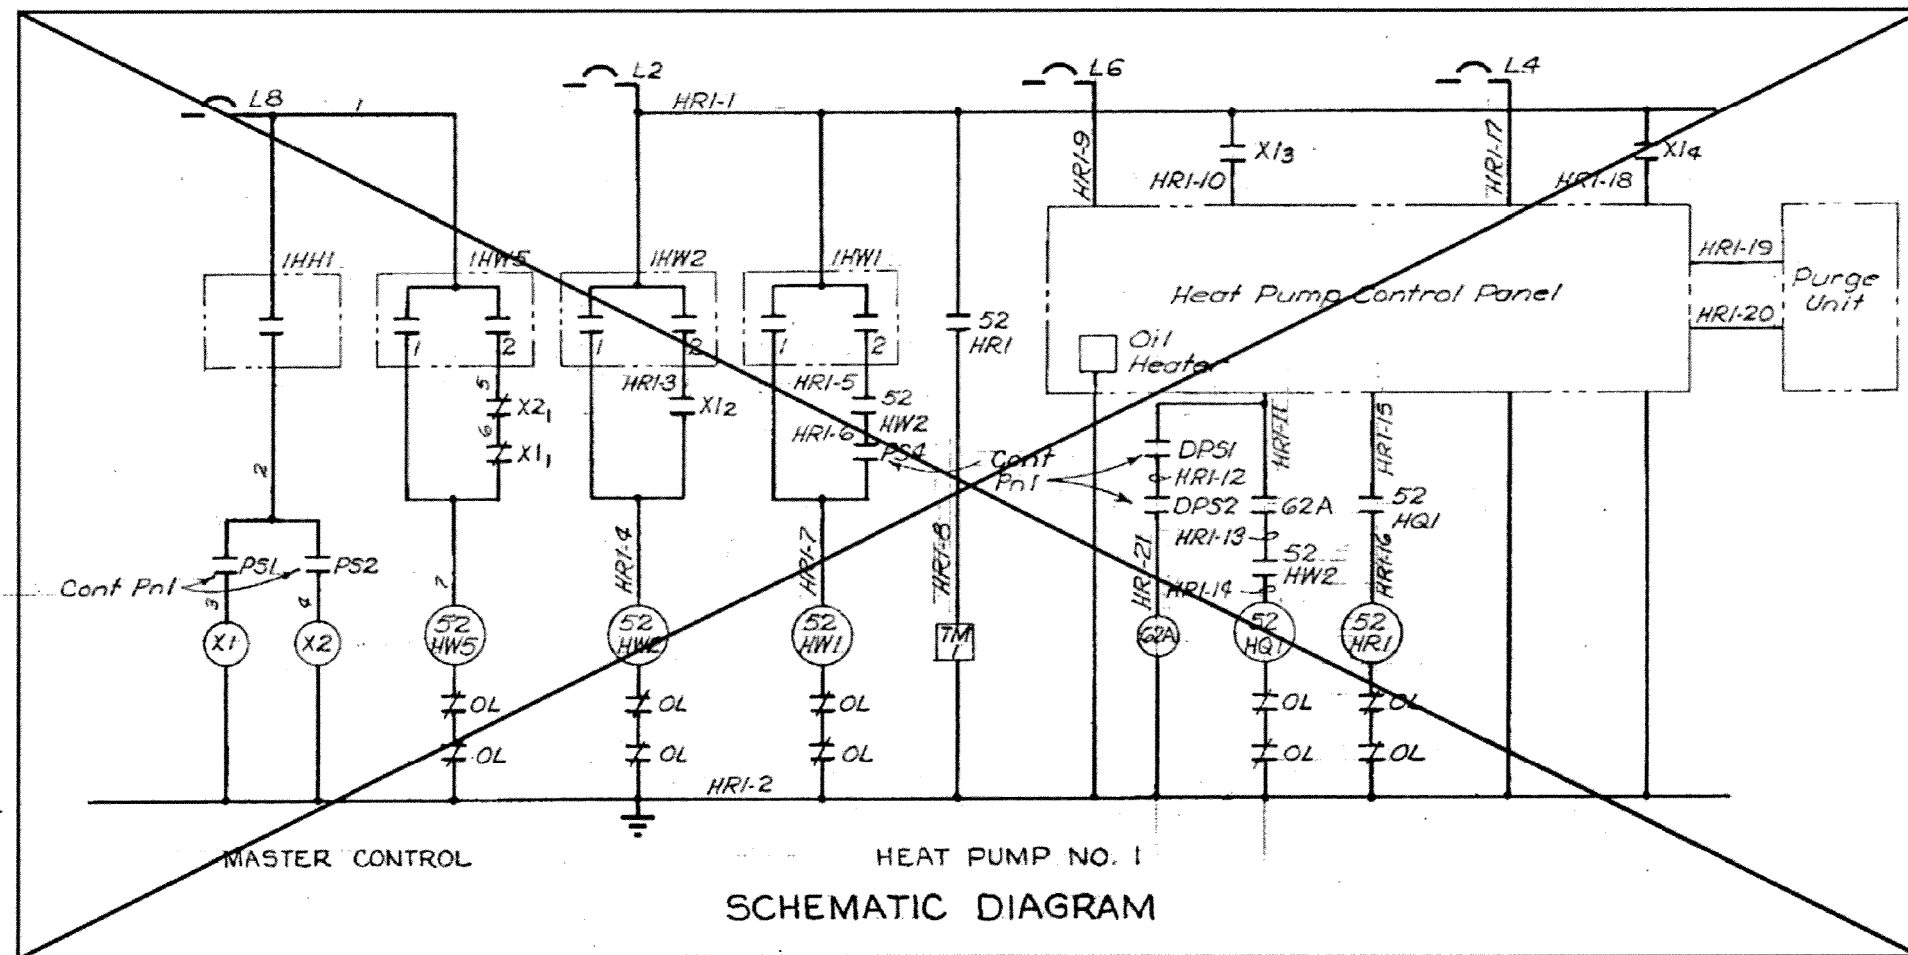


SCHEMATIC DIAGRAM

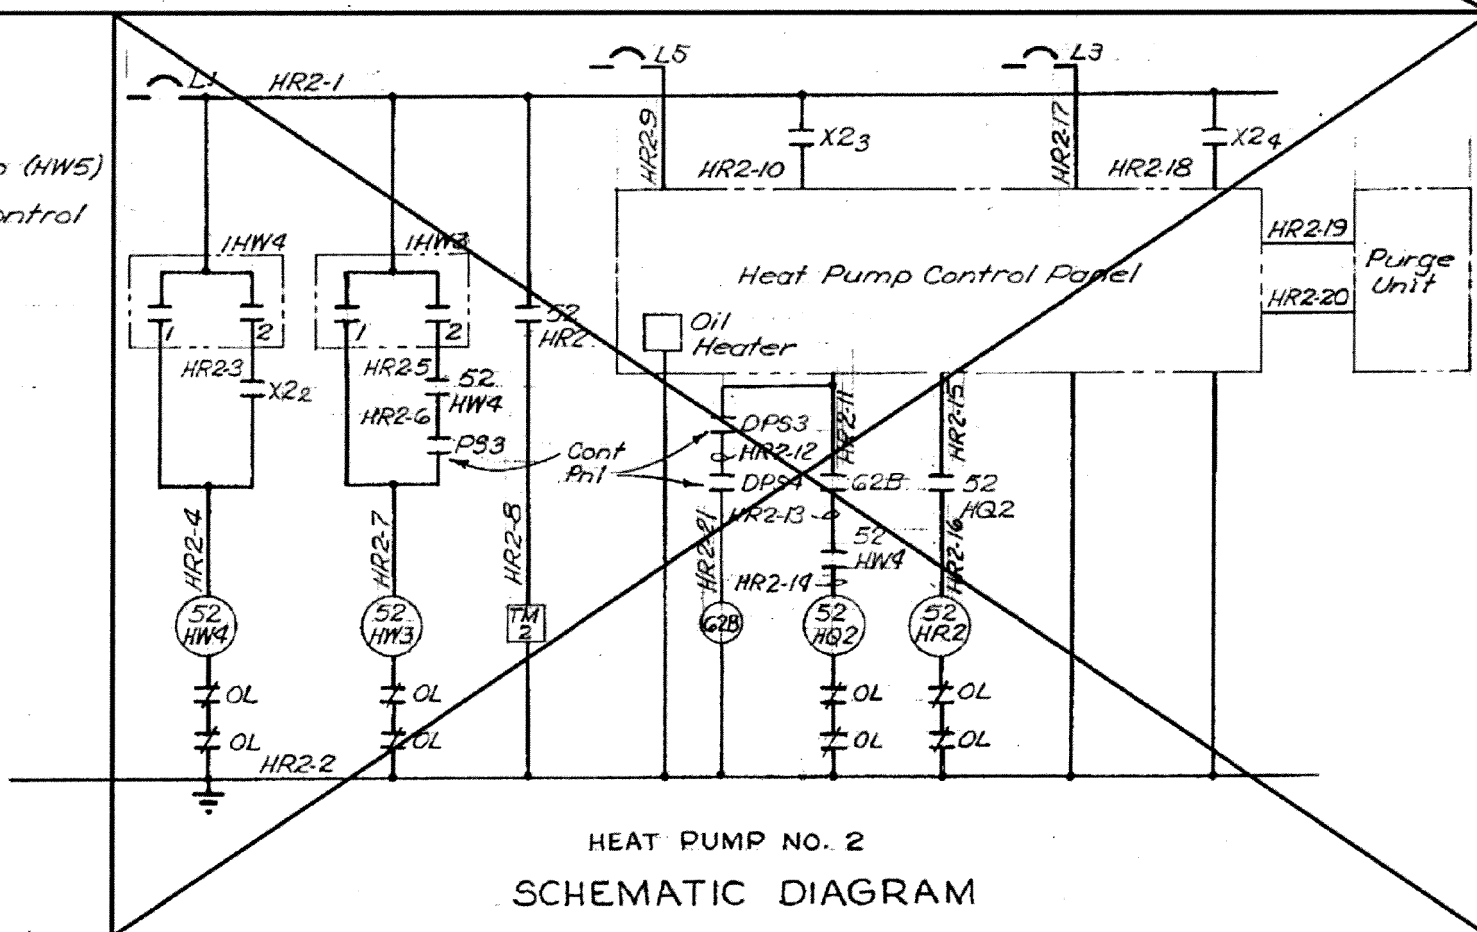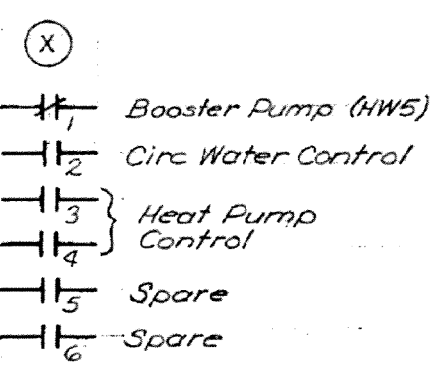

HEAT PUMP NO. 2
SCHEMATIC DIAGRAM

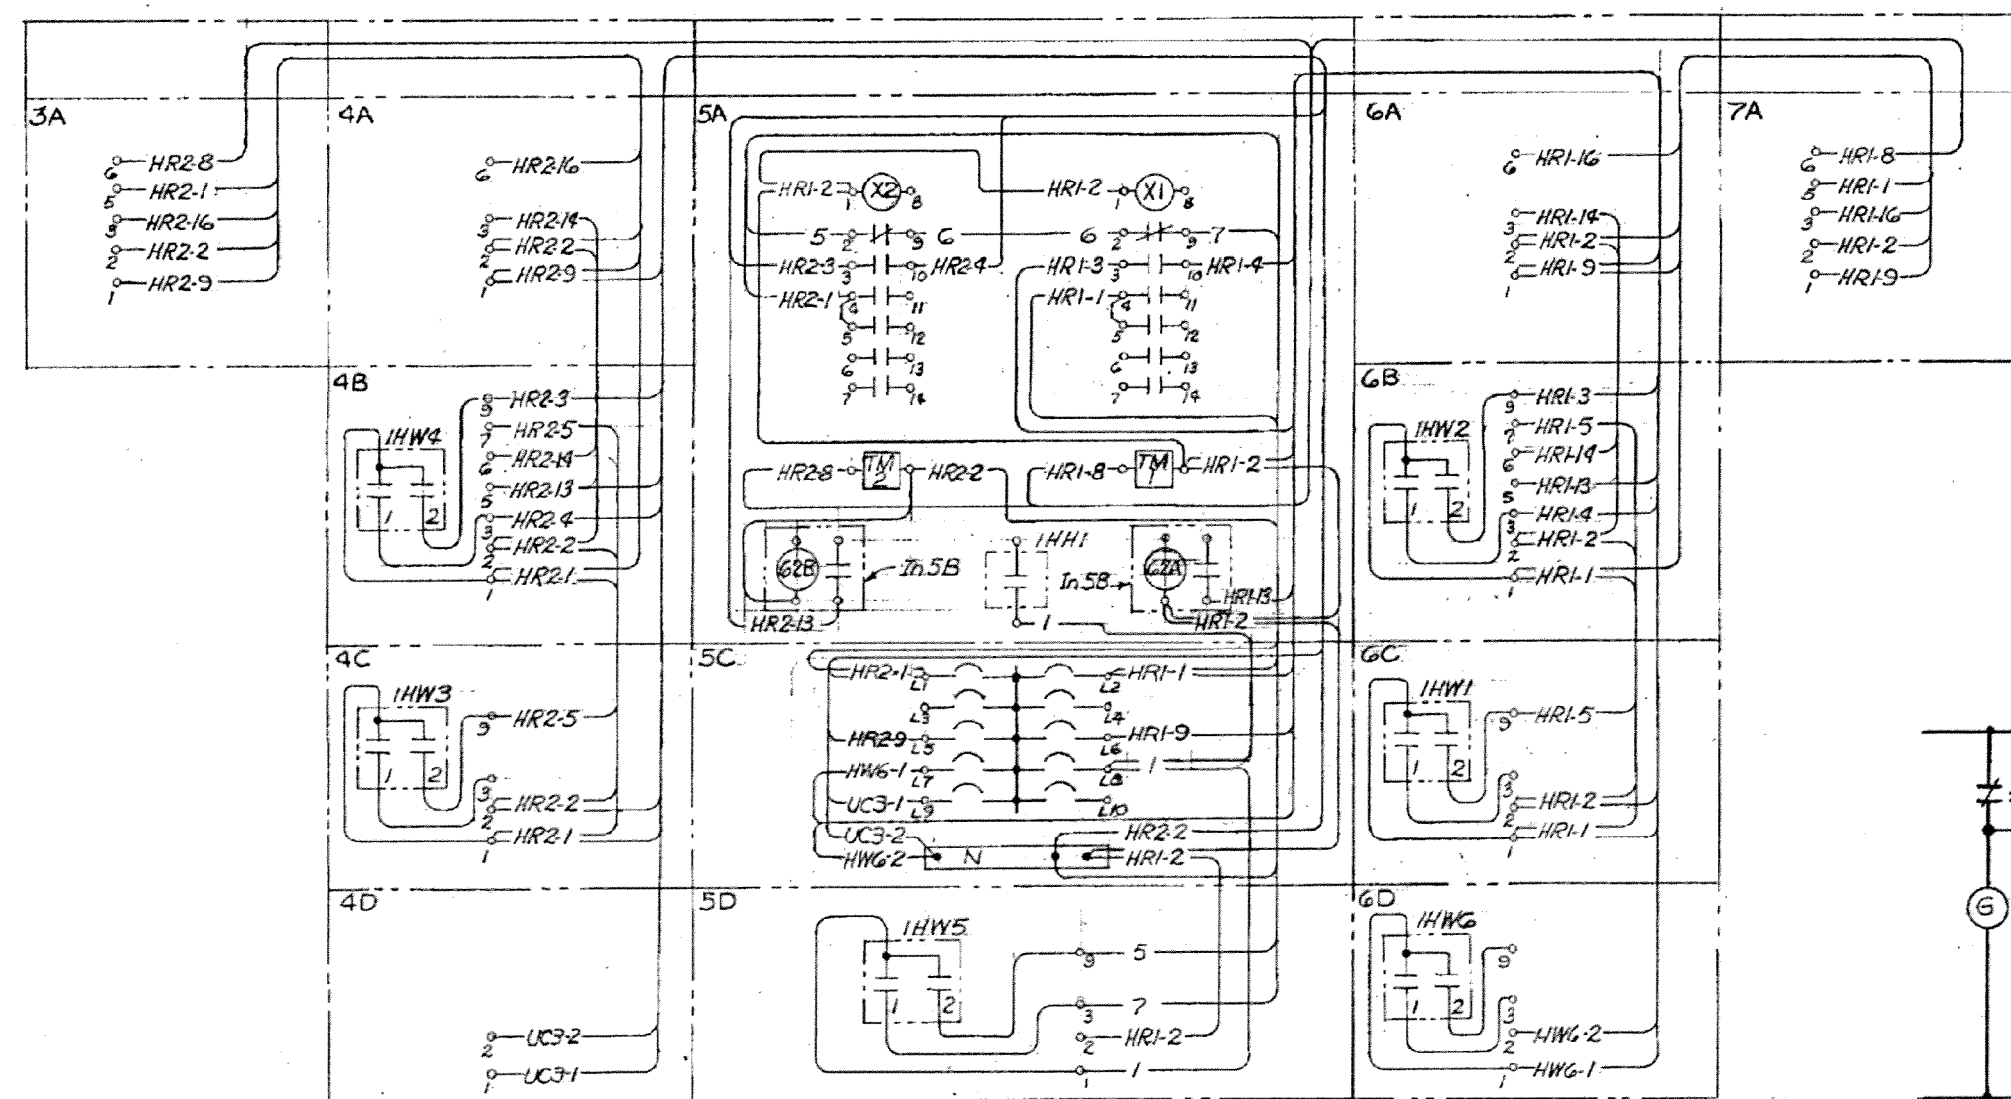


CONTROL CONNECTIONS

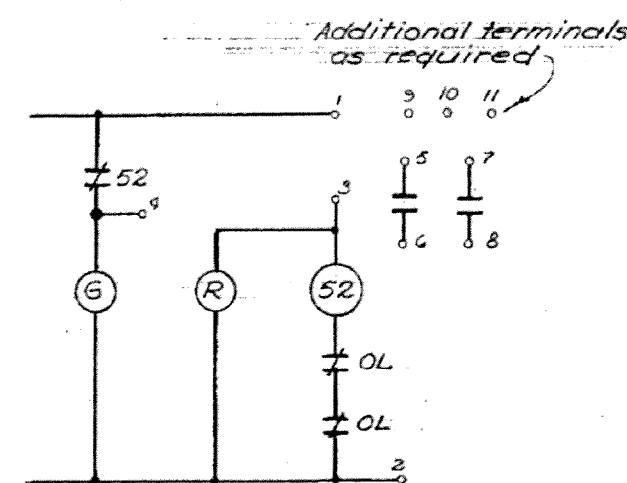

TYPICAL SCHEMATIC DIAGRAM
(See Control drawings for interconnections).

IHW6	INTER COOLING W PUMP
IHW5	BOOSTER WATER PUMP
IHW4	CIRC WATER PUMP P4
IHW3	SUPPLY WATER PUMP P3
IHW2	CIRC WATER PUMP P2
IHW1	SUPPLY WATER PUMP P1

① OFF
ON  AUTO

*Maintained
Contacts*

CONTACT	ON	OFF	AUTO
1	X		
2			X

1HH1		HT PUMP MASTER SW	
(1A)	OFF ON	<i>Maintained Contacts</i>	
CONTACT		ON	OFF
I		X	

—SUPERSEDED BY CONTRACT 05-C-0013,
SEE LPG-1-6-18/5

NOTES

1. For General Notes and Legend see drawing LCP-1.1-G-1A011.
2. Shipping dimensions shall be limited to allow passage through a 6'-0" x 10'-0" hatch.
3. Circuit breakers in the load control center shall be 3 pole except control breakers in compartment 3C shall be single pole, 20 amperes.
4. All empty compartments shall be covered with a suitable cover and available for future use.

This drawing was issued to show general design information for supply purposes and is now superseded by shop drawings listed below.

<u>CONTR. NO.</u>	<u>MANUFACTURER</u>	<u>DWG. NO.</u>
68-0080	TRANE CO.	2301/9333
↓	TRANE CO.	2301/6205
	ITE CIR. BKR. CO.	86-0D-06387-D
	ITE CIR. BKR. CO.	86-0F-06387-B

AS CONSTRUCTED


HYDRO ELECTRIC DESIGN BRANCH, NPD

DATE 1971 SEP 7 BY J. H. Hines

23

B	6-08	AS CONSTRUCTED, NEW HEAT PUMPS	
A	7-5-97	AS CONSTRUCTED, CHANGED BAY SIZE, ADDED NOTE #10	JK
REVISION	DATE	DESCRIPTION	BY
<p align="center">U. S. ARMY ENGINEER DIVISION. N. P. PORTLAND, OREGON</p>			
DESIGNED BY <i>EMS</i>		<p align="center">LITTLE GOOSE LOCK AND DAM SNAKE RIVER, OREGON, WASHINGTON & IDAHO POWERHOUSE</p>	
DRAWN BY <i>DCR</i>			
CHECKED BY <i>DAS</i>		<p align="center">AIR CONDITIONING SYSTEM 480 VOLT SUBSTATION SH</p>	
PREPARED BY <i>DAK</i> DAM LITTLE ROCK SECTION		APPROVED FOR DR. PROJECTOR <i>AK</i> CHIEF ENGINEER	
DATE 11-1-98		DATE 25-Jan-98	
SUBMITTED BY <i>L. Miller</i>		SCALE <i>AS SHOWN</i>	
CHIEF, HYDRO-ELECTRIC DESIGN BRANCH		SPEC. NO.	
INV. NO. DAG-68-60-2-0030-		<p align="center">LGP-I-1-6-1A8/5</p>	

FOR INFORMATION ONLY

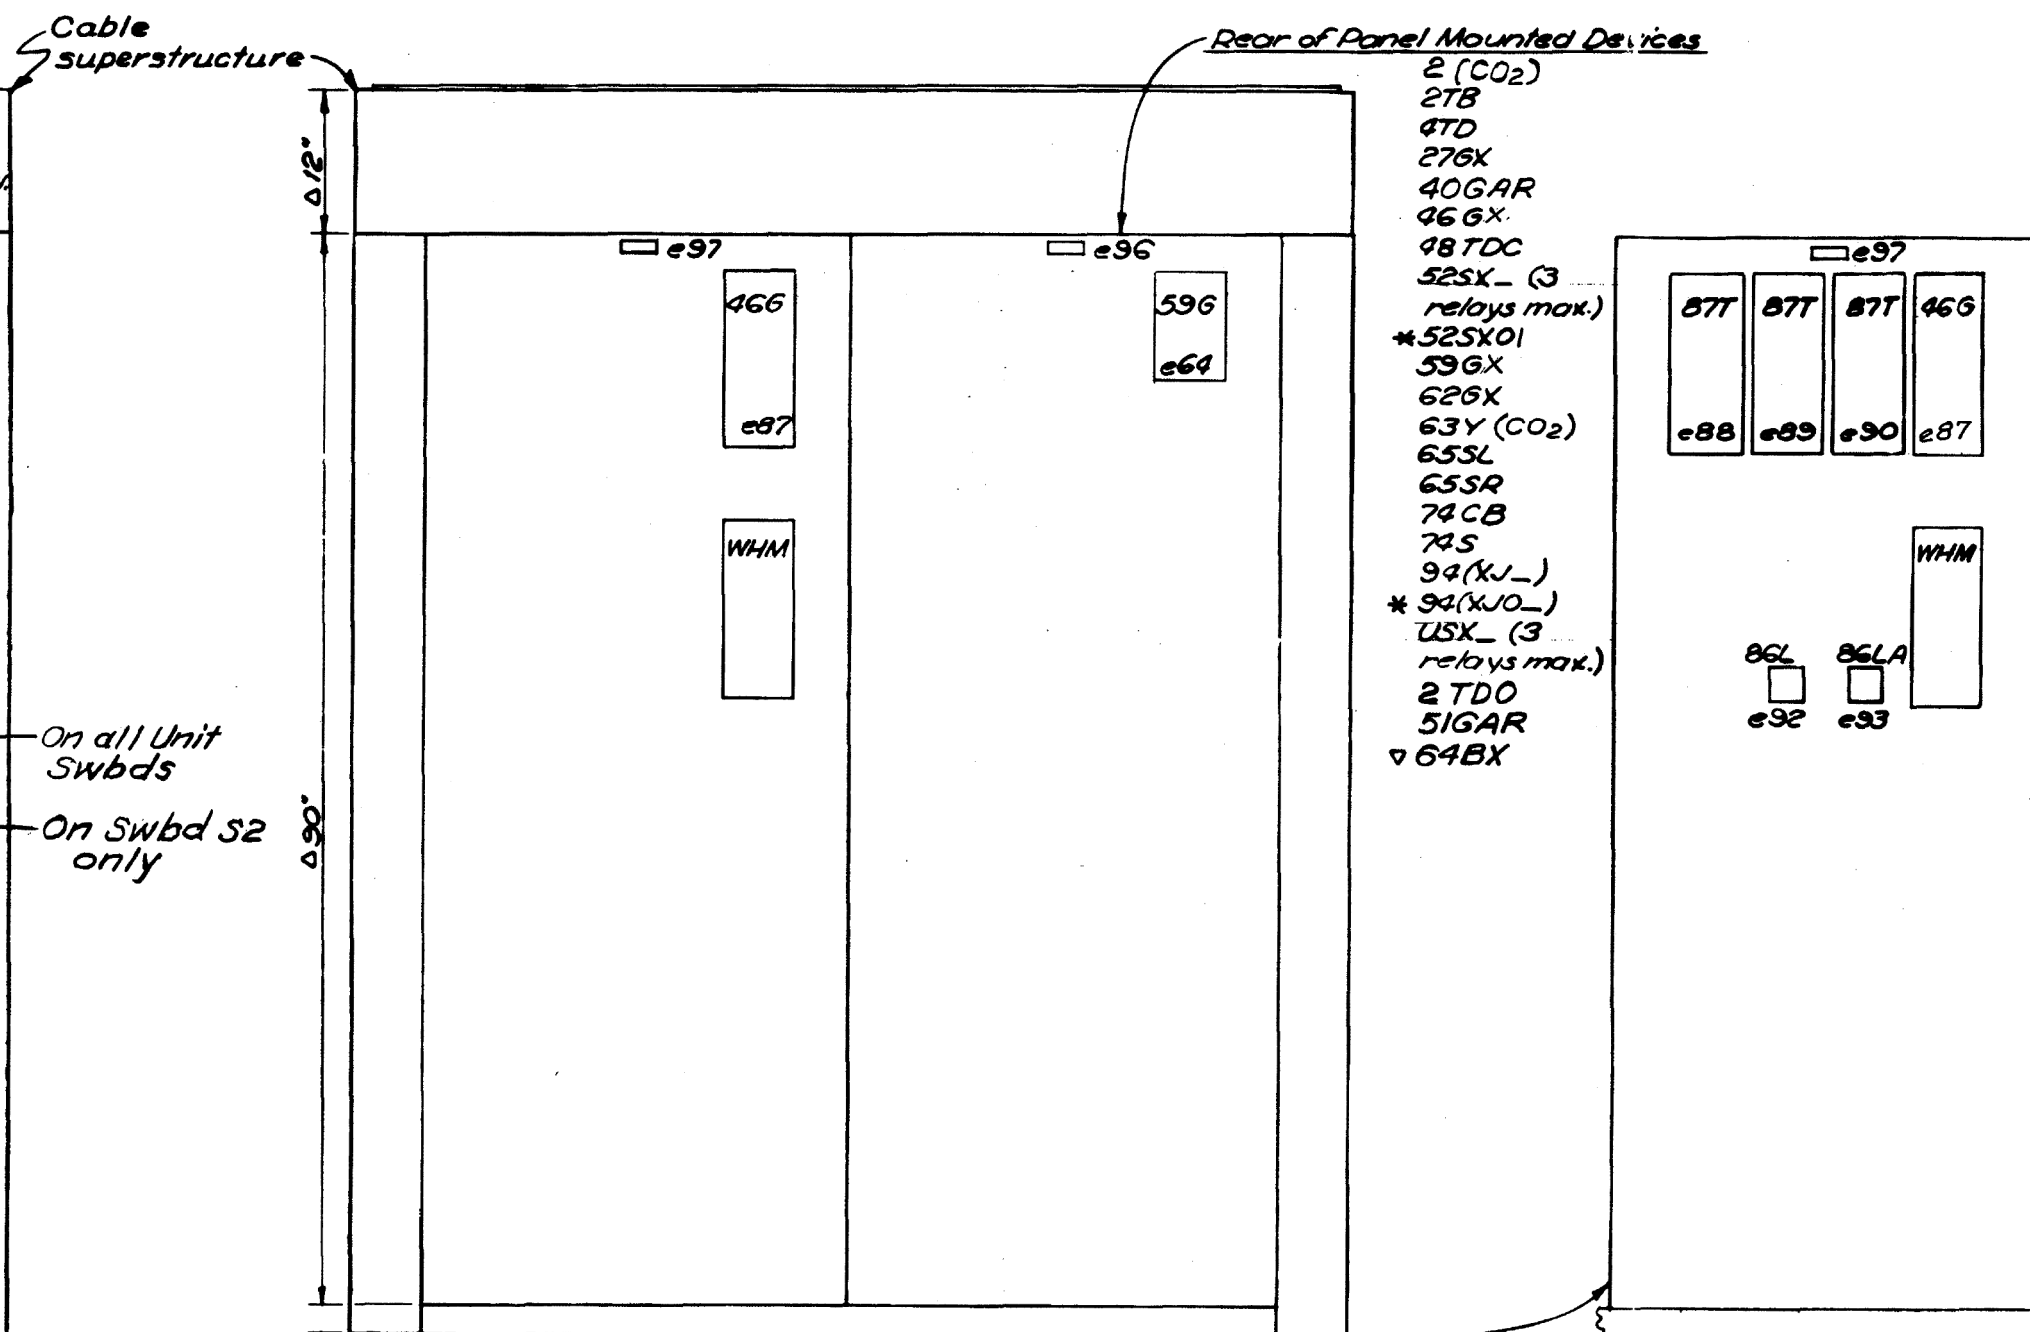

SIR2 (S3R2 SIMILAR)	SIR1 (S2R1 to S3R1 SIMILAR)	<u>Rear of Panel/Mounted Devices</u> 647AR 877AR 747L	S2R2
▽ On panels SIR1 and S3R1 only.			

NOMENCLATURE

CONTROL AND EXCITATION PANEL

A	Ammeter	V	Voltmeter
ABF	Ammeter, Exc Field	VAR	Vorometer
AGF	Ammeter, Gen Field	VGF	Voltmeter, Gen Field
F	Frequency Meter	VRS	Voltmeter, Regulator
Ⓢ	Synchronizing Lamp	W	Wattmeter or White Light
S	Synroscope	WHM	Watthourmeter
	Indicating Lamp, W-White,	WT	Watt Transducer
B	G-Green, R-Red, A-Amber	VAR T	Var Transducer
1.	Ammeter Switch	RTD-10,8 or 6	RTD Bridge Chassis/number of indicators
2.	Voltmeter Switch		of bridges
3.	Auto-Start/Stop Switch		
4.	Emergency Stop Switch (5)		
5.	Synchronizing Switch		
6.	Circuit Breaker Control Switch		
7.	Local - Central - Central Test Transfer Switch (43)		
8.	Annunciator Reset Switch		
9.	Annunciator Silence Switch		
10.	Generator Symbol Light		
11.	Field Breaker Control Switch		
12.	Voltage Adjust Rheostat Control Switch		
13.	Voltage Regulator Transfer Switch		
14.	Exciter Field Rheostat Control Switch		
15.	COP System Indicating Light		
16.	Annunciator or Horn Source Indicating Lamp		
17.			
18.	Clearance Switch		

RELAY PANELS (REAR PANELS)

AR	Alarm Relay	TD	Time Delay Relay
G	Generator, Green	URX	Unit Run Relay
L	Lower, Line	UX	Unit Selector Relay
		W	White
R	Raise, Red	XYZ	Auxiliary Relay
T	Transformer, Trip, Transducer	TDC	Time Delay Close
XJ_	Generator Breaker	XJO_	Sta. Serv. Trans. Breaker
B	Bus		
2	Time Delay Relay		
3	Unit Start Interlock Relay		
4	Master Relay		
27	Voltage Relay		
40	Loss of Excitation Relay		
46	Negative Phase Sequence Relay		
48	Incomplete Sequence Relay		
51	Overcurrent Relay		
52	A-C Circuit Breaker or Contactor		
52SX	Circuit Breaker Selector Relay		
59	A-C Overvoltage Relay		
62	Time Delay Stopping Relay		
63	Liquid or Gas Pressure Relay		
64	Overcurrent Ground Relay		
65	Governor		
SL	Speed Adjust, Lower Relay		
SR	Speed Adjust, Raise Relay		
74	Alarm Relay, S-Centralized Start, CB & TL Unit Control Bus and Trans & Line Control Bus Undervoltage Relay		
86	Lockout Relay, GT-Gen Time Shutdown		
87	Differential Relay		
94	Tripping Relay		

6. All dimensions marked Δ shall not be changed. These dimensions are required for proper lineup with adjacent governor cabinet.


7. Dashed lines indicate rear of panel mounted equipment.

NOTES

1. For detailed requirements of nameplates refer to nameplate engraving schedule drawing.
2. Ground lug for 2/p stranded copper cable to be supplied with switchboard behind Panel S11. Lugs to be Burndy type NA or approved equal.
3. Telephone to be furnished and installed by Government.
4. Annular engraving as shown on LGR-1-6-9A31/1.
5. Conduit 5' long to be furnished by Government to manufacturer's standard practice will be permitted provided that the specific requirements on the drawings and in the specifications are complied with.

REFERENCE DRAWINGS


LGP-11-6-9A23/1	CONTROL SOURCES ONE LINE DIAGRAM
LGP-11-6-9A28/1	AUTOMATIC SYNCHRONIZING SCHEMATIC DIAG.
LGP-11-6-9E24/1	MAIN UNIT CONTROL SCHEMATIC DIAG SH.1
LGP-11-6-9E24/2	MAIN UNIT CONTROL SCHEMATIC DIAG SH.2
LGP-11-6-9E24/3	VOLTAGE REGULATOR SCHEMATIC DIAGRAM
LGP-11-6-9A31/1	MAIN UNIT ANNUNCIATOR SCHEMATIC DIAG

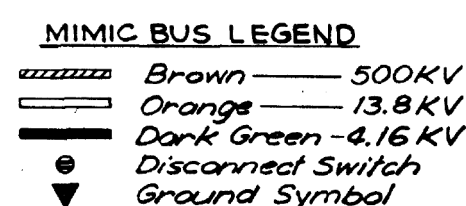

LEFT HAND END VIEW
Δ See Note 6

RIGHT HAND END VIEW
Δ See Note 6

SECTION B-B
(SWBD DEVICES NOT SHOWN)
A See Note 6

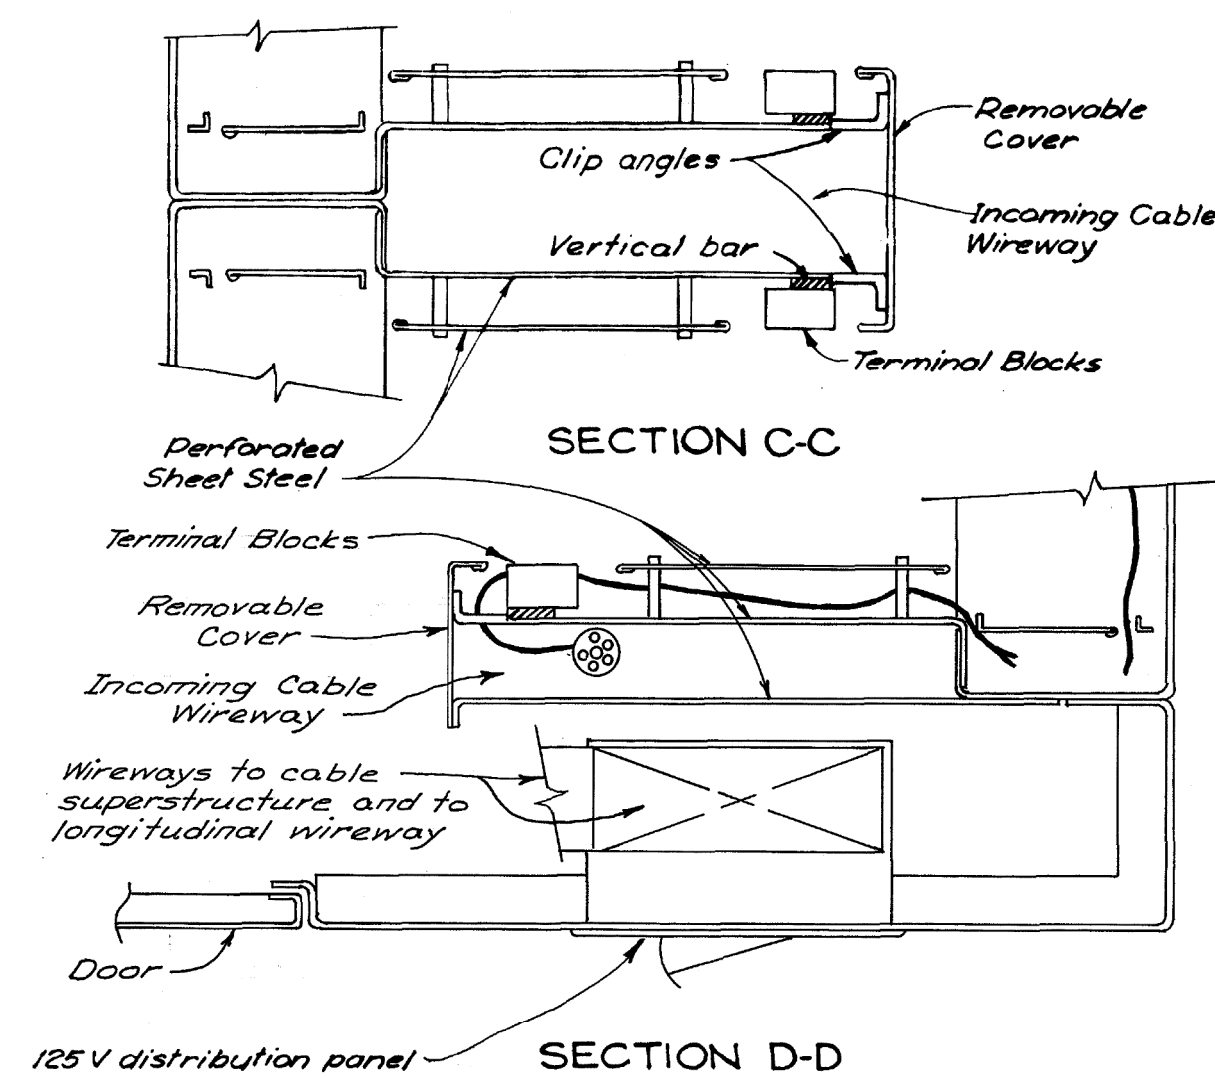

NO SCALE

This drawing was issued as drawing LGP-1-G-9E4/1 for procurement of Government furnished equipment. It will be superseded by manufacturer's drawing 6586-1CD as soon as "Approved for Construction" tracings are available.

A	71SEP7	Suspended, see above	
REVISION	DATE	DESCRIPTION	
<p align="center">U. S. ARMY ENGINEER DIVISION. N. P. PORTLAND, OREGON</p>			
<p align="center">LITTLE GOOSE LOCK AND DAM SHAKE RIVER, OREGON, WASHINGTON & IDAHO POWERHOUSE</p>			
<p align="center">GENERATOR SWITCHBOARDS SI-S3</p>			
DESIGNED BY <i>WWM</i>		DATE <i>25 Jan 68</i>	
DRAWN BY <i>REB</i>		SCALE AS SHOWN	
CHECKED BY <i>J.C.</i>		SPEC. NO.	
PREPARED BY <i>[Signature]</i>		LGP-11-6-9E4/1	
WORK ELECTRICAL SECTION		SMRY	
SUBMITTED: <i>L.T. Fisher</i>		APPROVED: FOR BY <i>ENGINEER</i>	
GATE, WEIR & BARGE DAM SECTION		DATE <i>25 Jan 68</i>	
<i>10-C-80</i>		<i>[Signature]</i>	




- 1 Undervoltage Relay
- 2 Charger Ammeter
- 3 Voltmeter
- 4 Battery Ammeter
- 5 Motor Control Switch
- 6 Voltmeter Switch-2 position
- 7 Generator Field Rheostat
- 8 Generator Breaker
- 9 48 Volt D-C Distribution Panel

1. Devices of Switchboard No.5 & 6 shall be aligned with existing switchboard devices. Device location dimension will be furnished to the successful bidder.
2. All devices located in CQ05 are furnished by others.
3. All 48 Volt D-C breakers in S06 distribution panel shall be single-pole with 5000 Ampere minimum interrupting rating at 125 Volt D-C.

⊗ Thermal only

SIZE OF LETTER { No. 4 Letter Size $\frac{3}{16}" \times 0.034"$ Line Width
No. 6 Letter Size $\frac{1}{8}" \times 0.017"$ Line Width

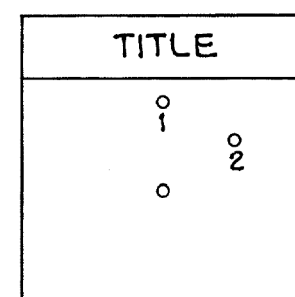


This drawing was issued as drawing L6P-1-6-0D4/2 for procurement of Government furnished equipment. It will be superseded by manufacturer's drawings 65101-IABC & 65101-EAC as soon as "Approved for Construction" tracings are available.

118 120 52 Incl
as req'd


VOL. NO. II

R-045

FINAL

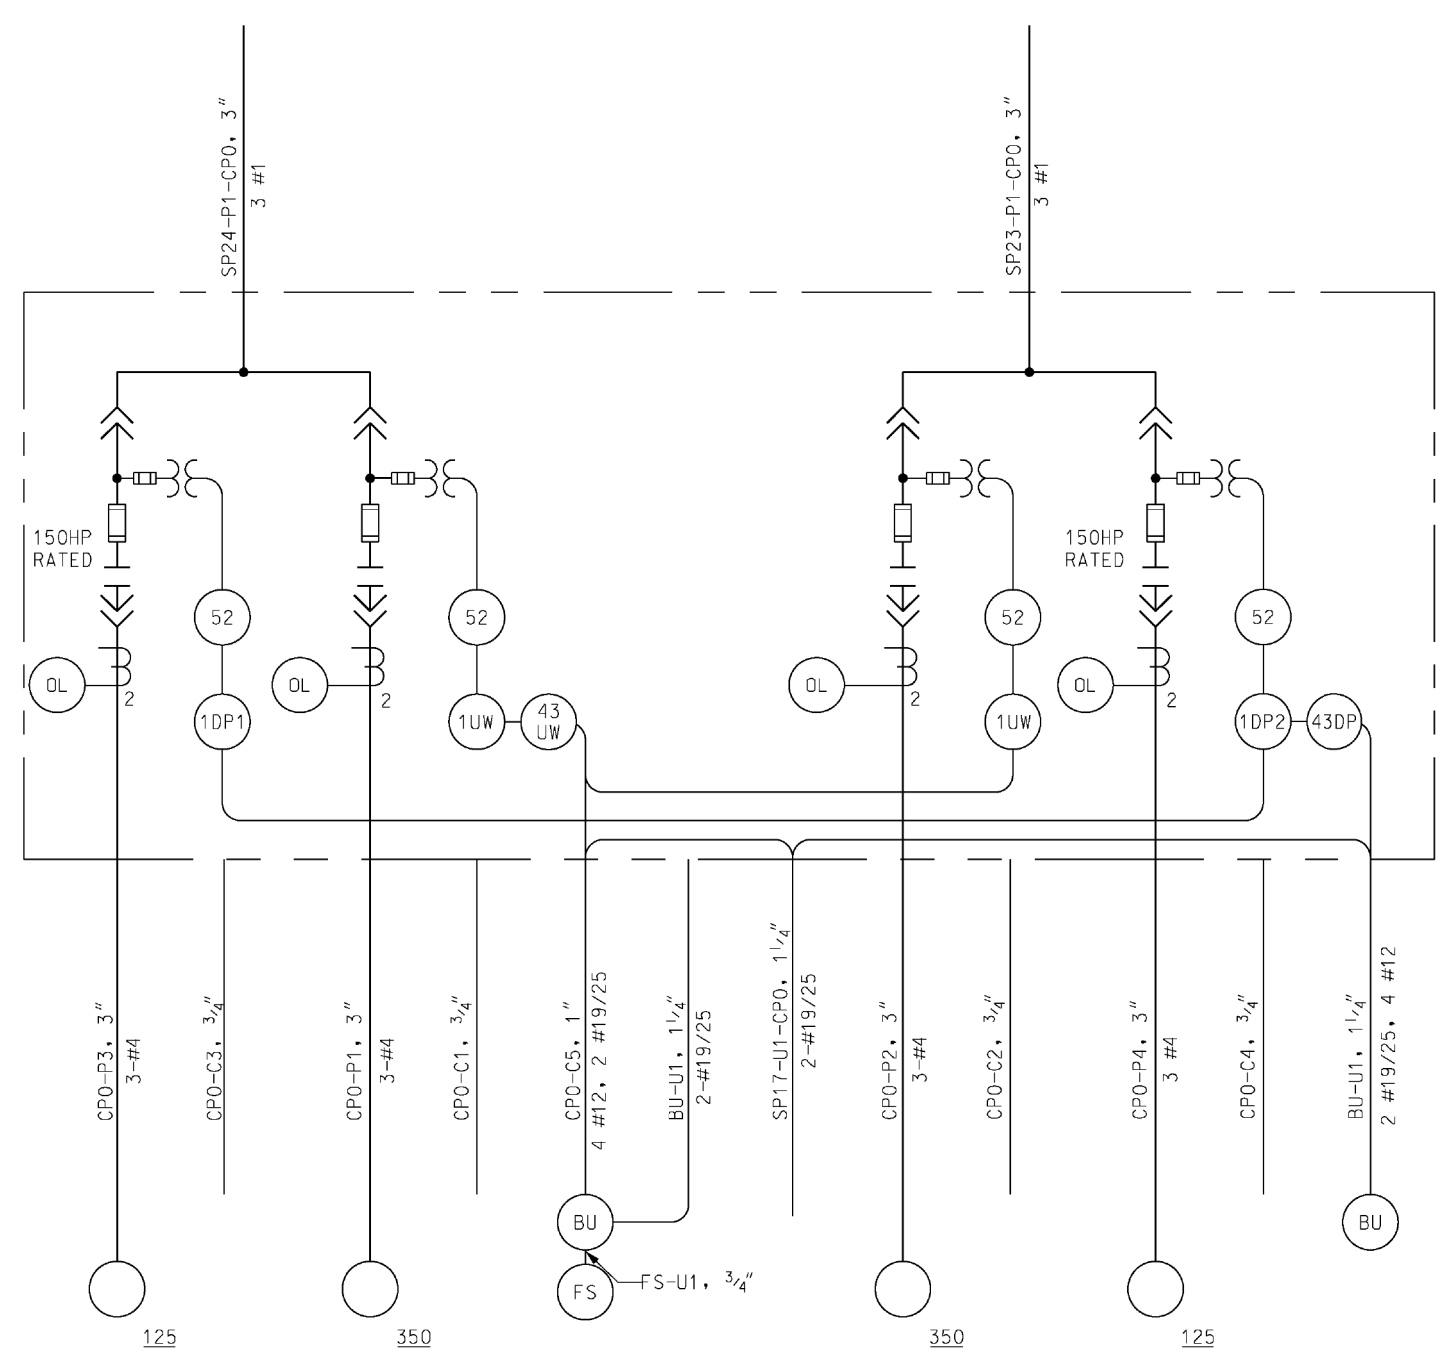

1. FOR GENERAL NOTES AND LEGEND SEE DWG LGP-1.1-6-1A0/1.




US Army Corps
of Engineers®

[illegible]

U.S. ARMY CORPS OF ENGINEERS WALLA WALLA DISTRICT 201 NORTH 3RD AVENUE SEATTLE, WASHINGTON	DESIGNED BY:	ISSUE DATE: AUGUST 2022
	DRAWN BY:	SOLICITATION NO.:
	CHECKED BY:	CONTRACT NO.:
	SUBMITTED BY:	DRAWING NUMBER:
	SIZE:	FILENAME: ANSI.D R-048.dgn

LITTLE GOOSE LOCK AND DAM
POWERHOUSE
DC SYSTEM AND LOW VOLTAGE SWITCHGEAR
POWERHOUSE
ONE LINE DIAGRAM
SQO, SQ1 & CPO

R-046

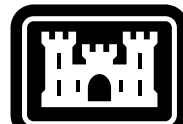US Army Corps
of Engineers®

DATE

MARK DESCRIPTION

DESIGNED BY:

DRAWN BY:

CHECKED BY:

SUBMITTED BY:

SIZE:

ANSI:

FILENAME:

R-047.dwg

U.S. ARMY CORPS OF ENGINEERS

WALLA WALLA DISTRICT

201 NORTH 3RD AVENUE

SEATTLE, WASHINGTON

LITTLE GOOSE LOCK AND DAM

POWERHOUSE

DC SYSTEM AND LOW VOLTAGE SWITCHGEAR

POWERHOUSE


ONE LINE DIAGRAM

CQ01, CQ02, FCQ1 & FCQ2



SHEET ID

R-047

FINAL

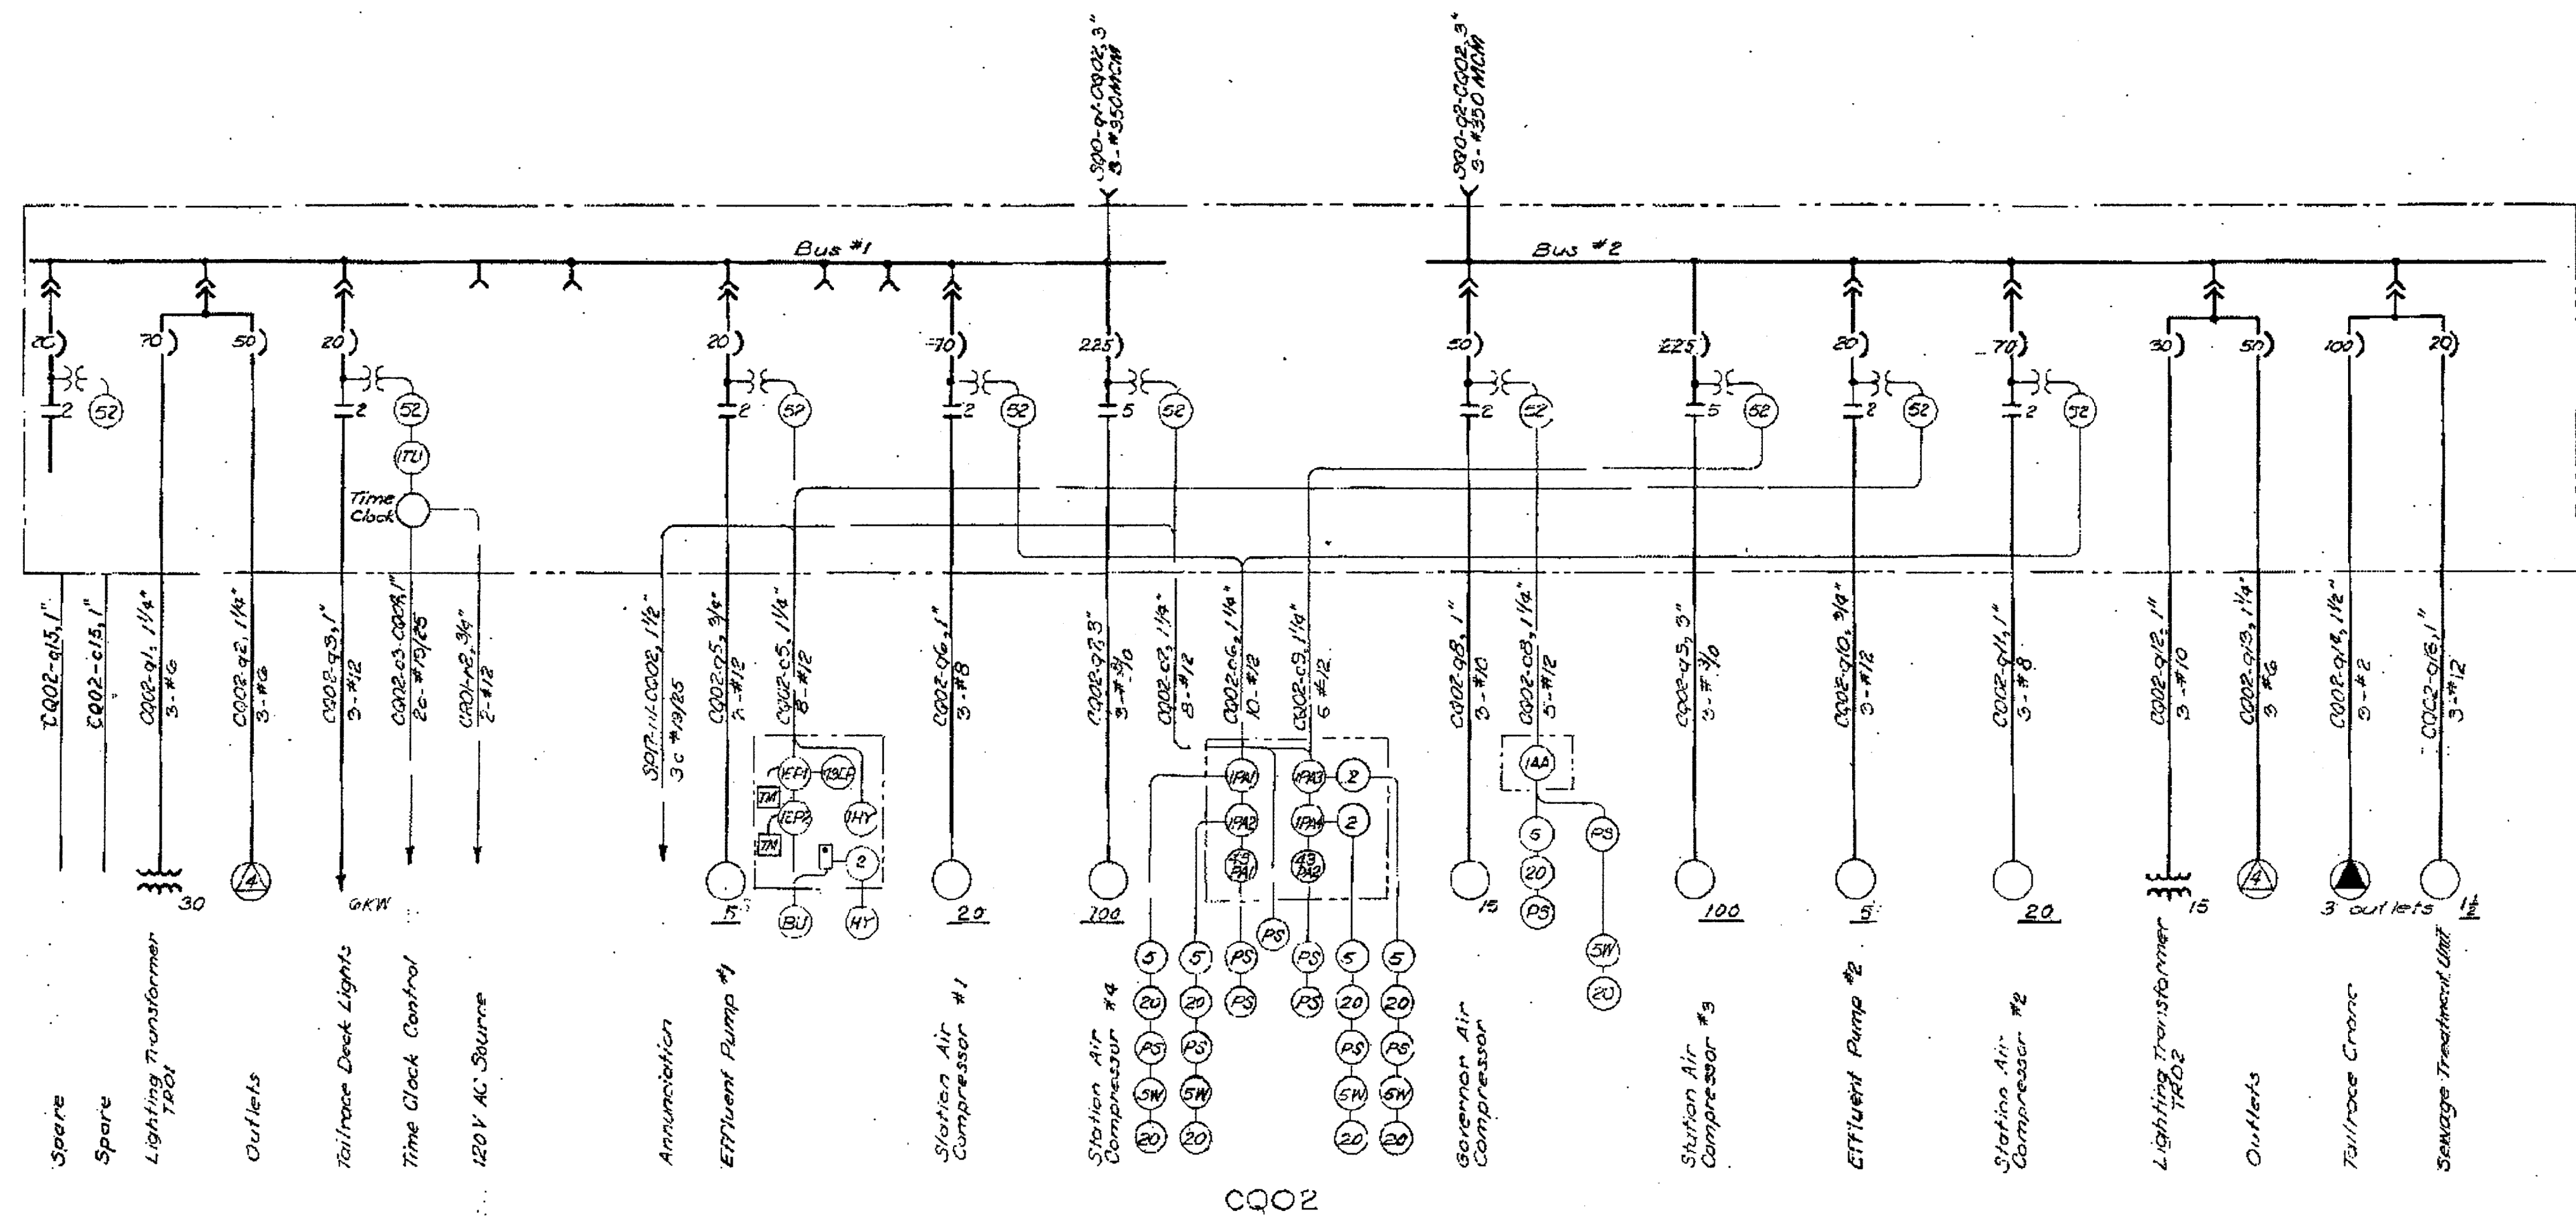

NOTE

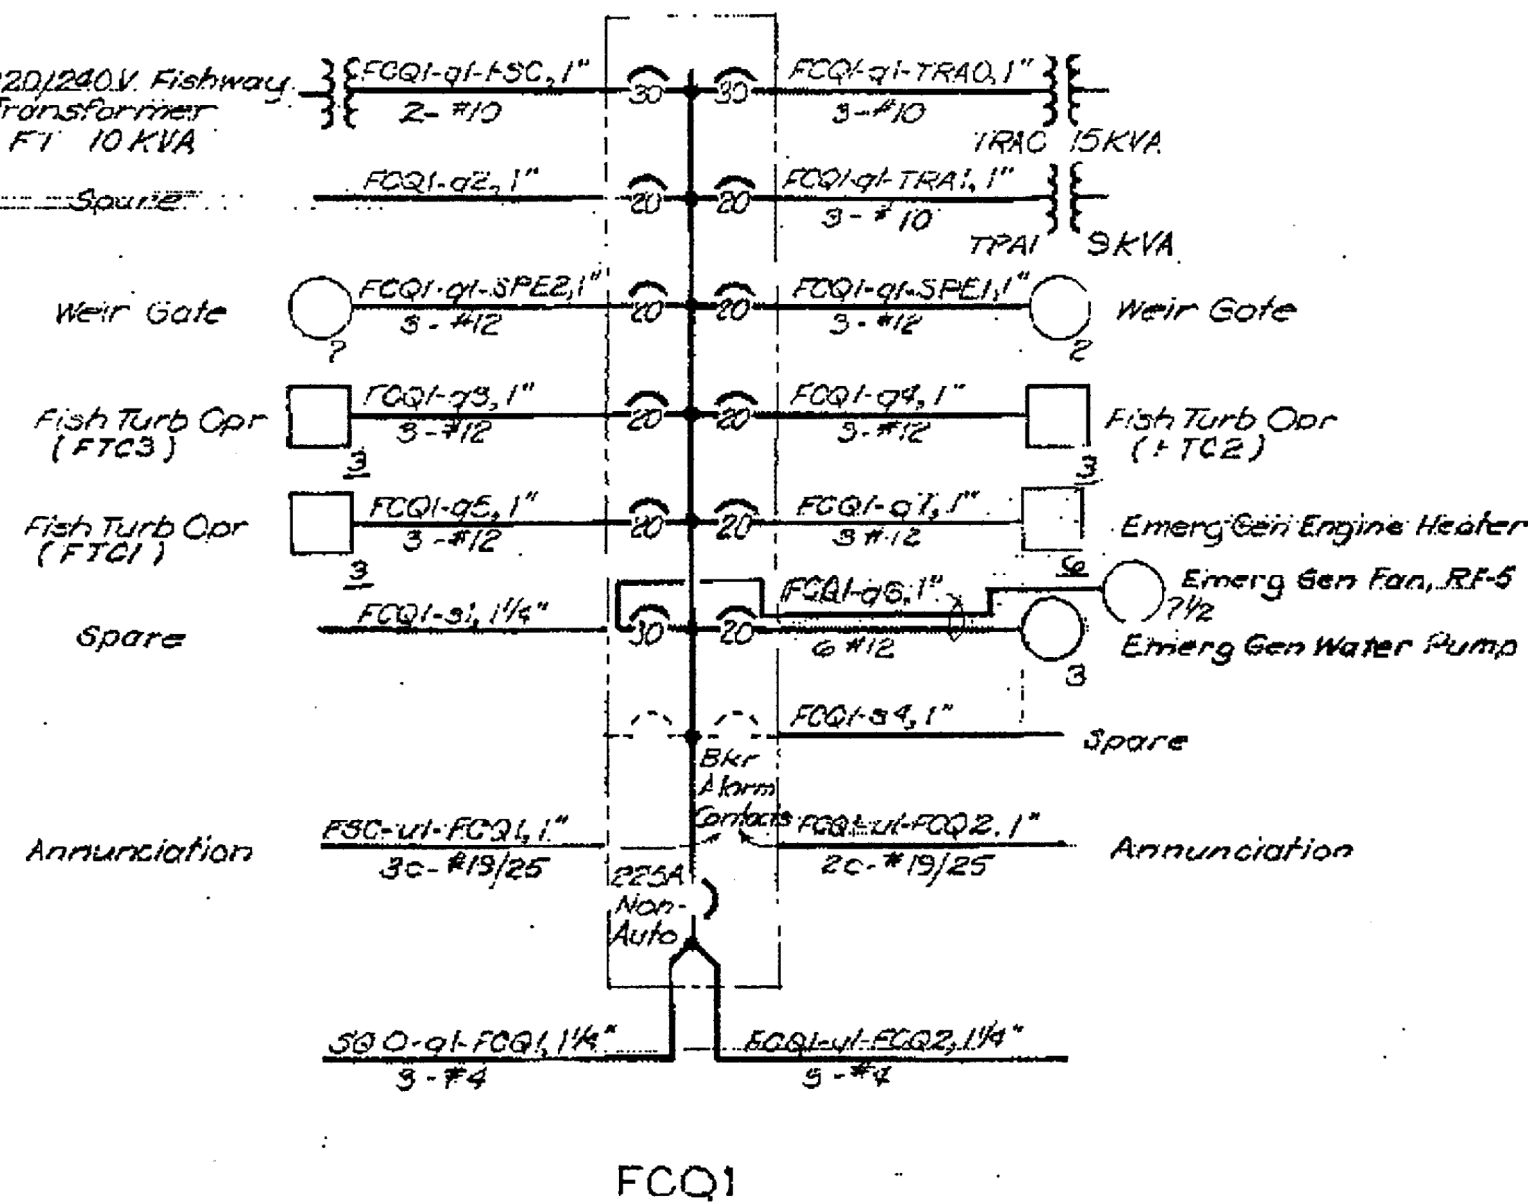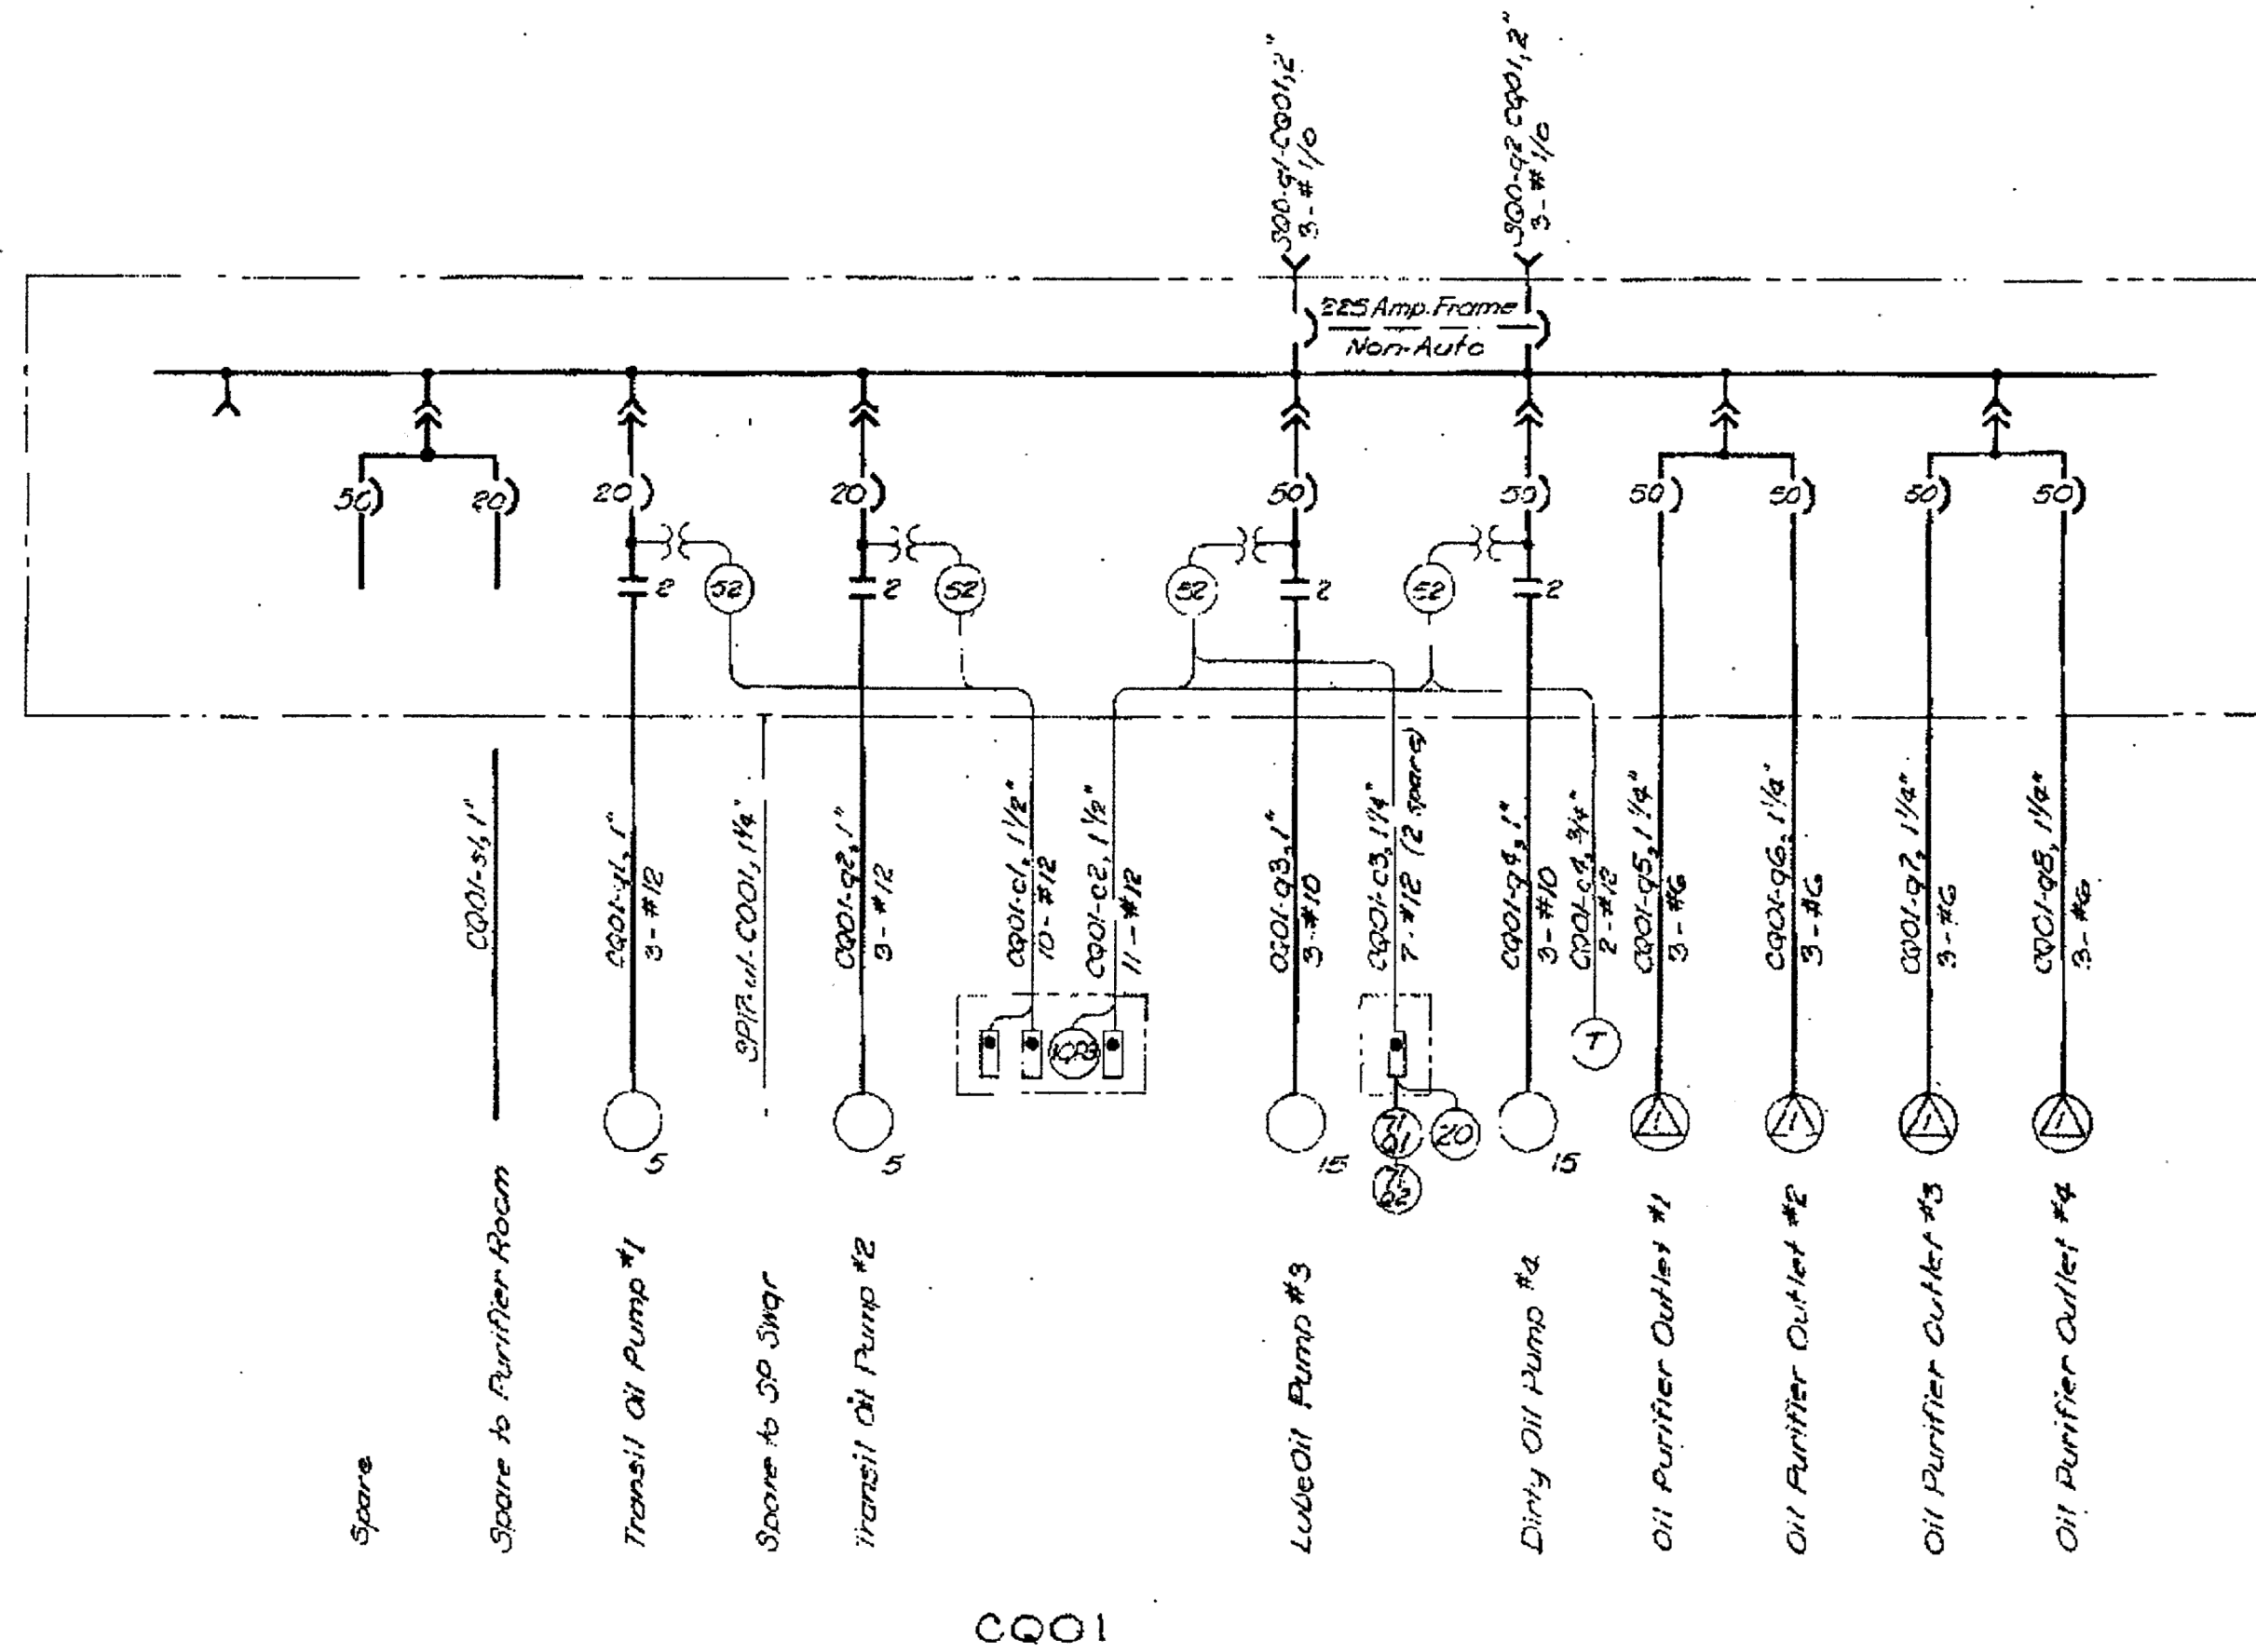1. For General Notes and Legend see drawing
LGP-1-16-1A0/1.

AS CONSTRUCTED

HYDRO-ELECTRIC DESIGN BRANCH, NPB

DATE: 1ST SEP 71 BY: J. R. 2/2/71

REVISION	DATE	DESCRIPTION	BY
C	7/5/61	Added Emerg Gen Aux to FCQ1	JRK
B	7/5/61	As Constructed, added Sta Air Comp Nos 1 & 2, Pump size	JRK
A	8/2/59	General revisions	JRK

U. S. ARMY ENGINEER DIVISION, N. P.
PORTLAND, OREGON

DESIGNED BY: EMS

DRAWN BY: DFR

CHECKED BY: DFR

PREPARED BY: DFR

DATE: 25 Jan 68

SUBMITTED BY: DFR

DATE: 25 Jan 68

SCALE: AS SHOWN


SPEC. NO.


INV. NO. DACW 98-68-B-0028

SHEET: 1


VOL. NO. II

LGP-1-16-1D21/2

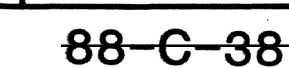

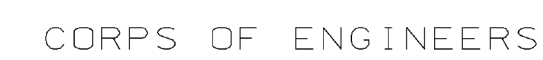

U.S. ARMY

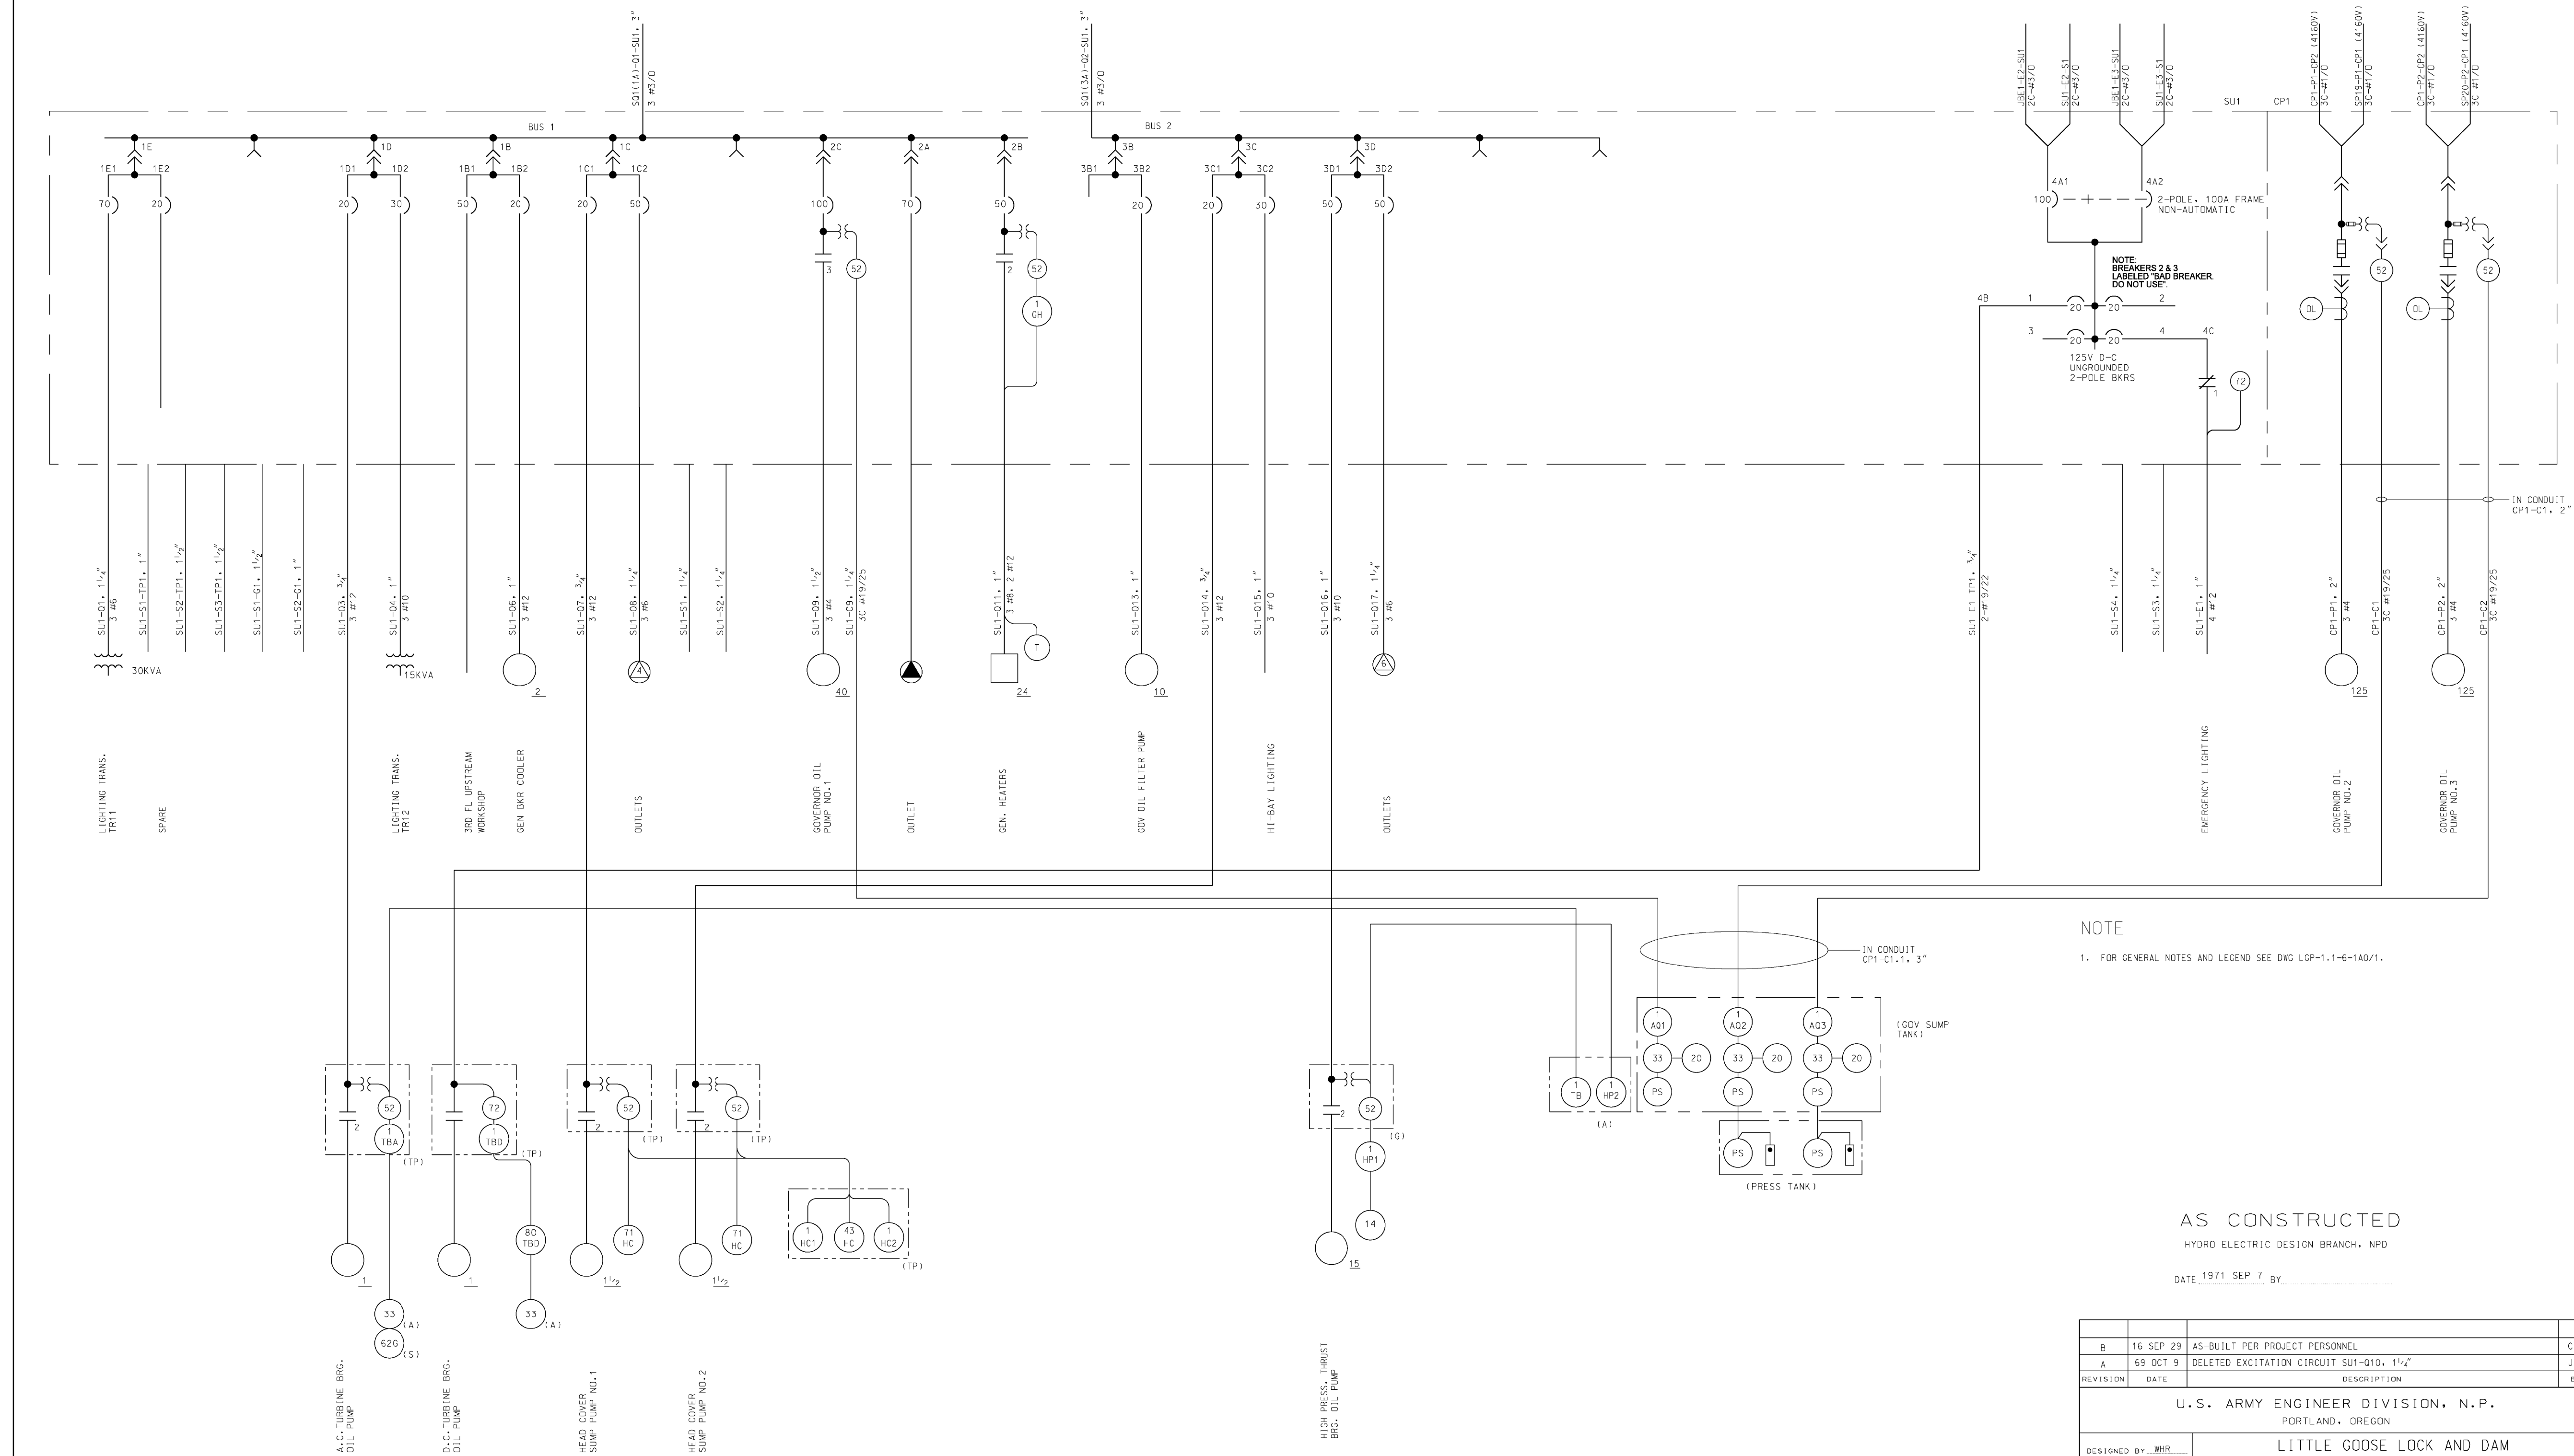

NOTE

1. FOR GENERAL NOTES AND LEGEND SEE DWG LGP-1.1-6-1A0/1.

AS CONSTRUCTED

HYDRO ELECTRIC DESIGN BRANCH, NPD


DATE 1971 SEP 7 BY

B		16 SEP 29	AS-BUILT PER PROJECT PERSONNEL	CTM
A		69 OCT 9	DELETED EXCITATION CIRCUIT SU1-010, 1 1/2"	JRK
REVISION	DATE	DESCRIPTION		BY
<p align="center">U.S. ARMY ENGINEER DIVISION, N.P. PORTLAND, OREGON</p> <p align="center">LITTLE GOOSE LOCK AND DAM SNAKE RIVER, OREGON, WASHINGTON & IDAHO POWERHOUSE</p> <p align="center">ONE LINE DIAGRAM SU1 & CP1</p>				
DESIGNED BY.....MHR		<p>APPROVED FOR DIV. ENGINEER DATE 25 JAN 68</p> <p>CHEF, ENGINEERING DIVISION</p> <p>SCALE AS SHOWN SPEC. NO.</p> <p align="right">LGP-1.1-6-1E21/1</p>		
DRAWN BY.....DFA				
CHECKED BY.....DBS				
PREPARED:				
<p>***** HEAD - ELECTRICAL SECTION</p>		<p>SHEET 18</p>		
<p>SUBMITTED:</p> <p>DATE: *****ELECTRIC DESIGN BRANCH</p> <p>INV. NO. DACW68-68-B-0029</p>				

1:50:20 PM DATE AND TIME PLOTTED:9/29/2016

DESIGN FILE:N:\@TECH SECTION\0_EQUIPMENT\HIERARCHY\4 LITTLE GOOSE\POWERHOUSE\5 STATION POWER\SQ 480V SYSTEM\1 480V SUBSTATION SQ1\ZDRAWINGS\LGP-1_1-6-1E21_1.DGN

SCALE\$SCALE\$ USERNAME \$USER\$

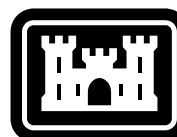[illegible]

U.S. ARMY CORPS OF ENGINEERS WALLA WALLA DISTRICT 201 NORTH 3RD AVENUE SEATTLE, WASHINGTON	DESIGNED BY:	ISSUE DATE: AUGUST 2022
	DRAWN BY:	SOLICITATION NO.: W912EE22R0001
	CHECKED BY:	CONTRACT NO.:
	SUBMITTED BY:	DRAWING NUMBER:
	SIZE:	FILENAME: R049.dgn

LITTLE GOOSE LOCK AND DAM
POWERHOUSE
POC SYSTEM AND LOW VOLTAGE SWITCHGEAR
POWERHOUSE
ONE LINE DIAGRAM
SU1 & CP1

SHEET ID

R-049

FINAL

