


GROUND RECEPTACLE DETAIL

SCALE: NONE


1
E-5 E-5

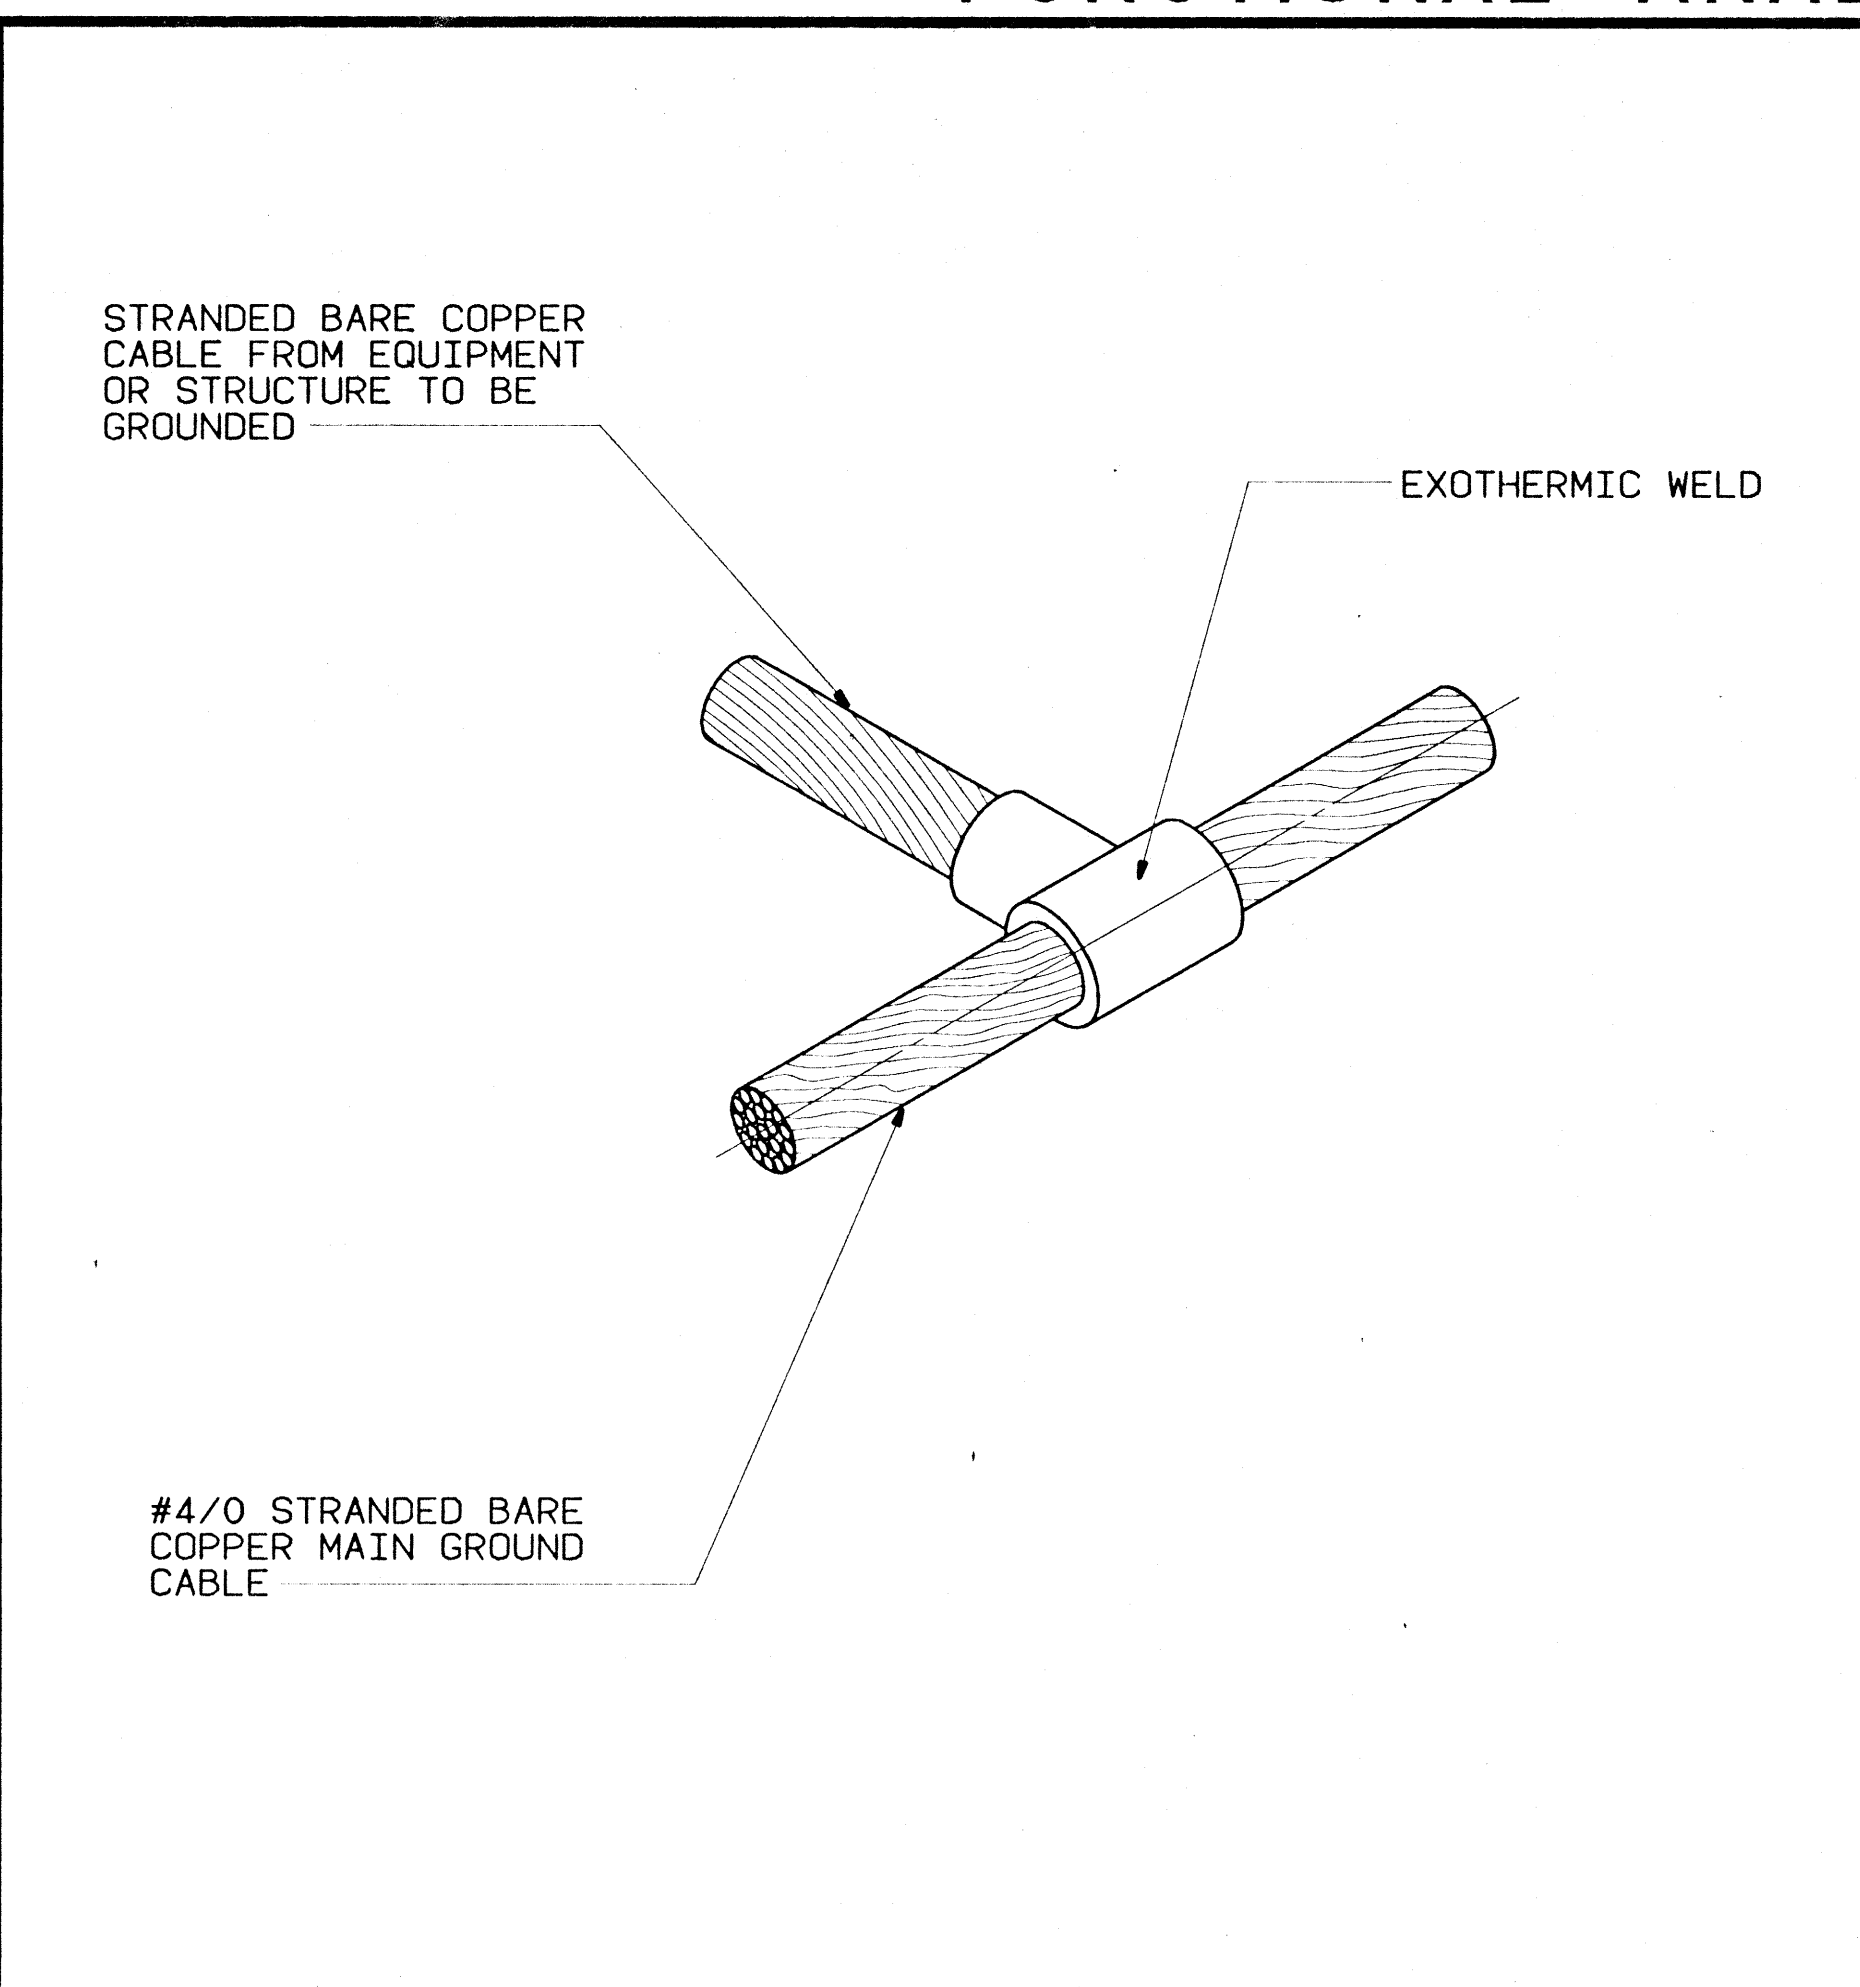

GROUND CONNECTION DETAIL

SCALE: NONE


2
E-17 E-5

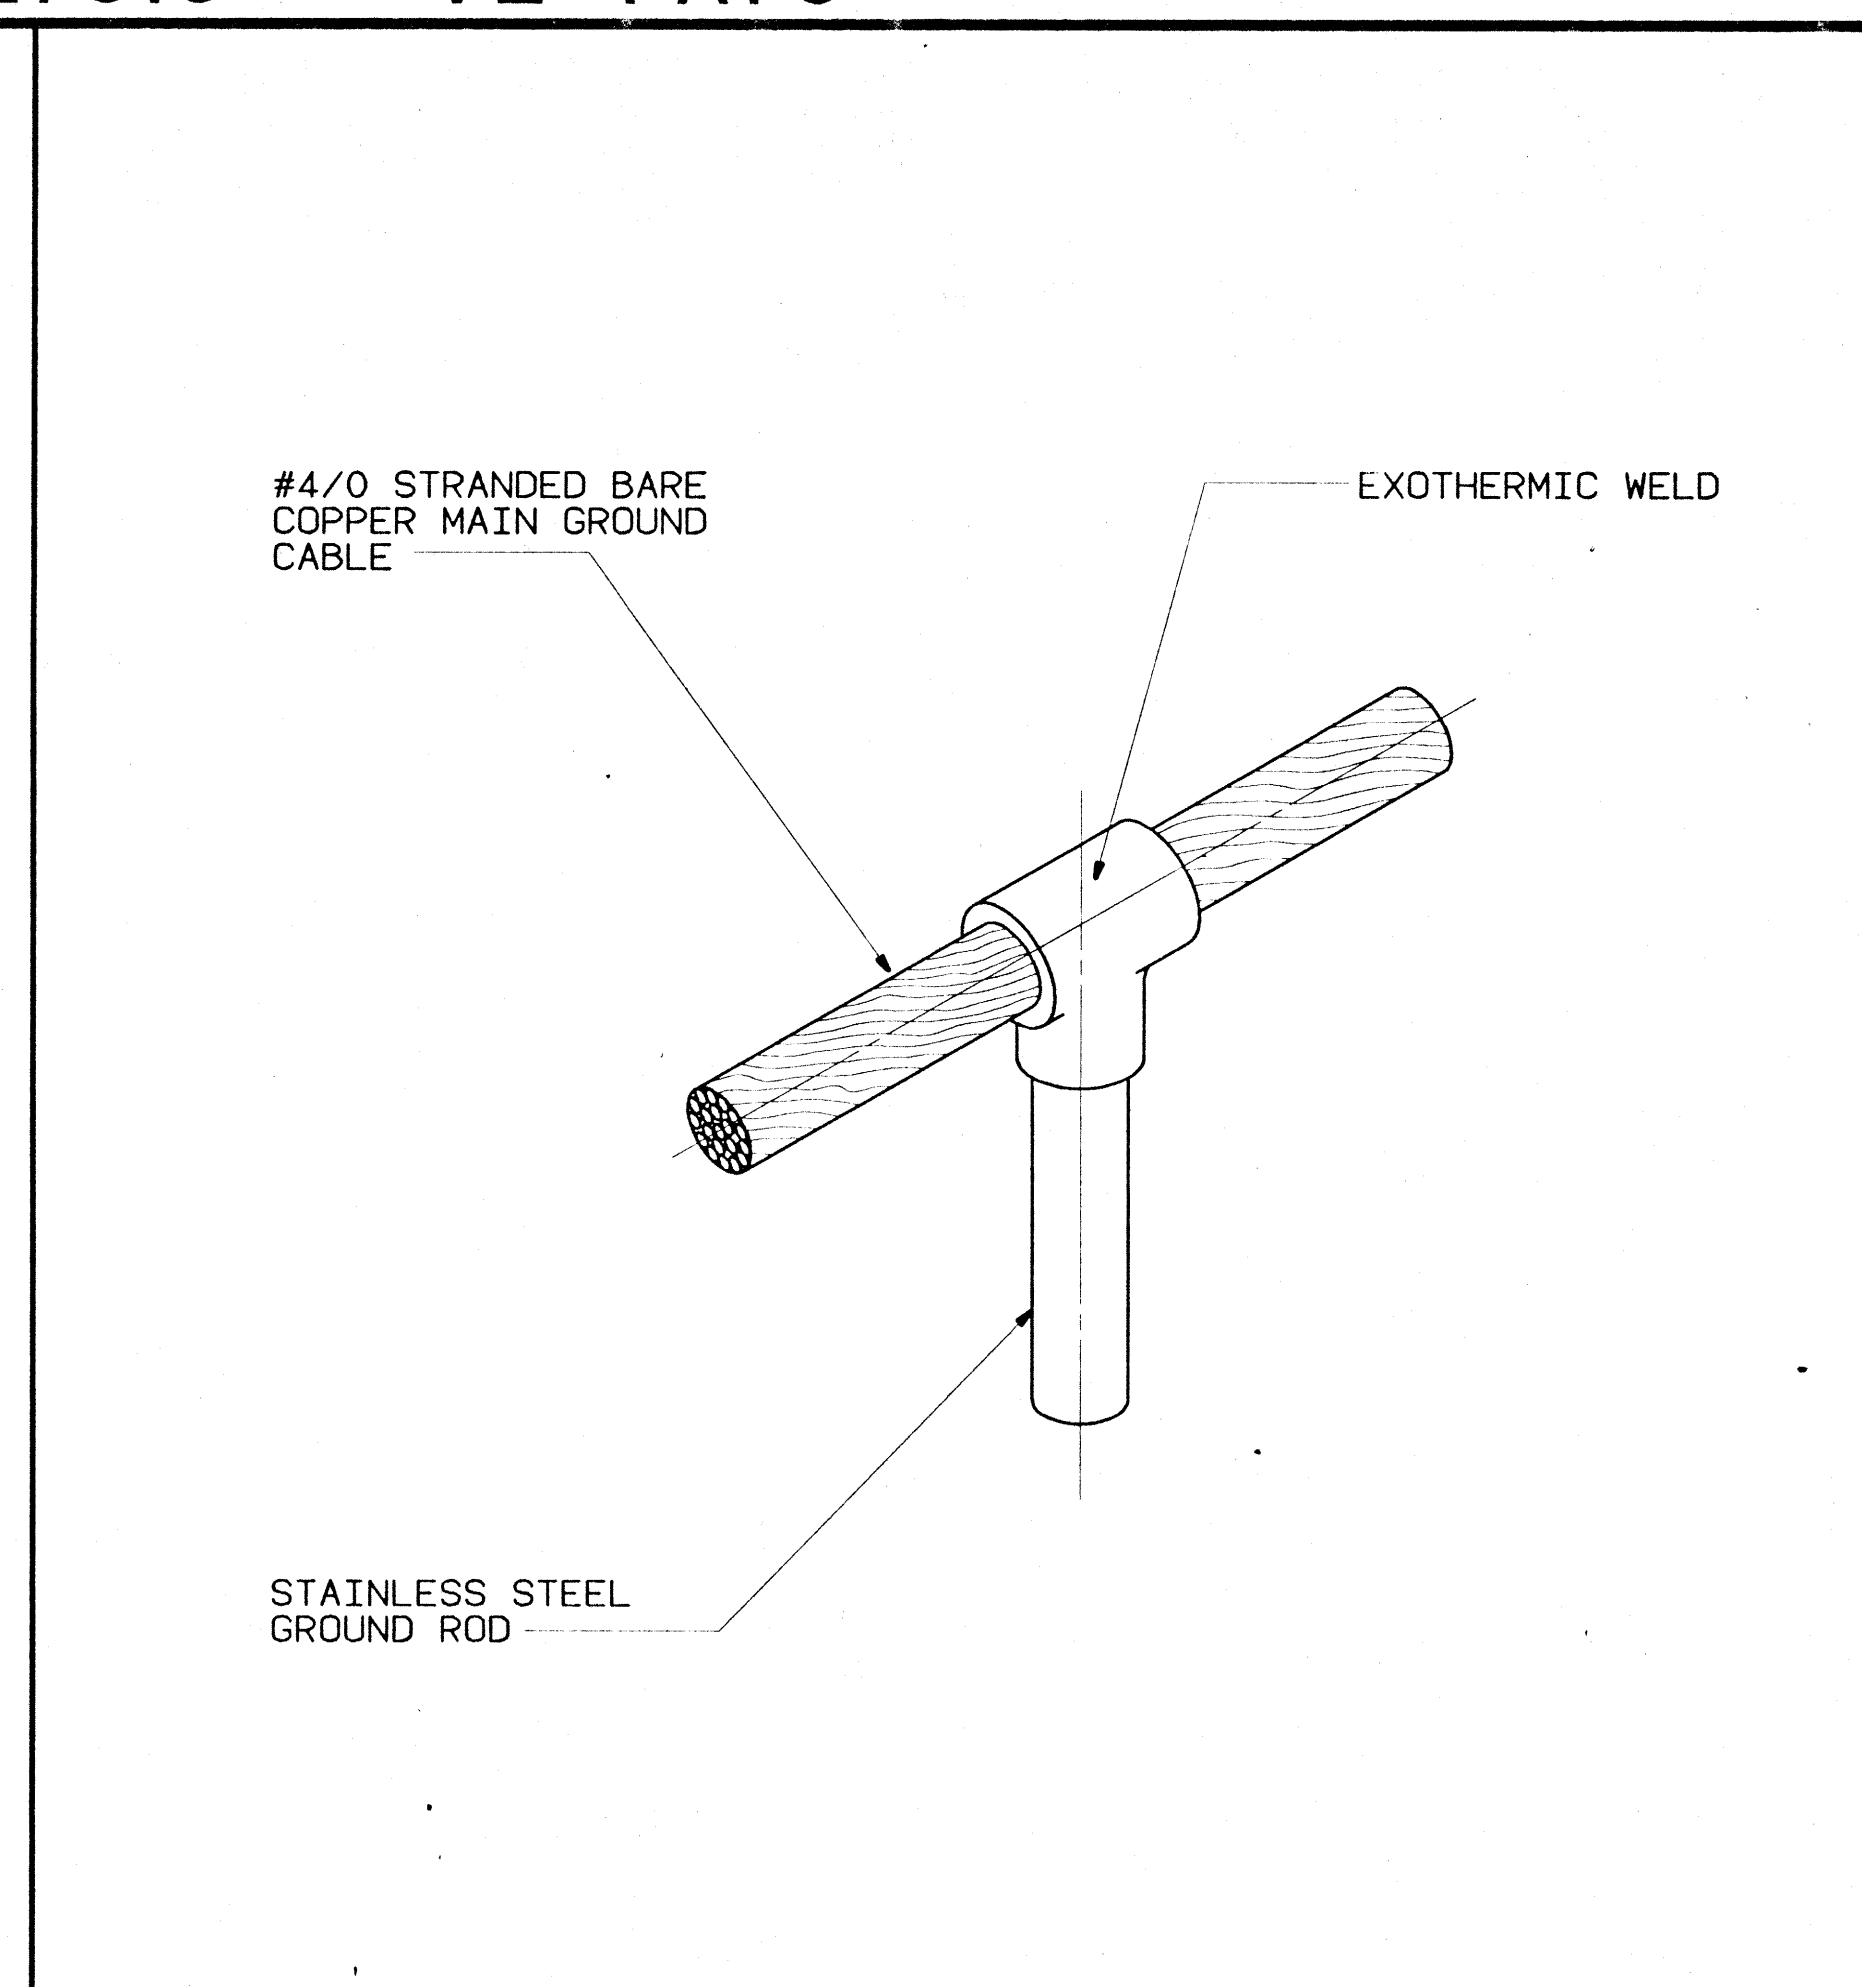

GROUND ROD DETAIL

SCALE: NONE


3
E-17 E-5

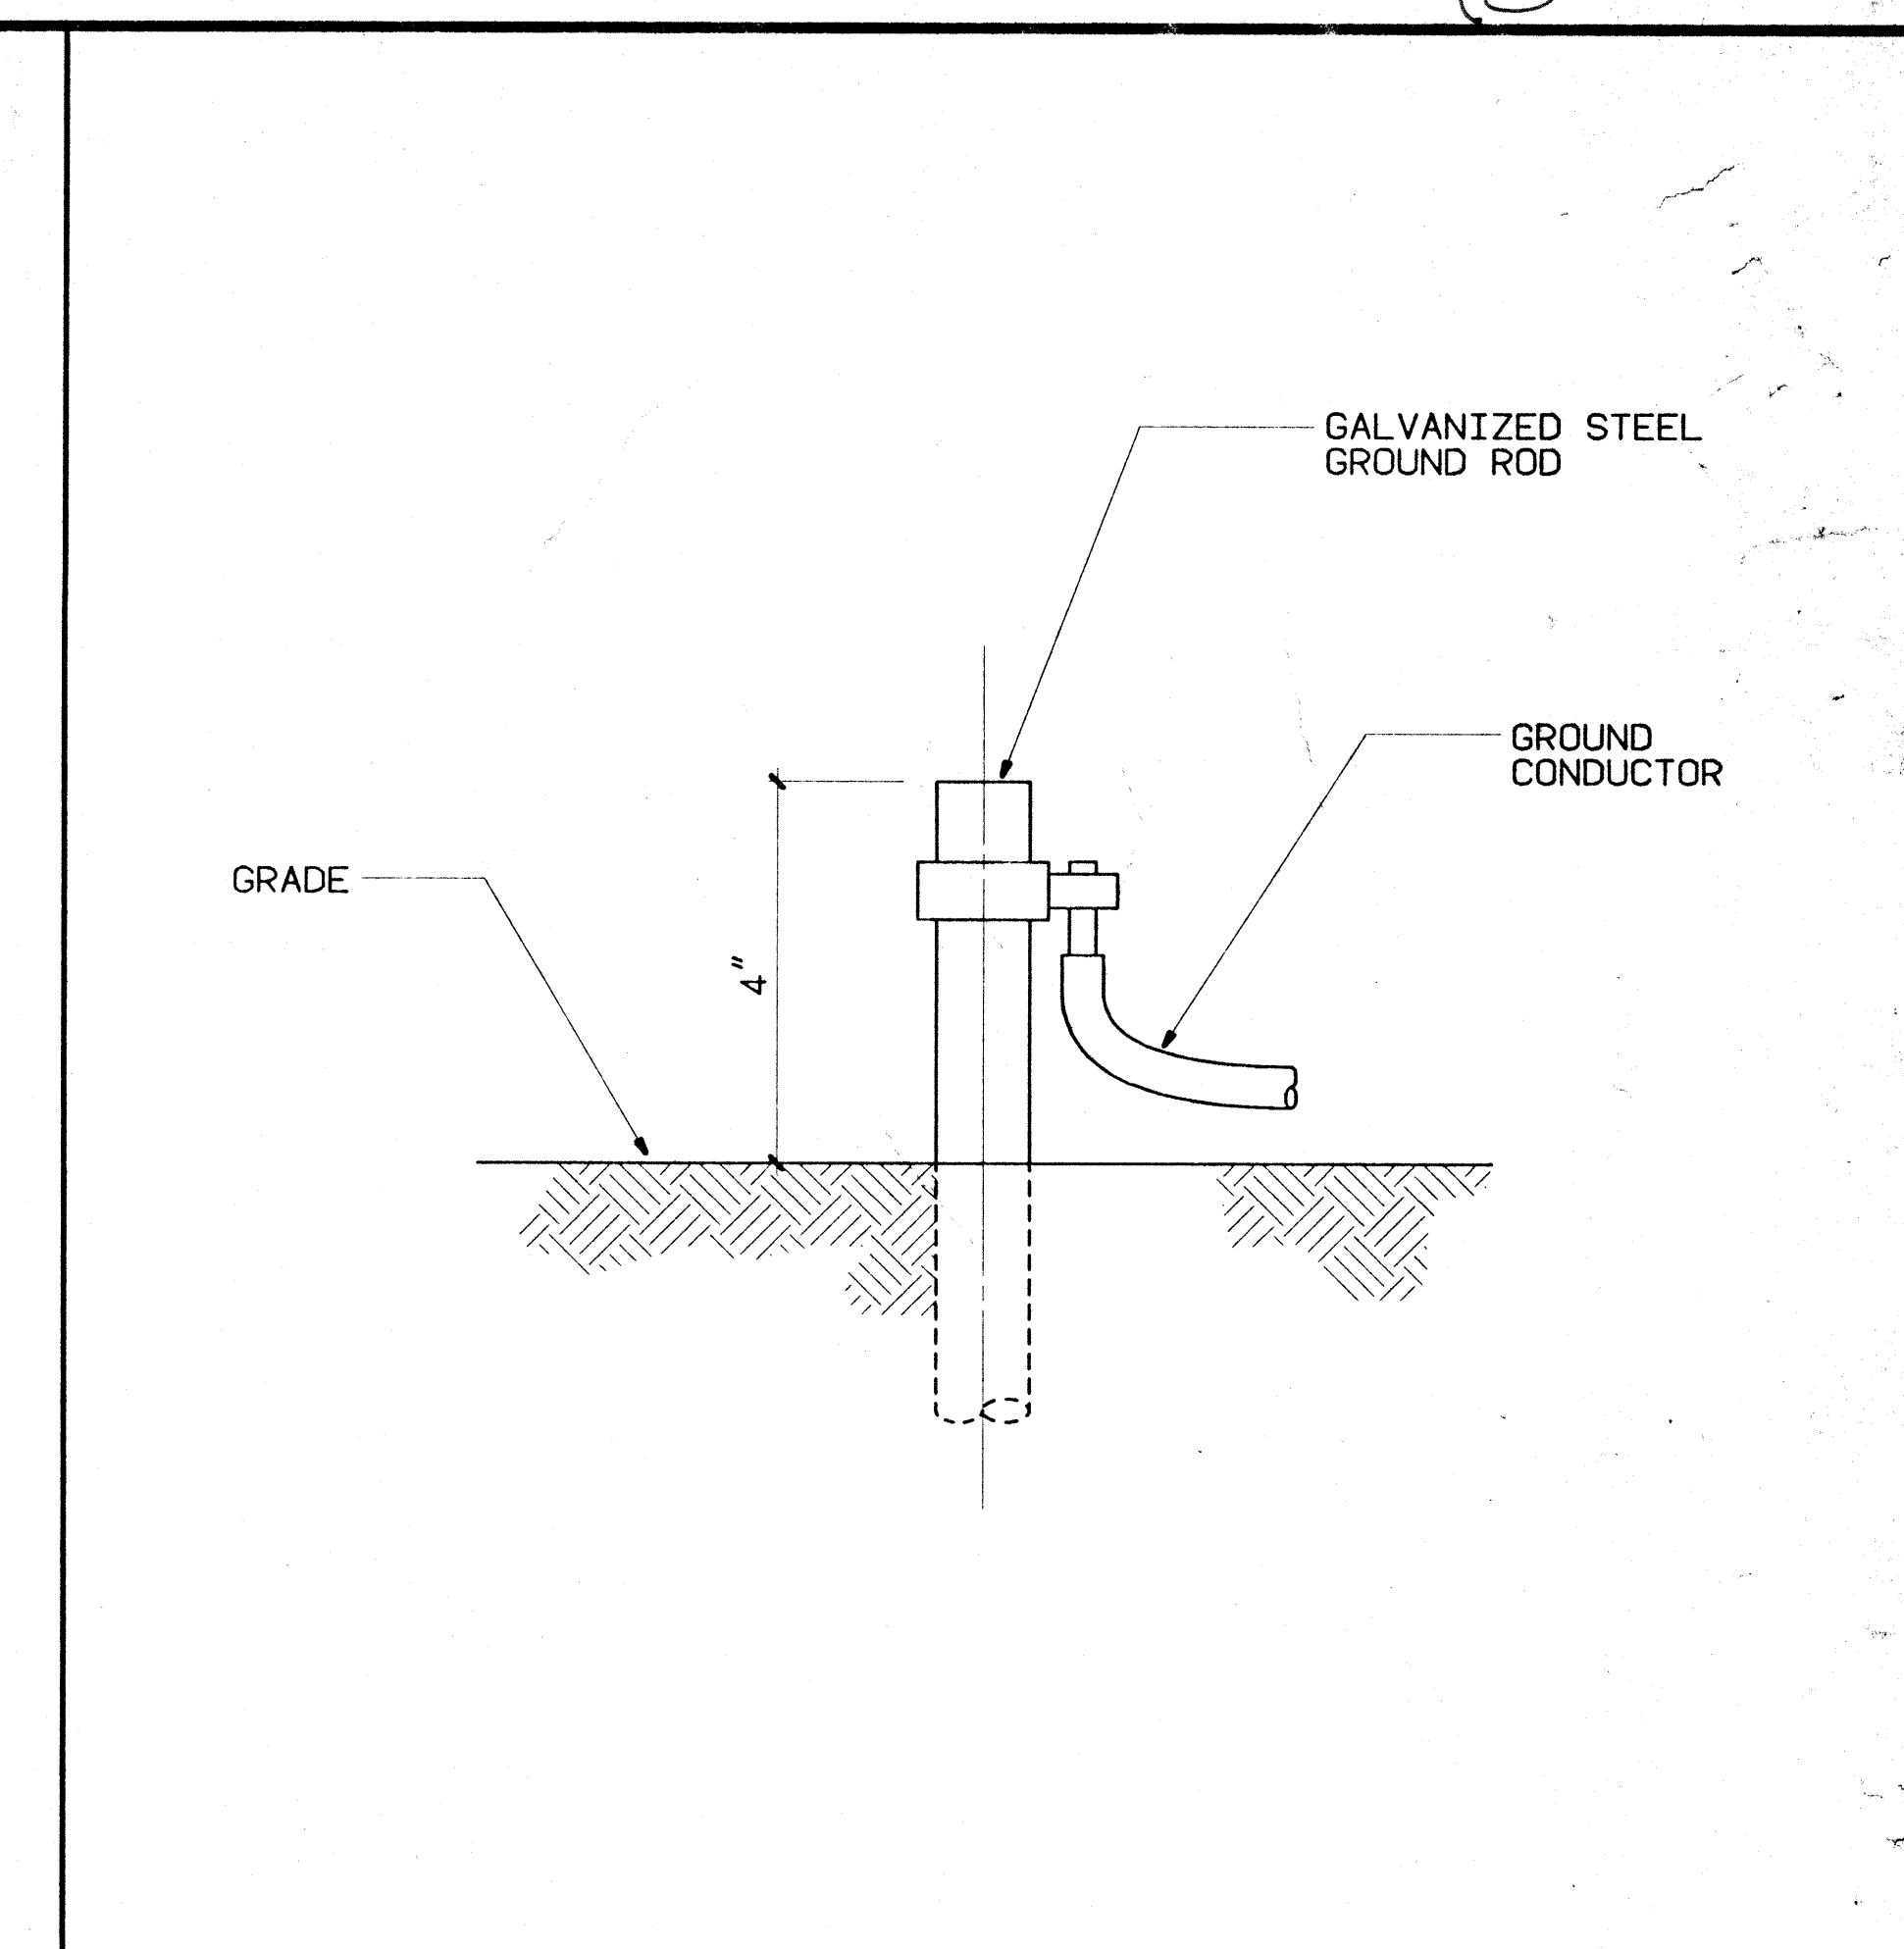

GROUND ROD DETAIL

SCALE: NONE

4
E-5, E-17 E-5

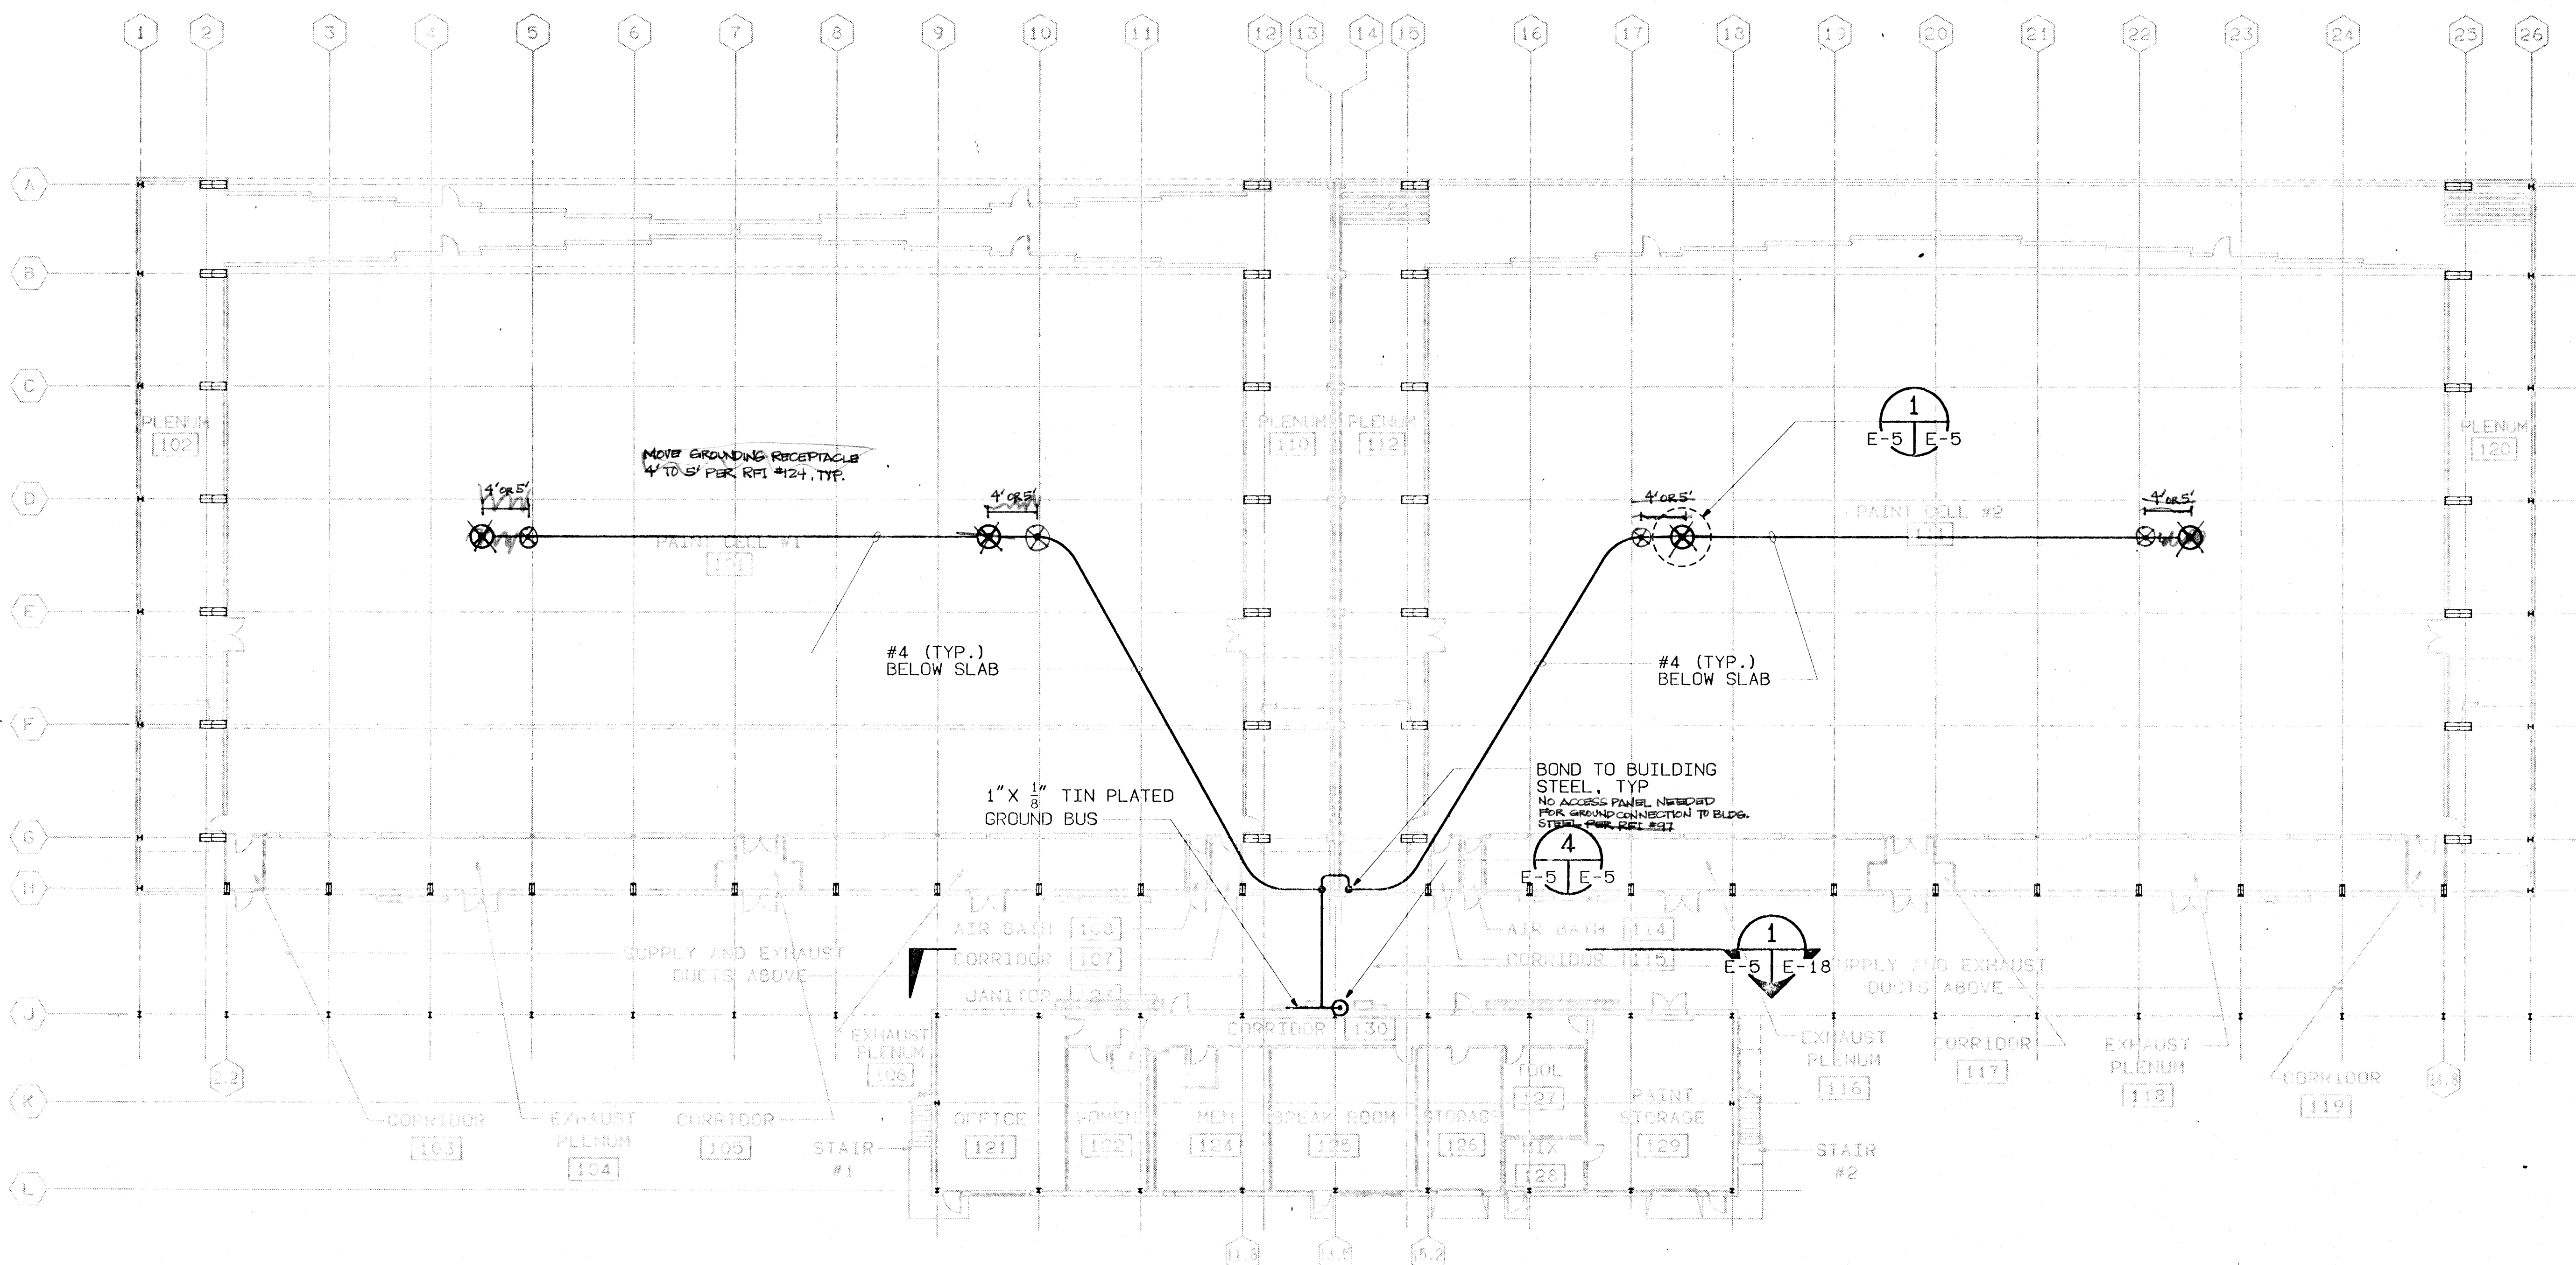

GROUNDING PLAN

SCALE: 1/16" = 1'-0"

Reference your RFI-149, dated September 28, 1994, regarding ground bus at service building.

Specification Section 16415, Paragraph 3.1.3, states in part "...noncurrent-carrying metal parts of electrical equipment shall be effectively grounded by bonding to the bus. The ground rod or rods..."

Therefore all the electrical equipment enclosures in this electrical equipment area shall be bonded to the ground bus. Some of the electrical equipment in this area are MCC1, MCC2, DPL, LPL, RPL, PP2, 2H, Emergency Battery Unit, etc. Additionally, bonding of the neutral point of the secondary side of Transformer T1 to the grounding electrode conductor is acceptable, provided the ground rod. Also, please note that other connections to this ground bus are shown on the contract drawings.

REVISION	DATE	REVISED DETAIL #1	RT
11/25/92			SY
NORMAN ENGINEERING CO.		DEPARTMENT OF THE ARMY	
CONSULTING ENGINEERS		SACRAMENTO DISTRICT, CORPS OF ENGINEERS	
LOS ANGELES, CALIFORNIA		SACRAMENTO, CALIFORNIA	
DESIGNED BY	MCCLELLAN AIR FORCE BASE CALIFORNIA		
R. SHEPARD	ADAL DEPOT CORROSION CONTROL FACILITY		
DRAWN BY	NEW AIRCRAFT PAINT FACILITY		
R. TAGAYUN			
CHECKED BY	GROUNDING PLAN B/B		
L. MYERS			
SUBMITTED BY	DATE APPROVED	SCALE: 1/16" = 1'-0"	SPEC No. 8529
9/30/92			
SHEET E-5		FILE No.	100-25-2051
77 OF 95			

NOTE:

- ALL FIXTURES, SWITCHES, WIRING ETC. IN ROOMS #103, #105, #107 AND #108 SHALL BE LOCATED A MINIMUM DISTANCE OF 36" AWAY FROM THE DOORS ENTERING THE PAINT CELL SO THAT THEY ARE OUTSIDE OF THE CLASS I, DIVISION 1, AREA (SEE DWG. E-2).
- SEE DETAIL 3, DWG. E-19 FOR EMERGENCY LIGHTING SCHEMATIC DIAGRAM.
- PROVIDE 3#12, 1" FLEX CONDUIT FROM J-BOX TO ALL 3-LAMP FLUORESCENT FIXTURES.


SEE RFI #23, RFP 13, R0012
 [5] LTG. H.R. VIA GUTTER ON BLDG. EXT.
 TO BALLAST CAB.
 3/4" C. 10#12, #12 GND.
 SEE 5/819 PER RFI'S 75#103, RFP 44, R0033

Circuits 23, 25, 27, & 29 should be controlled via a time switch as noted in the panel schedule on sheet E-15. The lighting contactor and time switch is located adjacent to Panel LP1, shown on Sheet E-16. Provide 24 hr time switch with override switch. Provide power to time switch from Panel LP1, SEE E-24

LIGHT FIXTURE L1 IS NOT CONNECTED TO THE EMERGENCY LIGHTING CIRCUIT PER RFI #31

Reference your RFI #72, dated January 19, 1994, regarding the branch circuit conductors running underground in the Class Division 1 hazardous area, as defined by the contract drawing sheet E-2. A review of your attached drawing produced the following comments:

- The seal-off located at the conduit stub-up shall be relocated to immediately outside the classified boundary. The seal-off can be located at the adapter between the rigid steel and rigid non-metallic conduit, but there shall be no fittings between the boundary and the seal-off. Reference NEC article 501-5(a)(1).
- All conduit seal-offs shall remain accessible. Reference NEC article 501-5(c)(1).
- Seal-offs will be required within 18 inches of each electrical device that is not factory sealed. Reference NEC article 501-5(a)(1).
- Steel conduit in contact with earth shall be protected against corrosion. Reference specification section 1415 paragraph 3.2.2.1.
- Conduit installed within the slab on grade shall comply with specification section 1415 paragraph 3.2.2.2.
- Conduit crossing a structural joint shall be installed to comply with section 1415 paragraph 3.2.2.

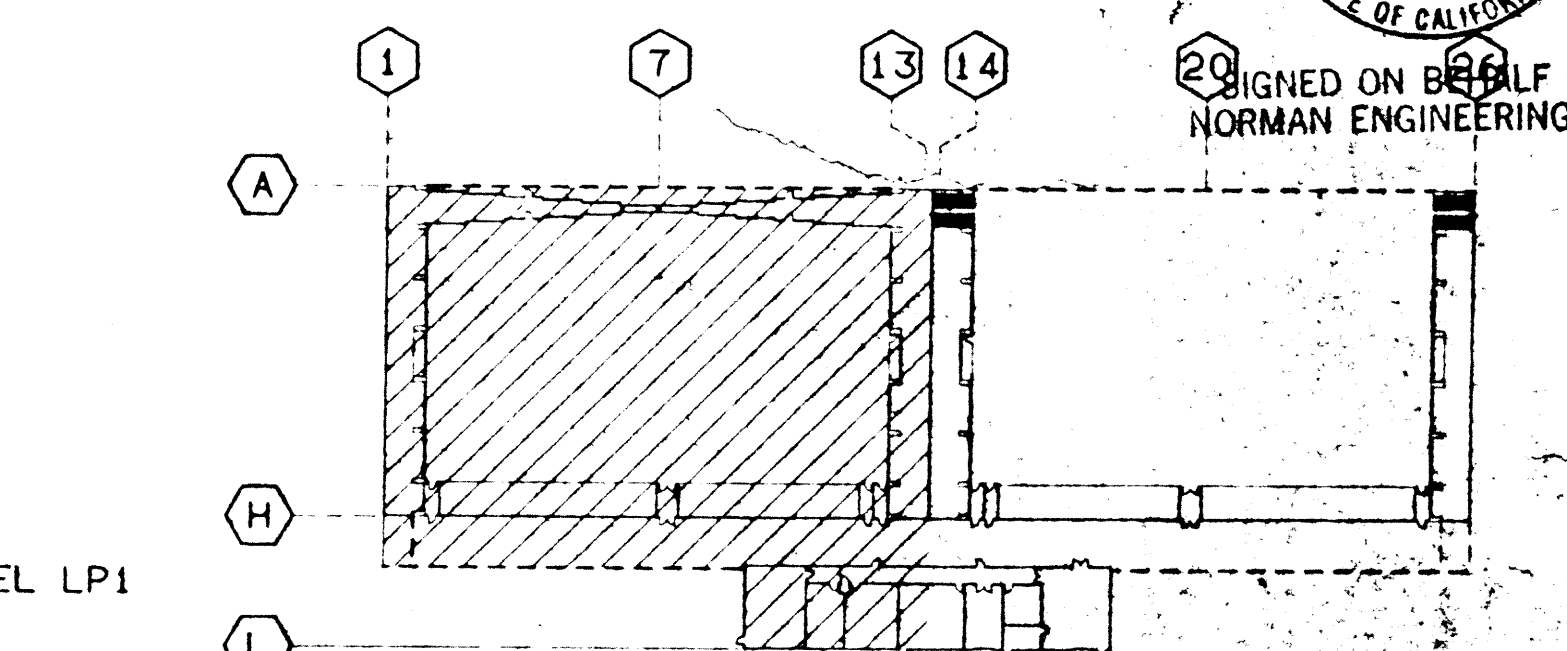

KEY PLAN

NOT TO SCALE

COLLINS ELECTRICAL CO., INC. 4107 Northgate Blvd. Sacramento, CA 95831 Phone: (916) 557-1100		DESIGNED BY R. SHEPARD		DRAWN BY R. TAGAYUN		CHECKED BY L. MYERS		SUBMITTED BY [Signature]	
DATE 9/30/92		DESCRIPTION NEW AIRCRAFT PAINT FACILITY		PROJECT ADAL DEPOT CORROSION CONTROL FACILITY		SHEET NO. E-8		TOTAL SHEETS 2051	
NORMAN ENGINEERING CO. CONSULTING ENGINEERS LOS ANGELES, CALIFORNIA				DEPARTMENT OF THE ARMY SACRAMENTO DISTRICT CORP. OF ENGINEERS SACRAMENTO, CALIFORNIA					

LIGHTING PLAN - SOUTH



SCALE: 1/8" = 1'-0"

FUNCTIONAL ANALYSIS - VE PAYS

NOTE:

1. ALL FIXTURES, SWITCHES, WIRING ETC. IN ROOMS #111, #116, #117, AND #119 SHALL BE LOCATED A MINIMUM DISTANCE OF 36" AWAY FROM THE DOORS ENTERING THE PAINT CELL SO THAT THEY ARE OUTSIDE OF THE CLASS I, DIVISION 1 AREA (SEE DWG. E-2).
2. SEE DETAIL 3, DWG E-19 FOR EMERGENCY LIGHTING SCHEMATIC DIAGRAM.
3. PROVIDE 3/4" 12, 1/2" FLEX CONDUIT FROM J-BOX TO ALL 3-LAMP FLUORESCENT FIXTURES.

5. SEE RPT #63
3/4" C. 10 #12, #12 GND. LGS. H.R. VIA GUTTER ON BLDG. EXT. TO BALLAST CAB.
LIGHT CIRCUIT E-1 IS NOT CONNECTED TO THE EMERGENCY LIGHTING CIRCUIT PER RPT #51

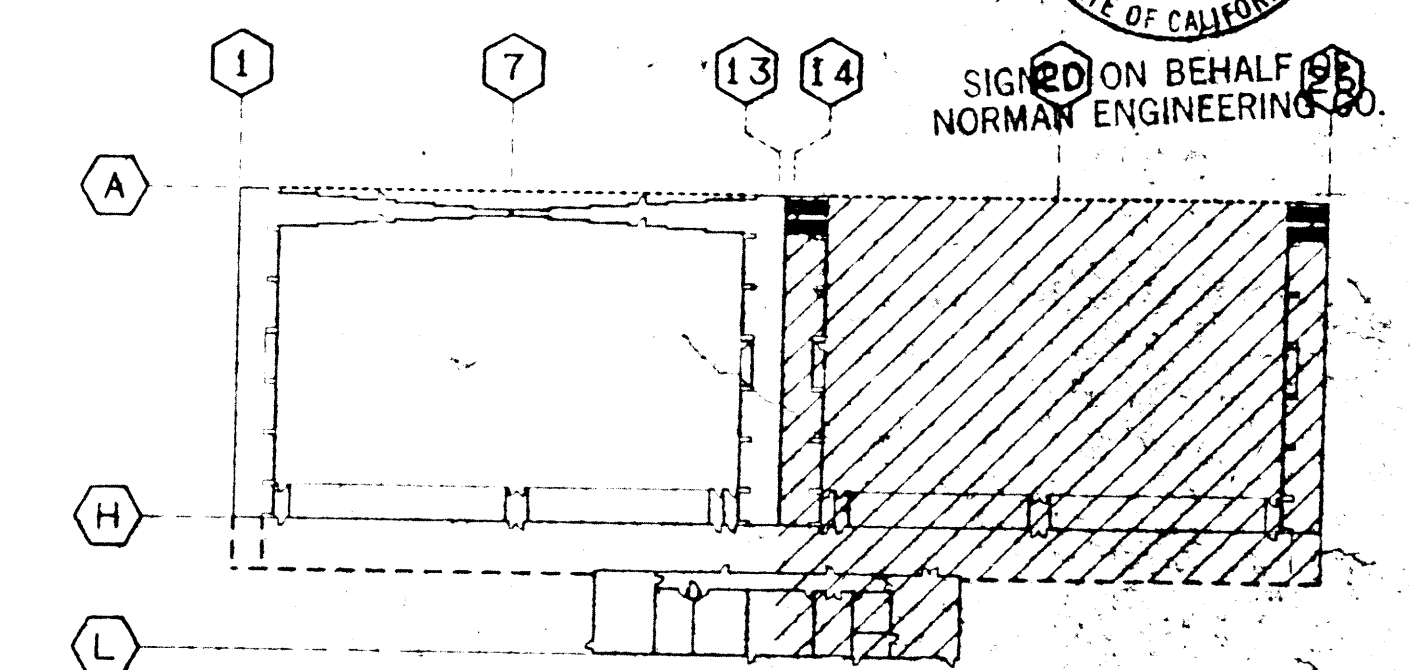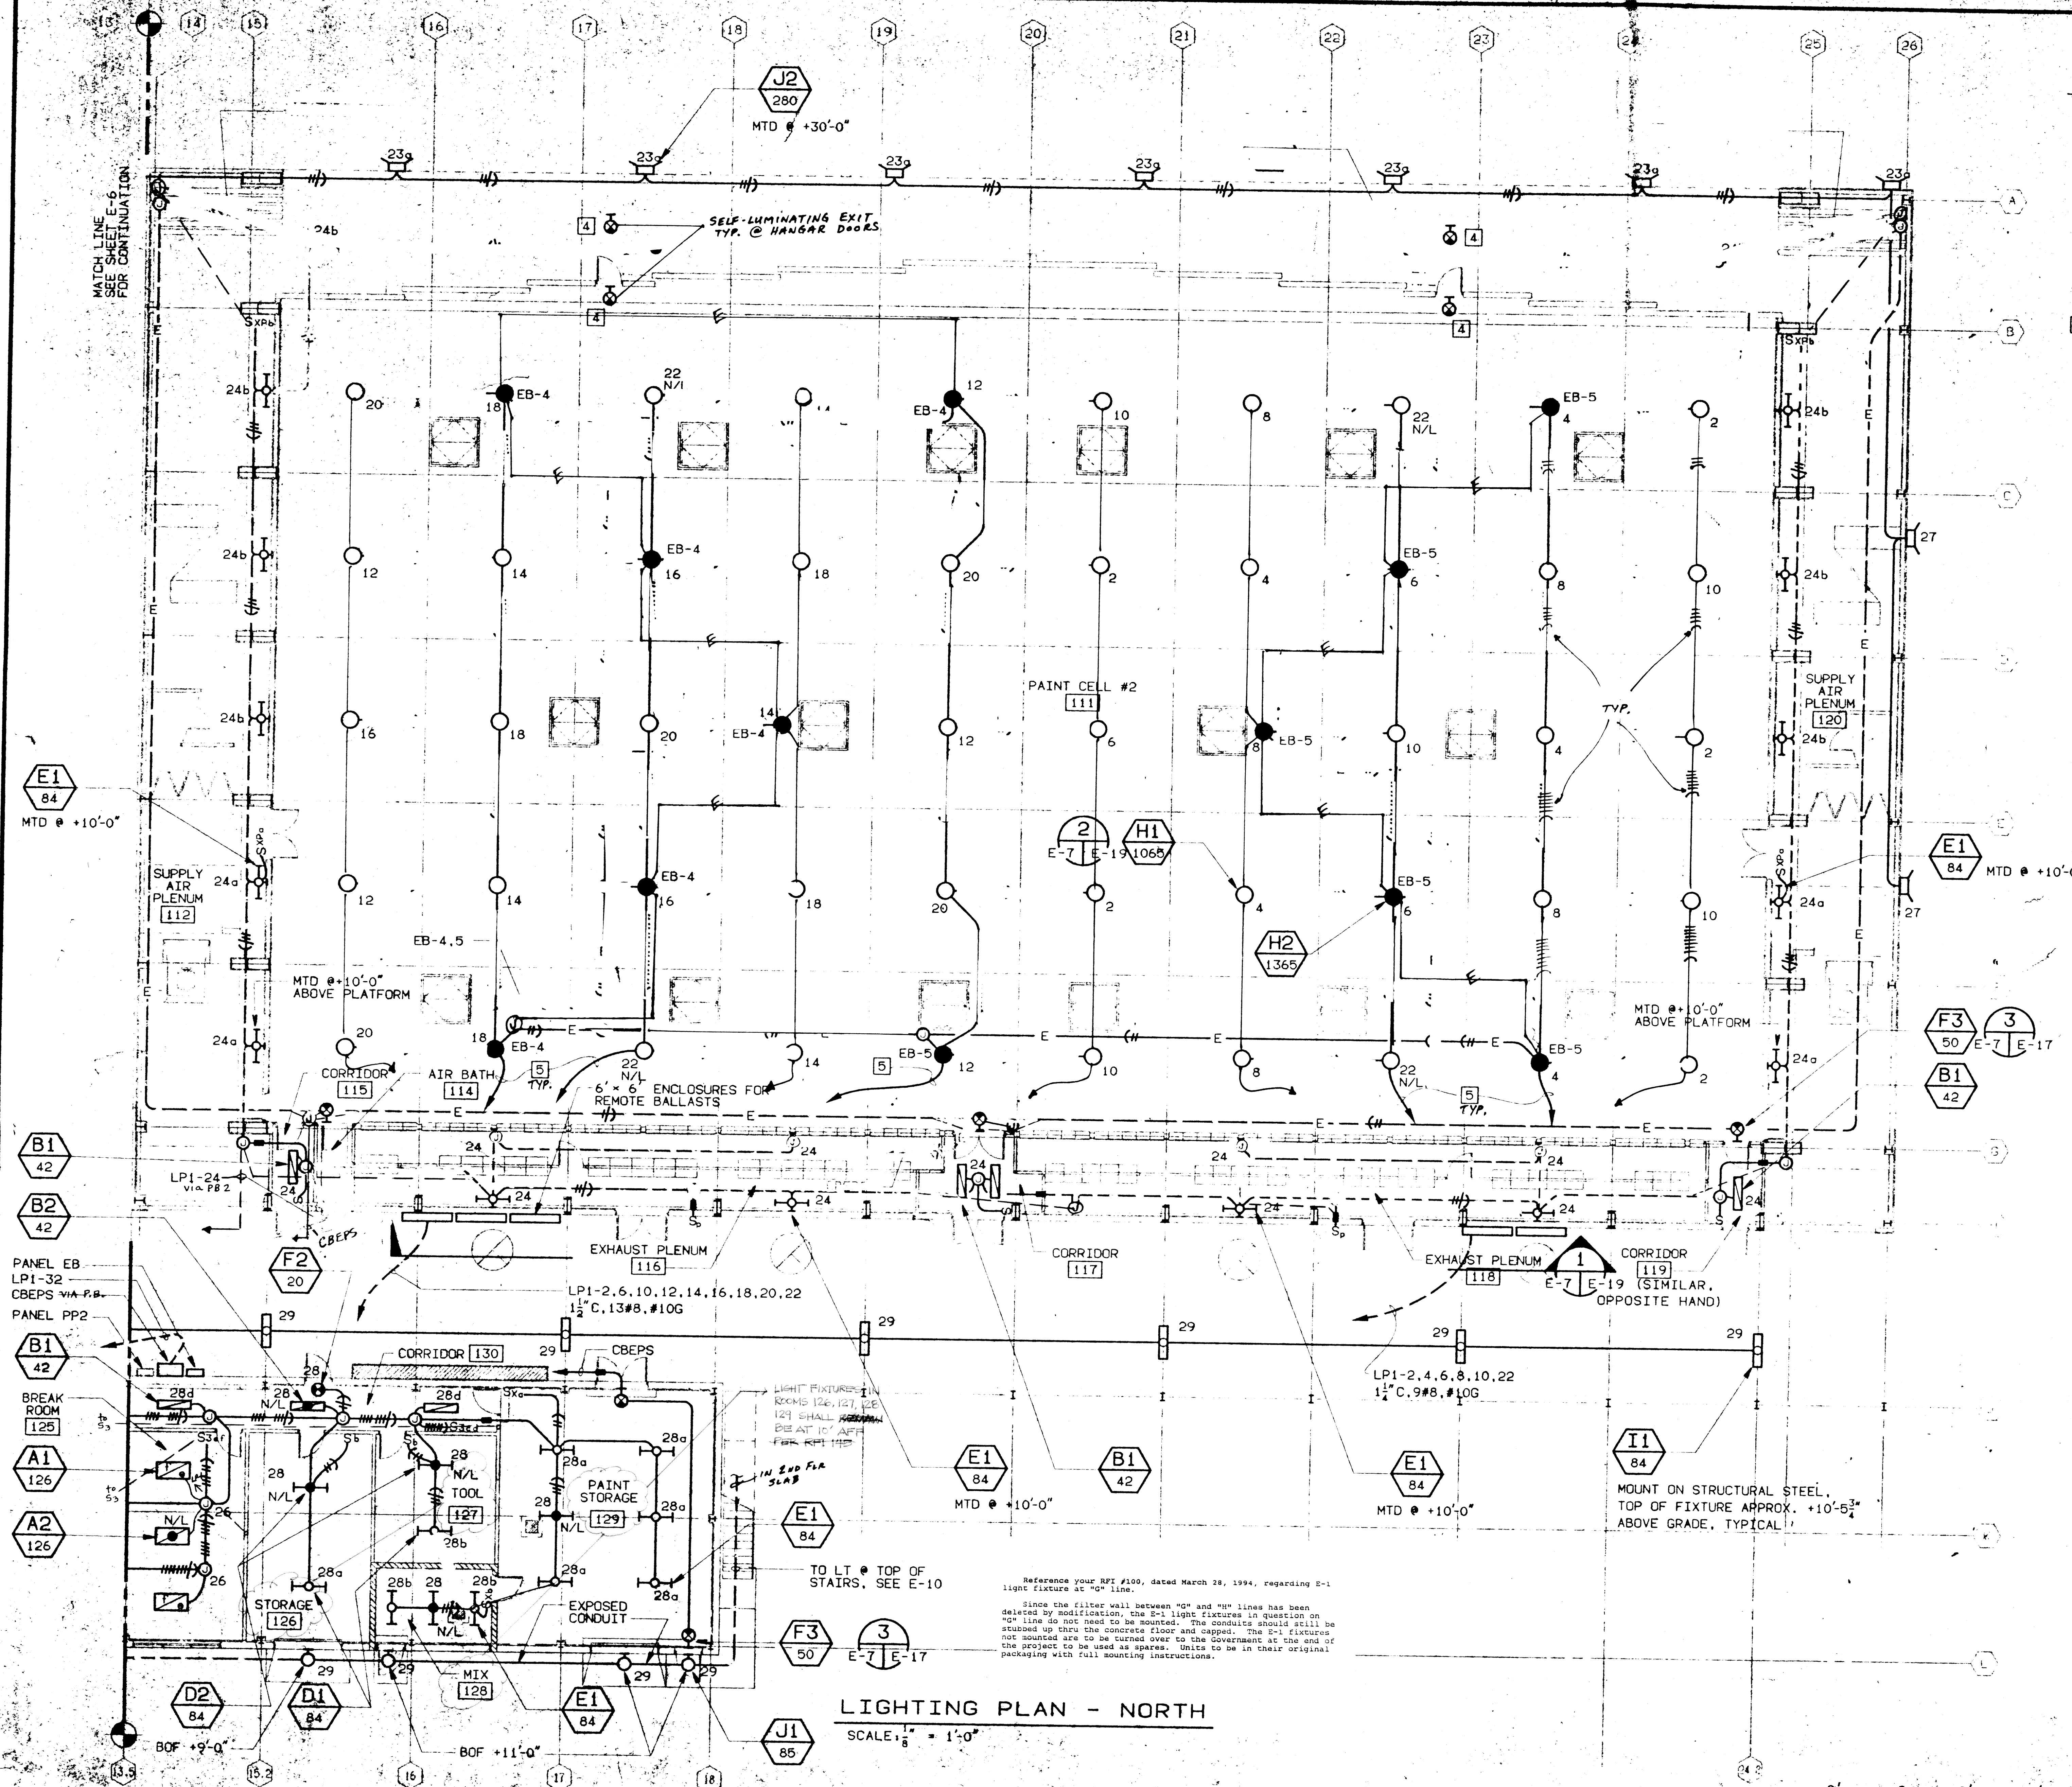

COLLINS ELECTRICAL CO., INC. 4107 Arroyo Blvd. Sacramento, CA 95834 Phone: (916) 567-1100		DEPARTMENT OF THE ARMY SACRAMENTO DISTRICT, CORPS OF ENGINEERS SACRAMENTO, CALIFORNIA	
DESIGNED BY R. SHEPARD	WCCLELLAN AIR FORCE BASE	CALIFORNIA	
DRAWN BY R. TAGAYUN	ADAL DEPOT CORROSION CONTROL FACILITY		
CHECKED BY L. MYERS	NEW AIRCRAFT PAINT FACILITY		
SUBMITTED BY		LIGHTING PLAN - NORTH	
DATE 9/30/98		SHEET NO. E-7	
PROJECT NO. 100-4-2051		SCALE 1/8" = 1'-0"	


FUNCTIONAL ANALYSIS - VE PAYS

NOTES:


- SEE DWG E-14 FOR CONDUIT AND CABLE SCHEDULE.
- SEE DWGS E-15 & E-16 FOR PANEL SCHEDULES.
- CONNECT TO FESTOON CABLE FEEDING CONTROLLER/DISCONNECT ON HANGAR DOORS.

HOMERUNS FROM CLASSIFIED AREAS ROUTED VIA U.G. PULLBOXES OUTSIDE CLASSIFIED AREAS

Both circuits for units FCU-1 and FCU-2 should be fed from the one (1) 20A/2P circuit breaker in panel PPI, circuits 9 and 11 shown on Sheet E-15. The two circuits should be spliced together in panel PPI and then 2#8 AWG from the splice should be run to the 20A/2P circuit breaker. *PP1-23*

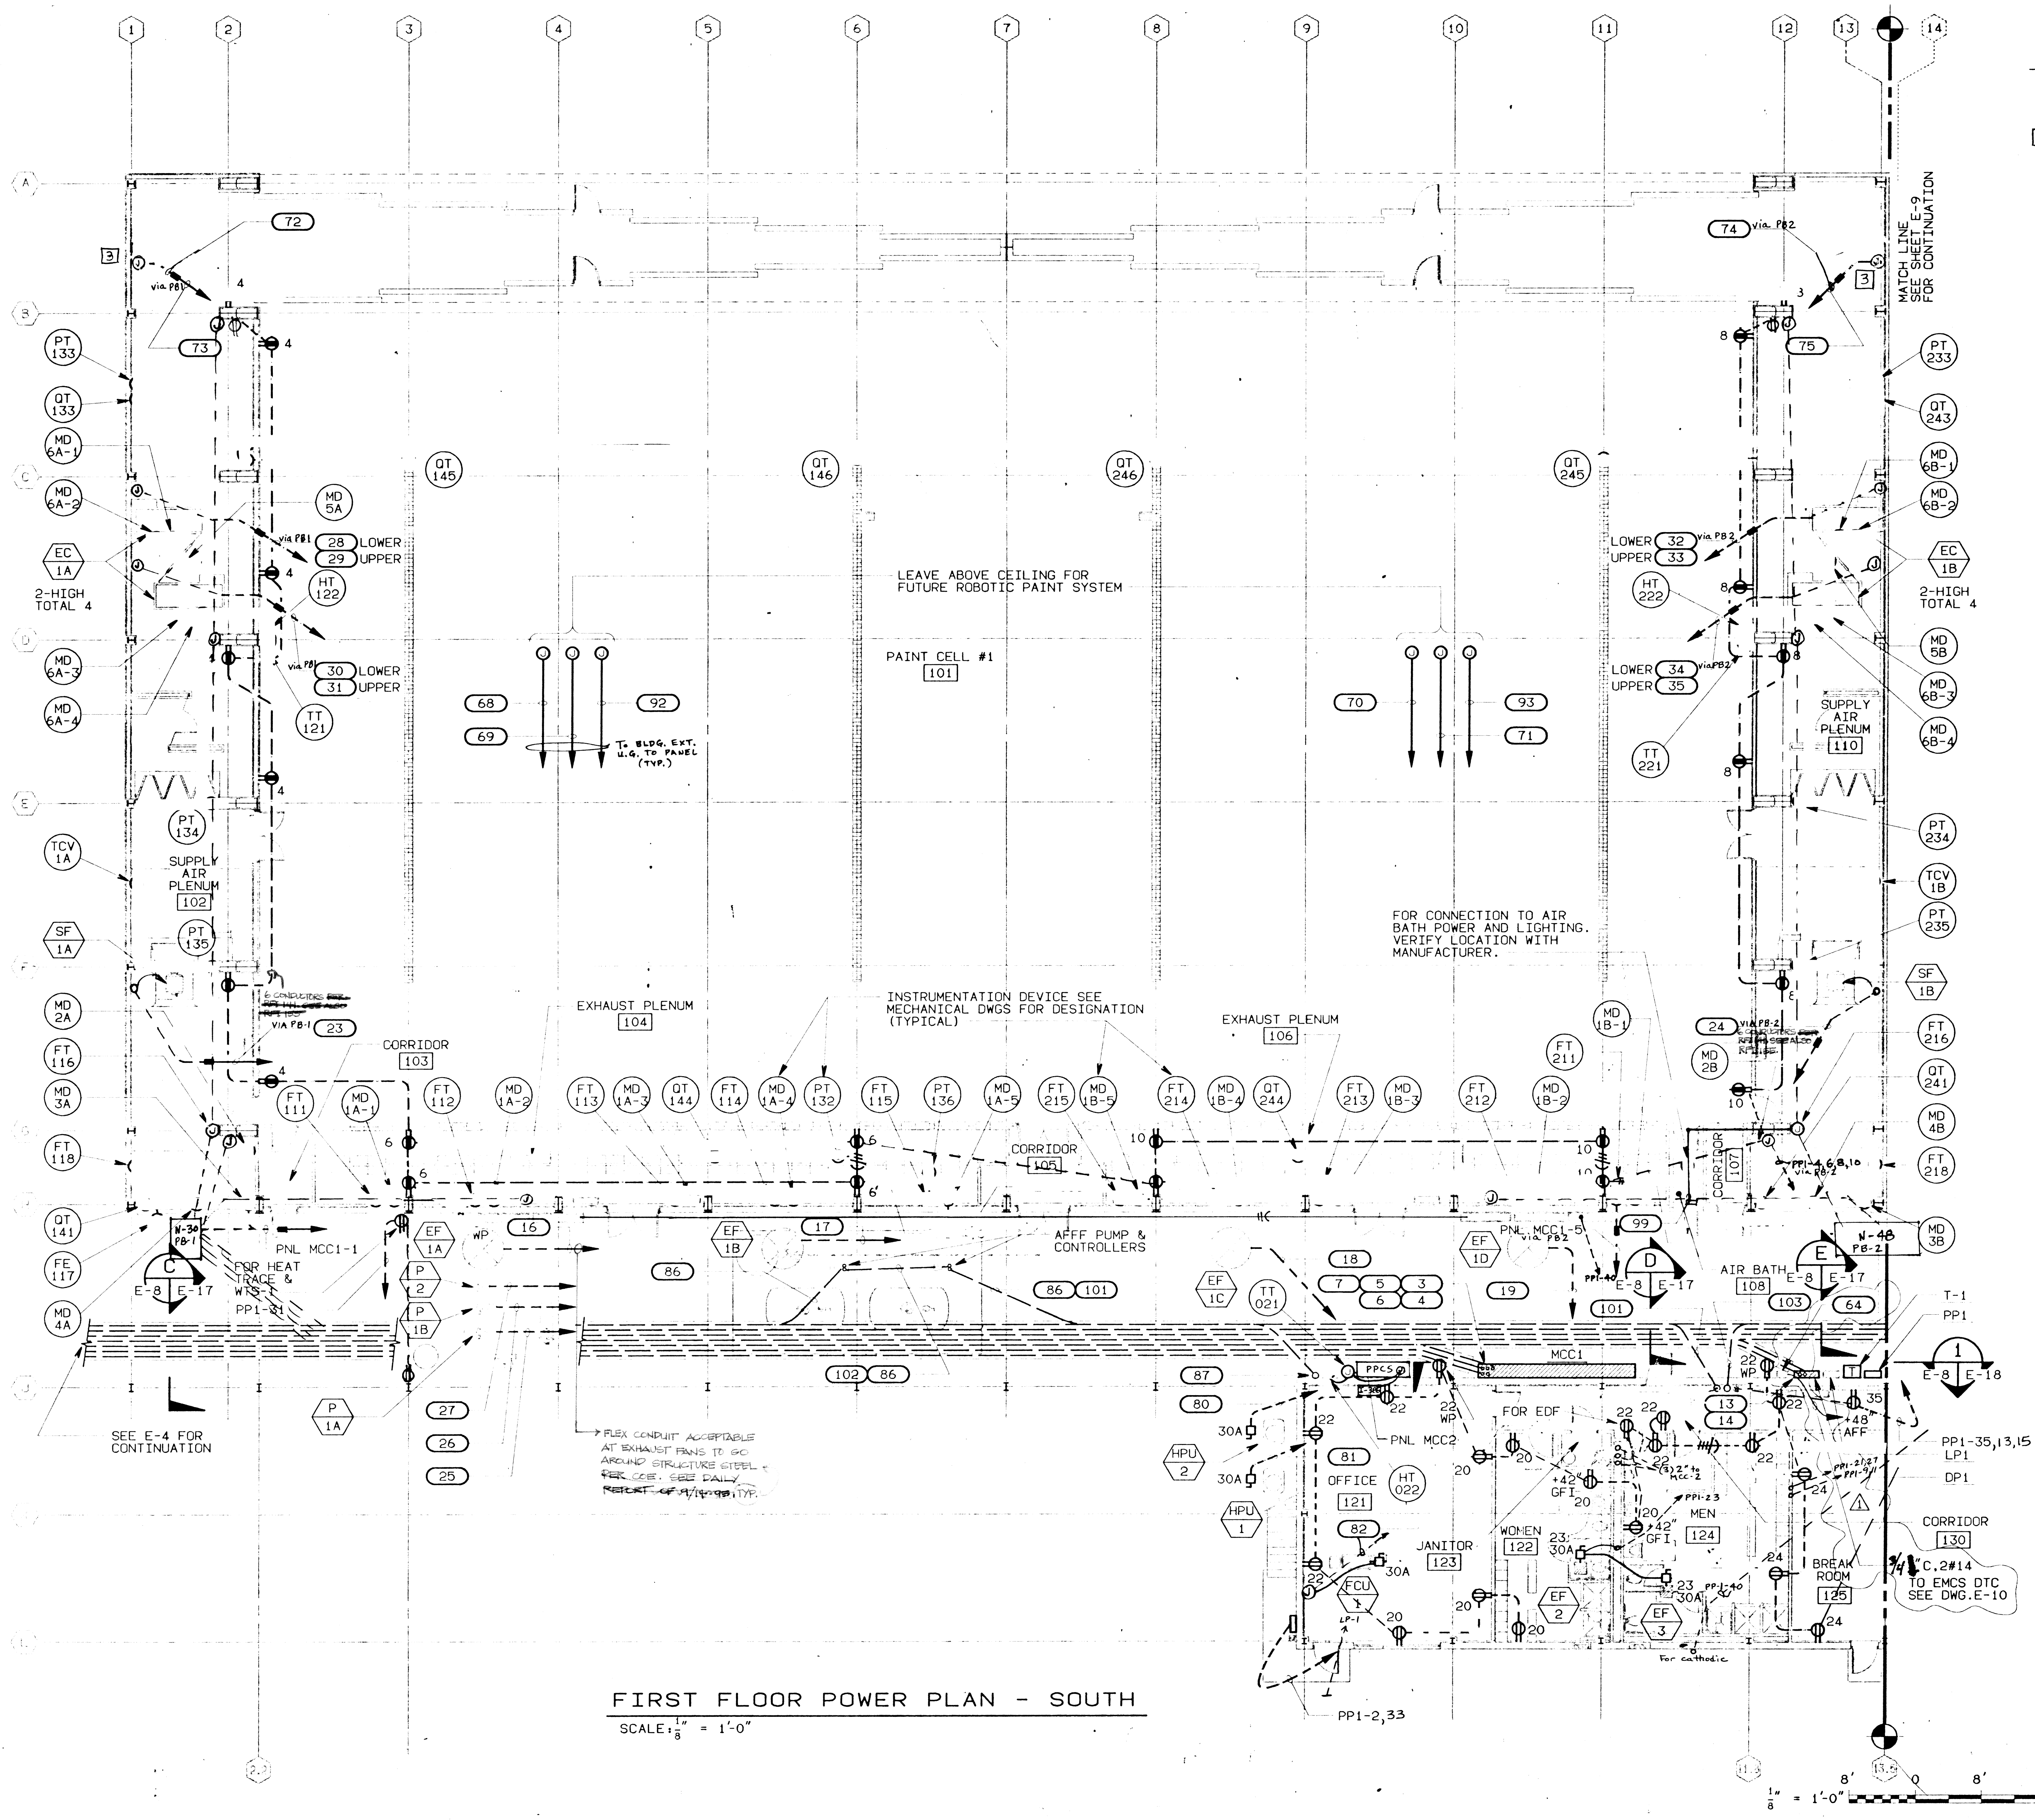

FIRST FLOOR POWER PLAN - SOUTH
SCALE: $\frac{1}{8}'' = 1'-0''$

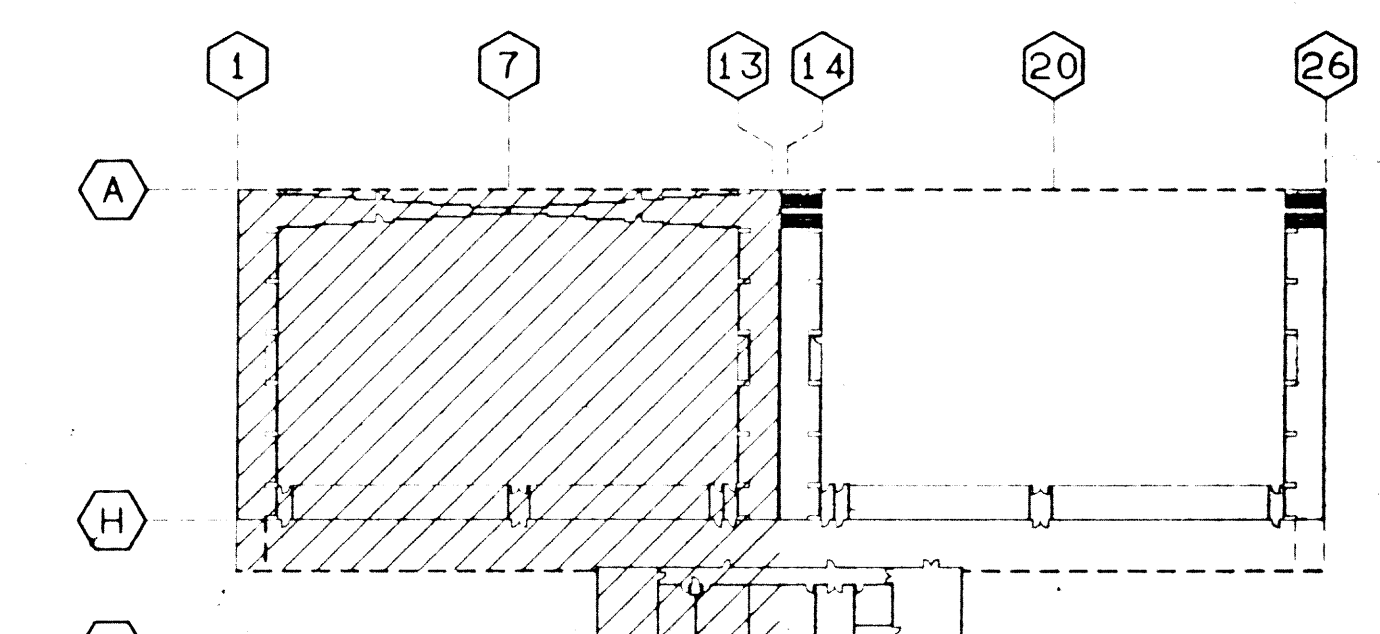

KEY PLAN
NOT TO SCALE

COLLINS ELECTRICAL CO., INC. 4107 Northgate Blvd. Sacramento, CA 95834 Phone: (916) 567-1100		RECORD Drawing	
REVISION	DATE	DESCRIPTION	BY
1	11/25/92	MISCELLANEOUS REVISION	RT
NORMAN ENGINEERING CO. CONSULTING ENGINEERS LOS ANGELES, CALIFORNIA		DEPARTMENT OF THE ARMY SACRAMENTO DISTRICT, CORPS OF ENGINEERS SACRAMENTO, CALIFORNIA	
DESIGNED BY R. SHEPARD	MCCLELLAN AIR FORCE BASE ADAL DEPOT CORROSION CONTROL FACILITY NEW AIRCRAFT PAINT FACILITY		
DRAWN BY R. TAGAYUN	CALIFORNIA		
CHECKED BY L. MYERS	POWER PLAN - SOUTH		
SUBMITTED	DATE APPROVED	SCALE: $\frac{1}{8}'' = 1'-0''$	SHEET NO. 8529
9/30/92		E-8	FILE NO. 100-25-2051
		80 OF 95	

NOTES:


- SEE DWG E-14 FOR CONDUIT AND CABLE SCHEDULE.
- SEE DWGS E-15 AND E-16 FOR PANEL SCHEDULES.

Both circuits for units FCU-1 and FCU-2 should be fed from the one (1) 20A/2P circuit breaker in panel PPI, circuits 9 and 11 shown on sheet E-15. The two circuits should be applied together in panel PPI and then 2-#8 AWG from the splice should be run to the 20A/2P circuit breaker.

PROVIDE CONTROLS, DEVICES AND WIRING
MEG. E.Q. AS NEEDED BUT NOT SHOWN PER
RPI #16


Reference your RPI #92, dated January 19, 1994, regarding the branch circuit conductors running underground in the Class I, Division 1 hazardous area, as defined by the contract drawing sheet E-2. A review of your attached drawing produced the following comments:

- The seal-off located at the conduit stub-up shall be relocated to immediately outside the classified boundary. The seal-off can be located at the adapter between the rigid steel and rigid non-metallic conduit, but there shall be no fittings between the boundary and the seal-off. Reference NEC article 501-5(a)(1).
- All conduit seal-offs shall remain accessible. Reference NEC article 501-5(c)(1).
- Seal-offs will be required within 18 inches of each electrical device that is not factory sealed. Reference NEC article 501-5(a)(1).
- Steel conduit in contact with earth shall be protected against corrosion. Reference specification section 1415 paragraph 3.2.2.1.
- Conduit installed within the slab on grade shall comply with specification section 1415 paragraph 3.2.2.2.
- Conduit crossing a structural joint shall be installed to comply with section 1415 paragraph 3.2.2.

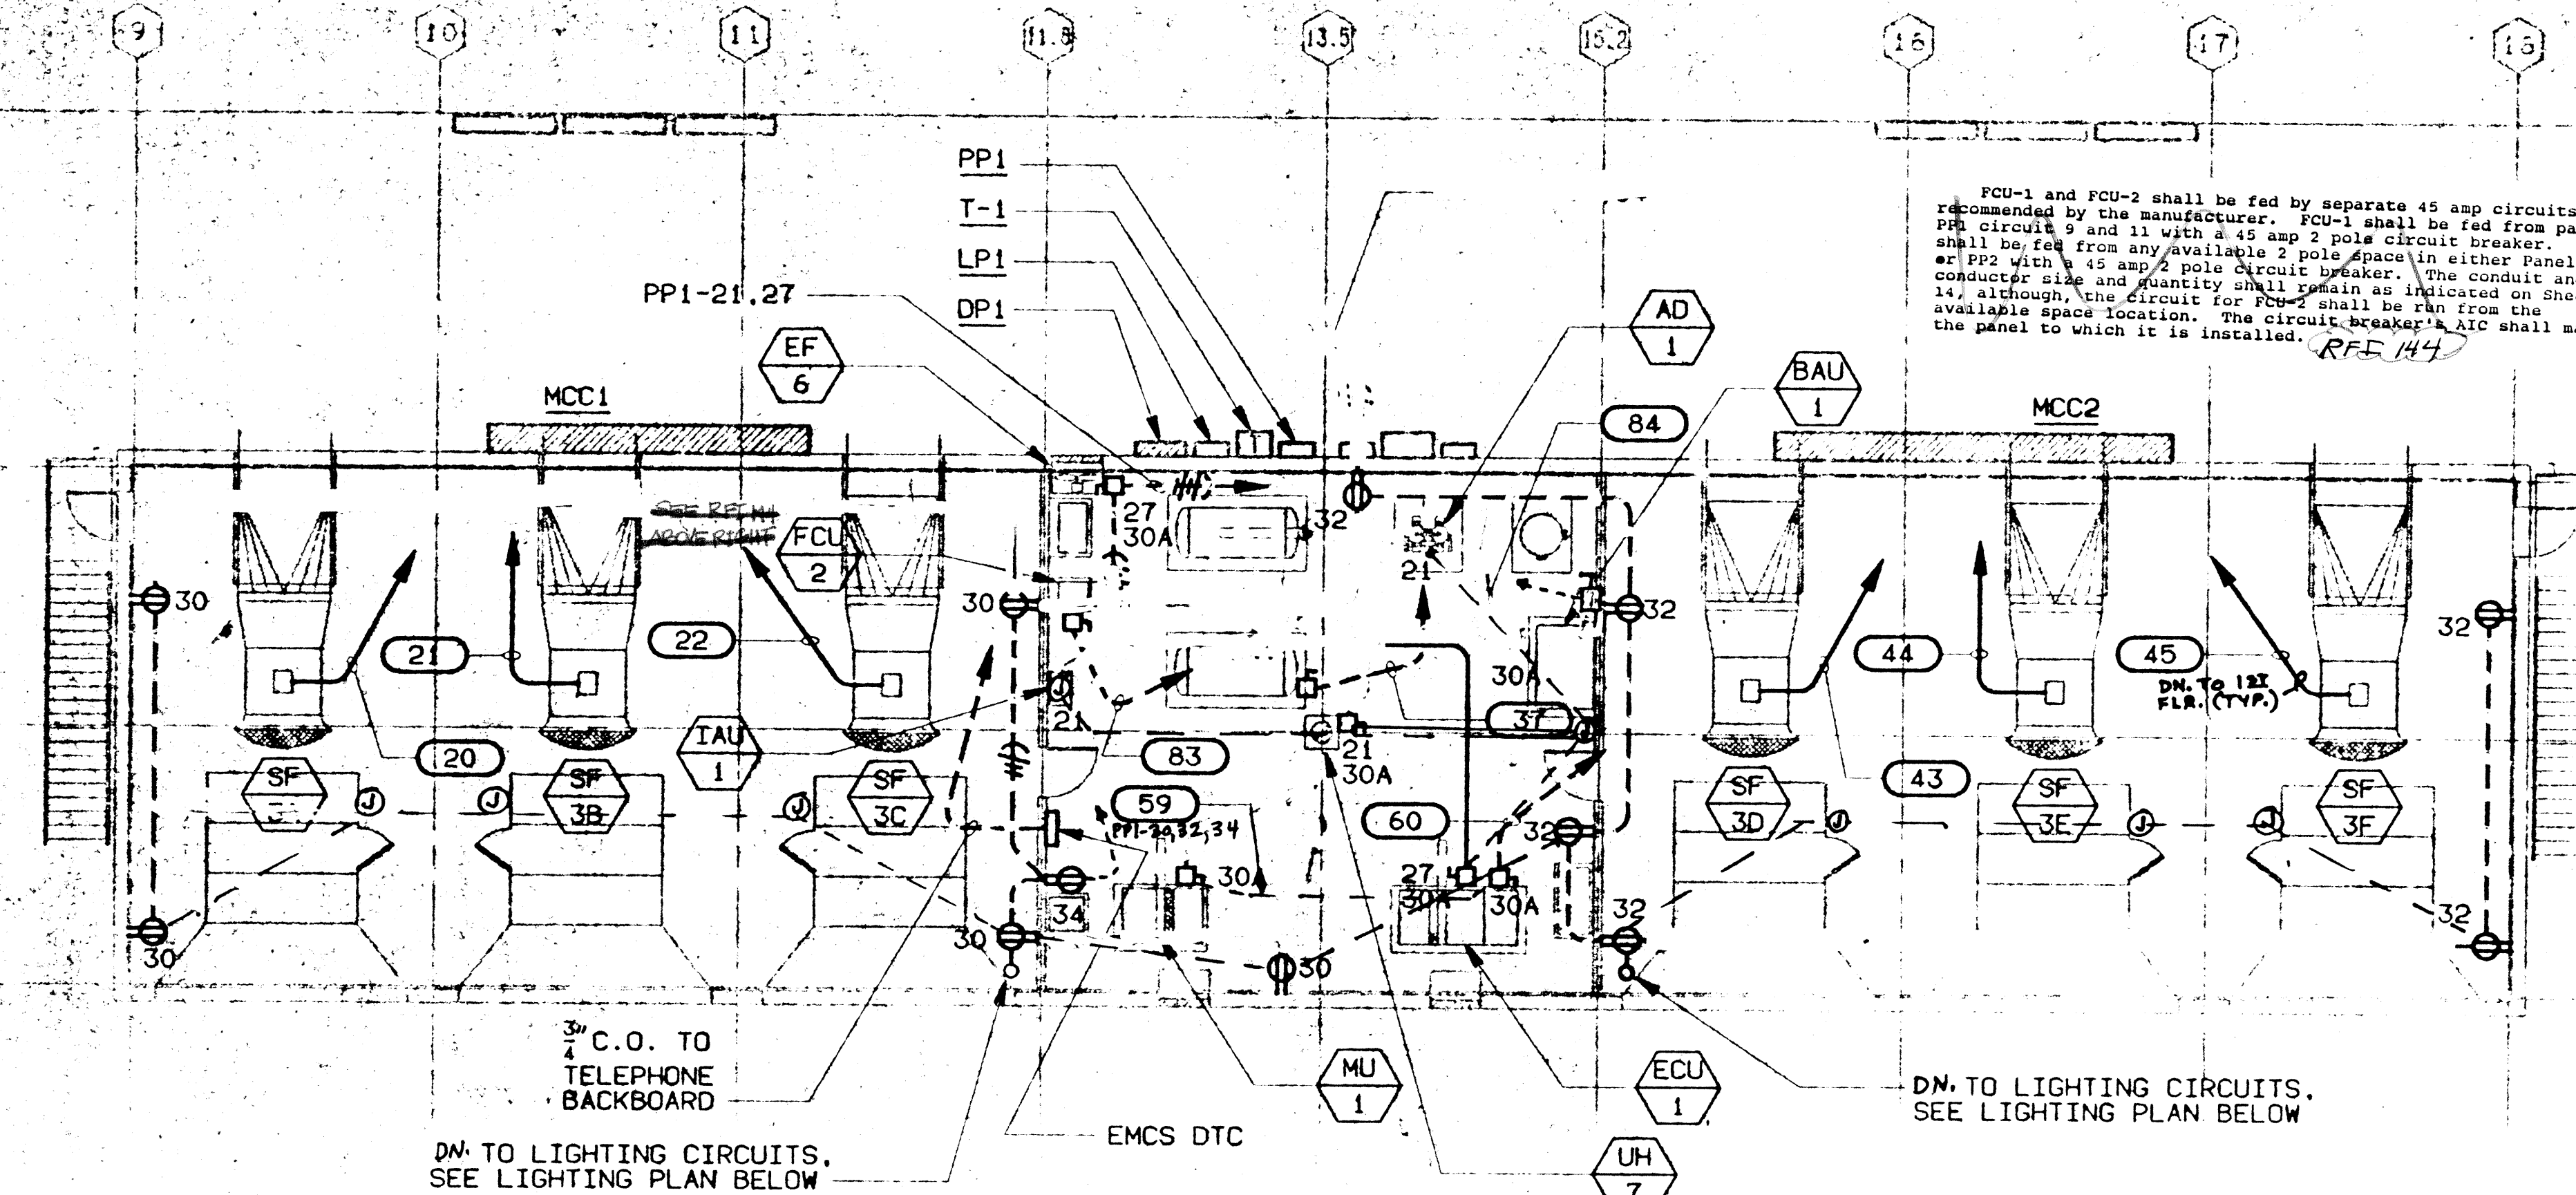


MECHANICAL EQUIPMENT SPACE POWER PLAN

SCALE: $\frac{1}{8}'' = 1'-0''$

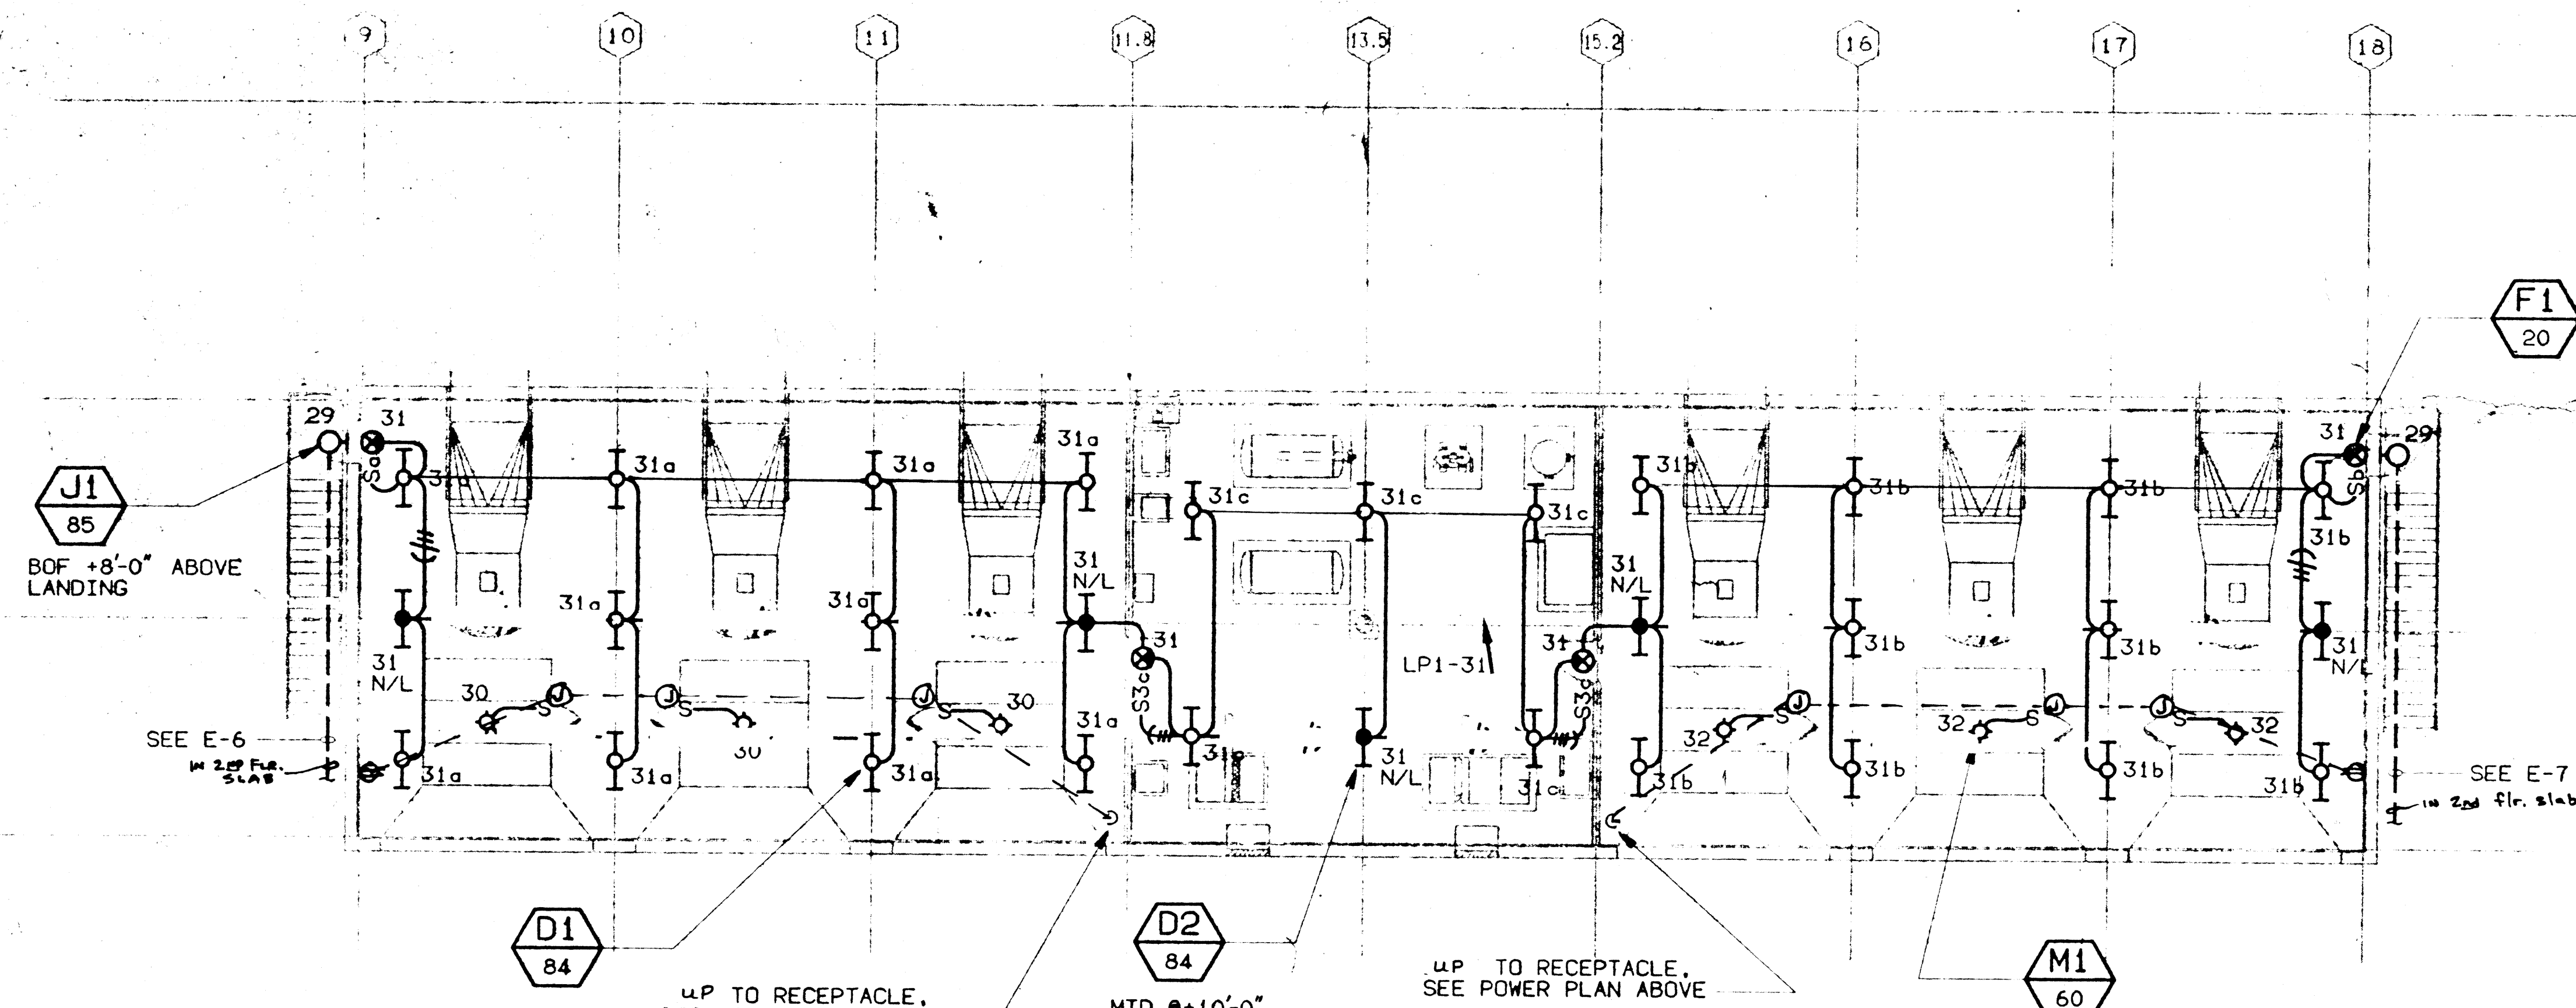

MECHANICAL EQUIPMENT SPACE LIGHTING PLAN

SCALE: $\frac{1}{8}'' = 1'-0''$


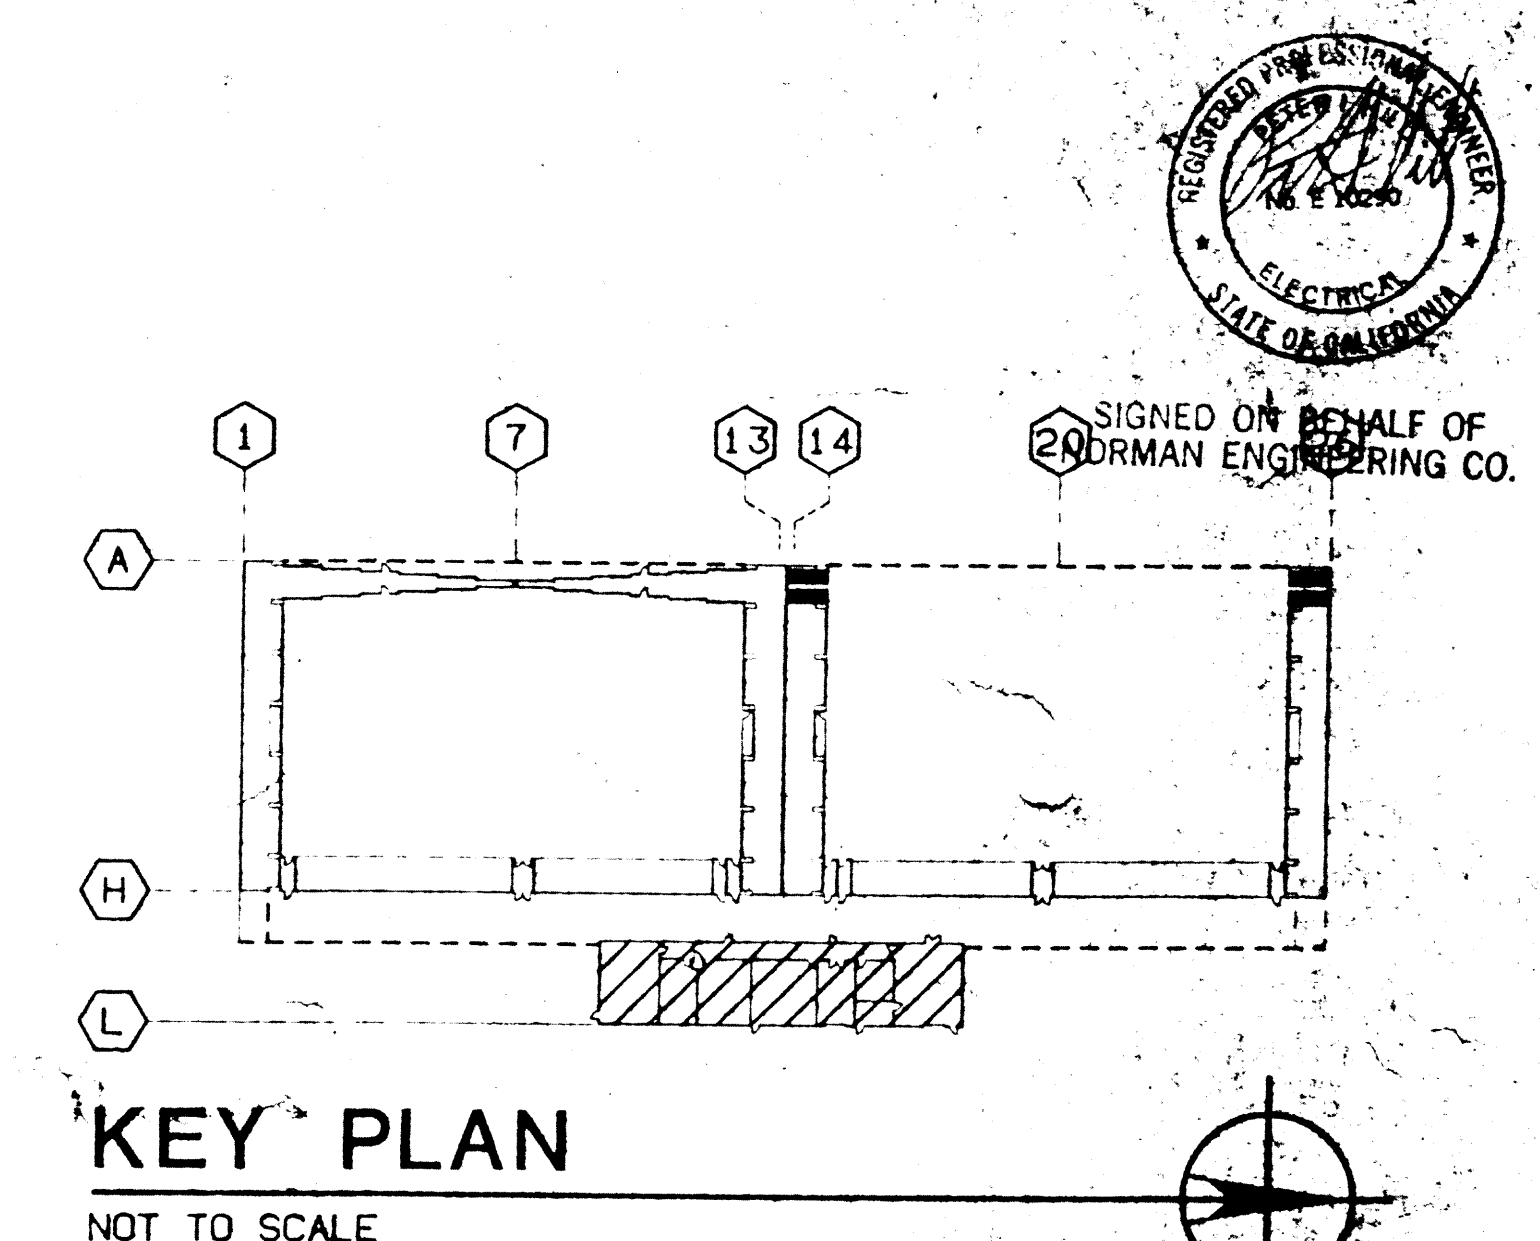


COLLINS ELECTRICAL CO., INC. 4107 Haringgate Blvd. Sacramento, CA 95834 Phone: (916) 567-1100		Record Drawing	
DESIGNED BY R. SHEPARD	CHECKED BY L. MYERS	DATE 9/30/92	PROJECT NO. 100-25-2051
NORMAN ENGINEERING CO. CONSULTING ENGINEERS LOS ANGELES, CALIFORNIA		DEPARTMENT OF THE ARMY SACRAMENTO DISTRICT OFFICE SACRAMENTO, CALIFORNIA	
NEW AIRCRAFT PAINT FACILITY SERVICE BUILDING UPPER FLOOR POWER AND LIGHTING		SHEET E-10 8/2/95	

SAFETY PAYS

NOTES:

1. ALL IDS JUNCTION BOXES, ENCLOSURES, ETC. TO BE TACK-WELDED.
2. CONNECT TO JUNCTION BOX WITH FESTOON CABLE PER MANUFACTURERS REQUIREMENTS.
3. SEE DWG E-20 FOR IDS BLOCK DIAGRAM.
4. EXPLOSION PROOF ROLLER-ARM TYPE LIMIT SWITCH AT UPPER TRACK DOOR. SET TO GENERATE ALARM SIGNAL WHEN LEAD LEAF OF OUTER DOOR MOVES 2" FROM FULLY CLOSED POSITION.

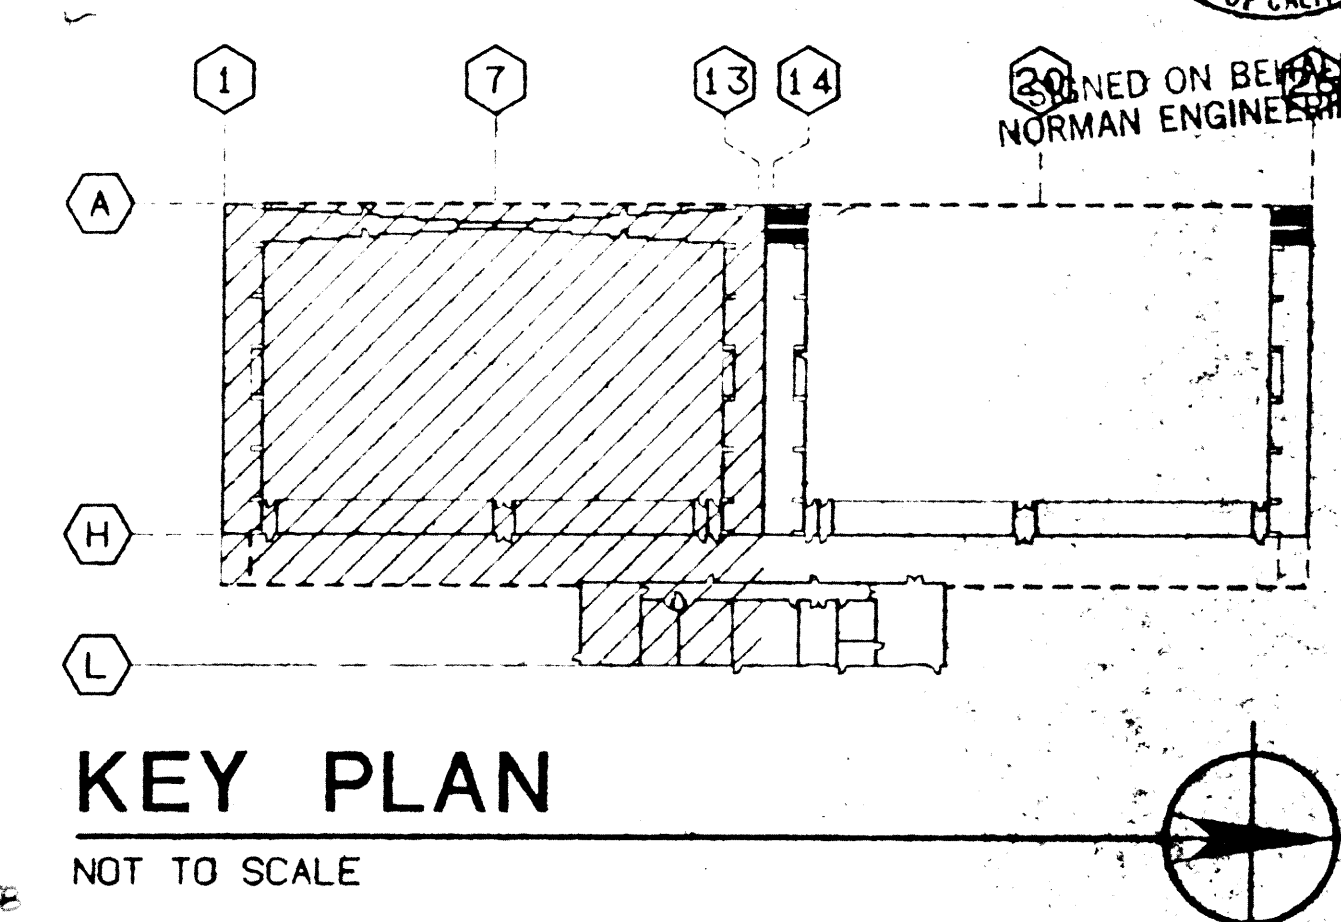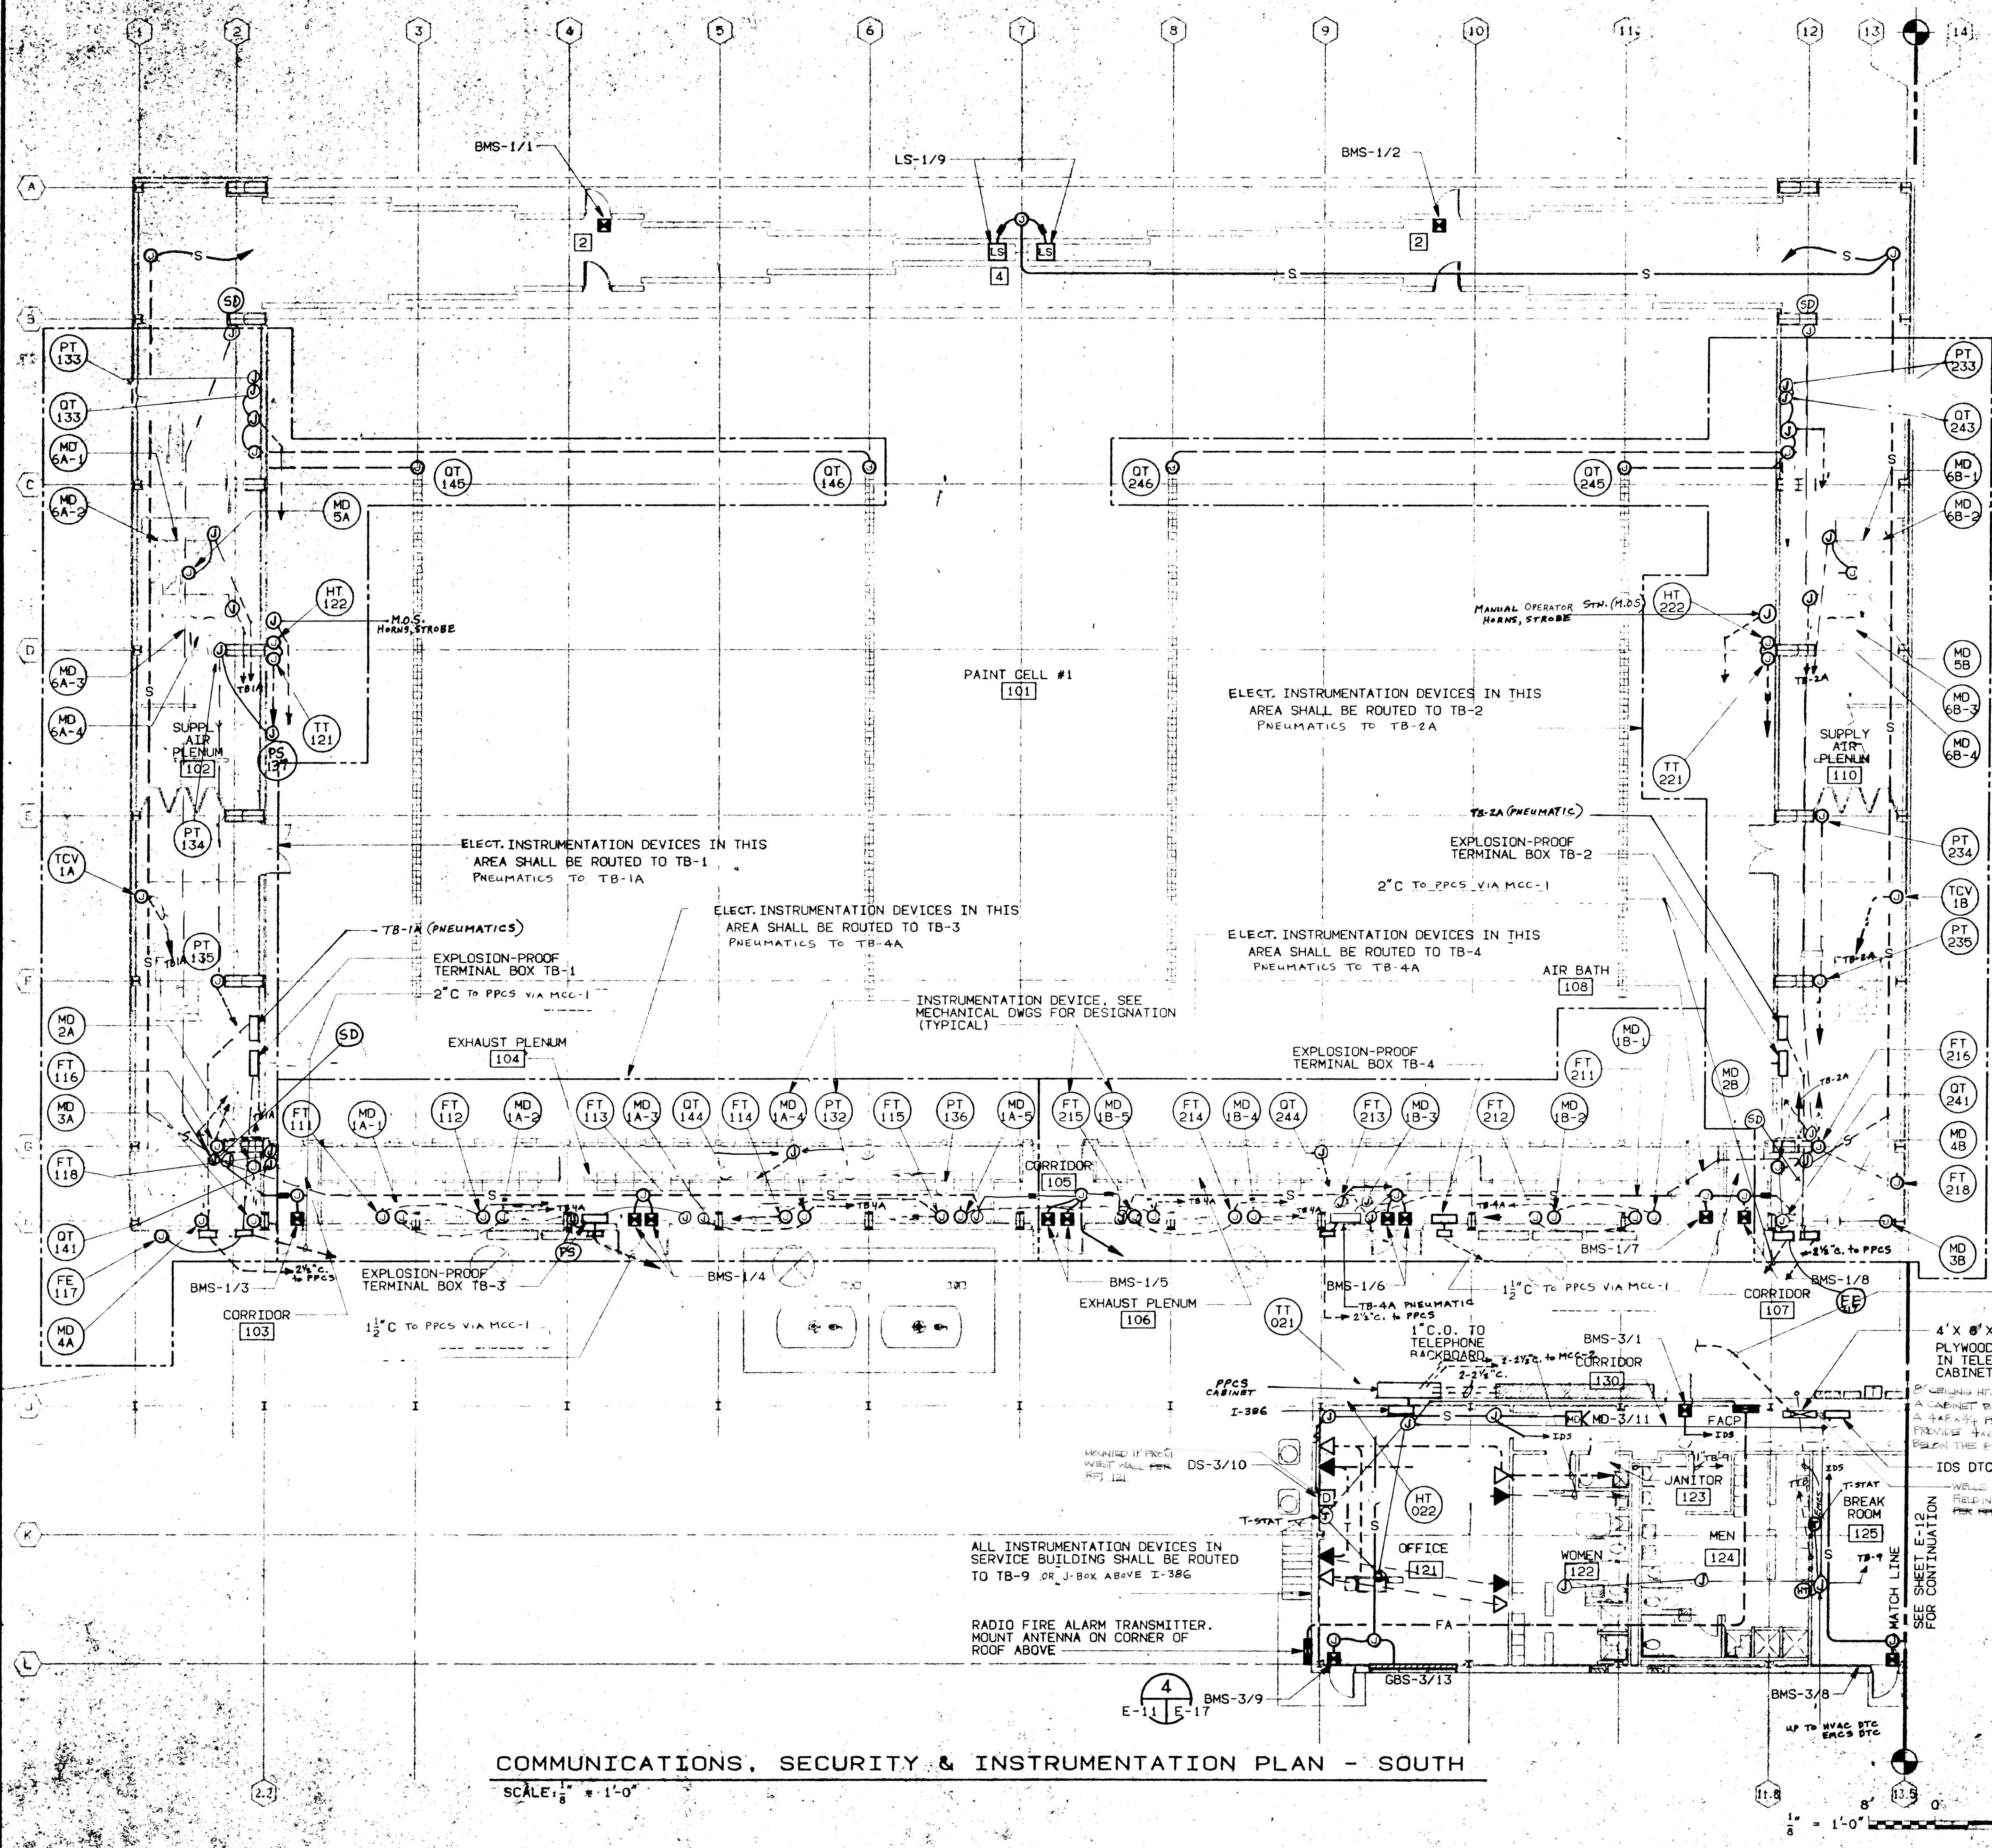


COMMUNICATIONS, SECURITY & INSTRUMENTATION PLAN - SOUTH

SCALE: 1/8" = 1'-0"

NORMAN ENGINEERING CO. CONSULTING ENGINEERS LOS ANGELES, CALIFORNIA		DEPARTMENT OF THE ARMY SACRAMENTO DISTRICT, CORPS OF ENGINEERS SACRAMENTO, CALIFORNIA	
DESIGNED BY R. SHEPARD	DATE 9/30/92	PROJECT ADAL DEPOT CORROSION CONTROL FACILITY NEW AIRCRAFT PAINT PLANT COMMUNICATIONS, SECURITY AND INSTRUMENTATION PLAN	
DRAWN BY R. TAGAYUN	CHECKED BY L. MYERS	SUBMITTED BY J. M. Dwyer	
SHEET E-11		100-28-205	

NOTES:

1. ALL IDS JUNCTION BOXES, ENCLOSURES, ETC. TO BE TACK-WEELDED.
2. CONNECT TO JUNCTION BOX WITH FESTOON CABLE PER MANUFACTURERS REQUIREMENTS. LOCATE ON MANDORS OF EXTERIOR HANGAR DOOR. SIMILAR TO DOORS AS SHOWN ON DWG. E-11.
3. SEE DWG E-20 FOR IDS BLOCK DIAGRAM.
4. SEE NOTE 4 ON DRAWING E-11.

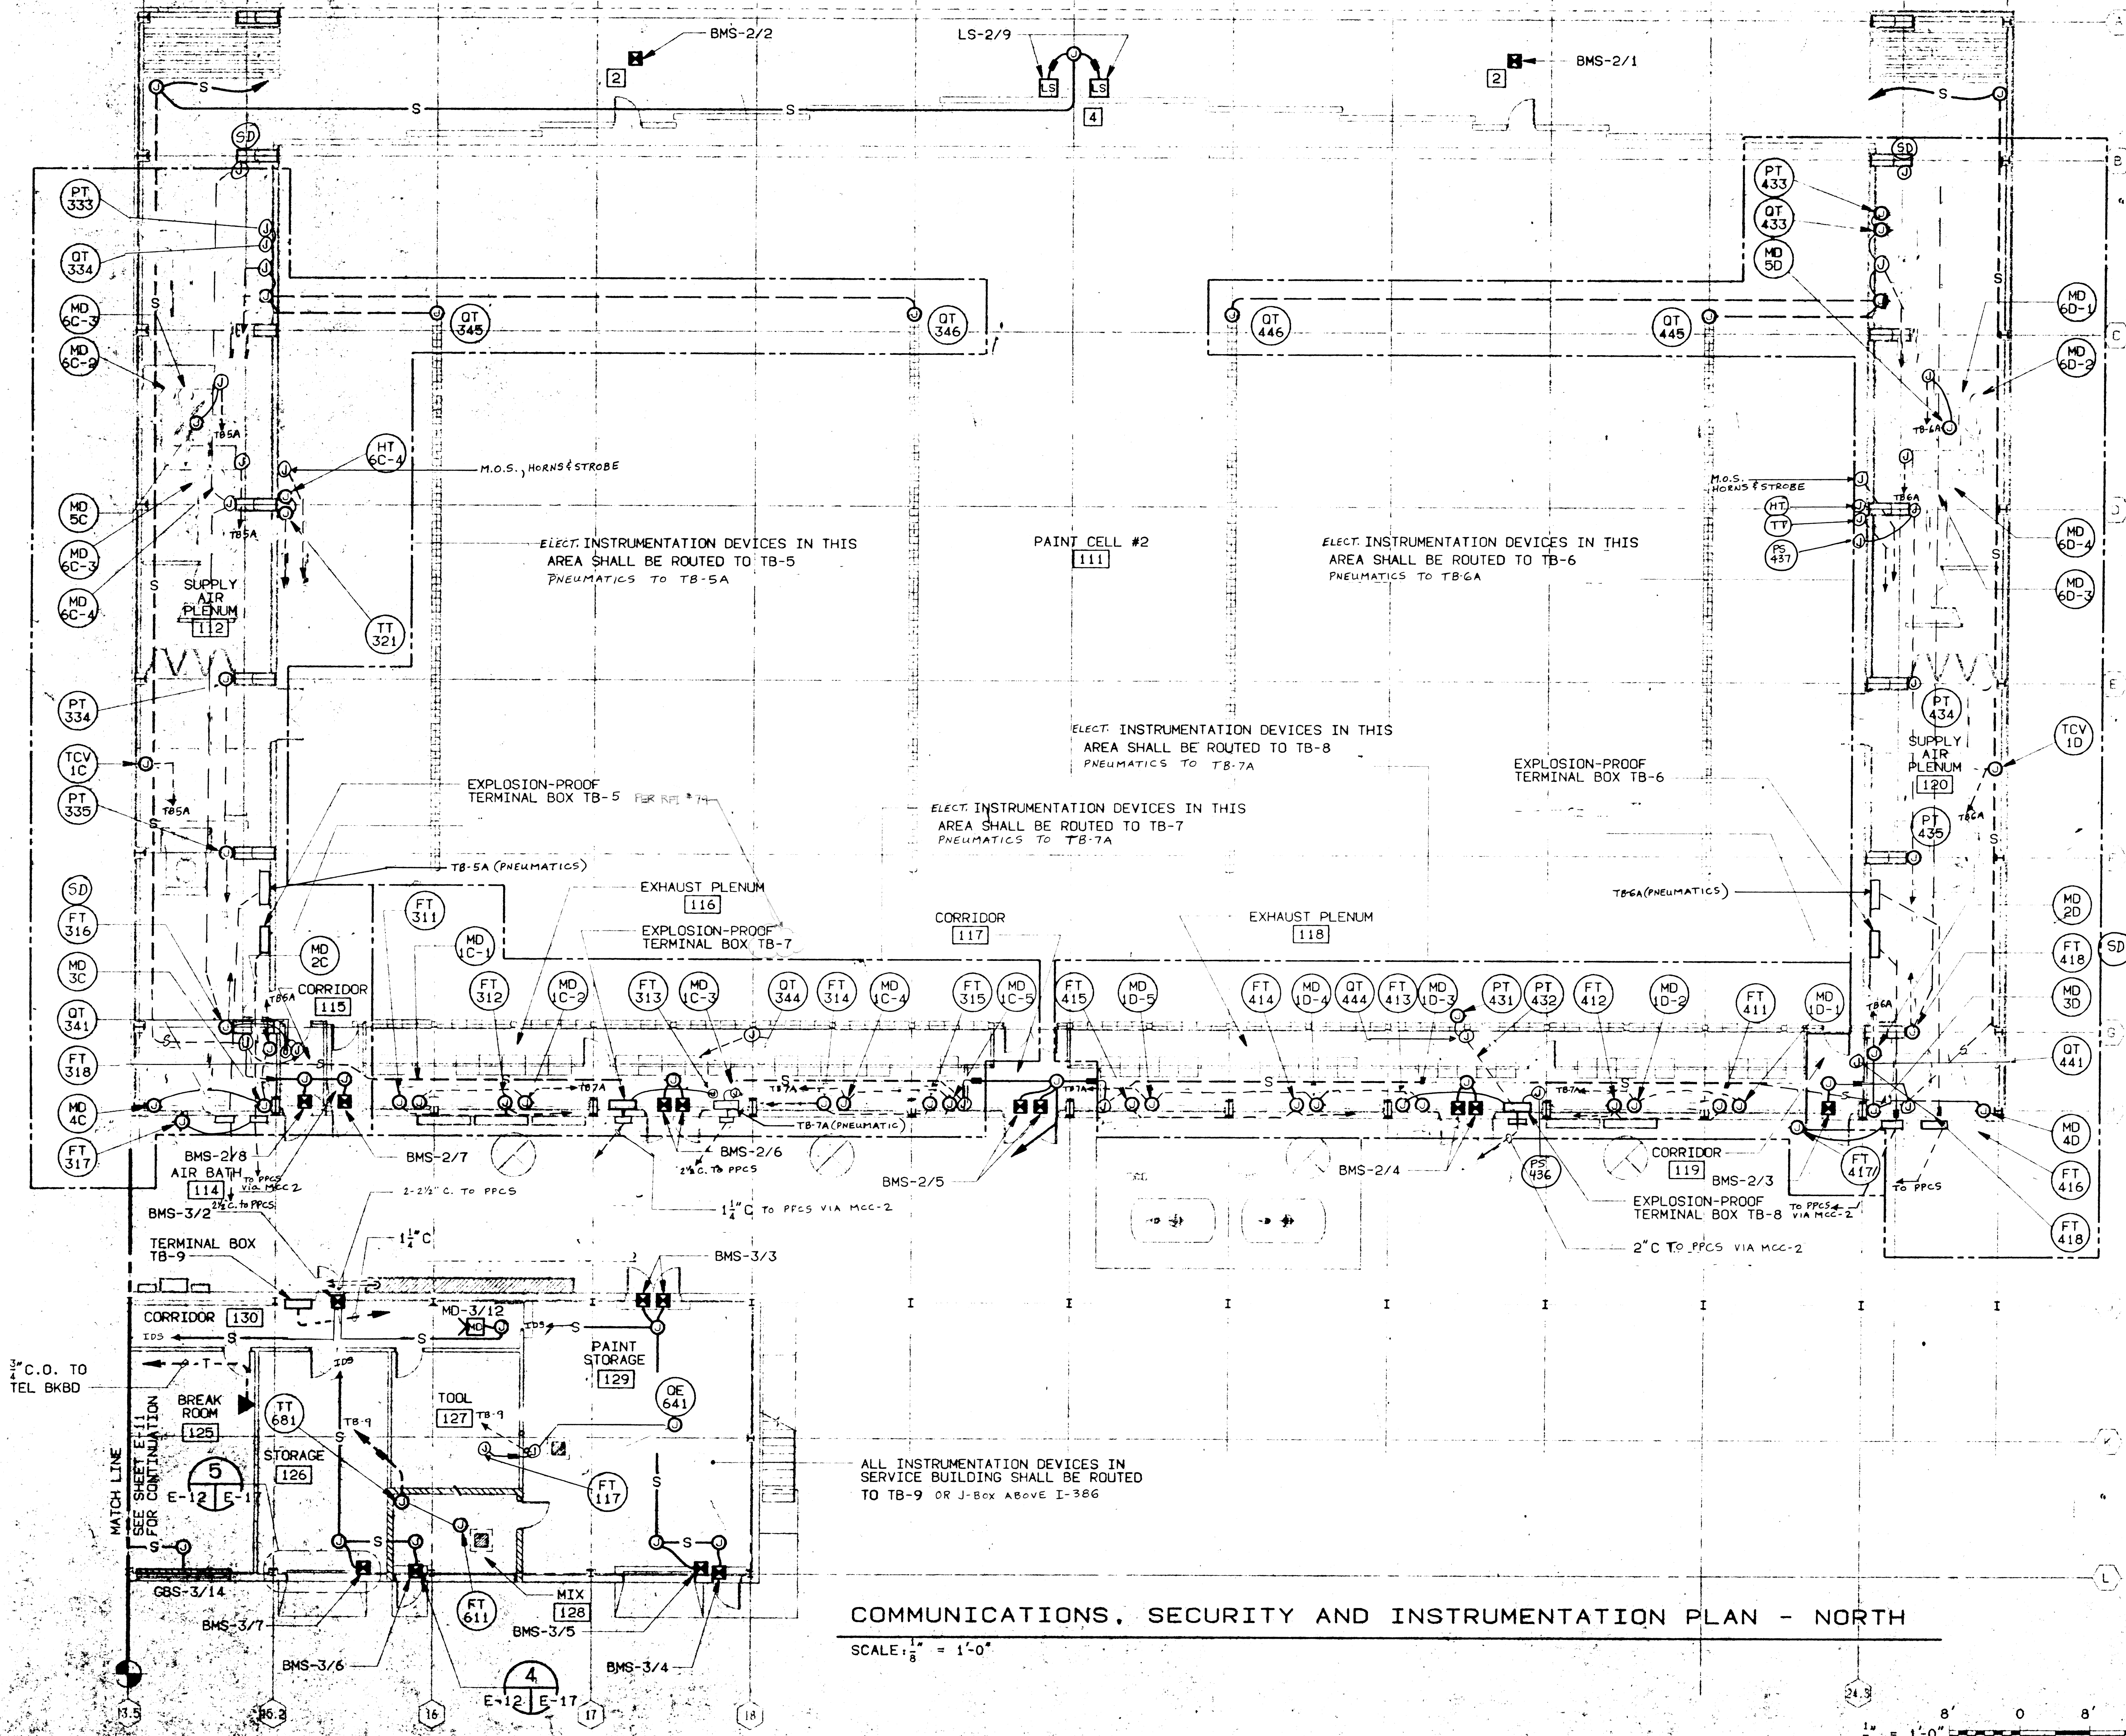


COMMUNICATIONS, SECURITY AND INSTRUMENTATION PLAN - NORTH


SCALE: $\frac{1}{8}$ " = 1'-0"

KEY PLAN

NOT TO SCALE

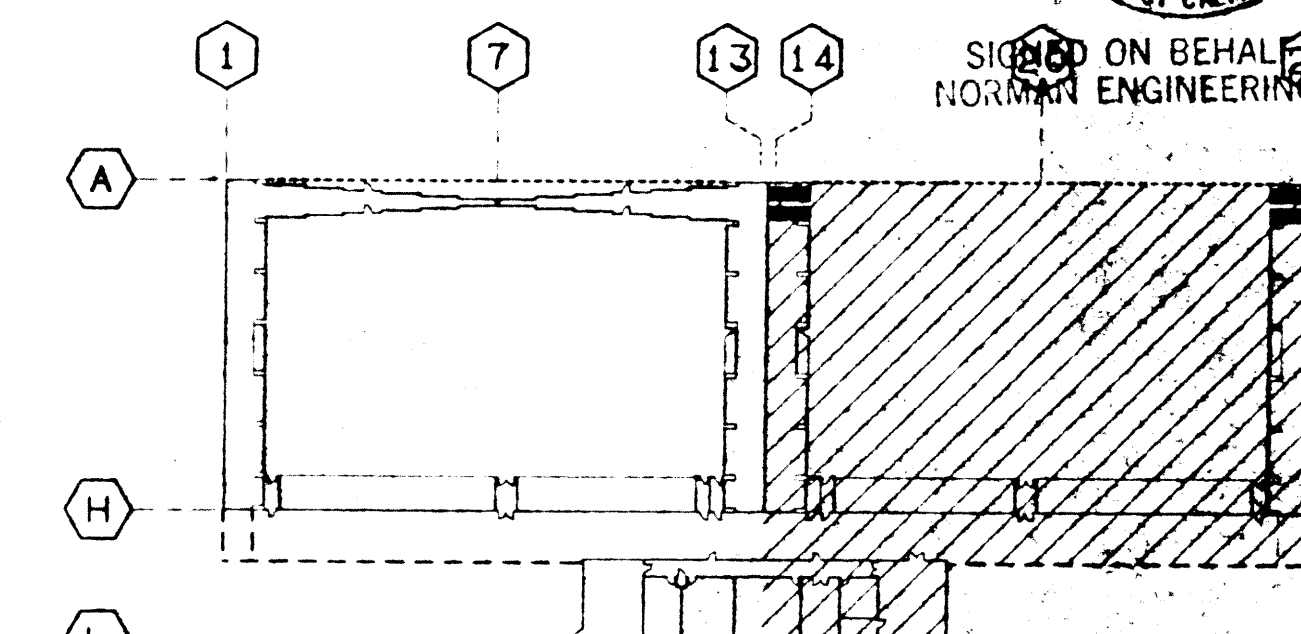

COLLINS ELECTRICAL CO. 4107 Northgate St. Sacramento, CA 95831 Phone: (916) 567-1100		DEPARTMENT OF THE ARMY SACRAMENTO DISTRICT, CORPS OF ENGINEERS SACRAMENTO, CALIFORNIA	
DESIGNED BY R. SHEPARD	PROJECT MCLELLAN AIR FORCE BASE ADAL DEPOT CORROSION CONTROL FACILITY	DRAWN BY R. TAGAYUN	
CHECKED BY L. MYERS	DATE 9/30/92	SUBMITTED BY J. W. [Signature]	
E-12		100-205	

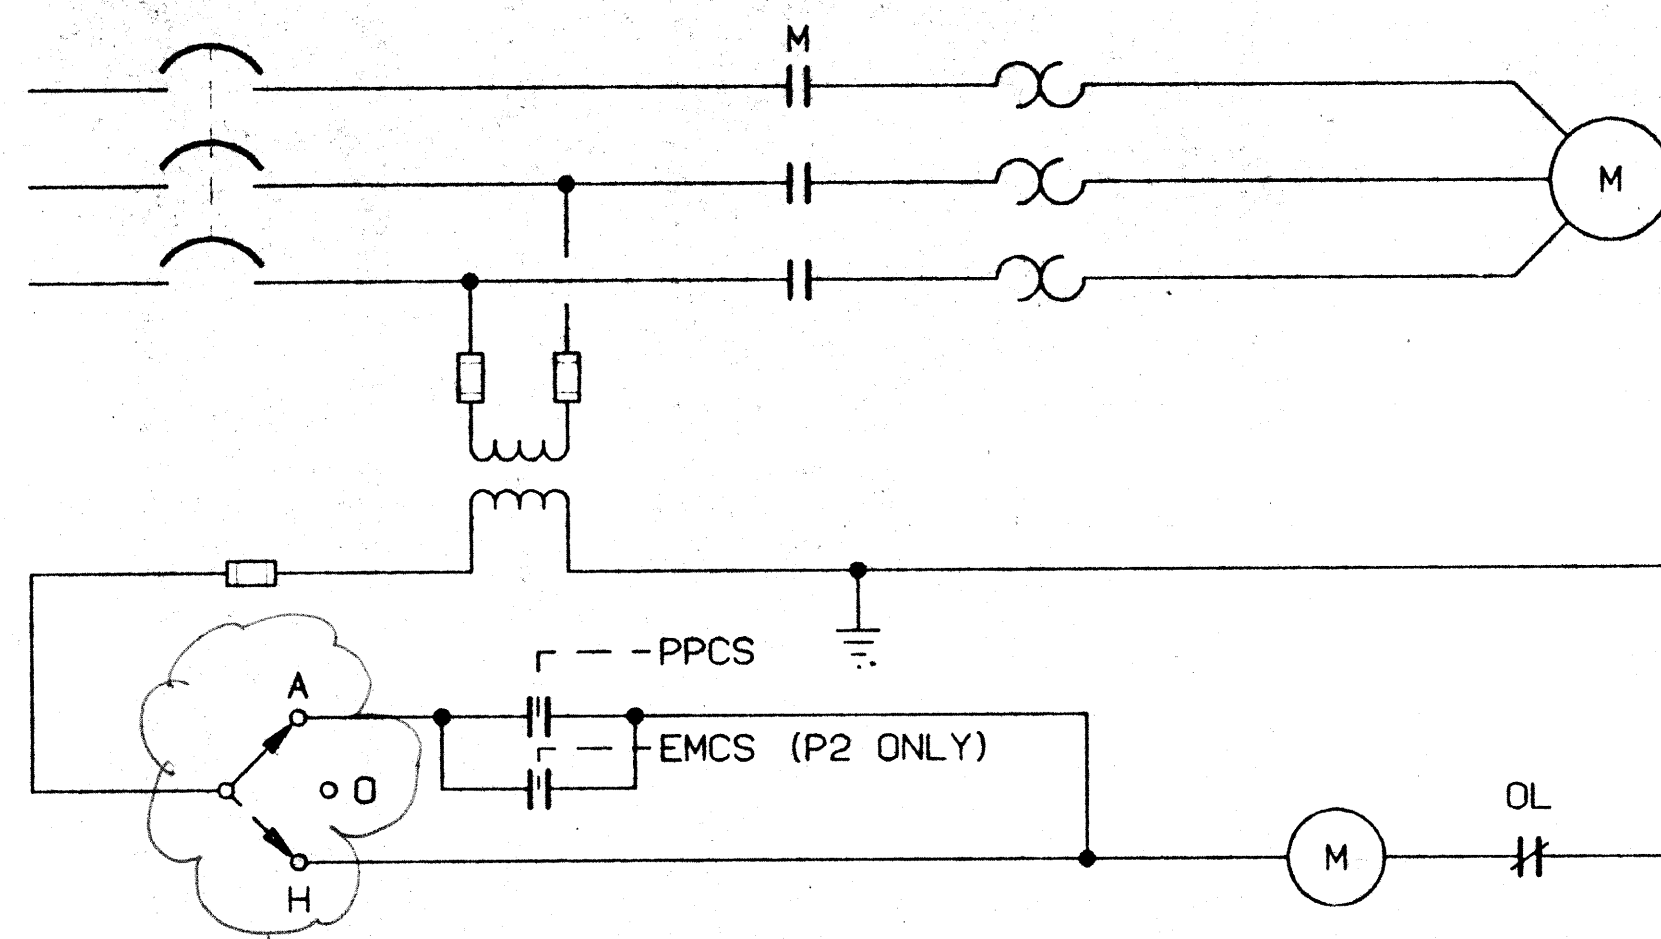


DISABLE HAND MODE
SEE RPT 146
SEE RFP 56

MOTOR	MCC CKT#	PPCS TAG#
EF1A	MCC1, #1	071
EF1B	MCC1, #2	072
EF1C	MCC1, #3	073
EF1D	MCC1, #4	074
EF1E	MCC1, #5	075
EF1F	MCC1, #6	076
EF1G	MCC1, #7	077
EF1H	MCC1, #8	078
P1A	MCC1, #9	561
P1B	MCC1, #10	562
P2	MCC1, #11	563
EC1A	MCC1, #12	161
EC1A	MCC1, #13	161
EC1A	MCC1, #14	161
EC1A	MCC1, #15	161
EC1B	MCC1, #16	261
EC1B	MCC1, #17	261
EC1B	MCC1, #18	261
EC1B	MCC1, #19	261
SF3A	MCC2, #1	081
SF3B	MCC2, #2	082
SF3C	MCC2, #3	083
SF3D	MCC2, #6	084
SF3E	MCC2, #7	085
SF3F	MCC2, #8	086
EF7	MCC2, #11	061
EF8	MCC2, #12	062
EC2A	MCC2, #13	361
EC2A	MCC2, #14	361
EC2A	MCC2, #15	361
EC2A	MCC2, #16	361
EC2B	MCC2, #17	461
EC2B	MCC2, #18	461
EC2B	MCC2, #19	461
EC2B	MCC2, #20	461
EF5	MCC2, #21	681
ECU1	MCC2, #23	683

SEE T.N.B. CONTROL DRNGS.

480V-3Ø NON-REVERSING MOTOR

SCALE: NONE

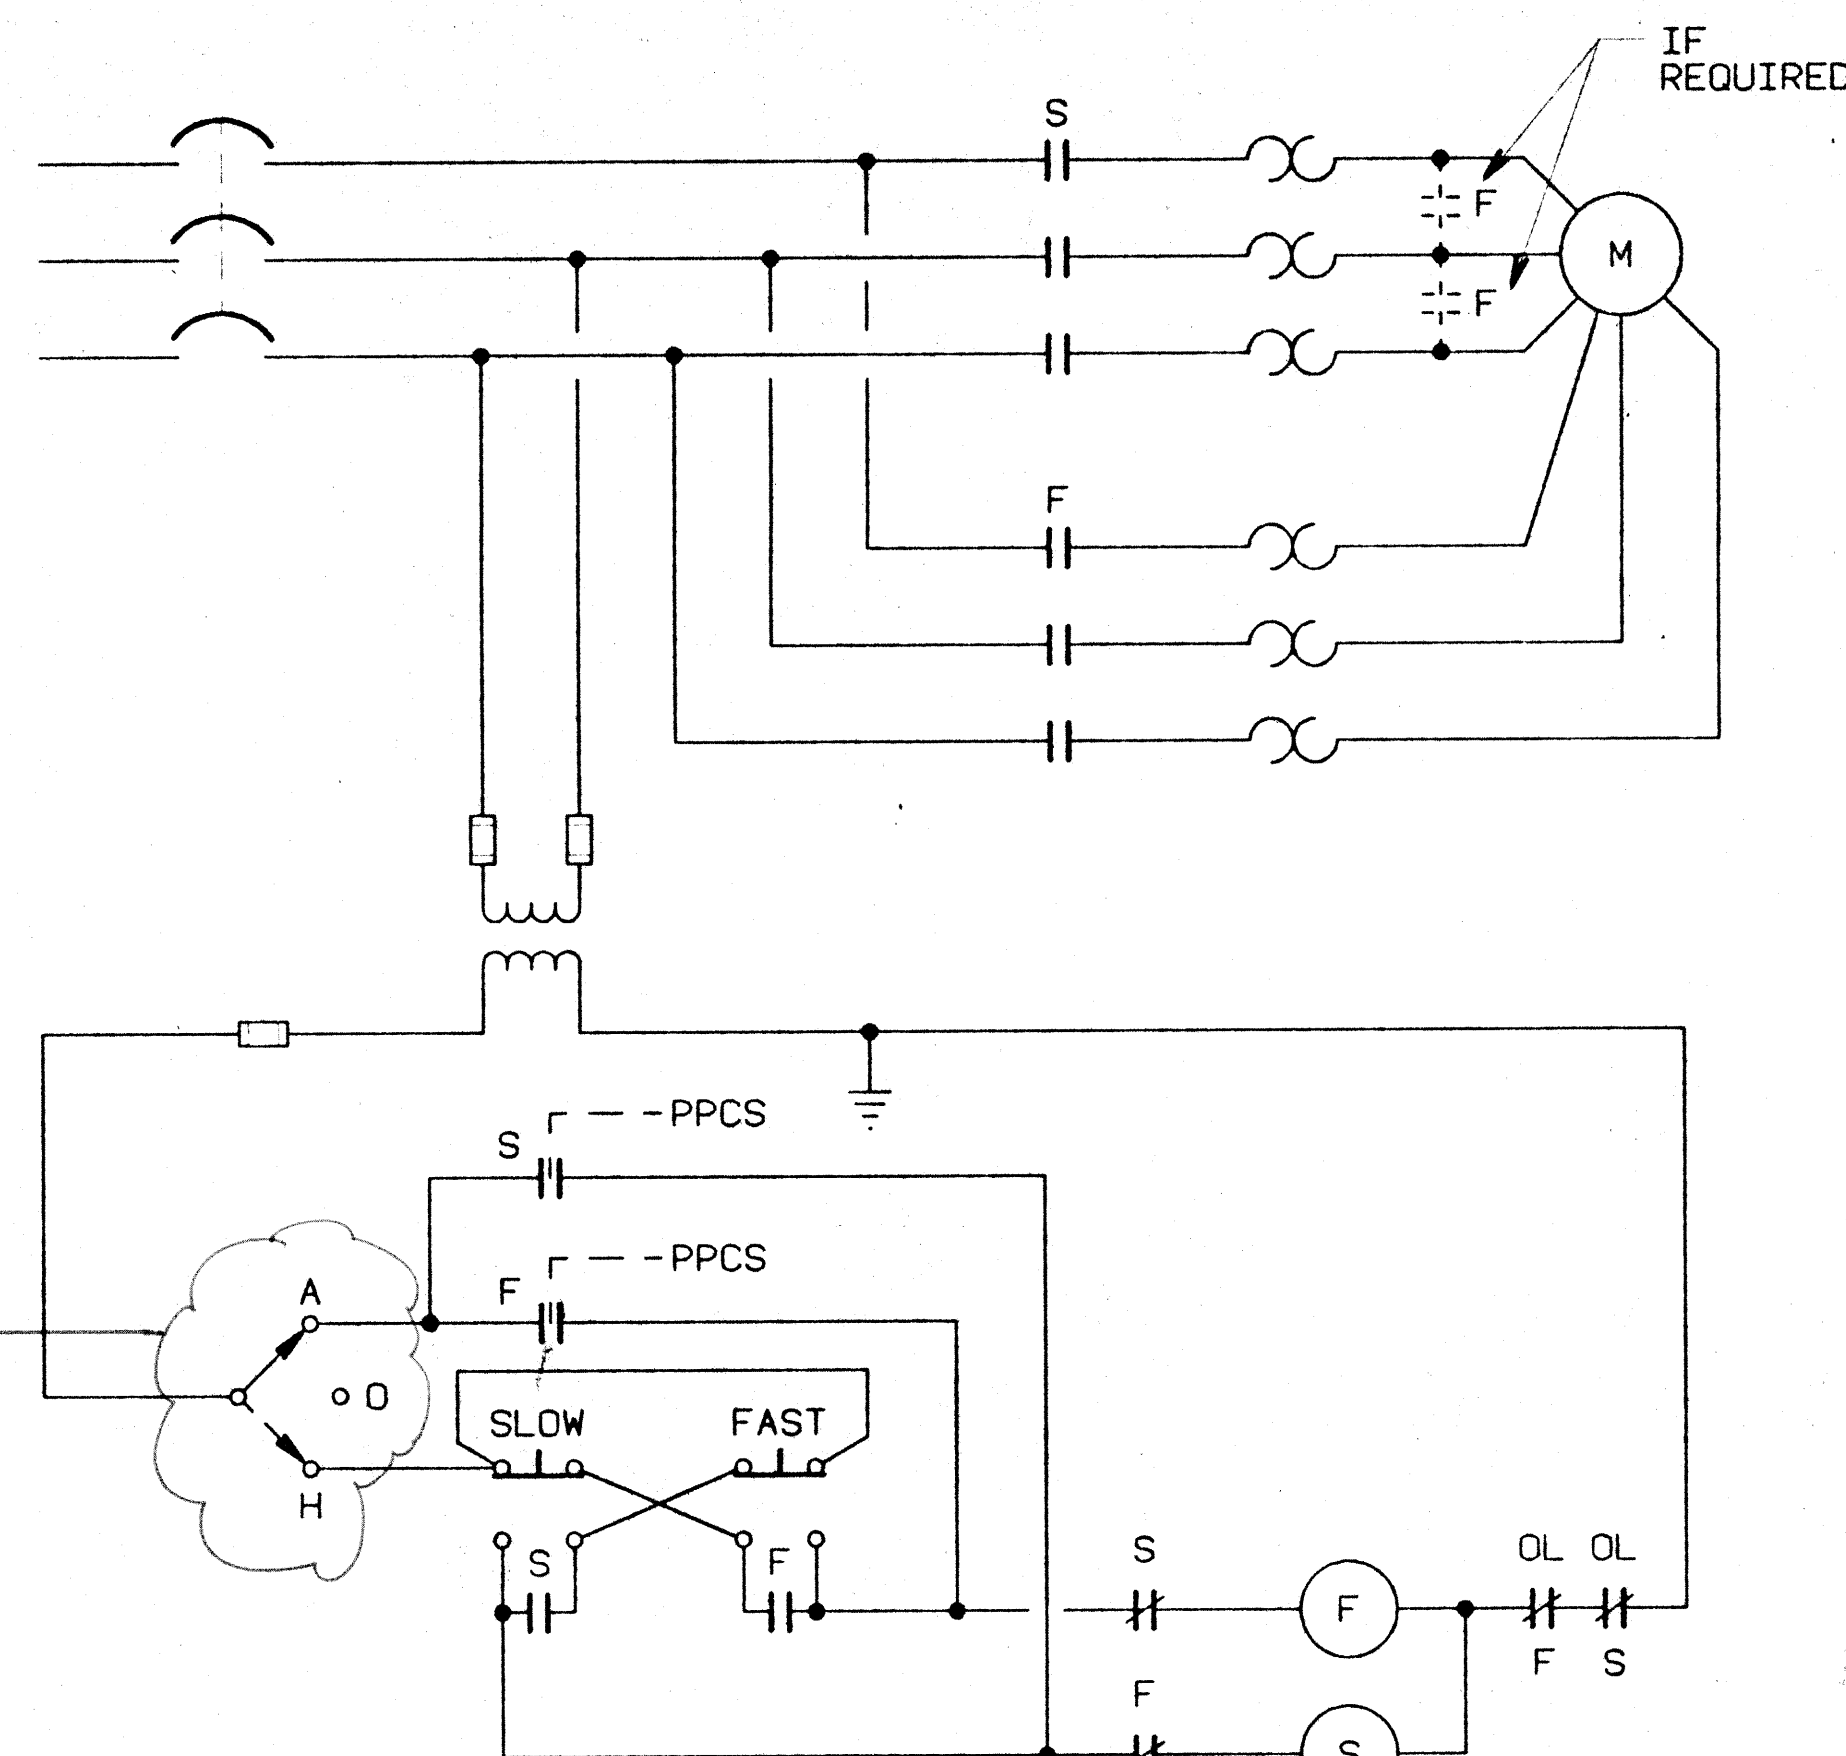


MOTOR	MCC CKT#	PPCS TAG# (SLOW)	PPCS TAG# (FAST)
SF1A	MCC2, #4	181	182
SF1B	MCC2, #5	281	282
SF2A	MCC2, #9	381	382
SF2B	MCC2, #10	481	482

NOT A - SEE CONTROL DRNGS.

480V-3Ø TWO-SPEED NON-REVERSING MOTOR


SCALE: NONE

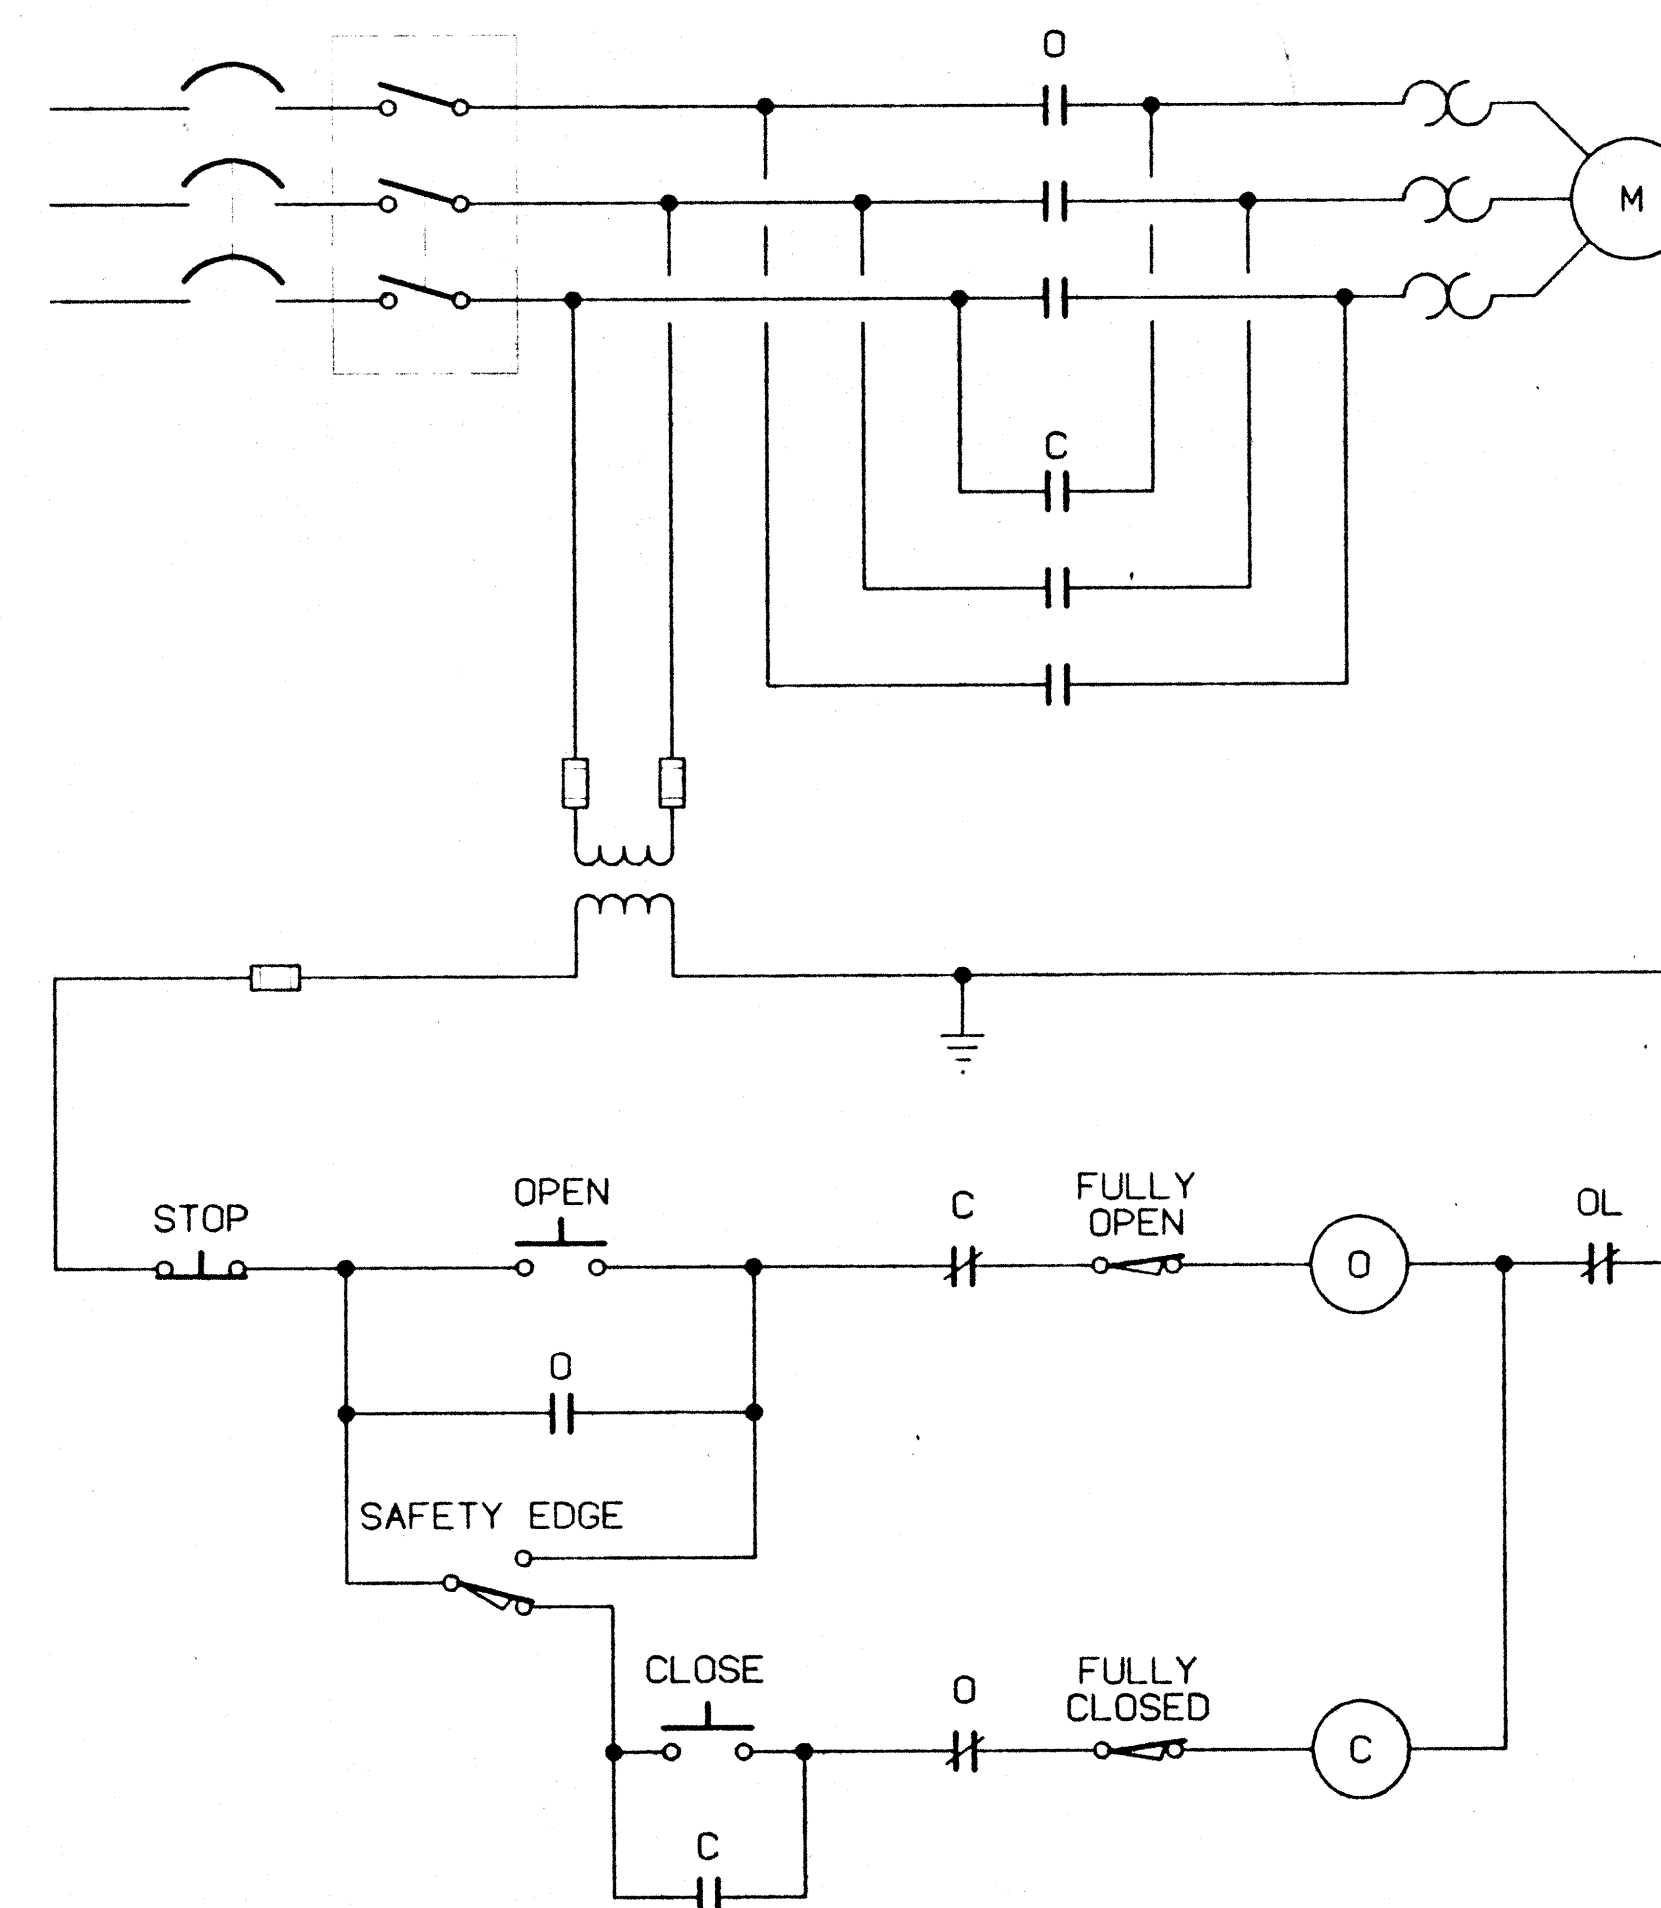

480V-3Ø ROLL-UP DOOR MOTOR

SCALE: NONE

(TYP FOR DOORS #140 & #142)

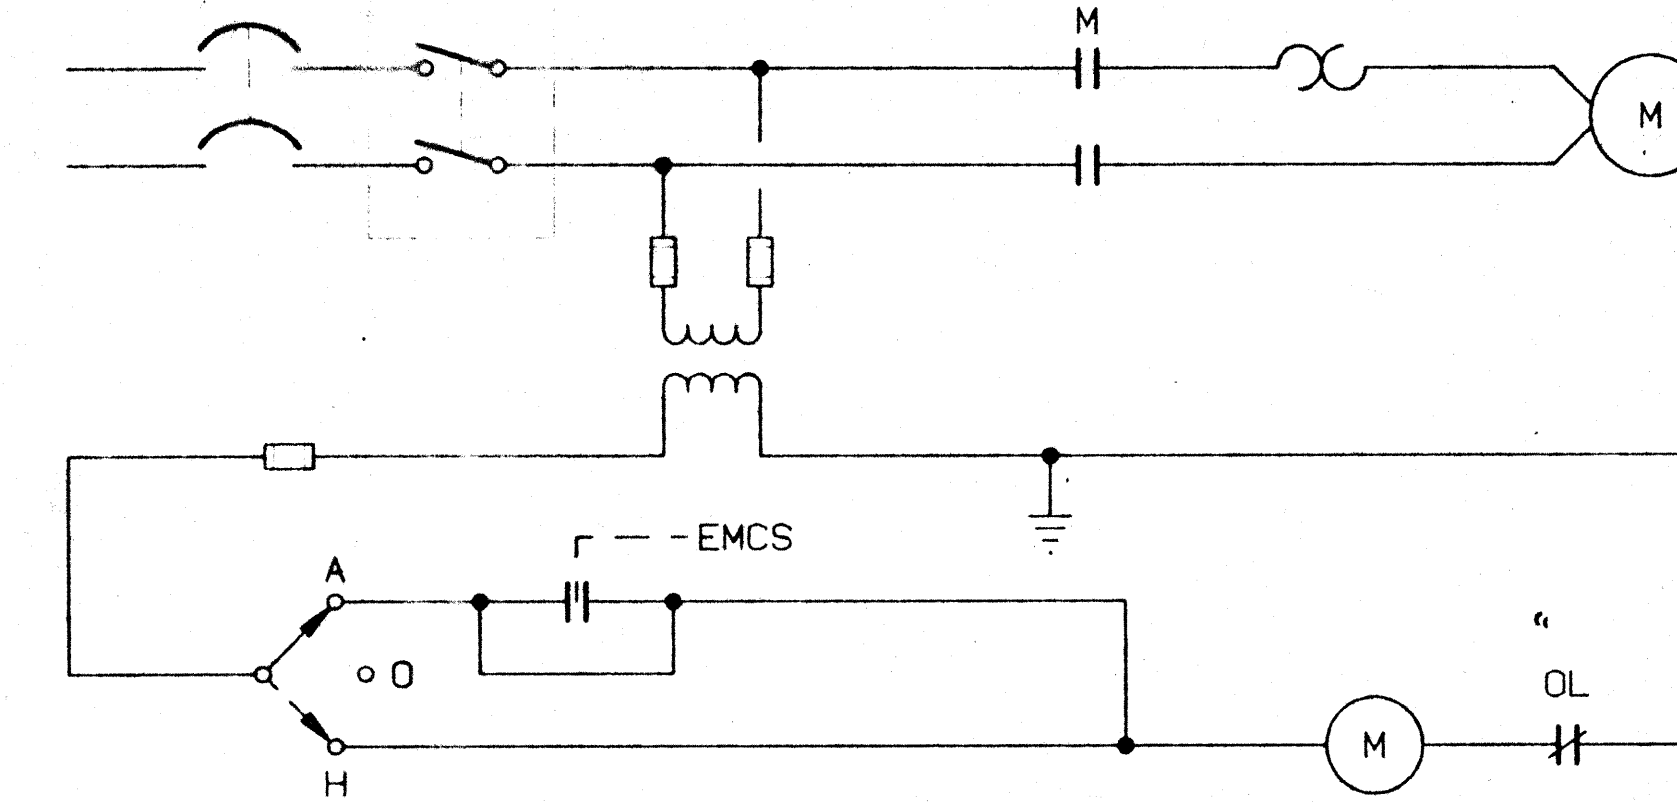


MOTOR	PNL CKT#
FCU-1	PP1-9, 11
FCU-2	PP2-26, 28 PP1-13, 15

Both circuits for units FCU-1 and FCU-2 should be fed from the one (1) 20A/2P circuit breaker in panel PP1, circuits 9 and 11 shown on sheet E-15. The two circuits should be spliced together in panel PP1 and then 2x#14 AWG from the splice should be run to the 20A/2P circuit breaker. RET# 23

208V-1Ø NON-REVERSING MOTOR

SCALE: NONE

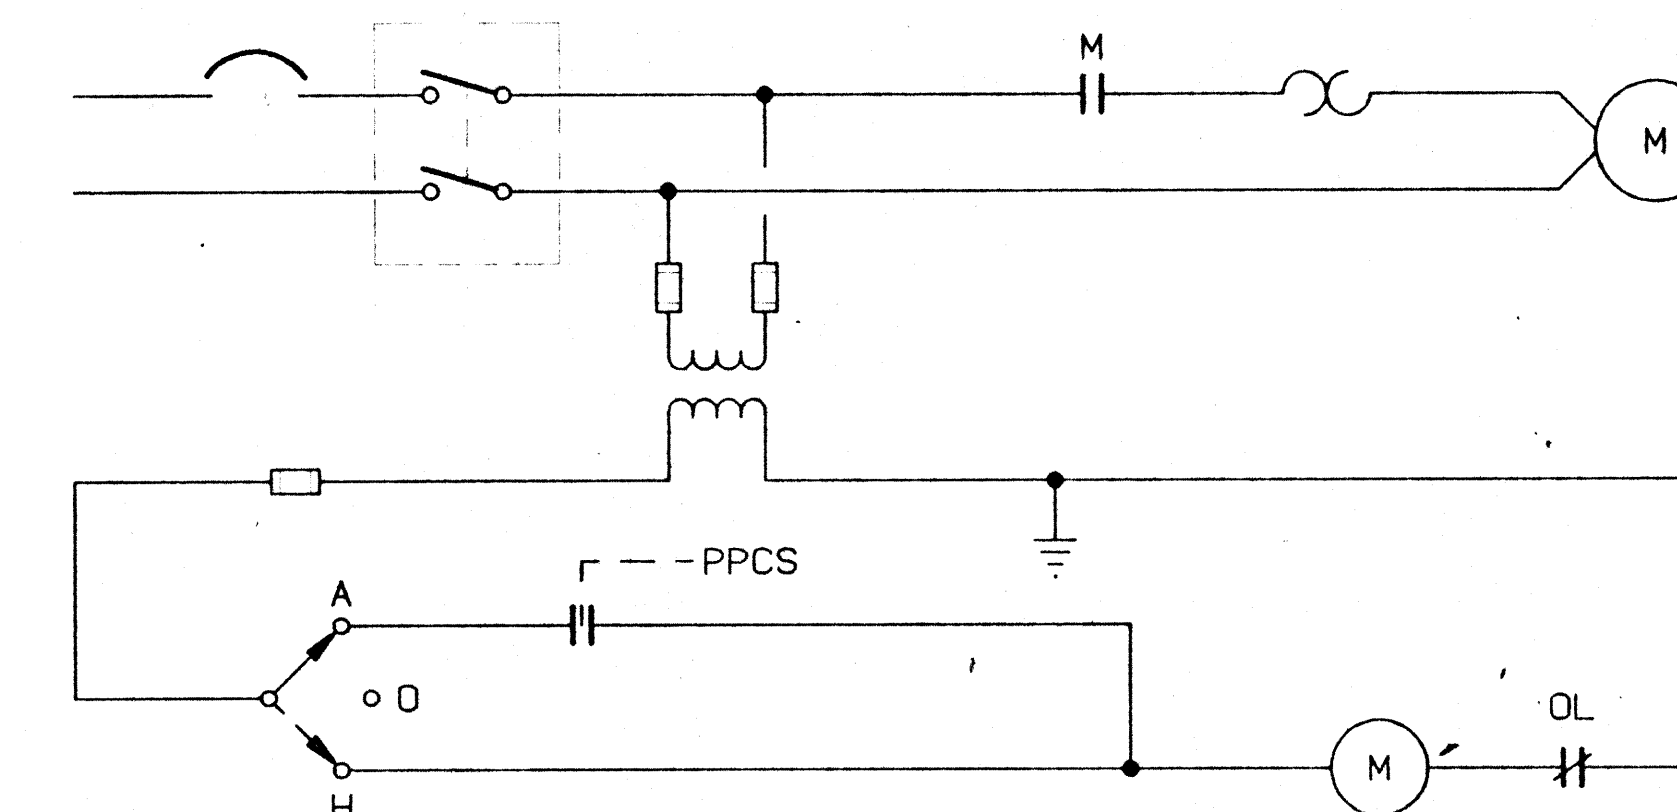


MOTOR	PNL CKT#	PPCS TAG#
EF-4	PP1-25	682
EF-6	PP1-27	884

NOT A - SEE CONTROL DRNGS.


120V-1Ø NON-REVERSING MOTOR

SCALE: NONE

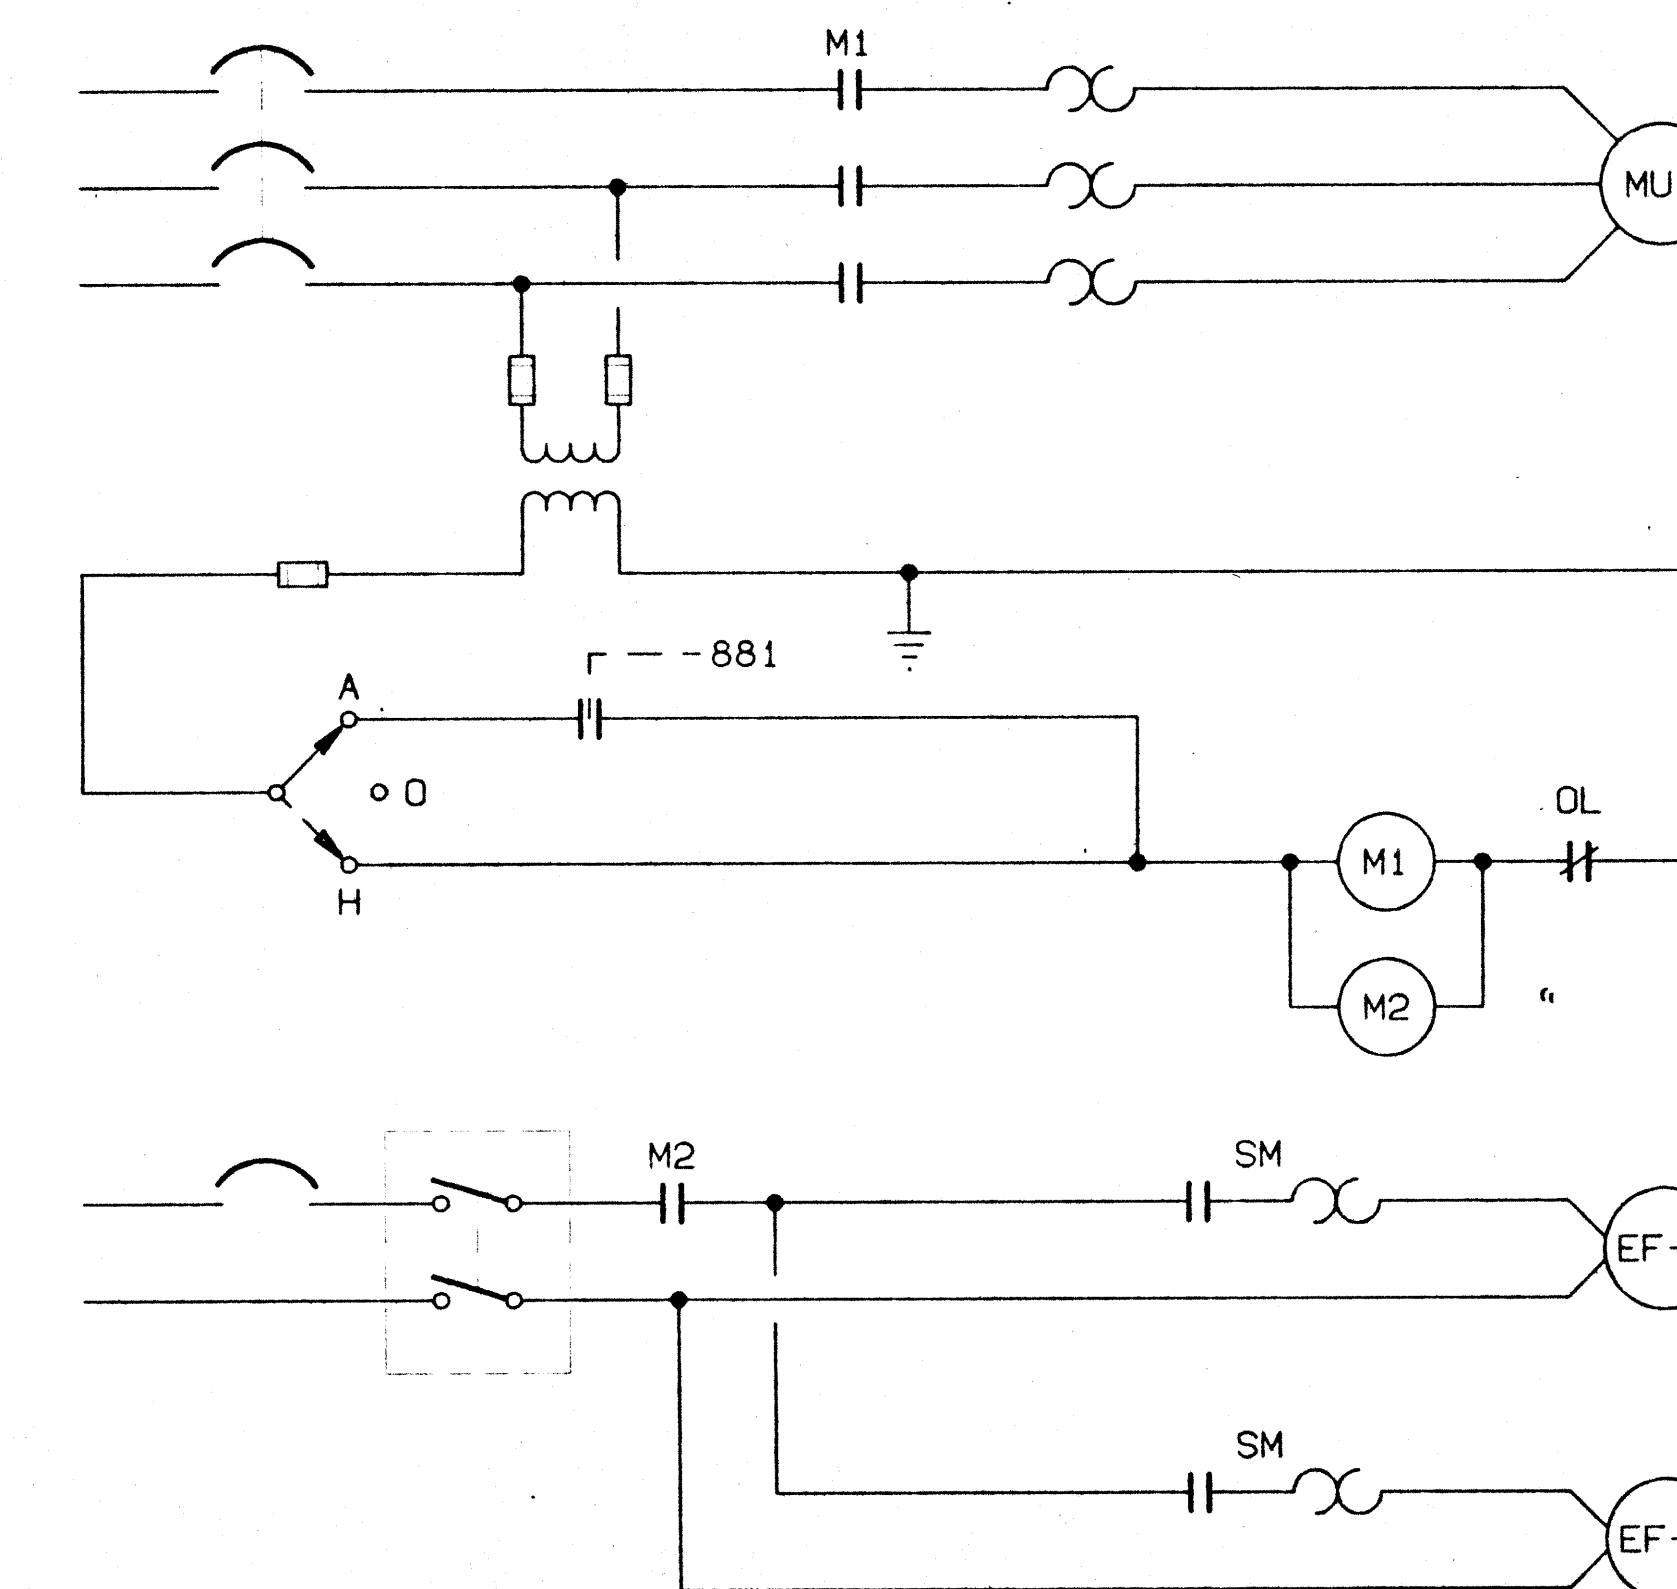

INTERLOCK OF MU1 WITH EF-2 & EF-3

SCALE: NONE

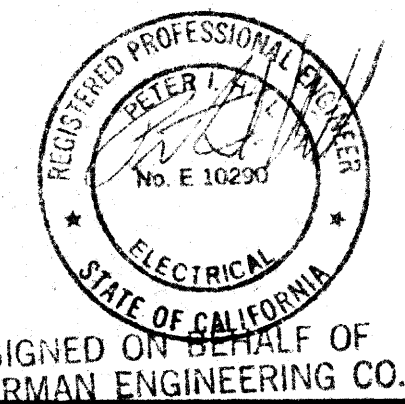

SIGNED ON BEHALF OF
NORMAN ENGINEERING CO.

REVISION	DATE	DESCRIPTION	BY

NORMAN ENGINEERING CO. CONSULTING ENGINEERS LOS ANGELES, CALIFORNIA		DEPARTMENT OF THE ARMY SACRAMENTO DISTRICT, CORPS OF ENGINEERS SACRAMENTO, CALIFORNIA	
DESIGNED BY R. SHEPARD	MCCLELLAN AIR FORCE BASE CALIFORNIA		
DRAWN BY R. TAGAYUN	ADAL DEPOT CORROSION CONTROL FACILITY NEW AIRCRAFT PAINT FACILITY		
CHECKED BY L. MYERS	CONTROL DIAGRAMS - 1		
SUBMITTED	DATE 9/30/92	SCALE NONE	SPEC No. 8529
SHEET E-13 85 OF 95		FILE No. 100-25-2051	

FUNCTIONAL ANALYSIS - VE PAYS

CONDUIT AND WIRE SCHEDULE

REV NO	CONDUIT NO	SERVICE	LOAD HP, FLA OR KVA	VOLTS	FROM	TO	CONDUIT SIZE	CONDUCTORS QUANTITY AND SIZE	GROUND	REFERENCE DRAWING NUMBER	REMARKS
1		NEW DIST FEEDER BS-4	400A	12.4KV	BELL AVE. SUBST	SS-708	2 1/2" RFI #10	3#500MCM	1#1/0	E-3,4,17,18	VIA EXIST DUCT BANK & MANHOLES
2		TAP TO LOADCENTER A	155A	12.4KV	SS-708	LOADCENTER A	4"	3#1/0	1#6	E-3,4,17	
3		MOTOR CONTROL CENTER MCC1	2000A	480	LOADCENTER A	MCC1	4"	3#750MCM	1#250MCM	E-3,4,8,17,18	
4		MOTOR CONTROL CENTER MCC1	2000A	480	LOADCENTER A	MCC1	4"	3#750MCM	1#250MCM	E-3,4,8,17,18	
5		MOTOR CONTROL CENTER MCC1	2000A	480	LOADCENTER A	MCC1	4"	3#750MCM	1#250MCM	E-3,4,8,17,18	
6		MOTOR CONTROL CENTER MCC1	2000A	480	LOADCENTER A	MCC1	4"	3#750MCM	1#250MCM	E-3,4,8,17,18	
7		MOTOR CONTROL CENTER MCC1	2000A	480	LOADCENTER A	MCC1	4"	3#750MCM	1#250MCM	E-3,4,8,17,18	
8		MOTOR CONTROL CENTER MCC2	2000A	480	LOADCENTER A	MCC2	4"	3#750MCM	1#250MCM	E-3,4,9,17,18	
9		MOTOR CONTROL CENTER MCC2	2000A	480	LOADCENTER A	MCC2	4"	3#750MCM	1#250MCM	E-3,4,9,17,18	
10		MOTOR CONTROL CENTER MCC2	2000A	480	LOADCENTER A	MCC2	4"	3#750MCM	1#250MCM	E-3,4,9,17,18	
11		MOTOR CONTROL CENTER MCC2	2000A	480	LOADCENTER A	MCC2	4"	3#750MCM	1#250MCM	E-3,4,9,17,18	
12		MOTOR CONTROL CENTER MCC2	2000A	480	LOADCENTER A	MCC2	4"	3#750MCM	1#250MCM	E-3,4,9,17,18	
13		DISTRIBUTION PANEL DP1	600A	480	LOADCENTER A	DP1	4"	3#350MCM	1#1	E-3,4,8,17,18	
14		DISTRIBUTION PANEL DP1	600A	480	LOADCENTER A	DP1	4"	3#350MCM	1#1	E-3,4,8,17,18	
15		TELEPHONE	N/A	N/A	EXIST. POLE	BACKBOARD	4"	PULLWIRE	-	E-4,11,17	
16		EXHAUST FAN EF1A	150HP	480	MCC1	EF1A	2"	3#4/0	1#2	E-3,8,18	
17		EXHAUST FAN EF1B	150HP	480	MCC1	EF1B	2"	3#4/0	1#2	E-3,8,18	
18		EXHAUST FAN EF1C	150HP	480	MCC1	EF1C	2"	3#4/0	1#2	E-3,8,18	
19		EXHAUST FAN EF1D	150HP	480	MCC1	EF1D	2"	3#4/0	1#2	E-3,8,18	
20		SUPPLY FAN SF3A	125HP	480	MCC2	SF3A	2"	3#3/0	1#4	E-3,10,18	
21		SUPPLY FAN SF3B	125HP	480	MCC2	SF3B	2"	3#3/0	1#4	E-3,10,18	
22		SUPPLY FAN SF3C	125HP	480	MCC2	SF3C	2"	3#3/0	1#4	E-3,10,18	
23		SUPPLY FAN SF1A	125HP	480	MCC2	SF1A	2"	3#3/0 RFI #14	1#4	E-3,8,18	
24		SUPPLY FAN SF1B	125HP	480	MCC2	SF1B	2"	3#3/0 RFI #14	1#4	E-3,8,18	
25		PUMP P1A	20HP	480	MCC1	P1A	3/4"	3#10 SEE ALSO	1#10	E-3,8,18	
26		PUMP P1B	20HP	480	MCC1	P1B	3/4"	3#10 RFI 185	1#10	E-3,8,18	
27		PUMP P2	3HP	480	MCC1	P2	3/4"	3#12	1#12	E-3,8,18	
28		EVAPORATIVE COOLER EC1A	1HP	480	MCC1	EC1A	3/4"	3#12	1#12	E-3,8,18	
29		EVAPORATIVE COOLER EC1A	1HP	480	MCC1	EC1A	3/4"	3#12	1#12	E-3,8,18	
30		EVAPORATIVE COOLER EC1A	1HP	480	MCC1	EC1A	3/4"	3#12	1#12	E-3,8,18	
31		EVAPORATIVE COOLER EC1A	1HP	480	MCC1	EC1A	3/4"	3#12	1#12	E-3,8,18	
32		EVAPORATIVE COOLER EC1B	1HP	480	MCC1	EC1B	3/4"	3#12	1#12	E-3,8,18	
33		EVAPORATIVE COOLER EC1B	1HP	480	MCC1	EC1B	3/4"	3#12	1#12	E-3,8,18	
34		EVAPORATIVE COOLER EC1B	1HP	480	MCC1	EC1B	3/4"	3#12	1#12	E-3,8,18	
35		EVAPORATIVE COOLER EC1B	1HP	480	MCC1	EC1B	3/4"	3#12	1#12	E-3,8,18	
36		IW LIFT STATION	2x1/2HP	480	DP1	LIFT STATION	1"	3#12	1#12	E-3,4,18	
37		WATER HEATER T-5	45 KW	480	DP1	T-5	1"	3#4	1#8	E-3,10,18	
38		VOC MONITORING	N/A	-	OT-142,442	MCC-2	1"	2-PR #18 SHIELDED	1#12	E-4,18	
39		EXHAUST FAN EF1E	150HP	480	MCC1	EF1E	2"	3#4/0	1#2	E-3,9,18	
40		EXHAUST FAN EF1F	150HP	480	MCC1	EF1F	2"	3#4/0	1#2	E-3,9,18	
41		EXHAUST FAN EF1G	150HP	480	MCC1	EF1G	2"	3#4/0	1#2	E-3,9,18	
42		EXHAUST FAN EF1H	150HP	480	MCC1	EF1H	2"	3#4/0	1#2	E-3,9,18	
43		SUPPLY FAN SF3D	125HP	480	MCC2	SF3D	2"	3#3/0	1#4	E-3,10,18	
44		SUPPLY FAN SF3E	125HP	480	MCC2	SF3E	2"	3#3/0	1#4	E-3,10,18	
45		SUPPLY FAN SF3F	125HP	480	MCC2	SF3F	2"	3#3/0	1#4	E-3,10,18	
46		SUPPLY FAN SF2A	125HP	480	MCC2	SF2A	2"	3#3/0 RFI 141	1#4	E-3,9,18	
47		SUPPLY FAN SF2B	125HP	480	MCC2	SF2B	2"	3#3/0 RFI 141	1#4	E-3,9,18	
48		EXHAUST FAN EF7	5HP	480	MCC2	EF7	3/4"	3#12 SEE RFI 185	1#12	E-3,4,18	
49		EXHAUST FAN EF8	5HP	480	MCC2	EF8	3/4"	3#12	1#12	E-3,9,18	
50		EVAPORATIVE COOLER EC2A	1HP	480	MCC2	EC2A	3/4"	3#12	1#12	E-3,9,18	
51		EVAPORATIVE COOLER EC2A	1HP	480	MCC2	EC2A	3/4"	3#12	1#12	E-3,9,18	
52		EVAPORATIVE COOLER EC2A	1HP	480	MCC2	EC2A	3/4"	3#12	1#12	E-3,9,18	
53		EVAPORATIVE COOLER EC2A	1HP	480	MCC2	EC2A	3/4"	3#12	1#12	E-3,9,18	
54		EVAPORATIVE COOLER EC2B	1HP	480	MCC2	EC2B	3/4"	3#12	1#12	E-3,9,18	
55		EVAPORATIVE COOLER EC2B	1HP	480	MCC2	EC2B	3/4"	3#12	1#12	E-3,9,18	
56		EVAPORATIVE COOLER EC2B	1HP	480	MCC2	EC2B	3/4"	3#12	1#12	E-3,9,18	
57		EVAPORATIVE COOLER EC2B	1HP	480	MCC2	EC2B	3/4"	3#12	1#12	E-3,9,18	
58		EXHAUST FAN EF-5	3/4HP	480	MCC2	EF-5	3/4"	3#12	3#12	E-3,9,18	
59		MAKE-UP AIR UNIT MU-1	3/4HP	480	MCC2	MU-1	3/4"	3#12	3#12	E-3,10,18	
60		EVAPORATIVE COOLER ECU-1	1HP	480	MCC2	ECU-1	3/4"	3#12	3#12	E-3,10,18	
61		SPARE			LOADCENTER A	SEE NOTE 1	4"			E-3,4,9,17,18	
62		SPARE			LOADCENTER A	SEE NOTE 1	4"			E-3,4,9,17,18	
63		TELEPHONE	N/A	N/A	EXIST. POLE	EXIST. POLE	4"	PULLWIRE	-	E-4	
64		ENERGY MONITORING	N/A	N/A	LOADCENTER A	EMCS DTC	4"	2#14	1#14	E-3,4,8	
65		PANEL LP1	225A	480	DP1	LP1	2"	4#3/0	1#4	E-3,18	
66		TRANSFORMER T-1	150KVA	480	DP1	T-1	2"	3#3/0	1#8	E-3,18	
67		PANEL PP1	400A	208/120	T-1	PP1	3"	4#500MCM	1#4	E-3,18	
68		ROBOTIC PAINT SYSTEM		480	DP1	J-BOX	3/4"	3#10	1#10	E-3,8	
69		ROBOTIC PAINT SYSTEM		480	DP1	J-BOX	3/4"	3#10	1#10	E-3,8	
70		ROBOTIC PAINT SYSTEM		480	DP1	J-BOX	3/4"	3#10	1#10	E-3,8	
71		ROBOTIC PAINT SYSTEM		480	DP1	J-BOX	3/4"	3#10	1#10	E-3,8	
72		HANGAR DOORS	2HP	480	DP1	HANGAR DOOR	3/4"	3#12	1#12	E-3,8	
73		HANGAR DOORS	2HP	480	DP1	HANGAR DOOR	3/4"	3#12	1#12	E-3,8	
74		HANGAR DOORS	2HP	480	DP1	HANGAR DOOR	3/4"	3#12	1#12	E-3,8	
75		HANGAR DOORS	2HP	480	DP1	HANGAR DOOR	3/4"	3#12	1#12	E-3,8	
76		HANGAR DOORS	2HP	480	DP1	HANGAR DOOR	3/4"	3#12	1#12	E-3,8	
77		HANGAR DOORS	2HP	480	DP1	HANGAR DOOR	3/4"	3#12	1#12	E-3,8	
78		HANGAR DOORS	2HP	480	DP1	HANGAR DOOR	3/4"	3#12	1#12	E-3,8	
79		HANGAR DOORS	2HP	480	DP1	HANGAR DOOR	3/4"	3#12	1#12	E-3,8	
80		HEAT PUMP HPU-1	208	208	PP1	HPU-1	3/4"	2#8	1#10	E-8	
81		HEAT PUMP HPU-2	208	208	PP1	HPU-2	3/4"	2#8	1#10	E-8	
82		FAN COIL UNIT FCU-1	208	208	PP1	FCU-1	3/4"	2#8	1#10	E-8	
83		FAN COIL UNIT FCU-2	208	208	PP1	FCU-2	3/4"	2#8	1#10	E-10	
84		BREATHING AIR UNIT BAU-1	208	208	PP1	BAU-1	3/4"	2#8	1#10	E-10	
85		EMERGENCY BATTERY UNIT	1800W	277	LP1	CBEPS	3/4"	2#12 3#10 ANG	1#12	E-3,18	
86		FIRE PROTECTION	4x15HP	480	LOADCENTER A	AFFF PUMPS	4"	2#2	1#8	E-3,4,8,9,17	
87		SPARE			LOADCENTER A	SERVICE BLDG	4"			E-3,4,8,17	
88		ROBOTIC PAINT SYSTEM	480	480	DP1	J-BOX	3/4"	3#10	1#10	E-3,9	
89		ROBOTIC PAINT SYSTEM	480	480	DP1	J-BOX	3/4"	3#10	1#10	E-3,9	
90		ROBOTIC PAINT SYSTEM	480	480	DP1	J-BOX	3/4"	3#10	1#10	E-3,9	
91		ROBOTIC PAINT SYSTEM	480	480	DP1	J-BOX	3/4"	3#10	1#10	E-3,9	
92		ROBOTIC PAINT SYSTEM	480	480	PP2	J-BOX	1 1/2"	2#3, 3#10, 3#12	1#8	E-8	
93		ROBOTIC PAINT SYSTEM	480	480	PP2	J-BOX	1 1/2"	2#3, 3#10, 3#12	1#8	E-8	
94		ROBOTIC PAINT SYSTEM	480	480	PP2	J-BOX	1 1/2"	2#3, 3#10, 3#12	1#8	E-9	
95		ROBOTIC PAINT SYSTEM	480	480	PP2	J-BOX	1 1/2"	2#3, 3#10, 3#12	1#8	E-9	
96		PANEL PP2	225A	208/120	PP1	PP2	2 1/2"	4#4/0	1#2	E-3,18	
97		ROLL-UP DOOR	1/2HP	480	DP1	DOOR#140	3/4"	3, 2#12	1#12	E-3,9	
98		ROLL-UP DOOR	1/2HP	480	DP1	DOOR#142	3/4"	3, 2#12	1#12	E-3,9	
99		AIR BATH	5HP	480	DP1	AIR BATH #108	3/4"	2#12	1#12	E-3,8	
100		AIR BATH	5HP	480	DP1	AIR BATH #114	3/4"	2#12	1#12	E-3,9	
101		AFFF CONTROLS	N/A	-	FACP	AFFF PUMP	1"	12#14	1#12	E-8,17,18	
102		AFFF CONTROLS	N/A	-	AFFF PUMP	AFFF PUMP	1"	6#14	1#12	E-8,17,18	
103		AFFF CONTROLS	N/A	-	FACP	AFFF PUMP	1"	12#14	1#12	E-8,9,17,18	
104		AFFF CONTROLS	N/A	-	FACP	AFFF PUMP	1"	6#14	1#12	E-9,17,18	
105											

NOTES:

- RUN SPARE CONDUIT TO LOCATIONS AS SHOWN ON THE DRAWINGS. INSTALL PULLWIRE AND CAP.
- PP2 - #3 WIRES, CKT #1 AND 3
#10 WIRES, CKT #5 AND 7 PLUS NEUTRAL
#12 WIRES, CKT #9 AND 11 PLUS NEUTRAL
- PP2 - #3 WIRES, CKT #13 AND 15
#10 WIRES, CKT #17 AND 19 PLUS NEUTRAL
#12 WIRES, CKT #21 AND 23 PLUS NEUTRAL
- PP2 - #3 WIRES, CKT #2 AND 4
#10 WIRES, CKT #6 AND 8 PLUS NEUTRAL
#12 WIRES, CKT #10 AND 12 PLUS NEUTRAL
- PP2 - #3 WIRES, CKT #14 AND 16
#10 WIRES, CKT #18 AND 20 PLUS NEUTRAL
#12 WIRES, CKT #22 AND 24 PLUS NEUTRAL

NOTES: *Referendum No. 0006*

- RUN SPARE CONDUIT TO LOCATIONS AS SHOWN ON THE DRAWINGS. INSTALL PULLWIRE AND CAP.
- PP2 - #3 WIRES, CKT #1 AND 3
#10 WIRES, CKT #5 AND 7 PLUS NEUTRAL
#12 WIRES, CKT #9 AND 11 PLUS NEUTRAL
- PP2 - #3 WIRES, CKT #13 AND 15
#10 WIRES, CKT #17 AND 19 PLUS NEUTRAL
#12 WIRES, CKT #21 AND 23 PLUS NEUTRAL
- PP2 - #3 WIRES, CKT #2 AND 4
#10 WIRES, CKT #6 AND 8 PLUS NEUTRAL
#12 WIRES, CKT #10 AND 12 PLUS NEUTRAL
- PP2 - #3 WIRES, CKT #14 AND 16
#10 WIRES, CKT #18 AND 20 PLUS NEUTRAL
#12 WIRES, CKT #22 AND 24 PLUS NEUTRAL

QUESTION/REQUEST: Elect does show only 2nd wire for pump to
Install white 1st station. Will any other electrical be
required - i.e. lighting, controls, instrumentation?
Please advise. *Referendum No. 0006*

A SEPARATE NEUTRAL IS NEEDED BETWEEN LOAD
CENTER A AND DP-1. *Referendum No. 0006*

ADD ONE #2 WIRE RFI 30 - PUMP 12

AFFF GROUND CONDUCTORS WILL 3/0 PER RFI 177

AFFF PUMPS SUBMITTED AS 30HP NET IS
WIRE SIZE REMAINS SUBMITTAL REVIEW
PER RFI # 67

Reference your letter #ALB-H-052, dated February 15, 1994, your
RFI's, RFI-87, dated March 3, 1994, and RFI-102, dated March 3,
1994. The above referenced correspondence all relates to the new
AFFF fire pumps, and the electrical layout for the same.

As noted in your letter, the pump size for the new AFFF
systems in both the new facility and in existing Building 692 are
required to be 30 horsepower.

You are correct in your RFI-87 when you state that the AFFF
pumps selected will not work with the wiring sizes shown on the
contract drawings:

a. For the four 30 horsepower pump motors being supplied by
your subcontractor for the new facility, you will need to
use 3 - 3/0 AHC feeder conductors with 1 - 250 MCM ground
conductor. This 250 MCM ground conductor (as specified in
enclosure 3 to amendment 0006) is adequate and does meet the
requirements of the National Electric Code (NEC). The 500 amp
fuses feeding those pumps (as shown on drawing E-3), need to be
changed to 1000 amp fuses.

b. For the two 30 horsepower pump motors being supplied by
your subcontractor for existing Building 692, you will need to
use 3 - 7/0 AHC feeder conductors with 1 - 250 MCM ground