

## INDEX OF DRAWINGS:

### 31-AS-000 - CONTRACTOR SITE MANAGEMENT PLAN

#### LIFE SAFETY:

31-AS-LSP - LIFE SAFETY PLAN

#### STRUCTURAL:

31-ST-101 - STRUCTURAL DETAILS

AS-BUILT STRUCTURAL SCANS (Set of 12 Sheets)

#### ARCHITECTURAL:

31-AS-100 EXISTING BASEMENT  
 31-AS-101 EXISTING GROUND FLOOR  
 31-AS-102 EXISTING FIRST FLOOR PLAN  
 31-AS-103 EXISTING SECOND FLOOR  
 31-AS-104 PHASING PLANS  
 31-AS-105A ABATEMENT DIAGRAM GROUND FLOOR  
 31-AS-105B ABATEMENT DIAGRAM LEVEL 1  
 31-AS-105C FIRE EXTINGUISHER PLAN  
 31-AS-106 FIRST FLOOR DEMOLITION PLAN  
 31-AS-107 FIREPROOFING PLAN  
 31-AS-108 FIREPROOFING PLAN  
 31-AS-109 GROUND FLOOR DEMO & RENOVATION PLAN  
 31-AS-110A FIRST FLOOR RENOVATION PLAN  
 31-AS-110B ICU CABLING REPLACEMENT  
 31-AS-111 DIMENSION PLAN  
 31-AS-201 WALL SECTIONS AND DETAILS  
 31-AS-401 ENLARGED PLANS & INTERIOR ELEVATIONS  
 31-AS-402 ENLARGED PLANS & INTERIOR ELEVATIONS  
 31-AS-403 ENLARGED PLANS & INTERIOR ELEVATIONS  
 31-AS-404 ENLARGED PLANS & INTERIOR ELEVATIONS  
 31-AS-405 ENLARGED PLANS & INTERIOR ELEVATIONS  
 31-AS-406 ENLARGED PLANS & INTERIOR ELEVATIONS  
 31-AS-407 ENLARGED PLANS & INTERIOR ELEVATIONS  
 31-AS-408 ENLARGED PLANS & INTERIOR ELEVATIONS  
 31-AS-409 ENLARGED PLANS & INTERIOR ELEVATIONS  
 31-AS-410 ENLARGED PLANS & INTERIOR ELEVATIONS  
 31-AS-411 ENLARGED PLANS & INTERIOR ELEVATIONS  
 31-AS-412 INTERIOR ELEVATIONS  
 31-AS-413 INTERIOR ELEVATIONS  
 31-AS-414 INTERIOR ELEVATIONS  
 31-AS-415 INTERIOR ELEVATIONS  
 31-AS-416 HEADWALL ELEVATIONS @ LEVEL 1 IN-PATIENT  
 31-AS-417 ENLARGED PLANS & INTERIOR ELEVATIONS  
 31-AS-418 ENLARGED PLANS & INTERIOR ELEVATIONS  
 31-AS-419 ENLARGED PLANS & INTERIOR ELEVATIONS  
 31-AS-420 HEADWALL ELEVATIONS @ GROUND FLOOR  
 31-AS-500 GROUND FLOOR DEMO & PROPOSED RCP  
 31-AS-501 FIRST FLOOR REFLECTED CEILING PLAN  
 31-AS-502 ENLARGED REFLECTED CEILING PLANS  
 31-AS-503 ENLARGED REFLECTED CEILING PLANS  
 31-AS-600 INTERIOR PARTITION TYPES  
 31-AS-601 DOOR AND WINDOW DETAILS  
 31-AS-602 DOOR SCHEDULE  
 31-AS-603 INTERIOR DETAILS  
 31-AS-701 FIRST FLOOR SIGNAGE LOCATION PLAN  
 31-AS-800 WALL PROTECTION PLAN  
 31-AS-901 MILLWORK SECTIONS  
 31-AS-902 MILLWORK SECTIONS  
 31-AS-903 MILLWORK SECTIONS

#### INTERIOR DESIGN:

31-ID-101 FIRST FLOOR - FLOOR FINISH PLAN  
 31-ID-102 FIRST FLOOR - WALL FINISH PLAN  
 31-ID-103 HEADWALL FINISHES  
 31-ID-104 INTERIOR FINISH LEGEND  
 31-ID-105 INTERIOR FINISH SCHEDULE

#### PLUMBING:

31-PD-181 Plumbing – Basement Floor, Demolition Plan  
 31-PD-101 Plumbing – Ground Floor, Demolition Plan  
 31-PD-102 Plumbing – Ground Floor, Demolition Plan  
 31-PD-103 Plumbing – Ground Floor, Demolition Plan  
 31-PD-104 Plumbing – Ground Floor, Demolition Plan  
 31-PD-111 Plumbing – First Floor, Demolition Plan  
 31-PD-112 Plumbing – First Floor, Demolition Plan  
 31-PD-113 Plumbing – First Floor, Demolition Plan  
 31-PD-114 Plumbing – First Floor, Demolition Plan  
 31-PL-181 Plumbing – Basement Floor, Drain & Vent New Work Plan  
 31-PL-101 Plumbing – Ground Floor, Drain & Vent New Work Plan  
 31-PL-102 Plumbing – Ground Floor, Drain & Vent New Work Plan  
 31-PL-103 Plumbing – Ground Floor, Drain & Vent New Work Plan  
 31-PL-104 Plumbing – Ground Floor, Drain & Vent New Work Plan  
 31-PL-111 Plumbing – First Floor, Drain & Vent New Work Plan  
 31-PL-112 Plumbing – First Floor, Drain & Vent New Work Plan  
 31-PL-113 Plumbing – First Floor, Drain & Vent New Work Plan  
 31-PL-114 Plumbing – First Floor, Drain & Vent New Work Plan  
 31-PP-101 Plumbing – Ground Floor, Supply New Work Plan  
 31-PP-111 Plumbing – First Floor, Supply New Work Plan  
 31-PP-112 Plumbing – First Floor, Supply New Work Plan  
 31-PP-113 Plumbing – First Floor, Supply New Work Plan  
 31-PP-114 Plumbing – First Floor, Supply New Work Plan  
 31-P-301 Plumbing – Waste and Vent Riser Diagrams  
 31-P-302 Plumbing – Waste and Vent Riser Diagrams  
 31-P-303 Plumbing – Dom. Water Supply Piping Riser Diagrams  
 31-P-304 Plumbing – Dom. Water Supply Piping Riser Diagrams  
 31-P-305 Plumbing – Medical Gases Piping Riser Diagrams  
 31-P-306 Plumbing – Medical Gases Piping Riser Diagrams  
 31-P-307 Plumbing – Ground Floor Swing Space Riser Diagrams  
 31-P-501 Plumbing – Legend, Fixture and Equipment Schedules

#### FIRE PROTECTION:

31-FD-101 Fire Protection – Ground Floor, Demolition Plan  
 31-FD-111 Fire Protection – First Floor, Demolition Plan  
 31-FD-112 Fire Protection – First Floor, Demolition Plan  
 31-FD-113 Fire Protection – First Floor, Demolition Plan  
 31-FD-114 Fire Protection – First Floor, Demolition Plan  
 31-FP-101 Fire Protection – Ground Floor, New Work Plan  
 31-FP-111 Fire Protection – First Floor, New Work Plan  
 31-FP-112 Fire Protection – First Floor, New Work Plan  
 31-FP-113 Fire Protection – First Floor, New Work Plan  
 31-FP-114 Fire Protection – First Floor, New Work Plan

#### HVAC:

31-MD-011 Mechanical – Phasing Plan, First Floor Demolition Plan  
 31-MD-101 Mechanical – Ground Floor, Demolition Plan  
 31-MD-111 Mechanical – First Floor, Demolition Plan  
 31-MD-112 Mechanical – First Floor, Demolition Plan  
 31-MD-113 Mechanical – First Floor, Demolition Plan  
 31-MD-114 Mechanical – First Floor, Demolition Plan  
 31-MD-131 Mechanical – Roof Level, Demolition Plan  
 31-MH-011 Mechanical – Phasing Plan, First Floor New Work Plan  
 31-MH-101 Mechanical – Ground Floor, Ductwork New Work Plan  
 31-MH-111 Mechanical – First Floor, Ductwork New Work Plan  
 31-MH-112 Mechanical – First Floor, Ductwork New Work Plan  
 31-MH-113 Mechanical – First Floor, Ductwork New Work Plan  
 31-MH-114 Mechanical – First Floor, Ductwork New Work Plan  
 31-MH-121 Mechanical – Partial Second Floor Plan & Elevations  
 31-MH-131 Mechanical – Roof Level, New Work Plans  
 31-MP-101 Mechanical – Ground Floor, Piping New Work Plan  
 31-MP-111 Mechanical – First Floor, Piping New Work Plan  
 31-MP-112 Mechanical – First Floor, Piping New Work Plan  
 31-MP-113 Mechanical – First Floor, Piping New Work Plan  
 31-MP-114 Mechanical – First Floor, Piping New Work Plan  
 31-M-301 Mechanical – Controls, Legend, Notes & Schematics  
 31-M-302 Mechanical – Controls, Schematics  
 31-M-303 Mechanical – Controls, Schematics  
 31-M-501 Mechanical – Legends and General Notes  
 31-M-502 Mechanical – Equipment Schedules  
 31-M-503 Mechanical – Equipment Schedules  
 31-M-504 Mechanical – Equipment Schedules  
 31-M-601 Mechanical – Typical Details  
 31-M-602 Mechanical – Typical Details  
 31-M-603 Mechanical – Typical Details

#### ELECTRICAL:

31-ED-101 Electrical – Ground Floor Demolition Plan  
 31-ED-111 Electrical – First Floor Demolition Plan  
 31-ED-112 Electrical – First Floor Demolition Plan  
 31-ED-113 Electrical – First Floor Demolition Plan  
 31-ED-114 Electrical – First Floor Demolition Plan  
 31-ED-115 Electrical – First Floor Demolition Plan  
 31-EP-101 Electrical – Ground Floor New Power/Signal Plan  
 31-EP-111 Electrical – First Floor New Power/Signal Plan  
 31-EP-112 Electrical – First Floor New Power/Signal Plan  
 31-EP-113 Electrical – First Floor New Power/Signal Plan  
 31-EP-114 Electrical – First Floor New Power/Signal Plan  
 31-EP-115 Electrical – First Floor New Power/Signal Plan  
 31-EP-411 Electrical – Level 1, Power & Lighting Patient Rm. Plans  
 31-EP-412 Electrical – Gnd. Fir. Level, Power & Lighting Patient Rm. Plans  
 31-EP-413 Electrical – Misc. Areas, Demolition & New Work Plans  
 31-EP-414 Electrical – Fiber Routing Plan  
 31-EL-101 Electrical – Ground Floor New Lighting Plan  
 31-EL-111 Electrical – First Floor New Lighting Plan  
 31-EL-112 Electrical – First Floor New Lighting Plan  
 31-EL-113 Electrical – First Floor New Lighting Plan  
 31-EL-114 Electrical – First Floor New Lighting Plan  
 31-E-601 Electrical – Legends, Notes and Schedules  
 31-E-602 Electrical – Panel Schedules  
 31-E-603 Electrical – Panel Schedules  
 31-E-604 Electrical – Details  
 31-E-605 Electrical – Details  
 31-E-606 Electrical – Details  
 31-E-607 Electrical – Details  
 31-E-801 Electrical – Demolition One-Line Diagram  
 31-E-802 Electrical – New Work One-Line Diagram  
 31-E-803 Fire Alarm – Ground Floor Demolition Riser Diagram  
 31-E-804 Fire Alarm – First Floor Demolition Riser Diagram  
 31-E-805 Fire Alarm – Ground Floor New Work Riser Diagram  
 31-E-806 Fire Alarm – First Floor New Work Riser Diagram  
 31-E-807 Telecom – Riser Diagram

# INPATIENT WARD RENOVATION VETERANS ADMINISTRATION MEDICAL CENTER BUILDING 31 WHITE RIVER JUNCTION, VERMONT

ISSUED FOR: Bidding and Construction

09/30/2022

#### OWNER:

WHITE RIVER JUNCTION VA MEDICAL CENTER  
 163 Veterans Drive (GPS)  
 White River Junction, VT 05009  
 Tel: 802.295.9363  
 www.e4harchitecture.com

#### ARCHITECT:

**e4h** ENVIRONMENTS FOR HEALTH ARCHITECTURE  
 E4H MORRISWITZER ENVIRONMENTS FOR HEALTH ARCHITECTURE  
 185 Talcott Road  
 Williston, VT 05495  
 Tel: 802.878.8842  
 www.e4harchitecture.com

#### STRUCTURAL CONSULTANT:

**ENGINEERING VENTURES PC**  
 ENGINEERING VENTURES  
 208 Flynn Avenue, Suite 2A  
 Burlington, VT 05401  
 Tel: 802-863-6225  
 www.engineeringventures.com

#### MEP CONSULTANT:

**LN CONSULTING**  
 LN CONSULTING  
 208 Flynn Ave., Suite 2J,  
 Burlington, VT 05401  
 Tel: 802.655.1753  
 www.lnconsulting.com

#### CONSTRUCTION COST ESTIMATING & SCHEDULING:

**VIS CONSTRUCTION CONSULTANTS**  
 VIS CONSTRUCTION CONSULTANTS  
 595 Dorset Street, Suite #5  
 South Burlington, VT 05403  
 Tel: 802.658.6100  
 www.viscc.com

#### HAZARDOUS MATERIALS:

**ATLAS**  
 ATLAS  
 51 Knight Lane  
 Williston, VT 05495  
 802-862-1980

#### COMMISSIONING SERVICES:

**Cxassociates.us**  
 Cx ASSOCIATES  
 110 Main Street  
 Burlington, VT 05401  
 Tel: 802.861.2715  
 www.cx-associates.com

#### LIFE SAFETY CONSULTANT:

**JENSEN HUGHES**  
 JENSEN-HUGHES  
 1661 Worcester Road  
 Suite 501  
 Framingham, MA  
 www.jensenhughes.com

#### INTERIOR SIGNAGE DESIGN:

**CREATIVE**  
 CREATIVE SIGNAGE  
 9101 51st Place  
 College Park, MD 20740  
 Tel: 301.345.3700  
 www.creativesignage.com

PROJECT  
 #405-13-104

11/10/2022  
 2:06:03 PM  
 Environments for Health, Inc.








**COLUMN SCHEDULE**

COL. NO.	FL. ELEV.	A-2	A-2.3	A-2.6	A-3	A-5-2	A-5-2.3	A-5-3	B-2	B-2.3	B-3	B-4	B-4.4	B-4.7	B-5	B-5.2	B-5.5	B-6	B-5.2	B-5.2.3	B-5.3	B-5.4	B-5.4.7	B-5.5	B-5.5.2	B-5.5.5	B-5.6	B-7.2.5	B-7.2.9	B-7.3.5	B-7.4.2	C-2	C-2.3	C-2.4	C-2.9	C-4	C-4.7	C-5			
PH. ROOF TOP	ROOF EL. 673.50																											W8x31	W8x31	W8x31	W8x31										
MAIN ROOF TOP	ROOF EL. 677.33		W8x31	W8x31					W10x112		W12x85	W10x89	W10x60																												
2 <sup>ND</sup> FL. TOP	FL. EL. 669.66		W10x89	W8x31	W8x31	W10x89	W10x77		W10x77	W10x112		W12x85	W10x89	W10x60																											
1 <sup>ST</sup> FL. TOP	FL. EL. 651.33		W10x89	W8x31	W8x31	W10x89	W10x77		W10x77	W10x112		W12x100	W10x89	W10x60																											
GR. FL. TOP	FL. EL. 638.00		W8x31	W8x31		W10x77	W8x31	W10x77	W10x112	W12x58	W12x100	W10x89		W10x60																											
BOT. BASE EL.		636.42	635.96	635.96	636.42	635.21	627.08	635.21	634.58	627.08	634.54	635.12	637.17	635.12	635.12	635.46	635.46	636.42	634.96	627.08	627.08	627.08	627.08	627.08	627.08	627.08	627.08	635.62	678.95	678.95	678.95	678.95	634.54	627.08	678.95	627.08	627.08	627.08	627.08	627.08	
BASE R. SIZE	# TYPE (L/BAN)	1/2x23x23																																							
COLUMN LOAD		126K	118K	112K	116K	236K	71K	242K	482K	87K	686K	310K	169K	182K	195K	187K	187K	105K	149K	100K	111K	104K	81K	58K	63K	63K	126K	6K	12K	12K	12K	577K	86K	14K	1000K	779K	586K	595K			

NOTE: SEE COLUMN D-5 BASE DETAIL

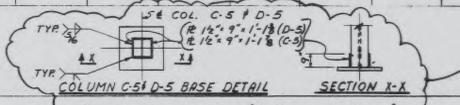


**COLUMN SCHEDULE**

COL. NO.	FL. ELEV.	C-5.1	C-5.2	C-5.5	C-6	D-2	D-2.3	D-2.4	D-2.9	D-4	D-4.7	D-5	D-5.1	D-5.2	D-5.5	D-6	D-9.6	D-9.6.2	E-1	E-1.5	E-2	E-2.3	E-3	E-4	E-4.7	E-5	E-5.2	E-5.5	E-2.2.5	E-2.2.9	E-2.3.5	E-2.4.2	E-3.4	E-3.1	E-5.4	E-5.1	E-5.1.5	E-5.2		
PH. ROOF TOP	ROOF EL. 673.50	W8x31				W10x60							W8x31																											
MAIN ROOF TOP	ROOF EL. 677.33					W10x112																																		
2 <sup>ND</sup> FL. TOP	FL. EL. 669.66					W10x112																																		
1 <sup>ST</sup> FL. TOP	FL. EL. 651.33					W10x112																																		
GR. FL. TOP	FL. EL. 638.00		W12x58	W12x58	W10x89	W10x112	W12x58			W12x161	W12x161	W12x120	W12x133		W12x58	W12x58	W10x89	W10x60	W12x58	W12x58																				
BOT. BASE EL.		678.95	627.08	627.08	635.27	634.81	627.08	678.95	627.08	627.08	627.08	627.08	678.95	627.08	627.08	635.43	631.08	631.08	634.50	635.08	635.08	627.08	627.08	627.08	627.08	627.08	627.08	627.08	627.08	627.08	627.08	627.08	627.08	627.08	627.08	627.08	627.08	627.08	627.08	
BASE R. SIZE	# TYPE (L/BAN)	1/2x9x9	1/2x22x22	1/2x22x22	1/2x25x25	1/2x27x27	1/2x24x24	1/2x9x9	1/2x40x40	3/4x26x26	2/3x28x28	2/3x30x30	1/2x9x9	1/2x22x22	1/2x22x22	1/2x25x25	1/2x19x19	1/2x19x19	1/2x19x19	1/2x19x19	1/2x22x22																			
COLUMN LOAD		51K	59K	63K	410K	540K	61K	21K	974K	51K	561K	585K	52K	40K	44K	407K	157K	73K	115K	225K	243K	77K	73K	70K	53K	37K	32K	36K	14K	12K	12K	12K	12K	30K	89K	30K	117K	75K	86K	

**COLUMN SCHEDULE**

COL. NO.	FL. ELEV.	E-5.2.3	E-5.3	E-5.4	E-5.4.7	E-5.5	E-5.5.2	E-5.5.5	E-5.6.2	F-1	F-1.5	F-2	F-2.2	F-2.5	F-2.7	F-3	F-3.3	F-4	F-4.7	F-4.9	F-5.2	F-5.5	F-6	F-6.2	F-5.4.9	F-5.5.3	F-5.6.2	G-4.9	G-5.1	G-5.3	G-6.2	H-5.1	H-5.3	X-2.3	X-2.6	B-7.4.7	B-7.5	E-2.4.7	E-2.5				
PH. ROOF TOP	ROOF EL. 673.50																																										
MAIN ROOF TOP	ROOF EL. 677.33																																										
2 <sup>ND</sup> FL. TOP	FL. EL. 669.66																																										
1 <sup>ST</sup> FL. TOP	FL. EL. 651.33																																										
GR. FL. TOP	FL. EL. 638.00	W8x31	W12x58	W12x58	W12x58	W12x58	W8x31	W8x31	W10x60	W10x60	W10x66	W10x89	W10x60	W10x60	W10x60																												
BOT. BASE EL.		624.91	627.08	627.08	627.08	627.08	627.08	627.08	631.08	634.42	635.08	626.83	626.83	BASE R. SIZE	# TYPE (L/BAN)	1/2x10x10	1/2x22x22	1/2x22x22	1/2x22x22	1/2x22x22	1/2x10x10	1/2x10x10	1/2x21x21	1/2x20x20																																	
COLUMN LOAD		71K	95K	95K	72K	49K	49K	61K	134K	123K	244K	285K	205K	224K	208K	222K	217K	357K	300K	549K	41K	49K	62K	505K	269K	76K	268K	153K	144K	179K	162K	79K	54K	54K	10K	6K	10K	6K					

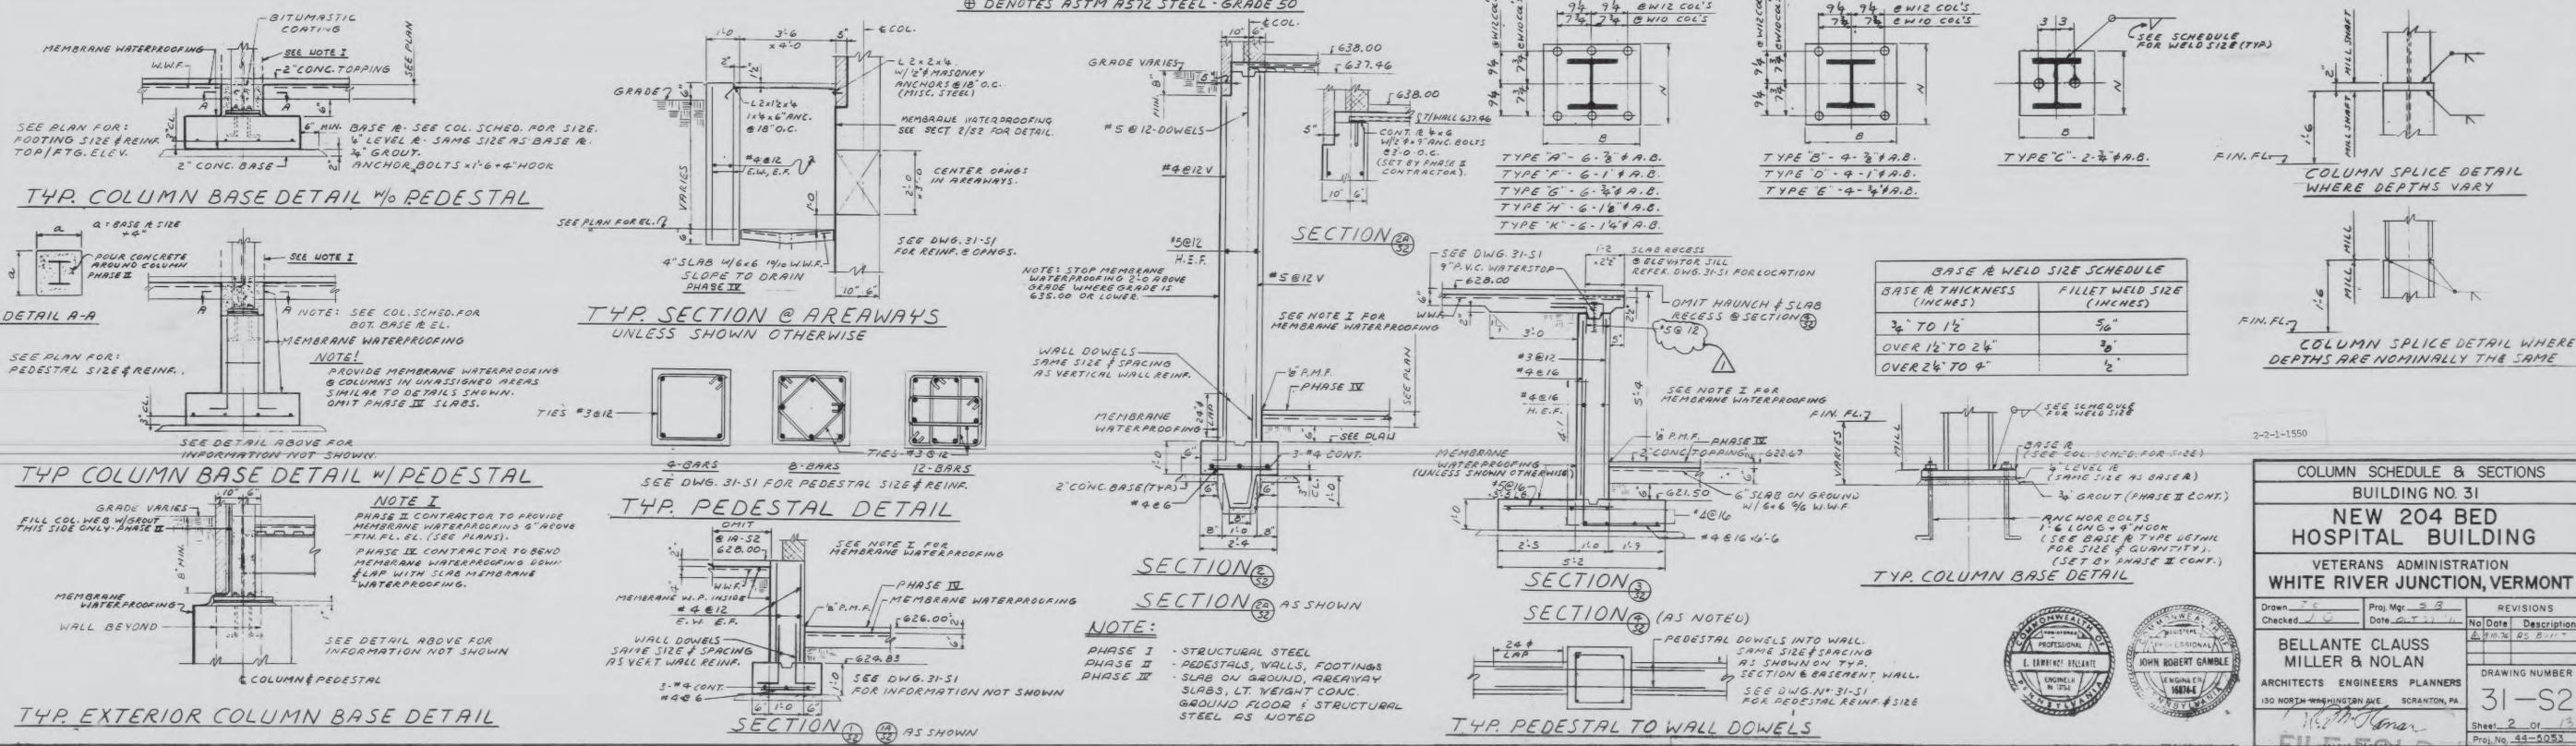























**COLUMN SCHEDULE & SECTIONS**  
**BUILDING NO. 31**  
**NEW 204 BED HOSPITAL BUILDING**  
 VETERANS ADMINISTRATION  
 WHITE RIVER JUNCTION, VERMONT

Drawn: J.C.    Proj. Mgr.: S.B.    REVISIONS  
 Checked: J.C.    Date: 11/11/11    No. Date Description  
 1 11/16/11 25 011

**BELLANTE CLAUS MILLER & NOLAN**  
 ARCHITECTS ENGINEERS PLANNERS  
 130 NORTH WASHINGTON AVE. SCRANTON, PA.

ENGINEER: JOHN ROBERT GAMBLE  
 LICENSE NO. 10844

DRAWING NUMBER: **31-52**  
 Sheet: 2 of 1  
 Proj. No. 44-5053

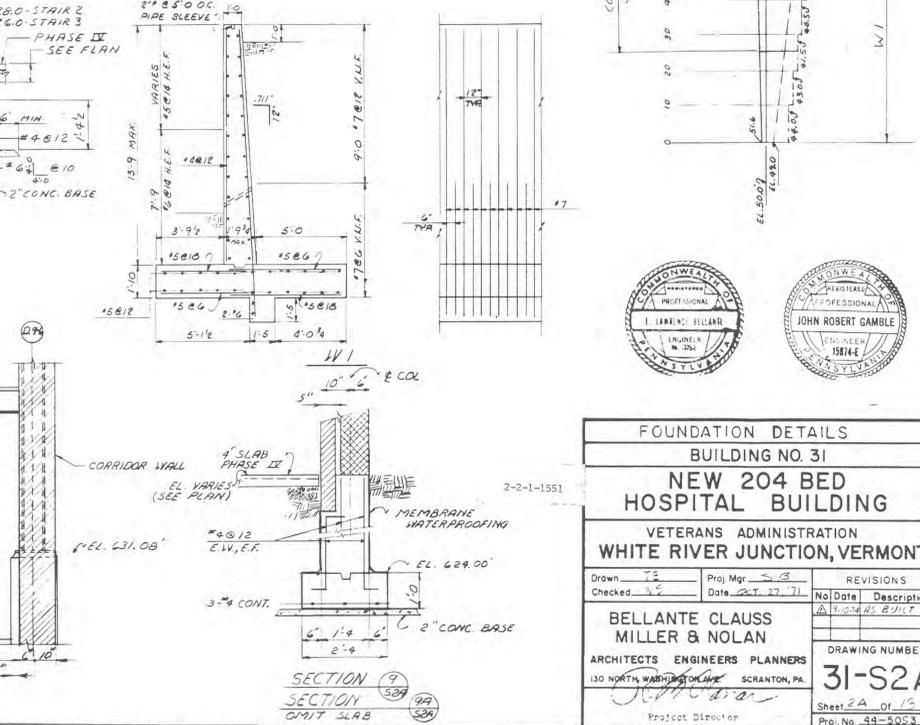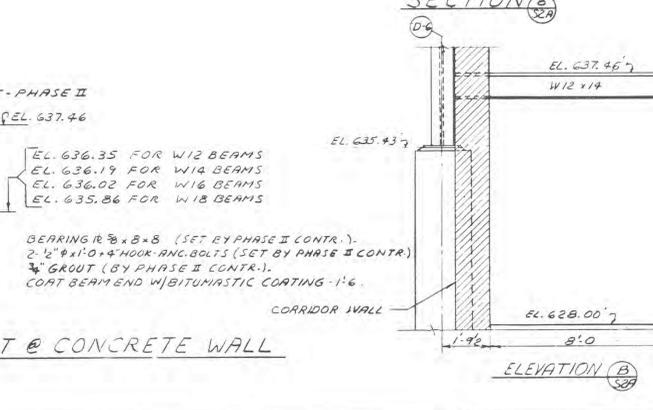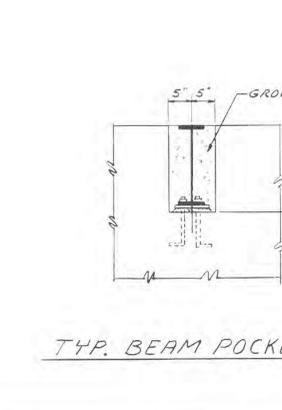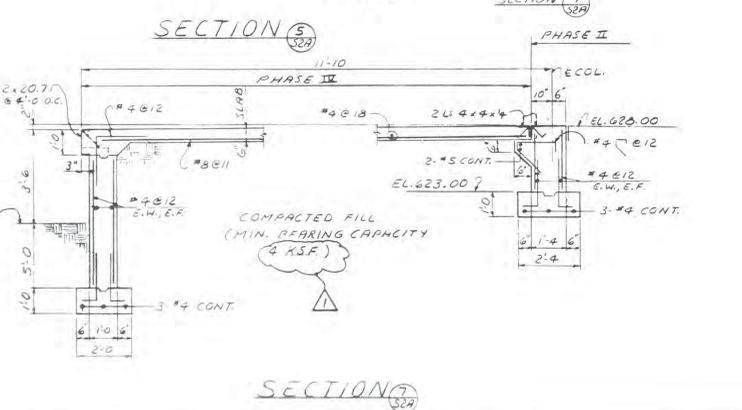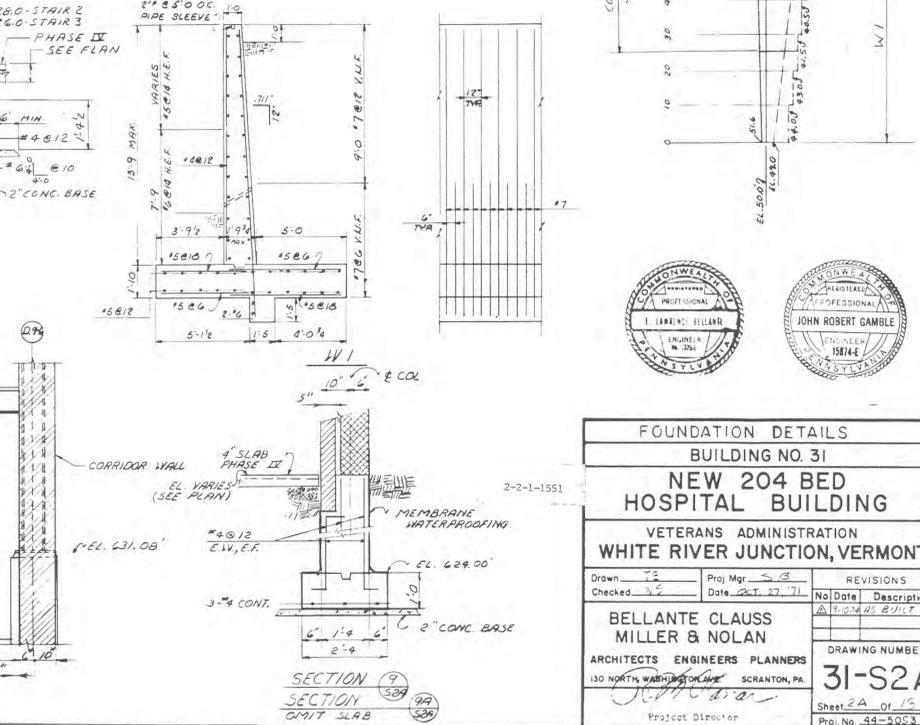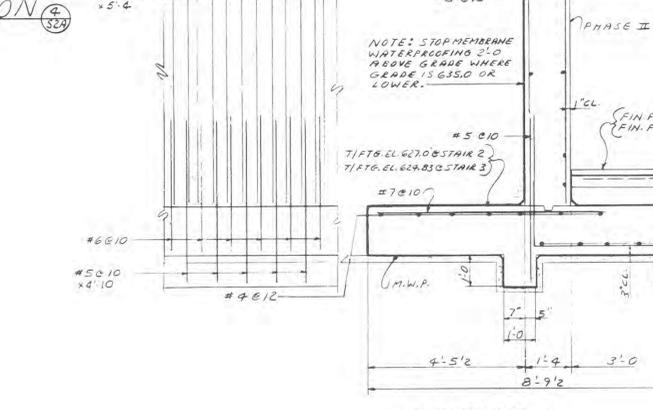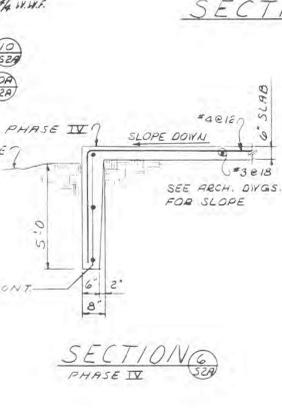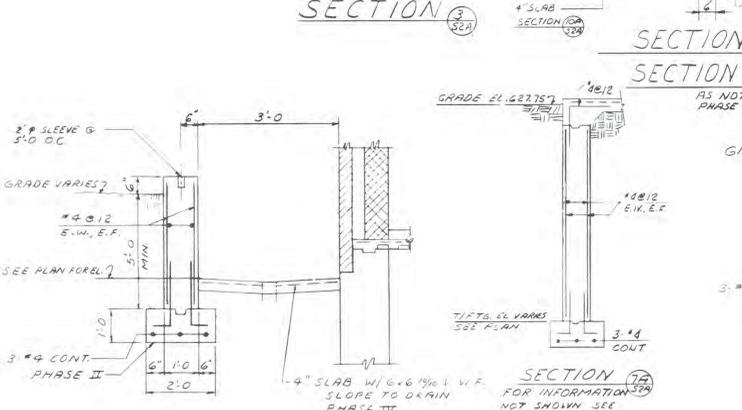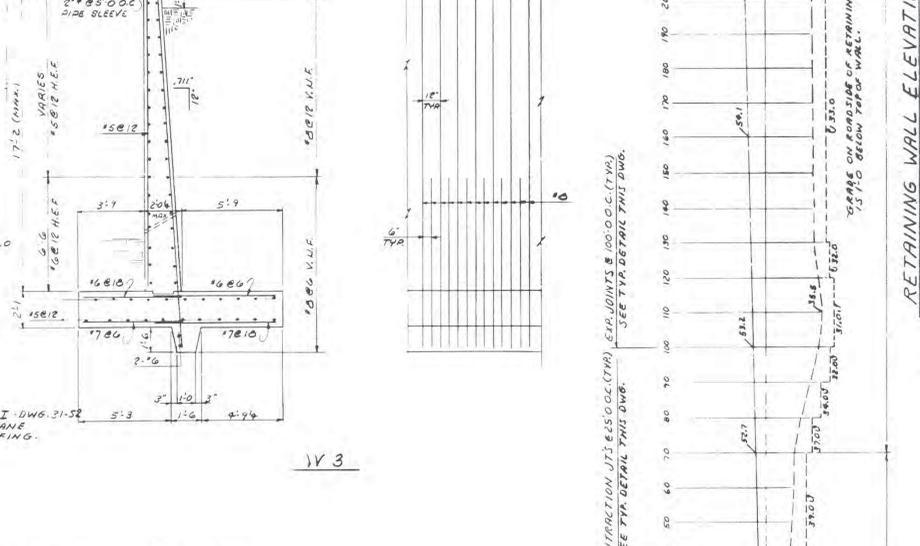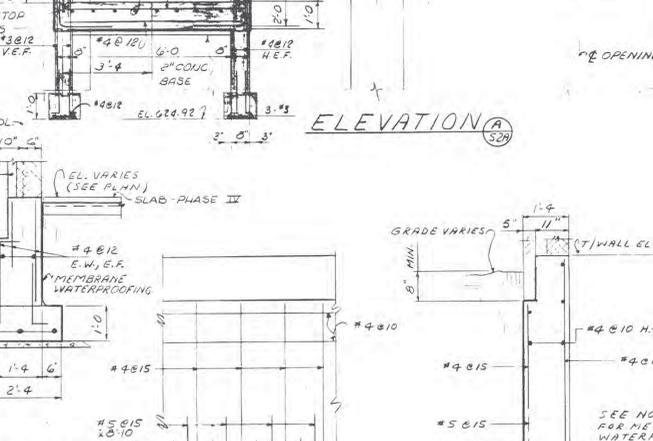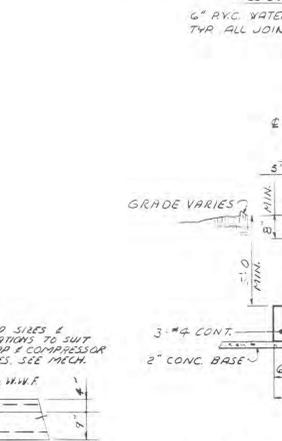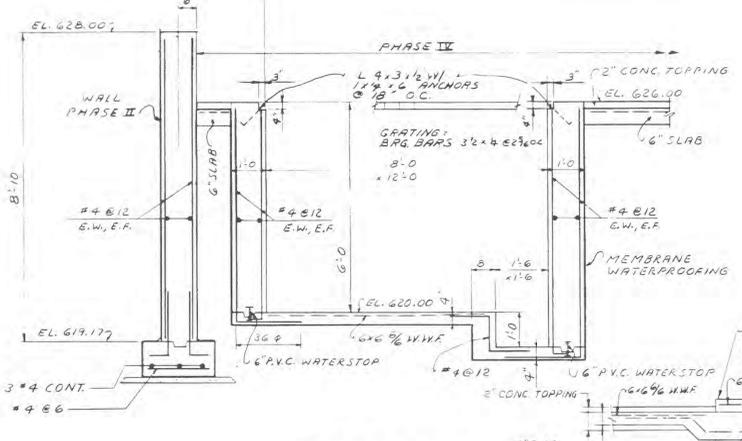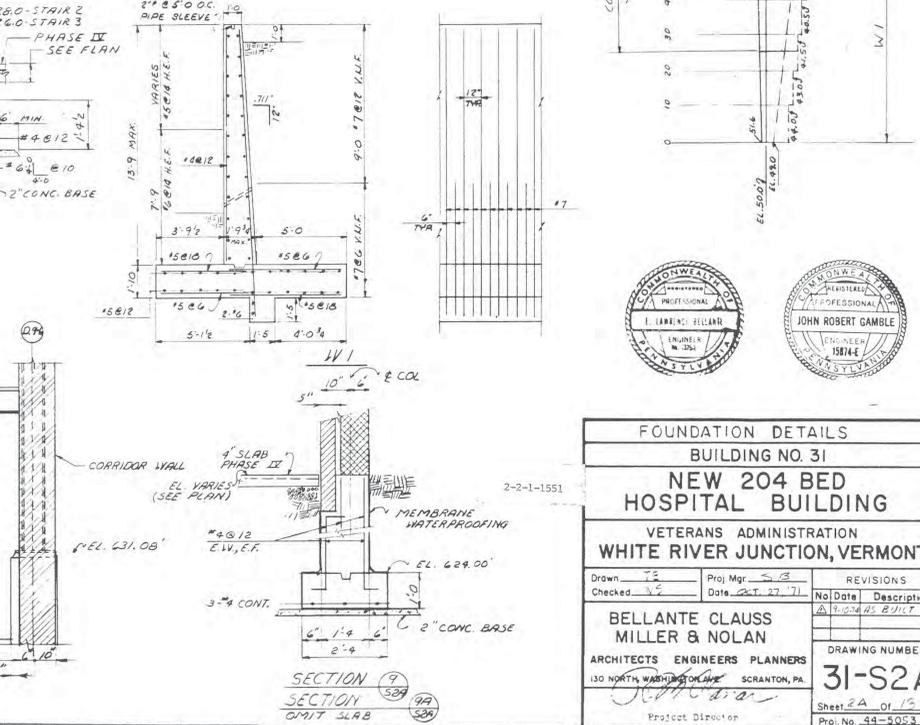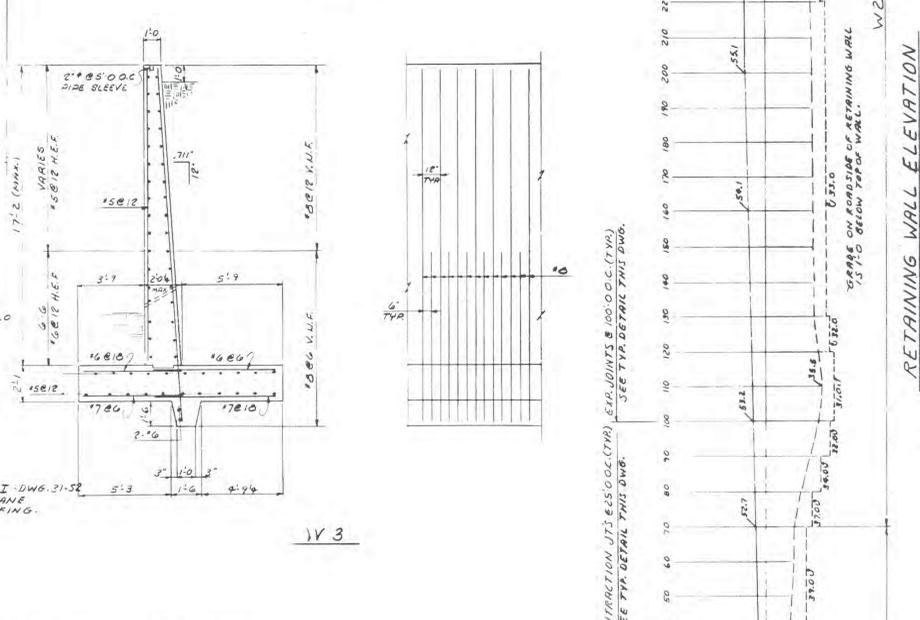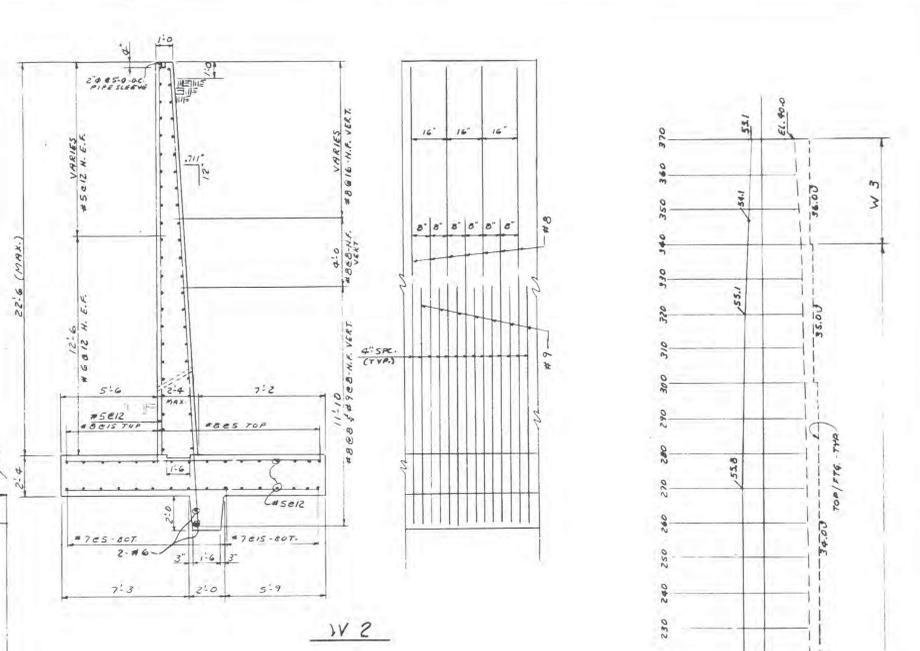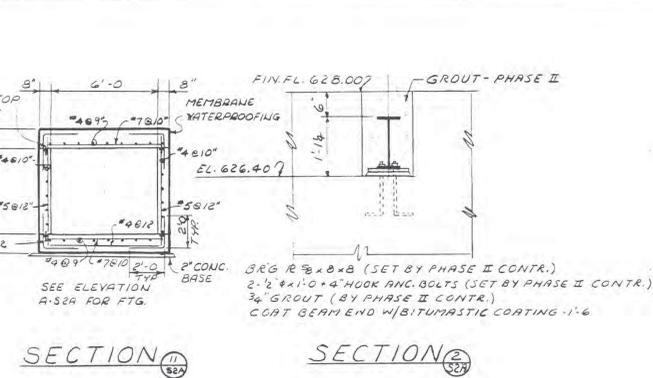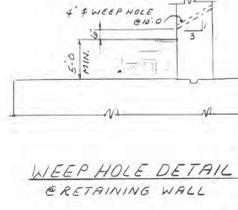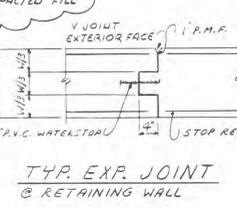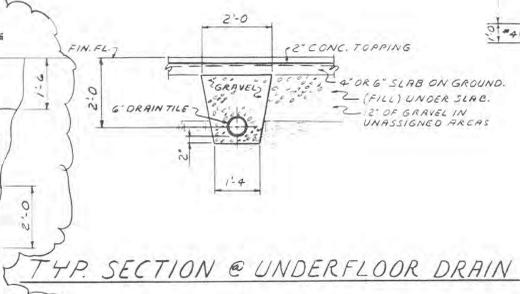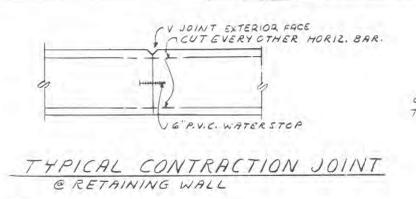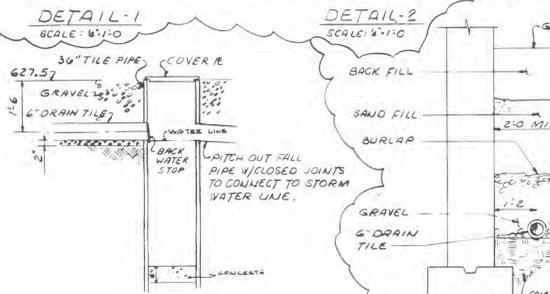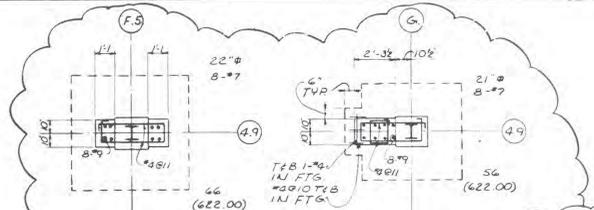

**TYP. BEAM POCKET @ CONCRETE WALL**

CONTRACTION JOINTS @ 65'-0" (TYP.) SEE JOINTS @ 100'-0" (TYP.) SEE TYP. DETAIL THIS DWG.

GRADE ON ROOFING OF RETAINING WALL 1.5' BELOW TOP OF WALL.



**FOUNDATION DETAILS**  
BUILDING NO. 31  
**NEW 204 BED HOSPITAL BUILDING**  
VETERANS ADMINISTRATION  
WHITE RIVER JUNCTION, VERMONT

Drawn: [ ]  
Checked: [ ]  
Project Mgr.: [ ]  
Date: 2-27-71


REVISIONS  
No. Date Description  
1 1-20-71 BUILT

**BELLANTE CLAUS MILLER & NOLAN**  
ARCHITECTS ENGINEERS PLANNERS  
130 NORTH WASHINGTON ST. SCRANTON, PA.


DRAWING NUMBER  
**31-S2A**  
Sheet 24 of 15  
Proj. No. 44-5053


**GENERAL NOTES - STEEL**

1. WELDED WIRE FABRIC (W.W.F.) A.S.T.M. A185, TO BE 6x6 "1/4" P.I.H. # 2
2. STEEL JOISTS, BRACING, BRIDGING, ETC. SHALL BE FABRICATED AND SHIPPED IN ACCORDANCE WITH THE LATEST SPECIFICATIONS OF THE STEEL JOIST INSTITUTE.
3. THE STEEL ROOF UNITS SHALL BE 1 1/2" DEEP, 22 GAGE, GALVANIZED, (SEE SPEC'S) AND SHALL BE SO FORMED AS TO HAVE A SECTION MODULUS OF AT LEAST 31.5 IN<sup>4</sup> PER FOOT OF WIDTH, UNLESS OTHERWISE SHOWN ON THE DESIGN DRAWINGS.
4. COMPOSITE FLOOR UNITS (COMBINED STEEL AND CONCRETE) SHALL BE CAPABLE OF SUPPORTING A SUPERIMPOSED LOAD OF (MIN. 150) POUNDS PER SQUARE FOOT. UNITS TO BE 1 1/2" DEEP, 22 GAGE, GALVANIZED, (SEE SPEC'S) AND SHALL BE SO FORMED AS TO HAVE A SECTION MODULUS OF AT LEAST 31.5 IN<sup>4</sup> PER FOOT OF WIDTH, UNLESS OTHERWISE SHOWN ON THE DESIGN DRAWINGS.
5. STRUCTURAL STEEL SHALL CONFORM TO A.S.T.M. A36 UNLESS MARKED FOR A.S.T.M. A572.
6. FABRICATION AND ERECTION SHALL CONFORM TO THE LATEST A.I.S.C. SPECIFICATIONS. CONNECTIONS MAY BE BOLTED OR WELDED. BOLTS SHALL CONFORM TO A.S.T.M. A325, #4 UNLESS NOTED OTHERWISE.
7. SHOP AND ERECTION DRAWINGS MUST SHOW ALL SHOP AND FIELD WELDS.
8. WELDING ELECTRODES SHALL CONFORM TO E70 SERIES A.S.T.M. A5.33. ALL WELDING AND WELDING SYMBOLS ON DRAWINGS SHALL CONFORM TO A.W.S. STANDARD CODE FOR WELDING IN BUILDING CONSTRUCTION.
9. DESIGN LIVE LOADS:  
 GROUND FL. (DINING, REC'D, PLANNED ACTIVITY) 100 PSF  
 OTHER GROUND FLOOR 60 PSF  
 1ST FLOOR 2ND FLOOR 60 PSF  
 PENTHOUSE FLOOR 150 PSF  
 ROOFS 40 PSF  
 CORRIDORS 100 PSF

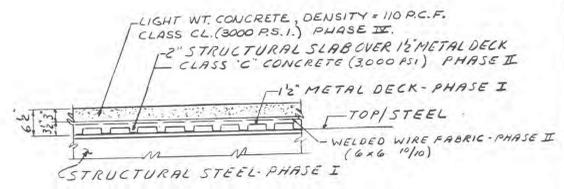


**TYPICAL CONSTRUCTION PHASES**  
 TYP. ALL FLOOR SLABS UNLESS SHOWN OTHERWISE (REFER DWGS. 31-59, 31-58.)

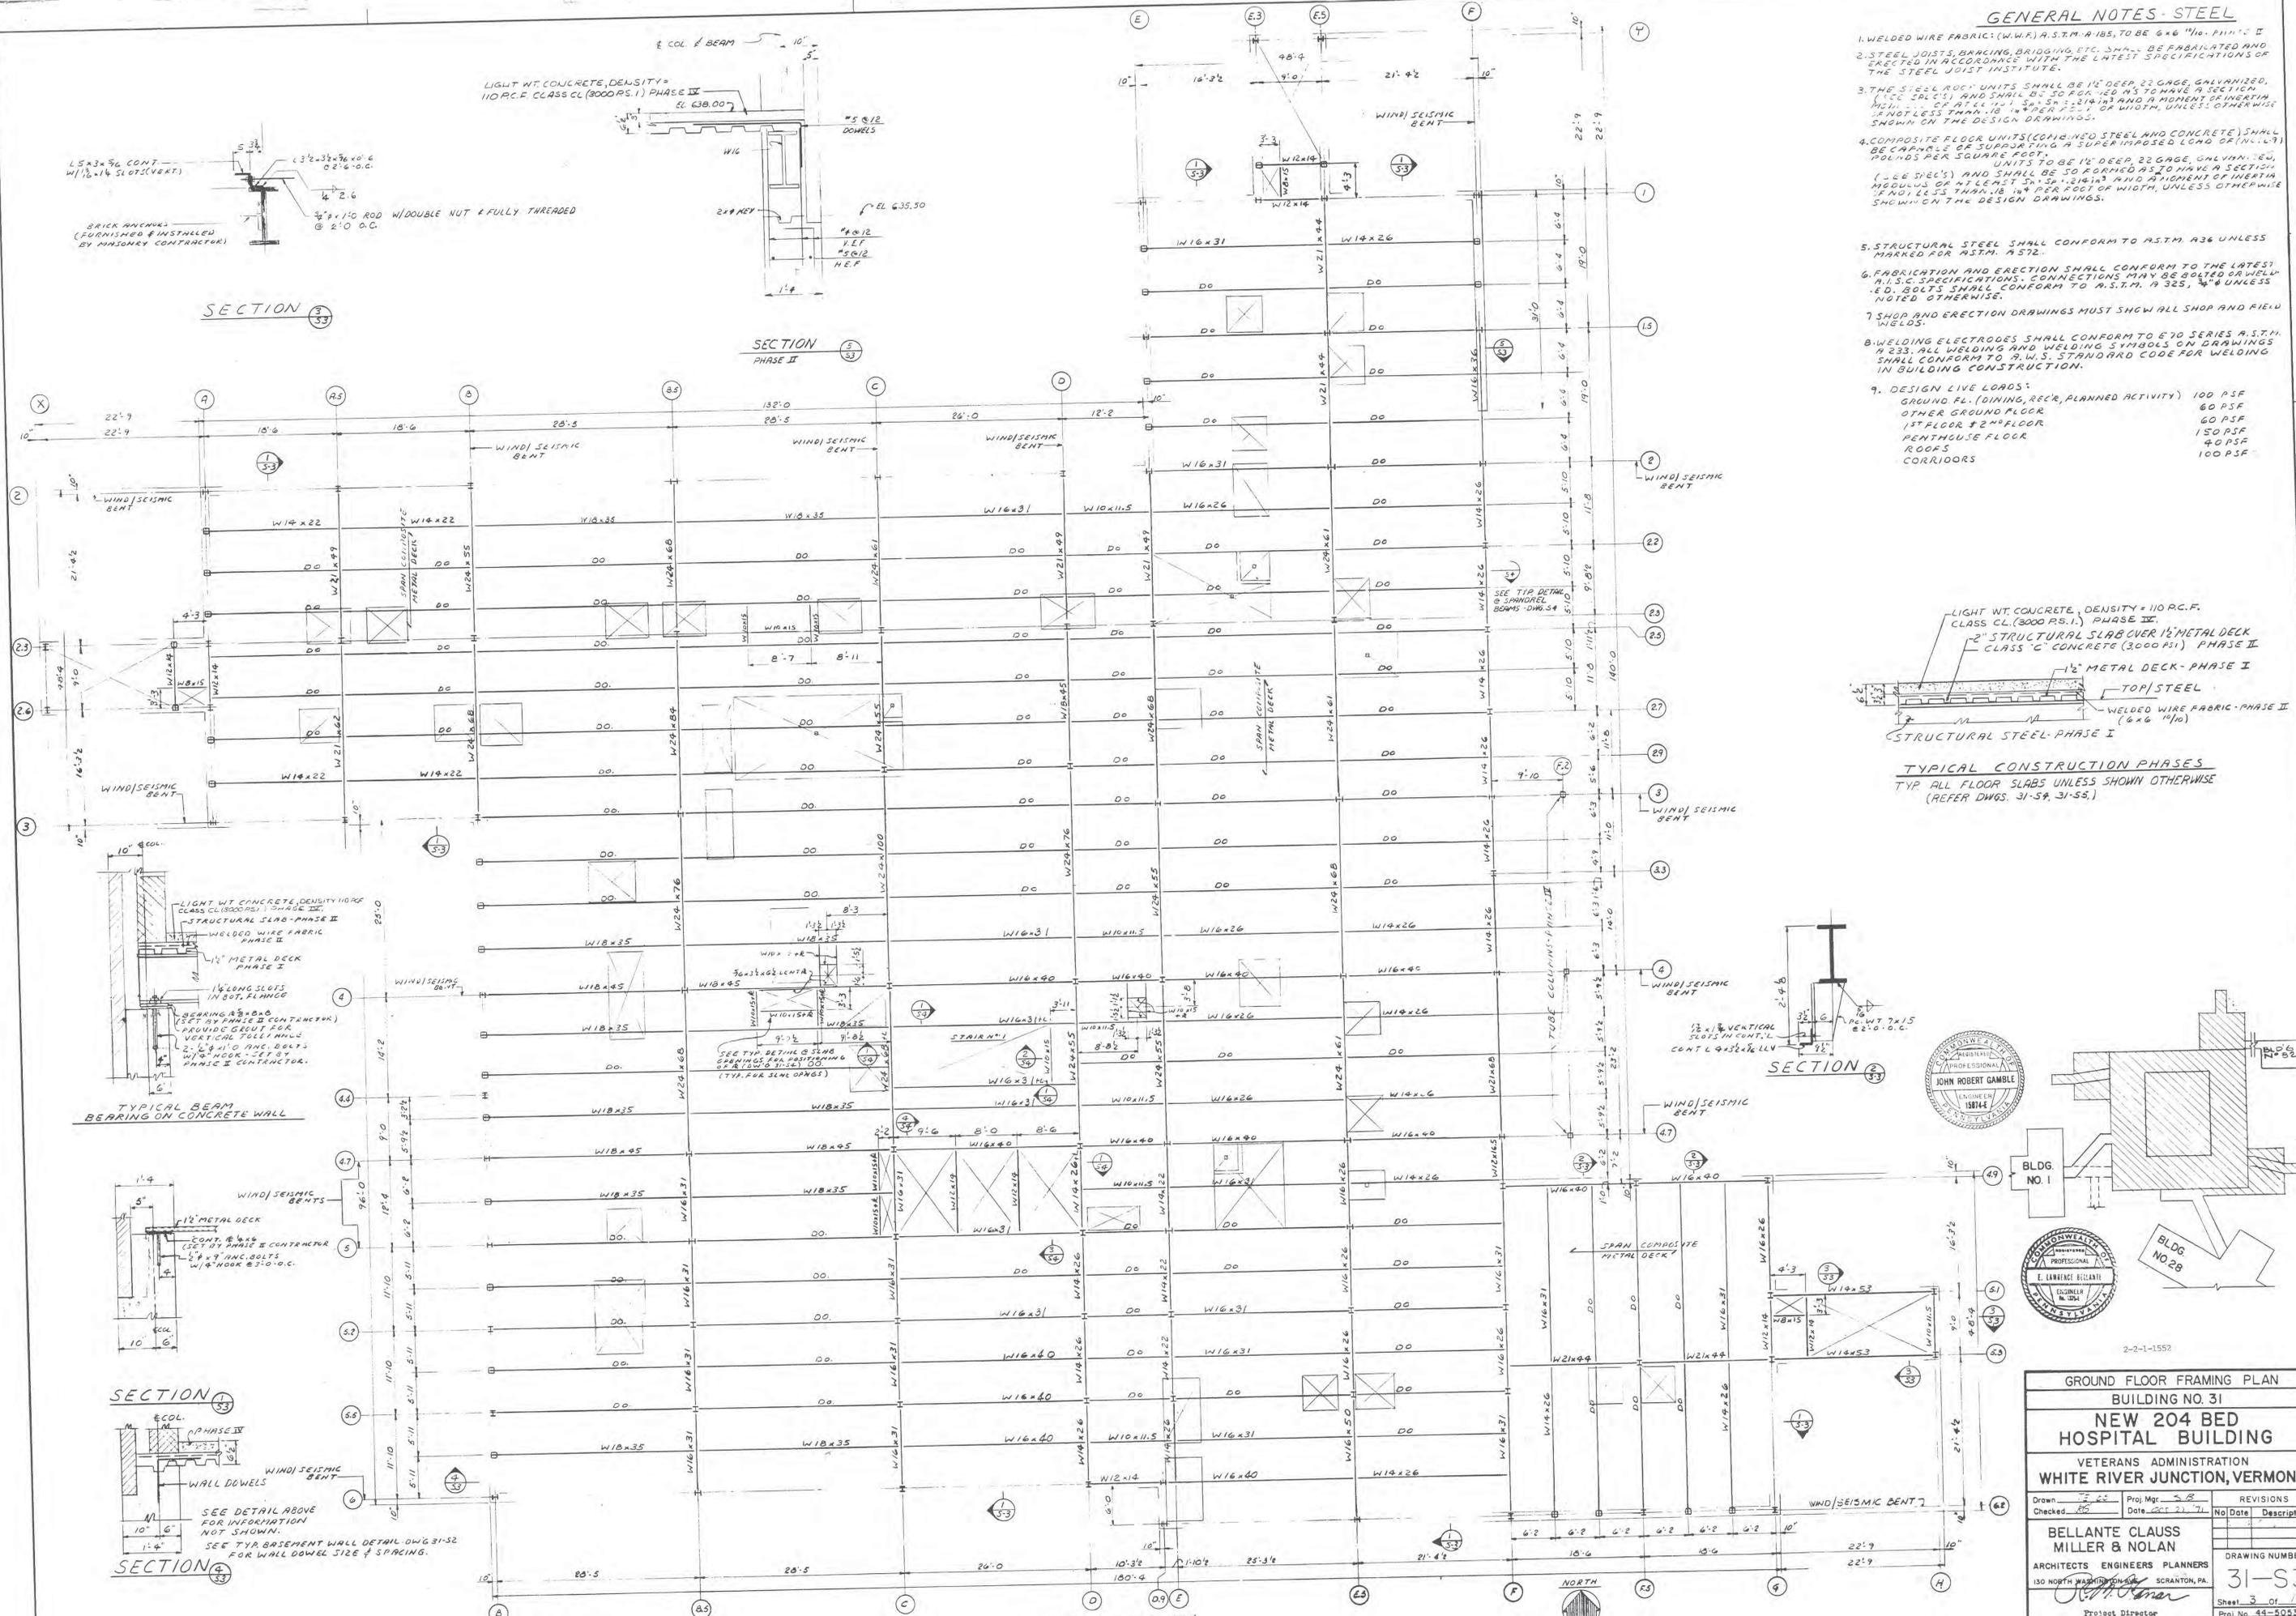


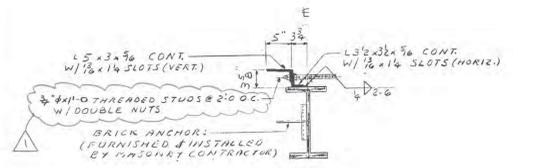


TYPICAL DETAIL @ SPANDREL BEAMS - U.N.

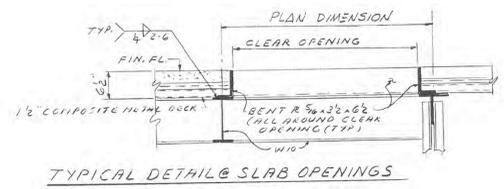


TYPICAL DETAIL @ SLAB OPENINGS

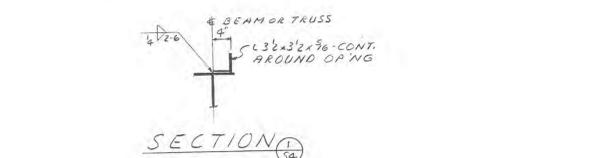

SECTION 1

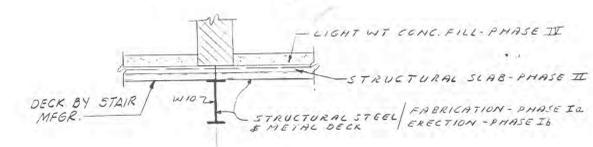


SECTION 2

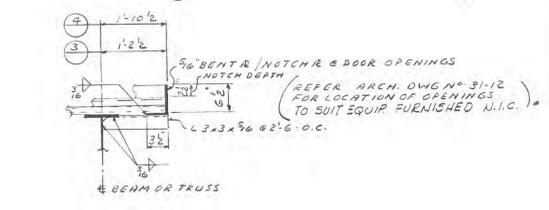


SECTION 3

SECTION 4 AS NOTED

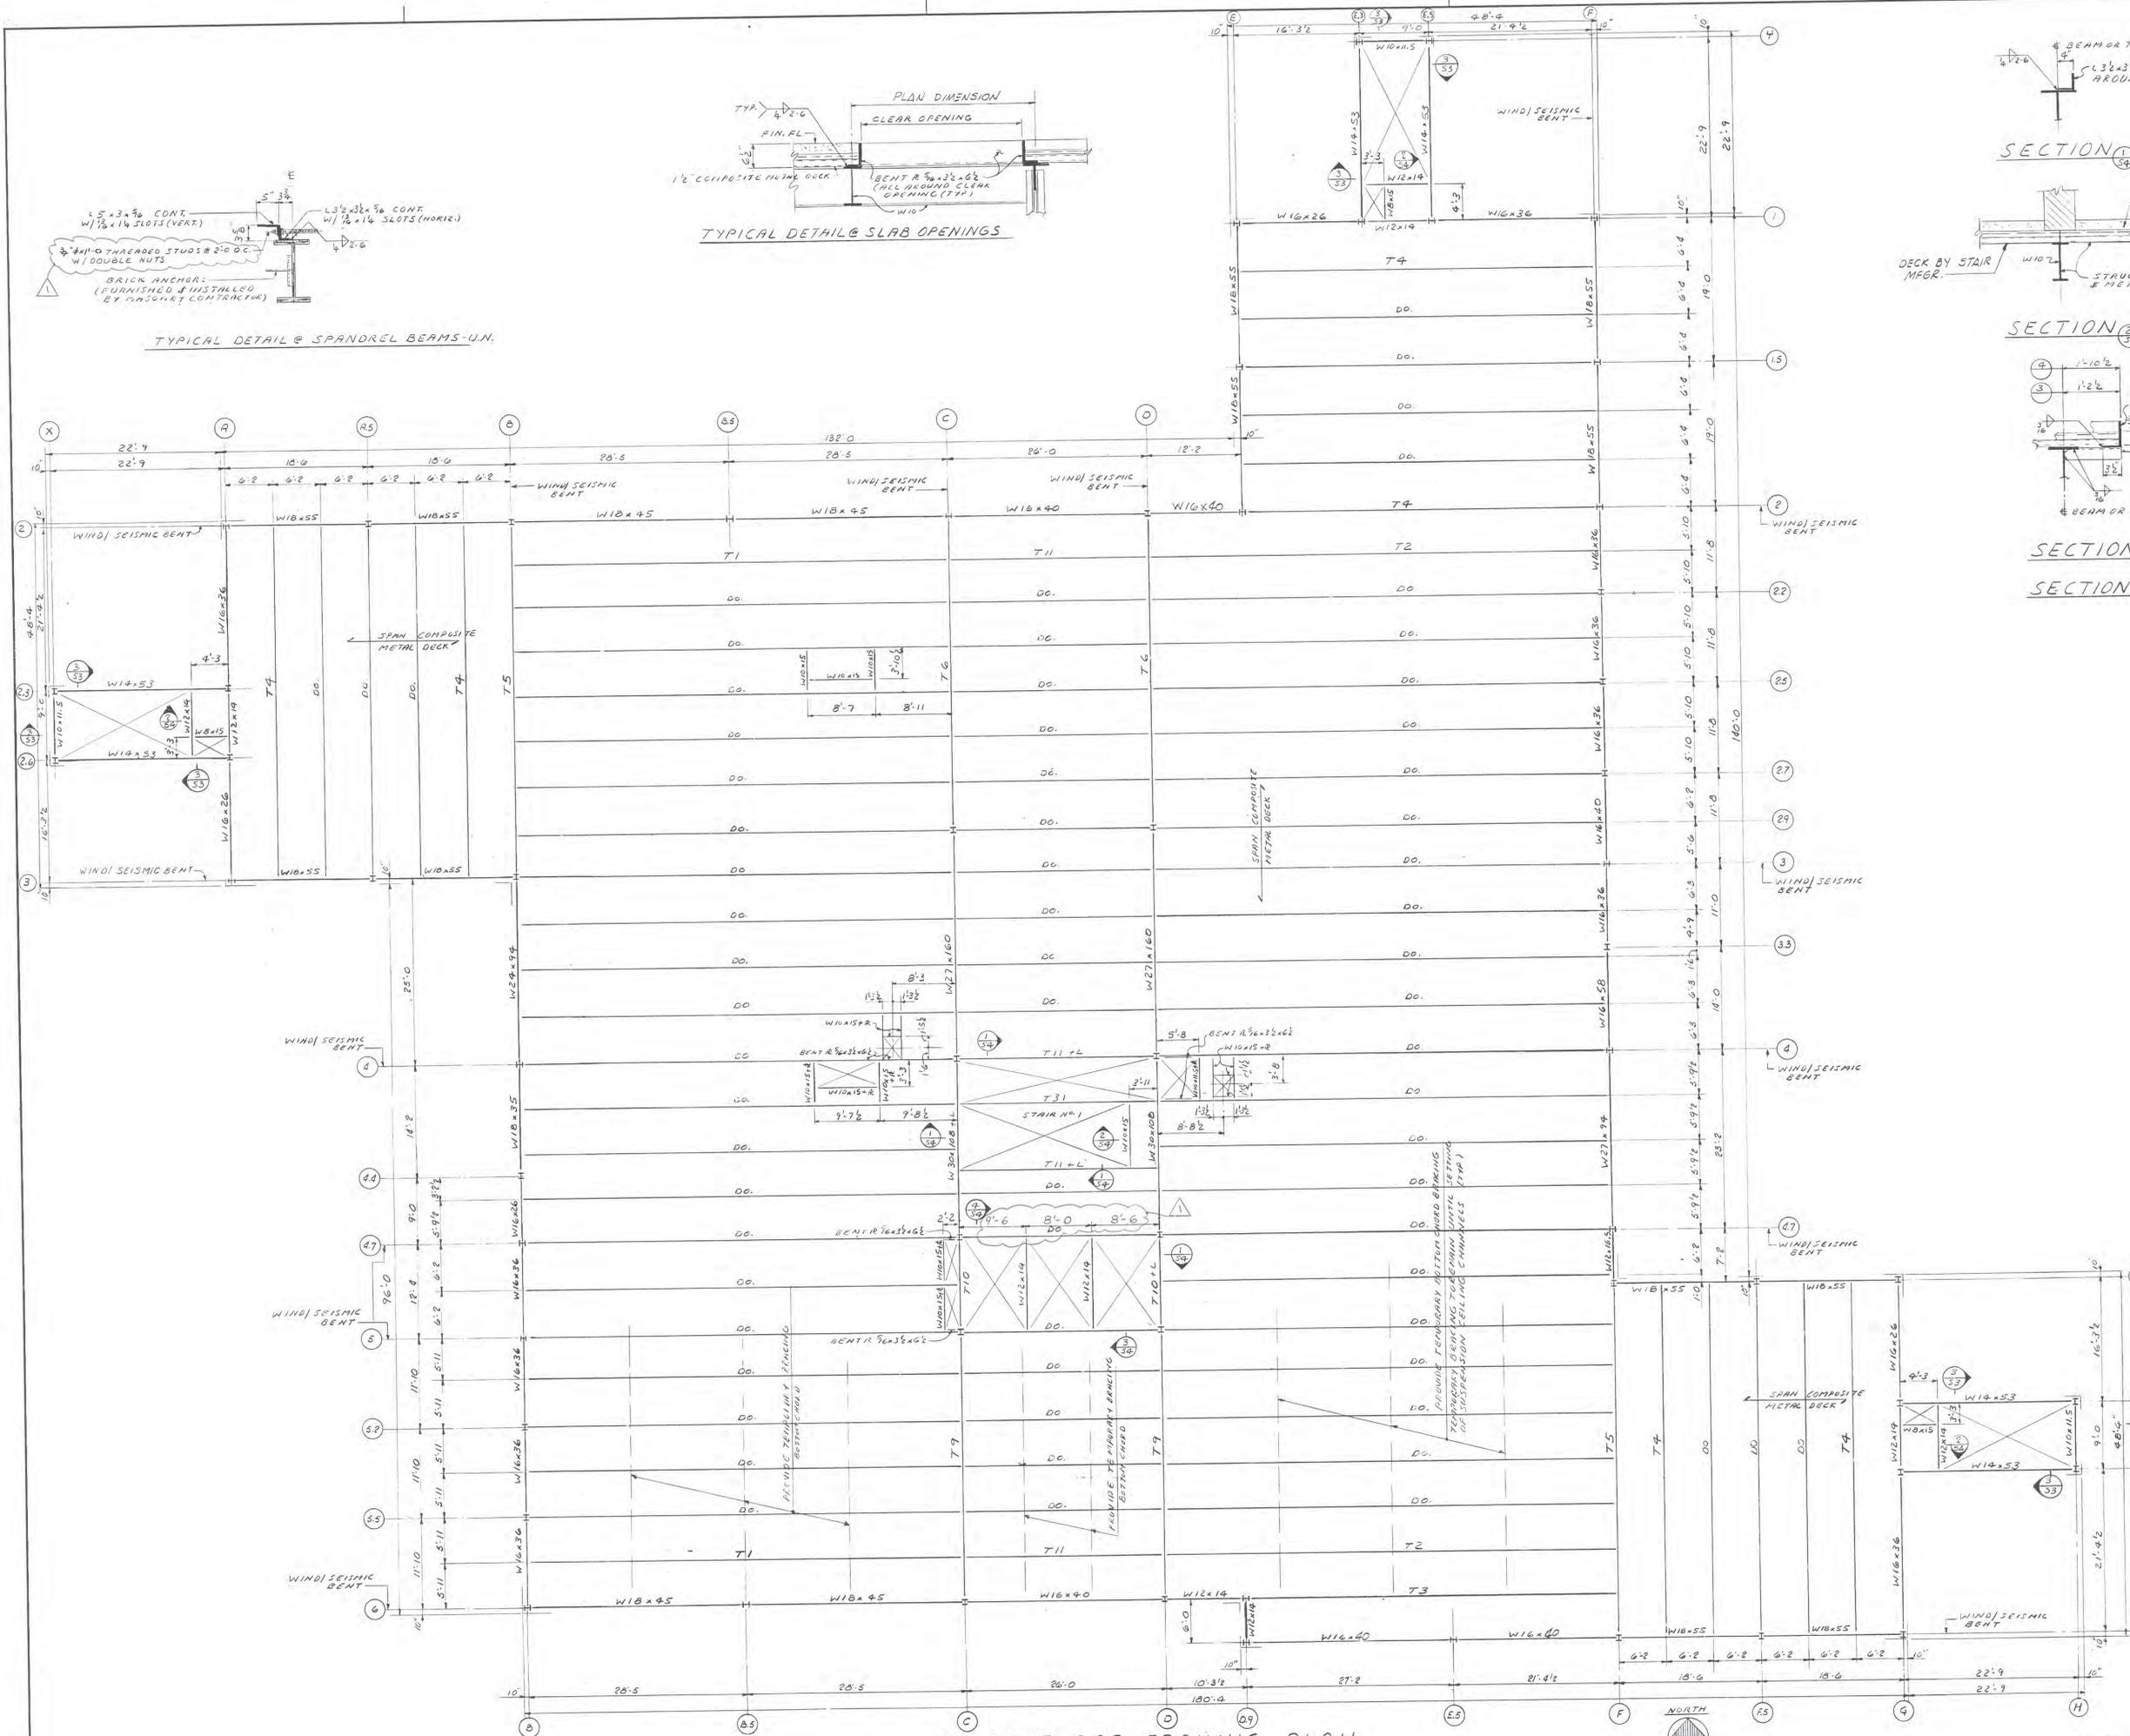


FIRST FLOOR FRAMING PLAN  
TOP STEEL EL. 650.79 SCALE 3/8" = 1'-0"

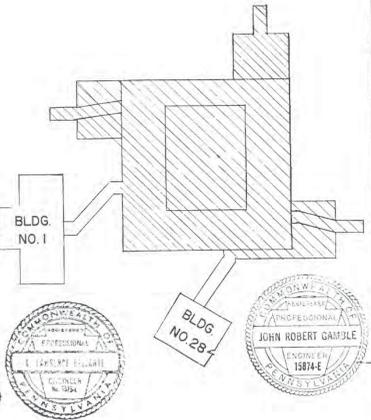


FIRST FLOOR FRAMING PLAN		BUILDING NO. 31	
NEW 204 BED HOSPITAL BUILDING			
VETERANS ADMINISTRATION WHITE RIVER JUNCTION, VERMONT			
Drawn: <u>SS/TE</u>	Proj. Mgr: <u>SB</u>	REVISIONS	
Checked: <u>ES</u>	Date: <u>3-12-71</u>	No.	Date Description
BELLANTE CLAUSS MILLER & NOLAN		1	AS BUILT
ARCHITECTS ENGINEERS PLANNERS		DRAWING NUMBER	
130 NORTH WASHINGTON AVE. SCRANTON, PA.		31-S4	
Project Director: <u>[Signature]</u>		Sheet 4 of 9	
Proj. No. 44-5083		2-2-1-1595	

FILE FOLDER NO. 24


RETURN TRACINGS TO PLAN LIBRARY

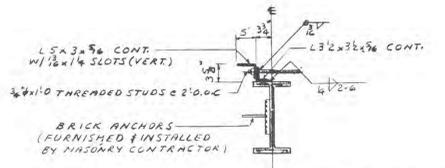


TYPICAL DETAIL & SPANDREL BEAMS  
SECTION 4-5

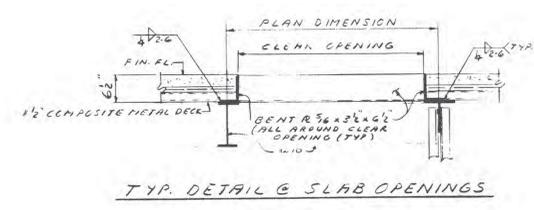

TYP. DETAIL @ SLAB OPENINGS

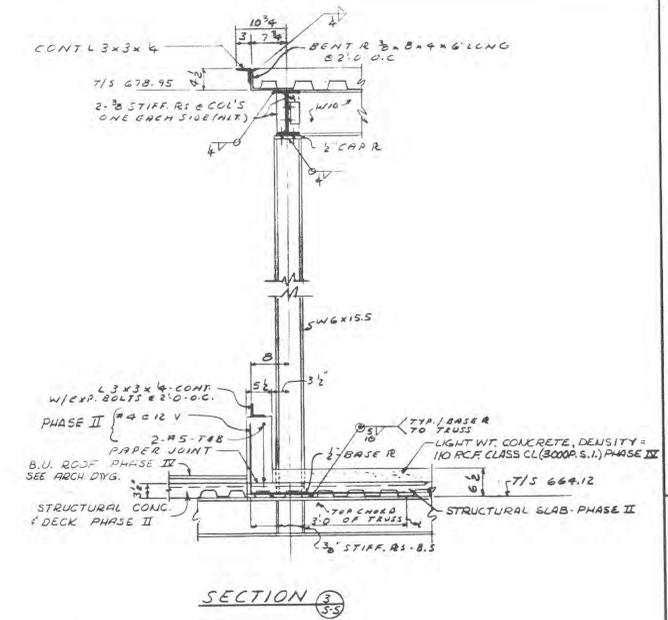


SECTION 3-3

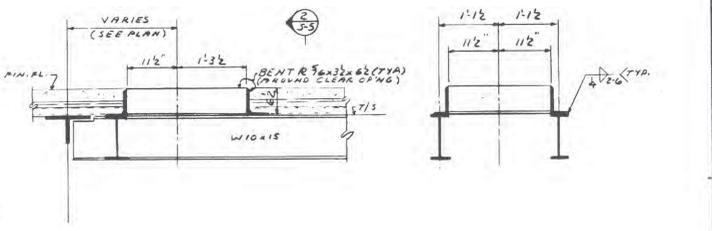


SECTION 1-1

SECTION 2-2

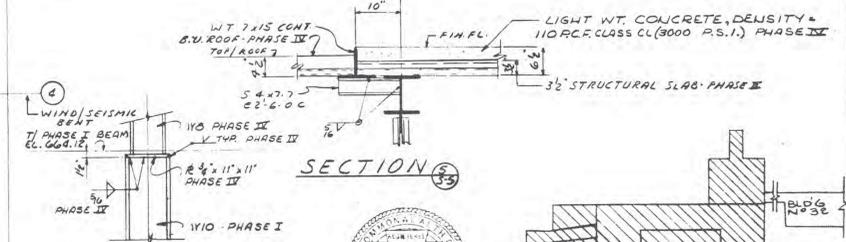

SECTION 5-5

DETAIL @ COLS.  
F.5-4.9 & G.4.9

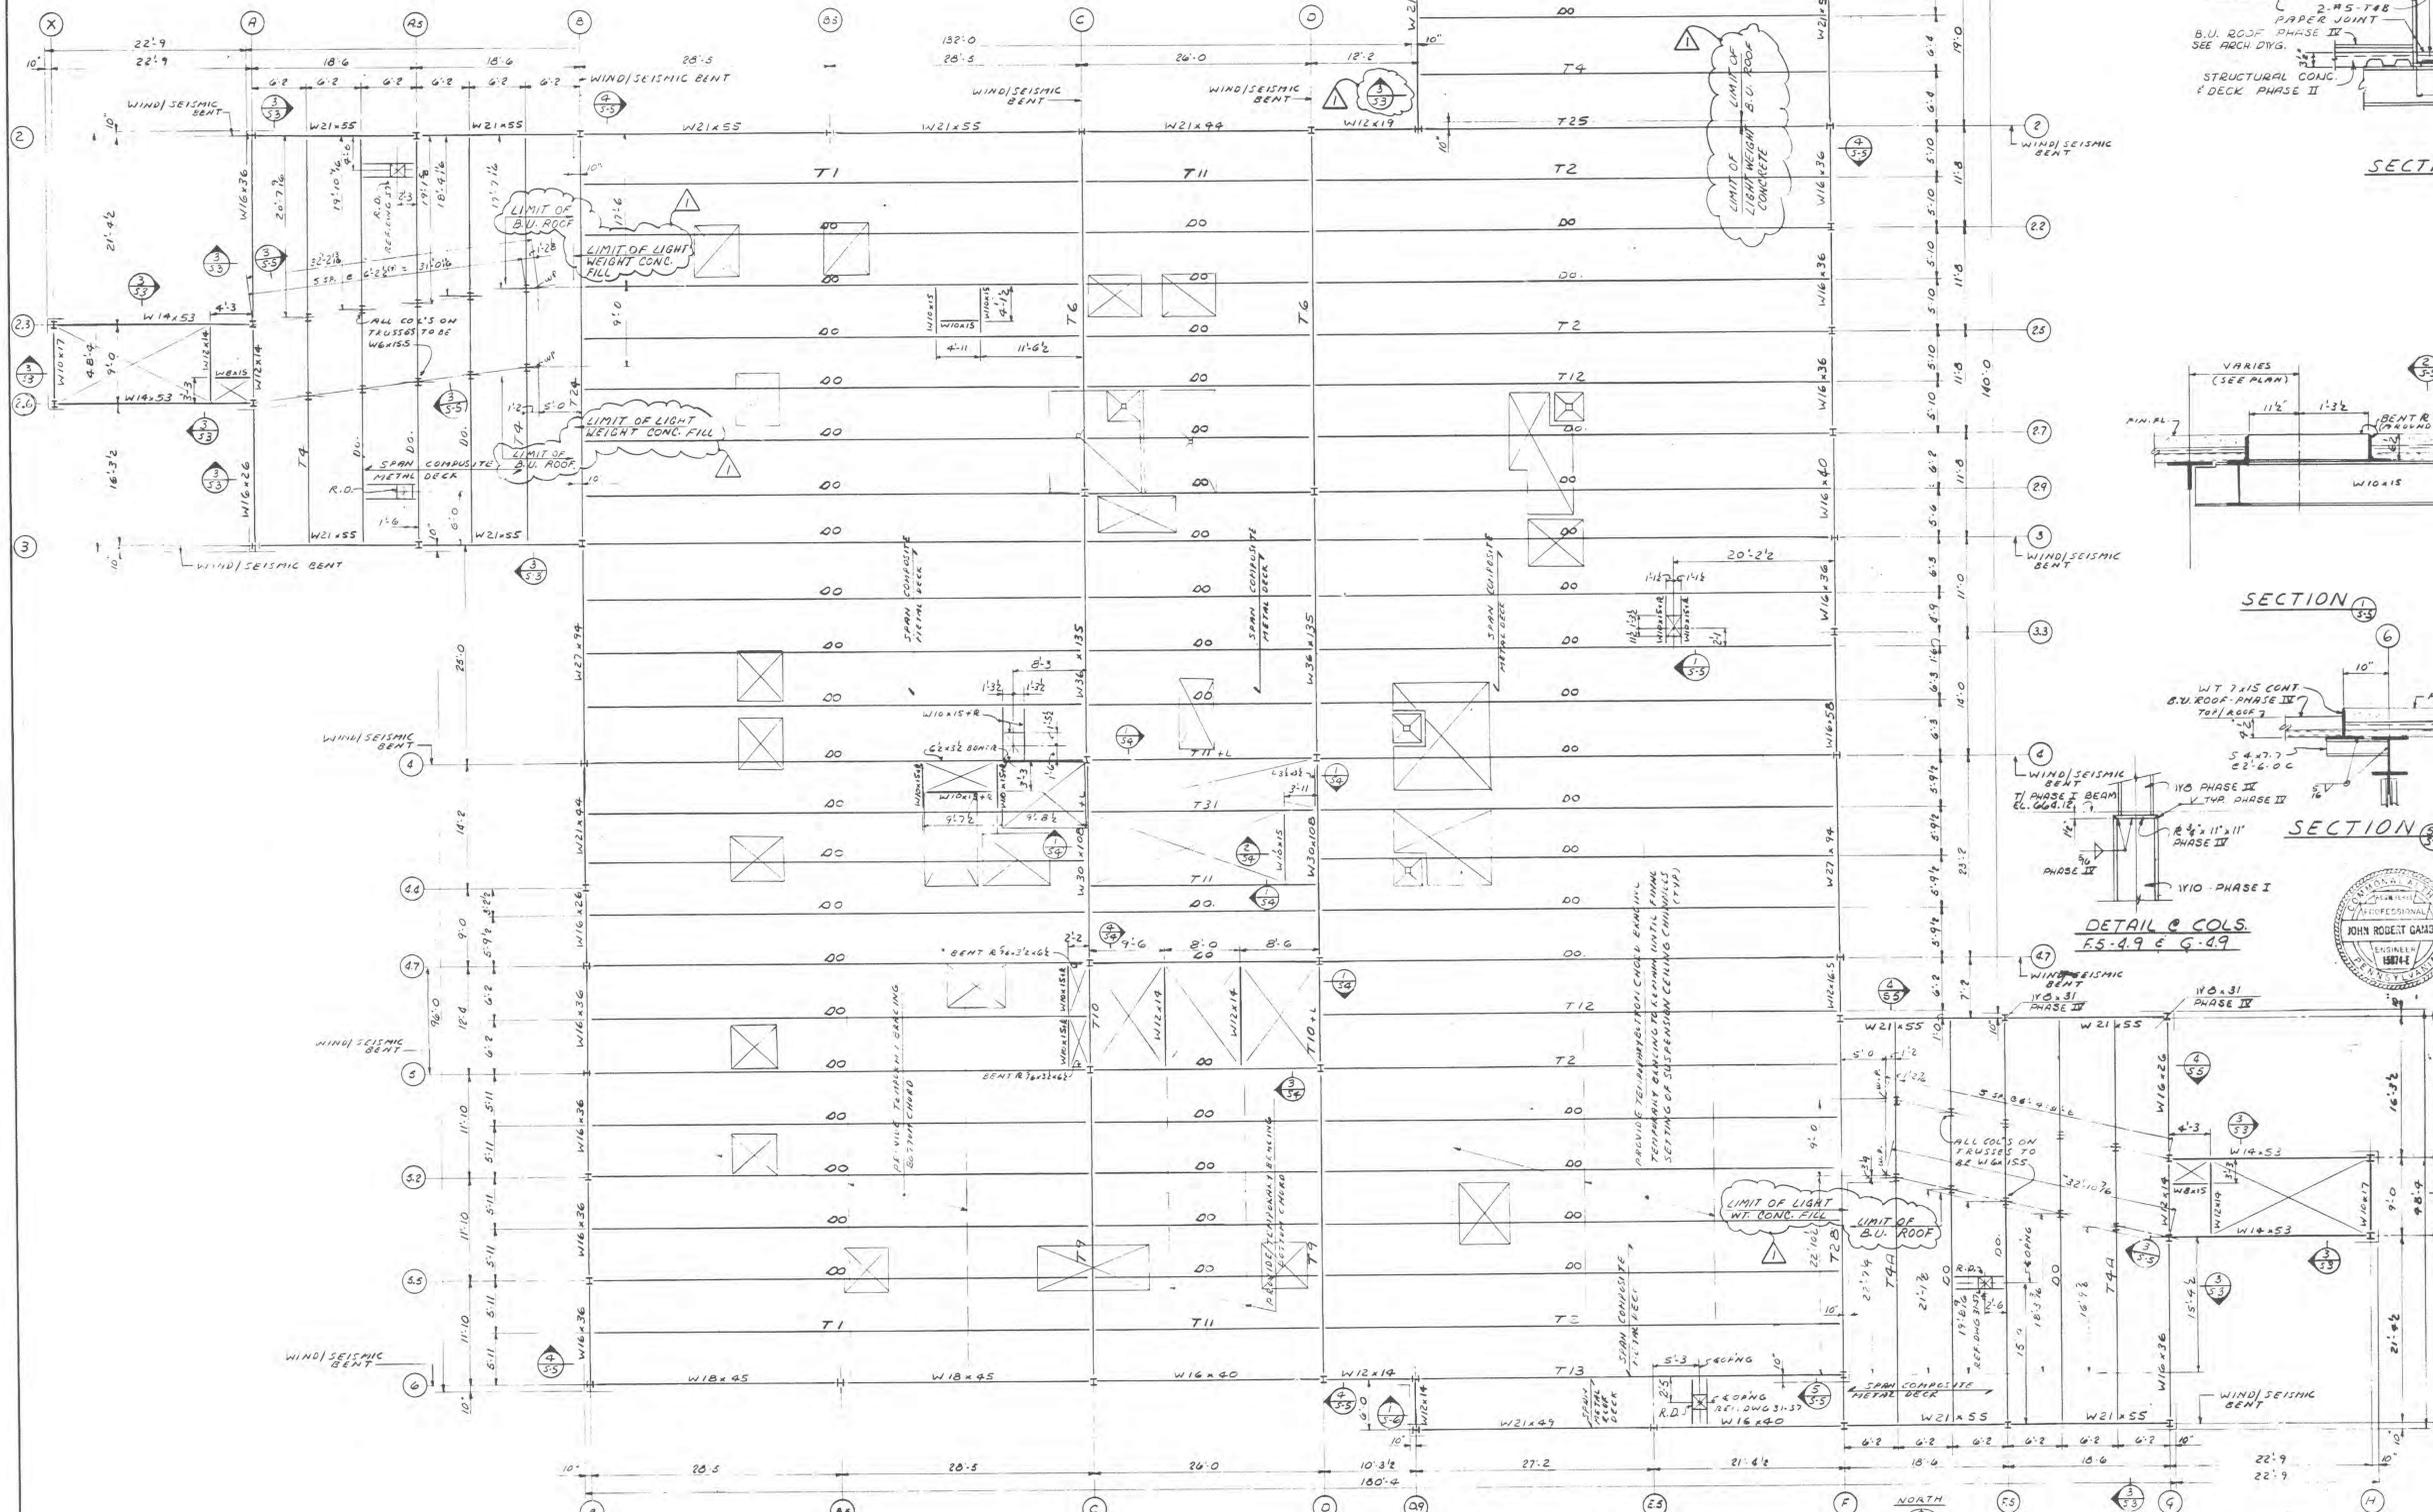


SECOND FLOOR & PARTIAL ROOF FRAMING PLAN  
TOP OF STEEL EL. 664.12 SCALE 1/8" = 1'-0"




SECOND FLOOR & PARTIAL ROOF PLAN		BUILDING NO. 31	
NEW 204 BED HOSPITAL BUILDING		VETERANS ADMINISTRATION	
WHITE RIVER JUNCTION, VERMONT		REVISIONS	
Drawn	Proj Mgr	No	Date
Checked	Date	Description	
BELLANTE CLAUS MILLER & NOLAN		DRAWING NUMBER	
ARCHITECTS ENGINEERS PLANNERS		31-S5	
130 NORTH WASHINGTON AVE. SCRANTON, PA.		Sheet 5 of 13	
Proj No. 44-5053		2-2-1-1554	


RETURN TRACINGS TO PLAN LIBRARY

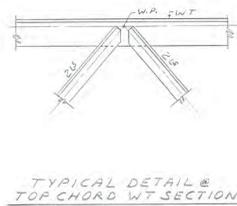


TYPICAL DETAIL @ TOP CHORD WT SECTION

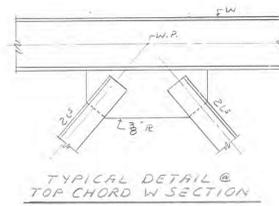


TYPICAL DETAIL @ TOP CHORD W SECTION

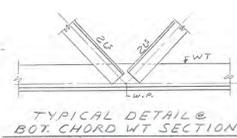


TYPICAL DETAIL @ BOT. CHORD WT SECTION

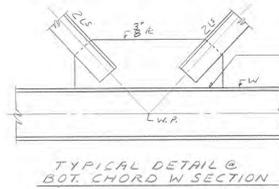


TYPICAL DETAIL @ BOT. CHORD W SECTION

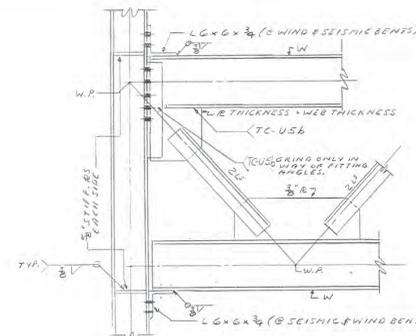


TYPICAL DETAIL @ TRUSS TO COLUMN FLANGE

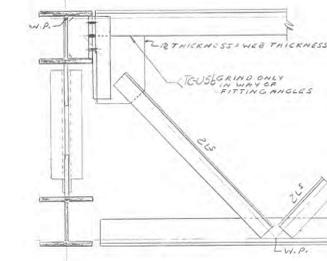


TYPICAL DETAIL @ TRUSS TO TRUSS

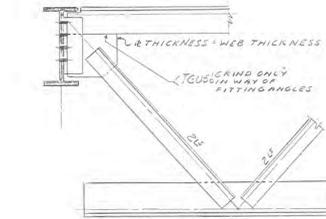

TYPICAL DETAIL @ TRUSS TO BEAM

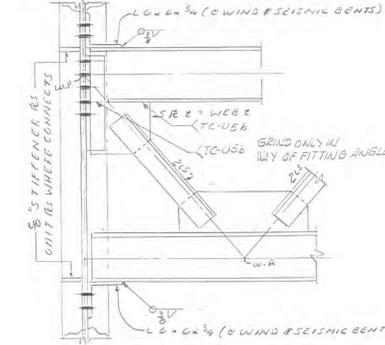


TYPICAL DETAIL @ TRUSS TO COLUMN WEB

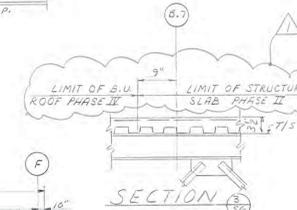


SECTION 30


NOTE: SEE TRUSS DRAWINGS FOR MEMBER SIZES.

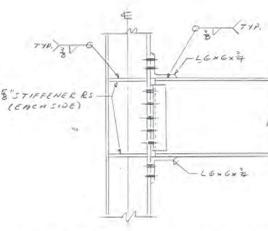


BEAM TO COL. FLG MOMENT CONN. @ WIND/SEISMIC BENTS

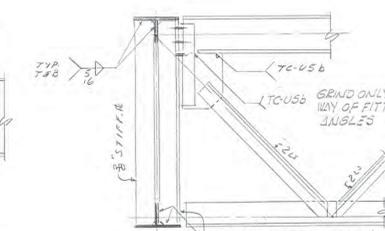


TYP. DETAIL - BEAM TOP CHORD TO WT TOP CHORD CONN.

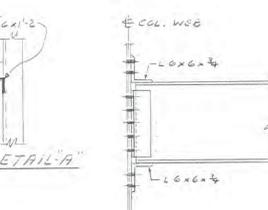


BEAM TO COL. WEB MOMENT CONN. @ WIND/SEISMIC BENT

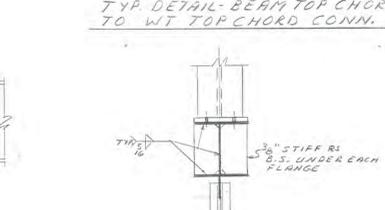

DETAIL COLUMNS ON TRANSFER TRUSSES

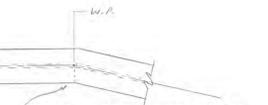


TYP. DETAIL OF BENT BEAM @ MAIN ROOF PASSAGE TO STAIR TOWER

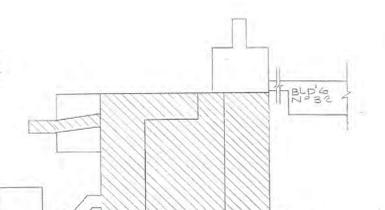

BLDG NO. 28



BLDG NO. 31

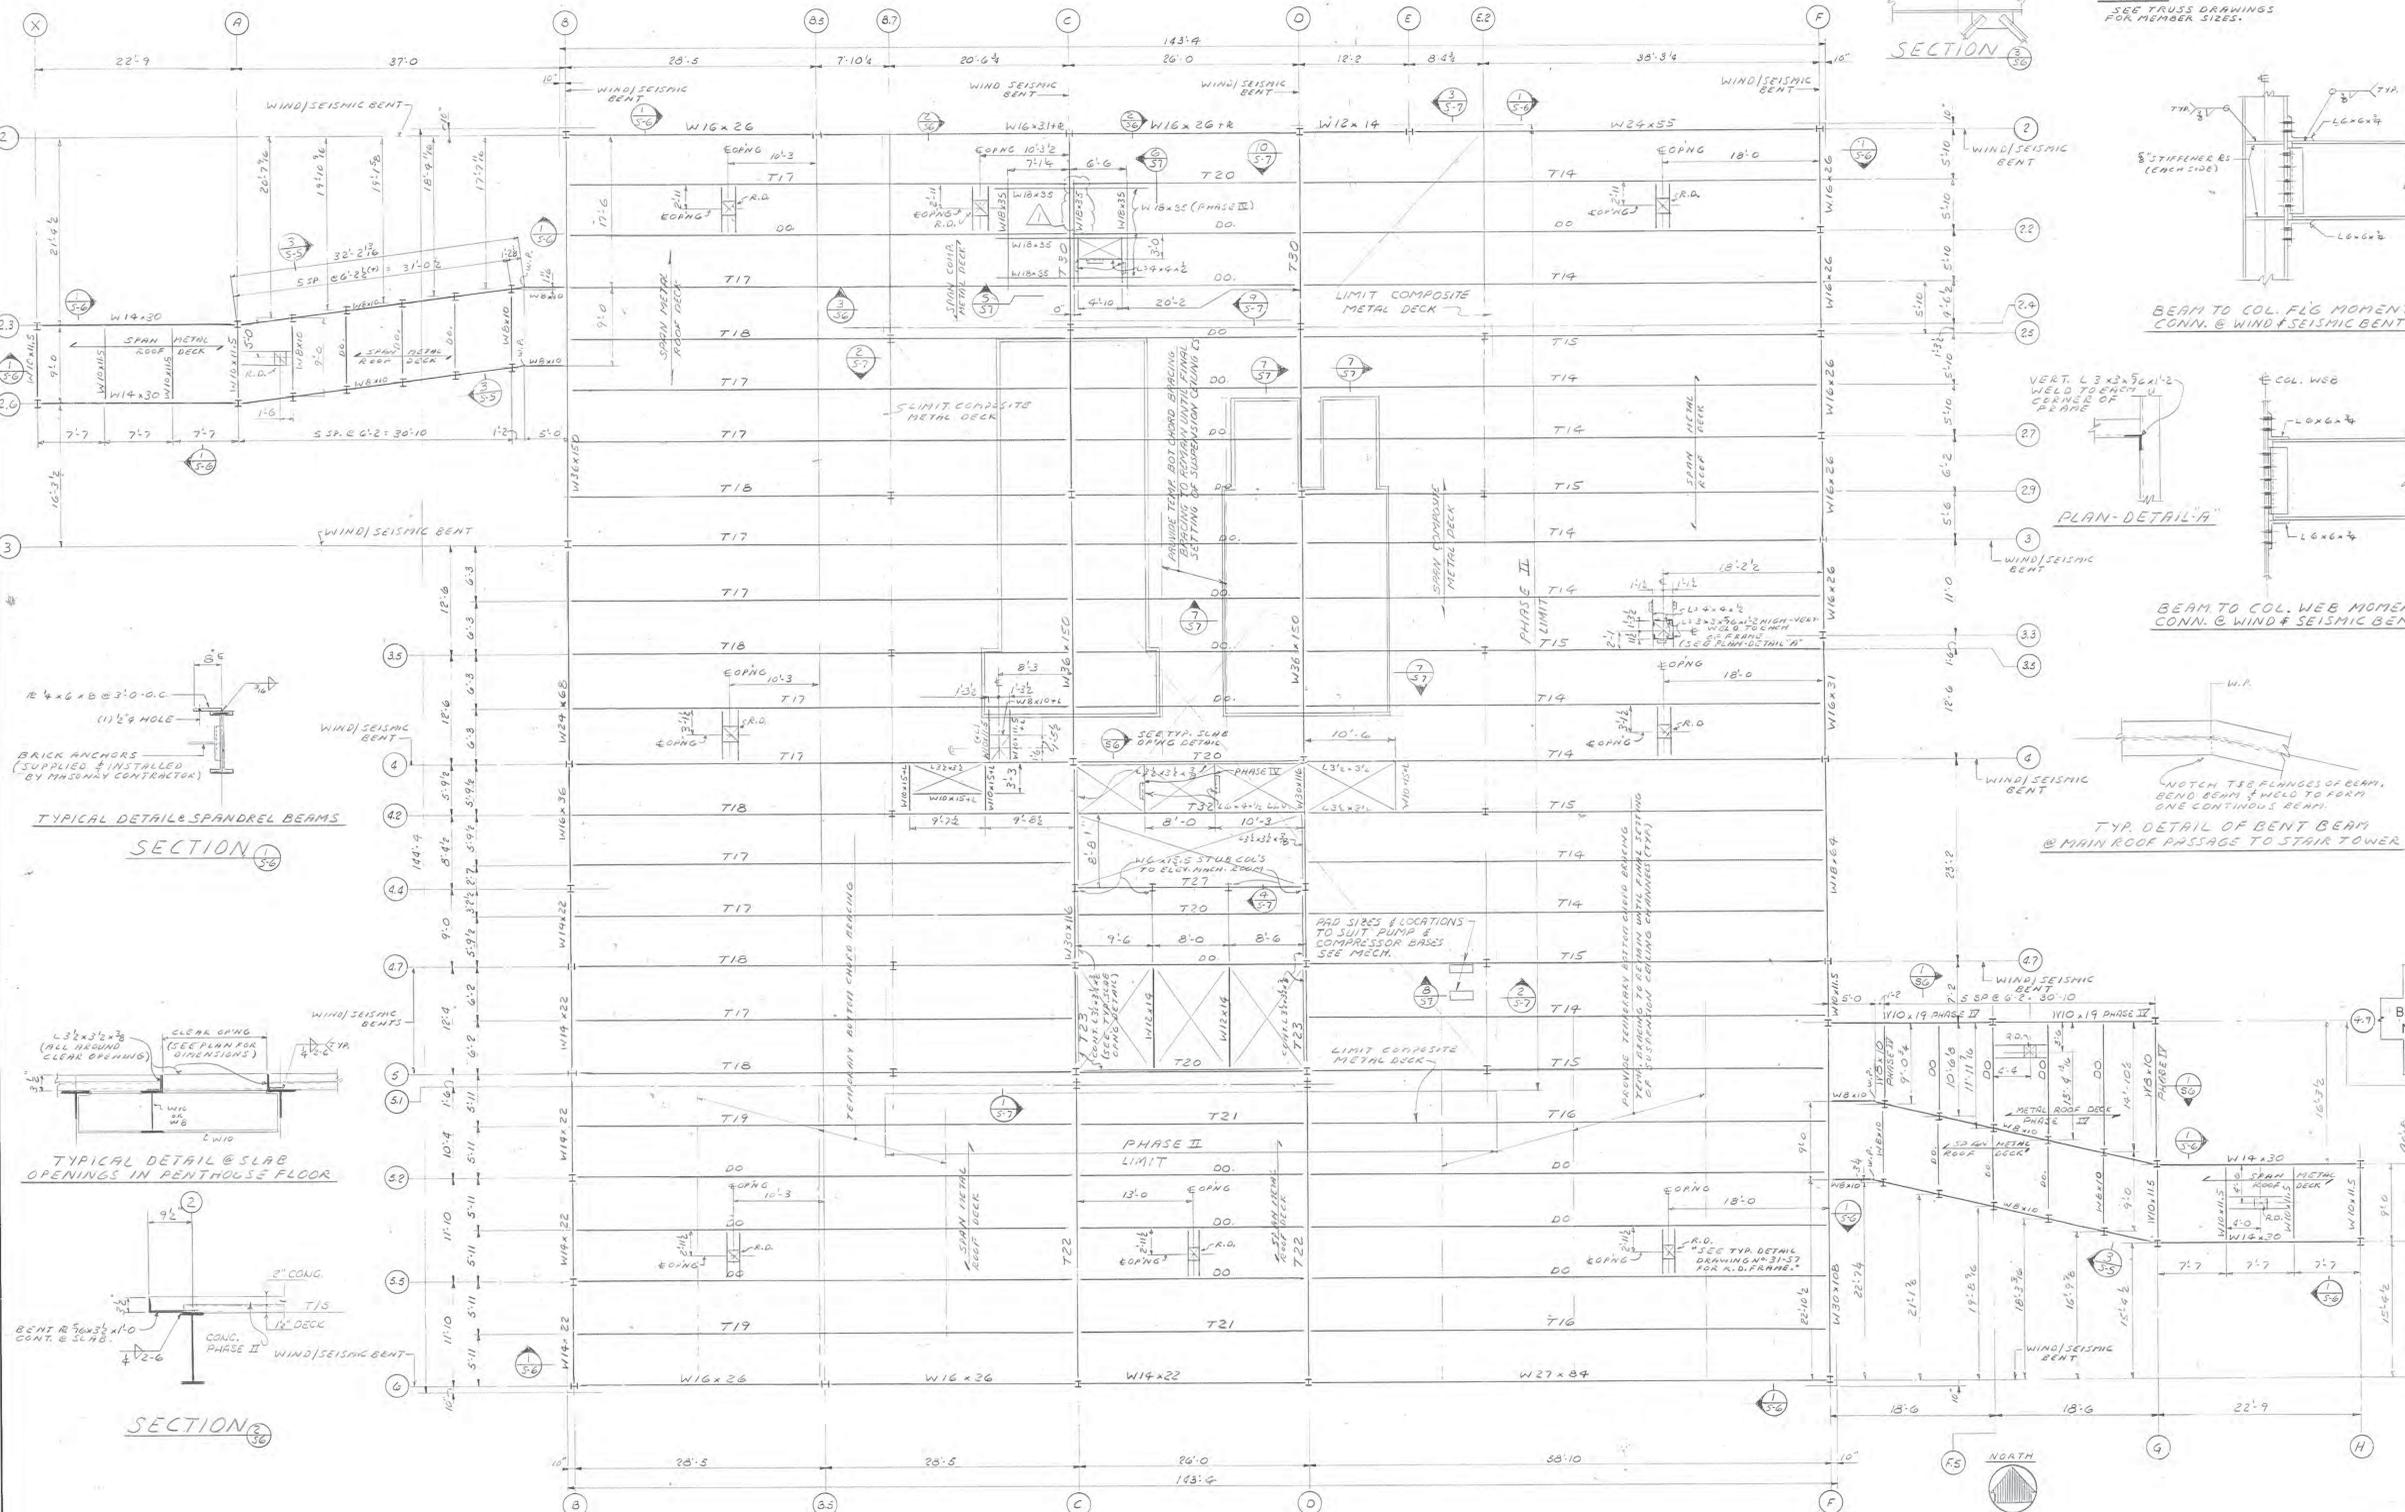



















ROOF FRAMING PLAN TOP/STEEL EL. 678.95 SCALE 1/8"=1'-0"

MAIN ROOF FRAMING PLAN		BUILDING NO. 31	
NEW 204 BED		HOSPITAL BUILDING	
VETERANS ADMINISTRATION WHITE RIVER JUNCTION, VERMONT			
Drawn: J.C.	Proj. Mgr.: S.B.	REVISIONS	
Checked: J.C.	Date: 2/17/71	No. Date Description	
BELLANTE CLAUS MILLER & NOLAN		ARCHITECTS ENGINEERS PLANNERS	
130 NORTH WASHINGTON ST. SCRANTON, PA.		DRAWING NUMBER	
31-S6		Sheet 6 of 11	
Proj. No. 44-5053.C			

2-2-1-1576

RETURN TRACINGS TO PLAN LIBRARY



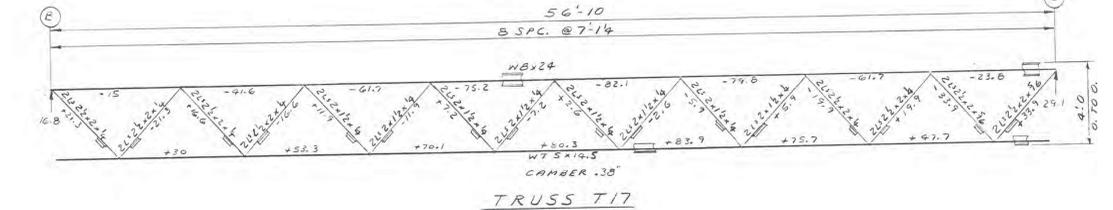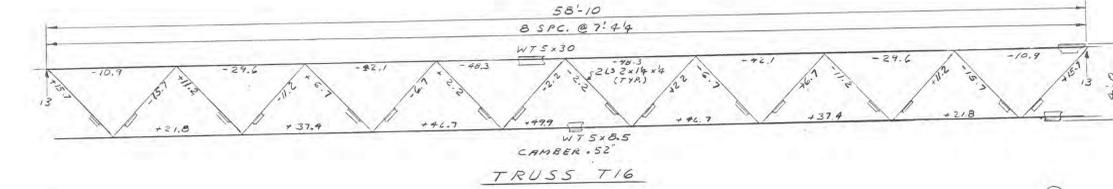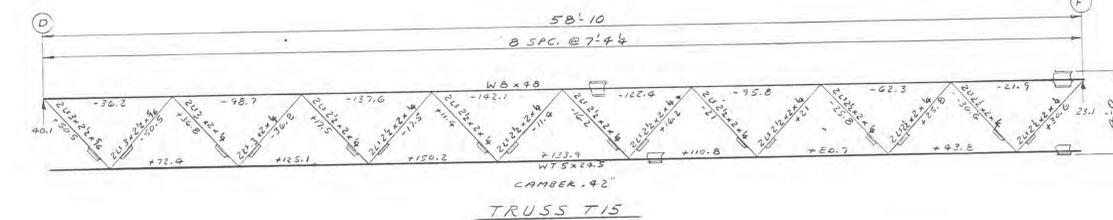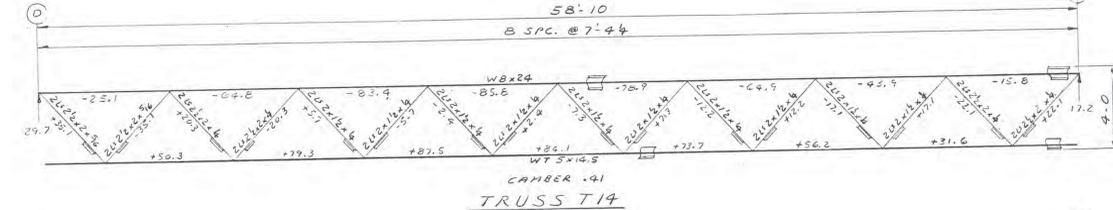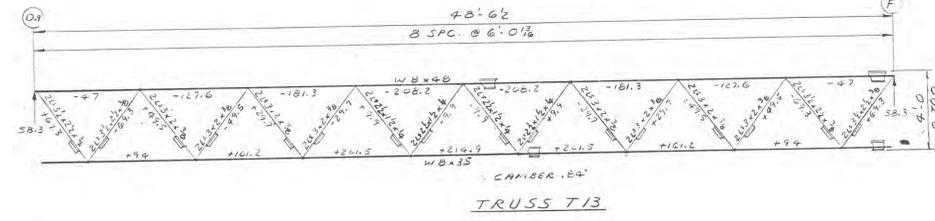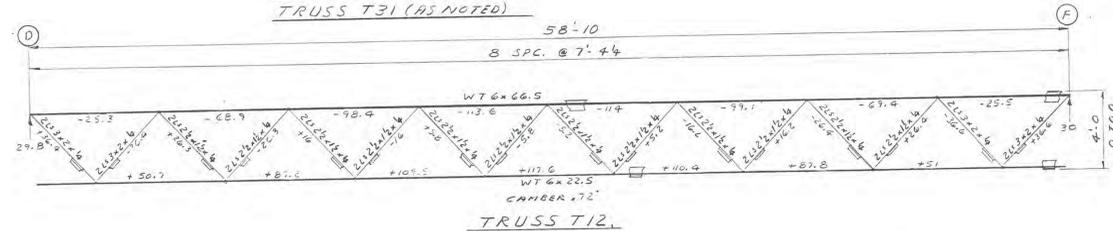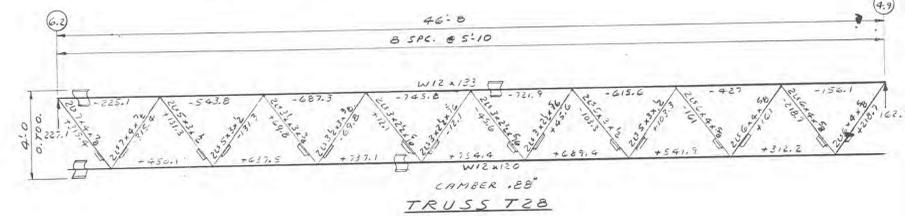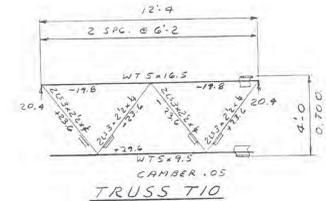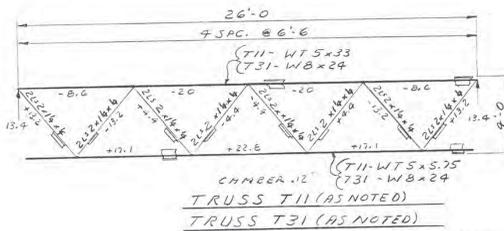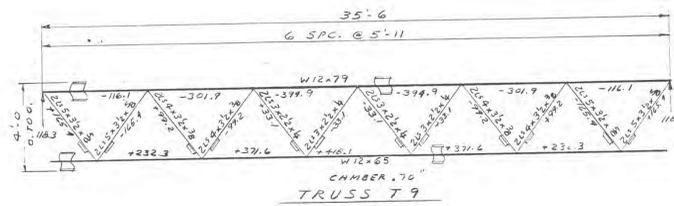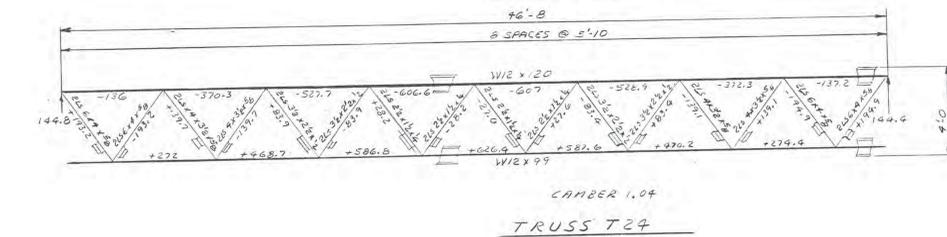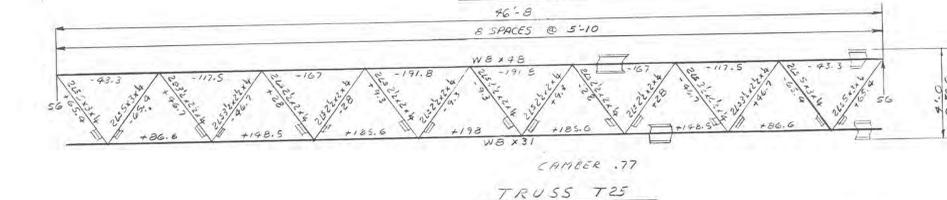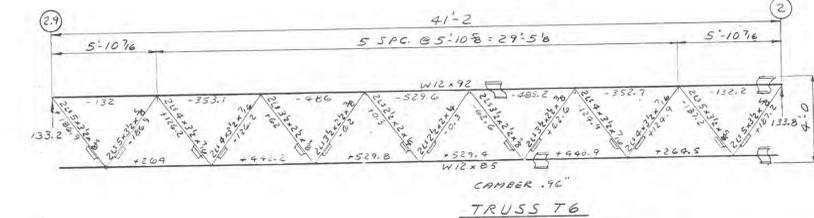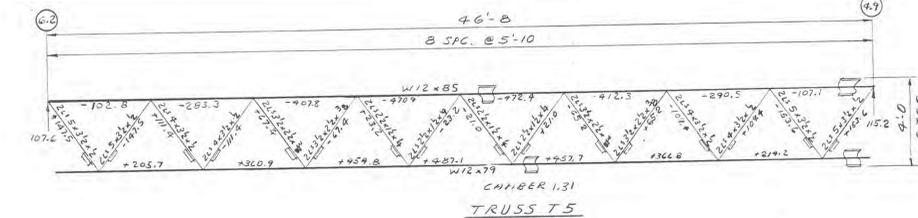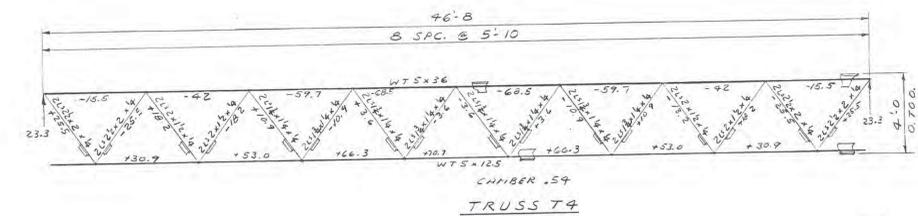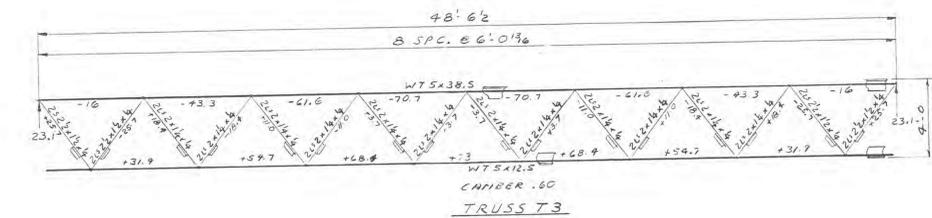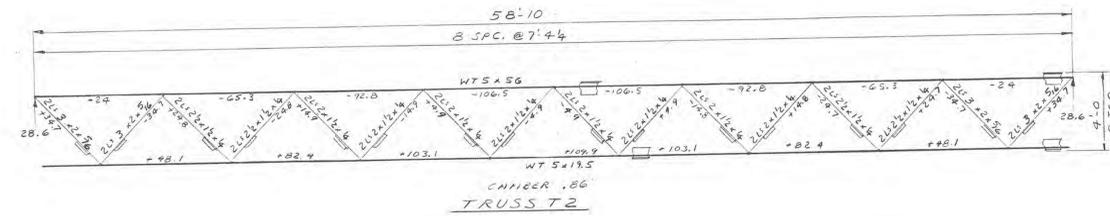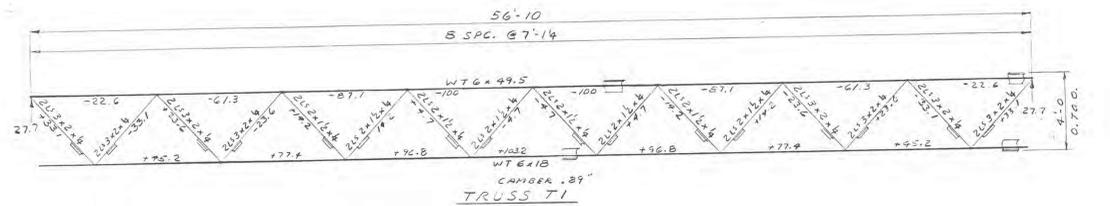


NOTE:  
1. ALL STRESSES NOTED ARE SHOWN IN KIPS.  
+ TENSION  
- COMPRESSION  
2. DIAGONAL MEMBERS TO HAVE LONG LEG VERTICAL.  
3. STITCH RS. TO BE MIDWAY BETWEEN WORKING POINTS, & ARE TO BE THE SAME THICKNESS AS GUSSET RS. UNLESS WEB OF WT.



TRUSS DETAILS		BUILDING NO. 31	
NEW 204 BED HOSPITAL BUILDING		VETERANS ADMINISTRATION	
WHITE RIVER JUNCTION, VERMONT		REVISIONS	
Drawn: T.E.	Proj. Mgr.: D.P.	No.:	Description:
Checked: A.G.	Date: 2-16-71		
BELLANTE CLAUSS MILLER & NOLAN		DRAWING NUMBER	
ARCHITECTS ENGINEERS PLANNERS		31-S8	
150 NORTH WASHINGTON ST. SCRANTON, PA.		Sheet 8 of 9	
Project Director		Proj. No. 44-50433	


2-2-1-1569

RETURN TRACINGS TO PLAN LIBRARY

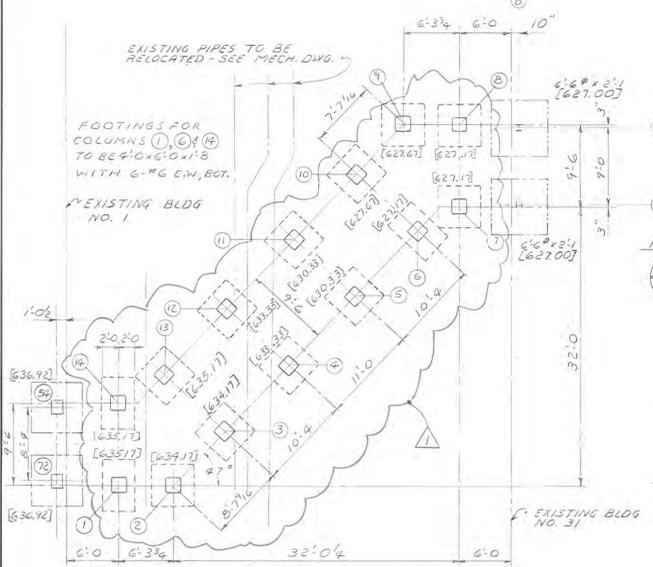


**FOUNDATION PLAN**

SCALE: 1/8"=1'-0"  
TOP/FTG. EL. SHOWN THUS ( ) ON PLAN.  
COLUMN FOOTINGS (UNLESS NOTED) TO BE 5'-0" x 6'-0" x 1'-8" WITH 8" #6 C.W. BOTTOM. SEE GROUND FLOOR FRAMING PLAN FOR GRADE BEAMS.

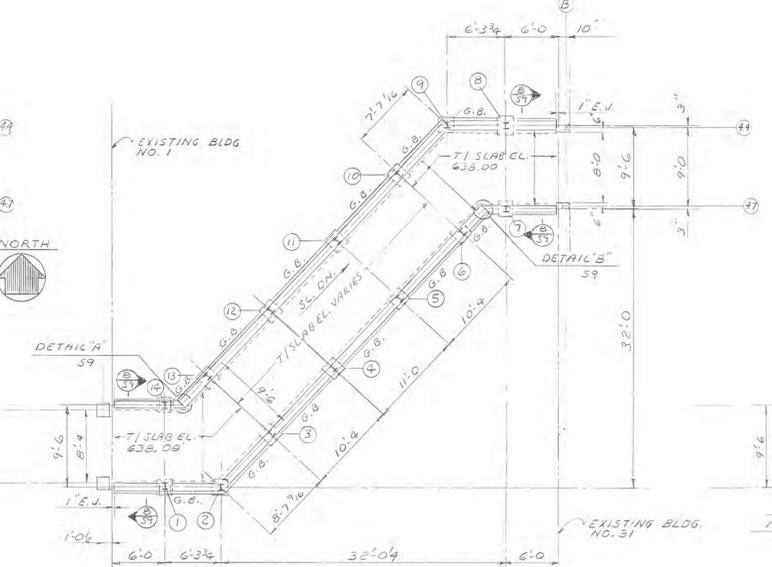


**GROUND FLOOR FRAMING PLAN**

G.B. = GRADE BEAM  
SCALE: 1/8"=1'-0"  
SEE DWG. NO. 31-51 & 31-53 FOR GENERAL NOTES

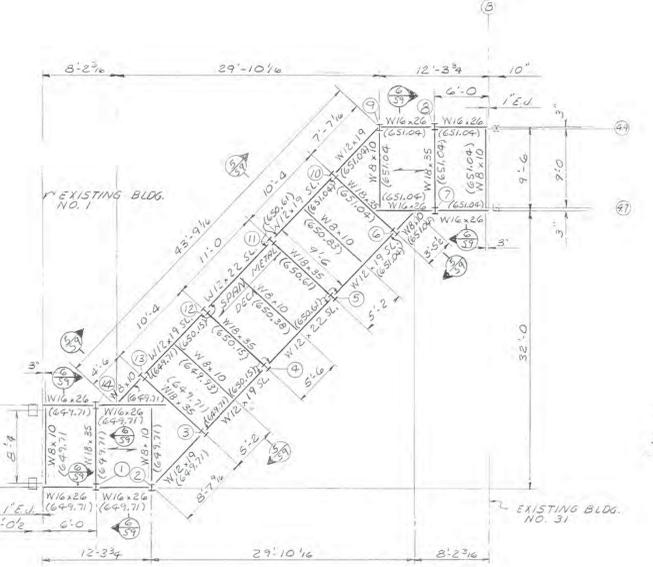


**FIRST FLOOR FRAMING PLAN**

TOP/STEEL EL. NOTED THUS ( ) ON PLAN.  
S.L. DENOTES SLOPED BEAM.  
SCALE: 1/8"=1'-0"

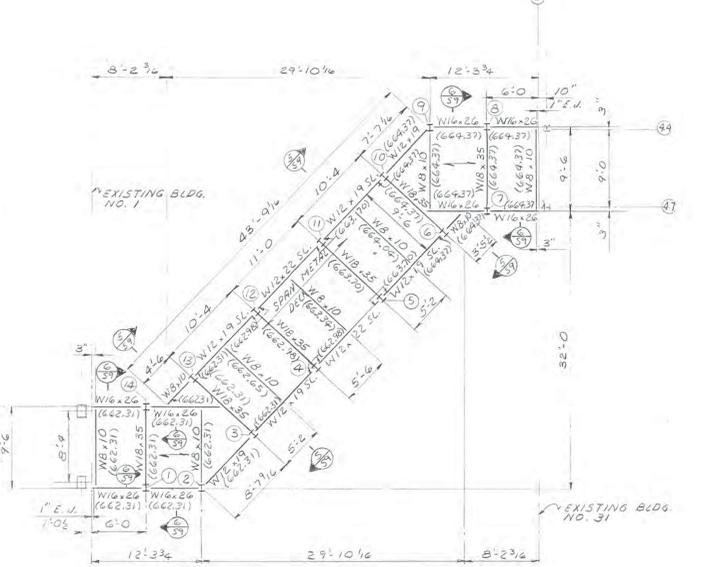


**SECOND FLOOR FRAMING PLAN**

TOP/STEEL EL. NOTED THUS ( ) ON PLAN.  
S.L. DENOTES SLOPED BEAM.  
SCALE: 1/8"=1'-0"

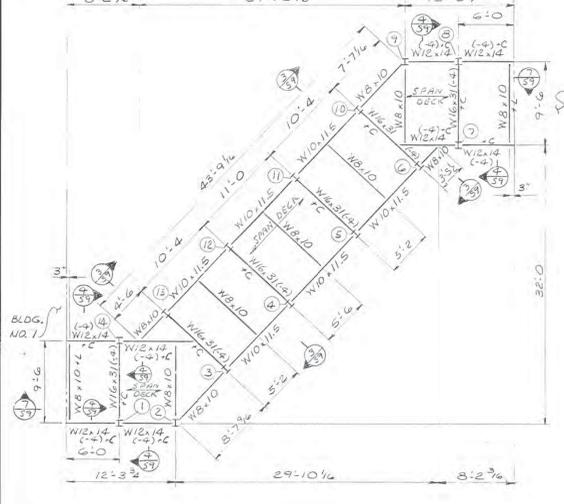


**ROOF FRAMING PLAN**

TOP/STEEL EL. 679.14 UNLESS NOTED THUS ( ) ON PLAN.  
SCALE: 1/8"=1'-0"

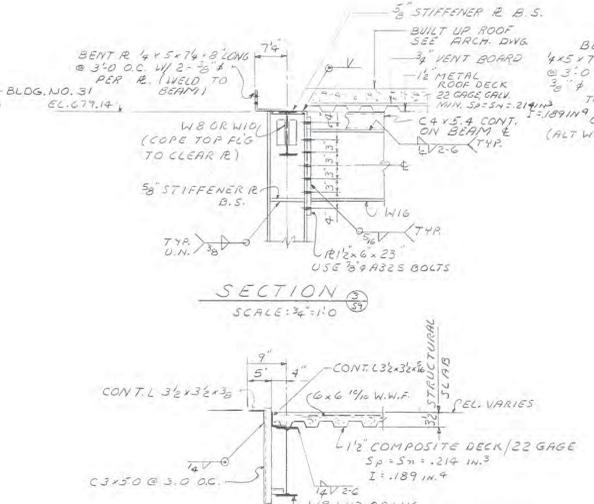


**TYP. SECTION THRU 1ST & 2ND FLOOR SPANDREL BEAMS**

SCALE: 3/4"=1'-0"

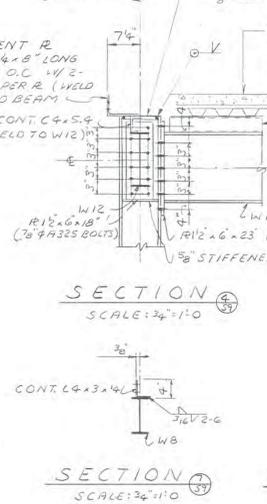


**TYP. SECTION THRU 1ST & 2ND FLOOR SPANDREL BEAMS**

SCALE: 3/4"=1'-0"

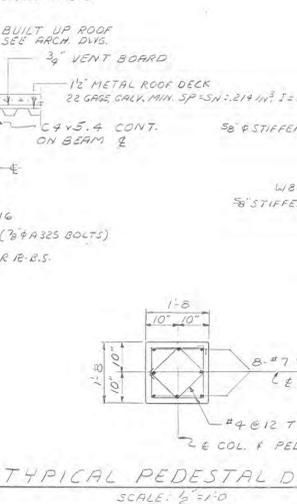


**TYP. SECTION THRU 1ST & 2ND FLOOR SPANDREL BEAMS**

SCALE: 3/4"=1'-0"

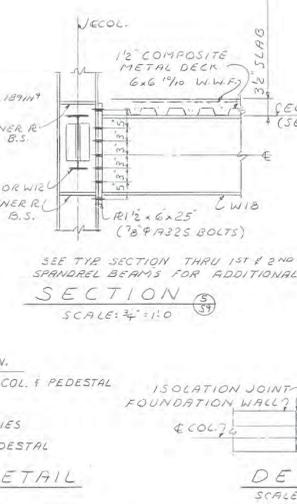


**TYP. SECTION THRU 1ST & 2ND FLOOR SPANDREL BEAMS**

SCALE: 3/4"=1'-0"

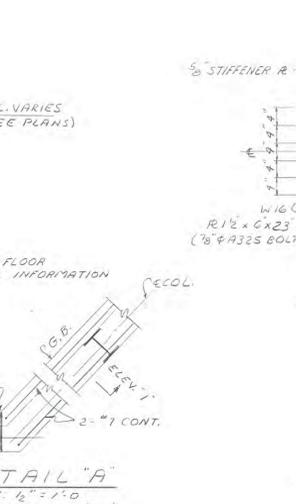


**TYP. SECTION THRU 1ST & 2ND FLOOR SPANDREL BEAMS**

SCALE: 3/4"=1'-0"

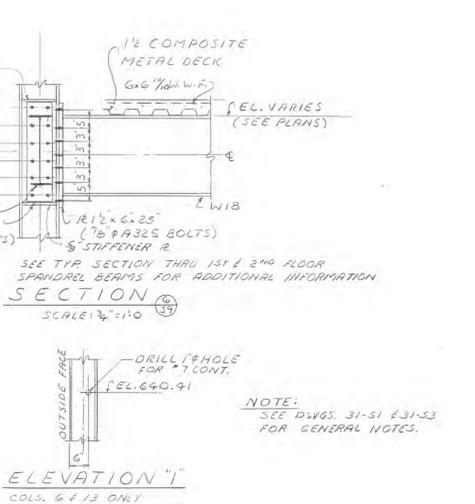


**ELEVATION 1**

SCALE: 1/2"=1'-0"

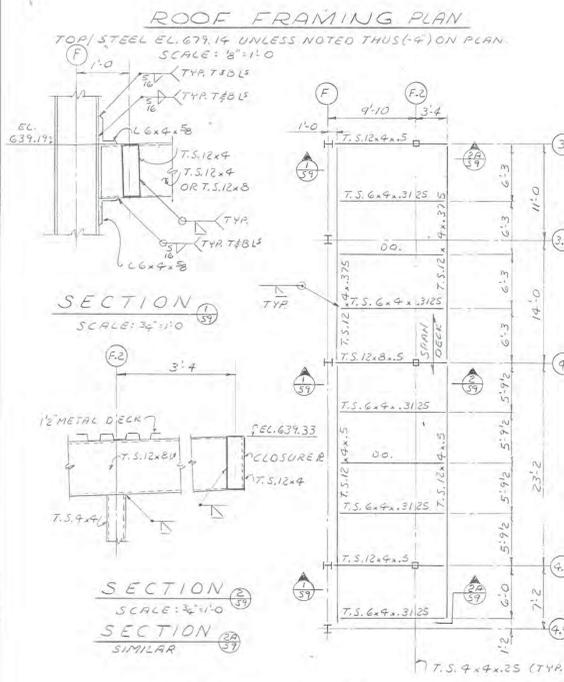


**LOADING PLATFORM ROOF FRAMING PLAN**

TOP/STEEL EL. AS NOTED IN SECTIONS.  
SCALE: 1/8"=1'-0"  
1 1/2" METAL DECK, 22 GAGE GALV. MIN. SP = 5/8" I = 214 IN<sup>3</sup>, I = 189 IN<sup>4</sup>

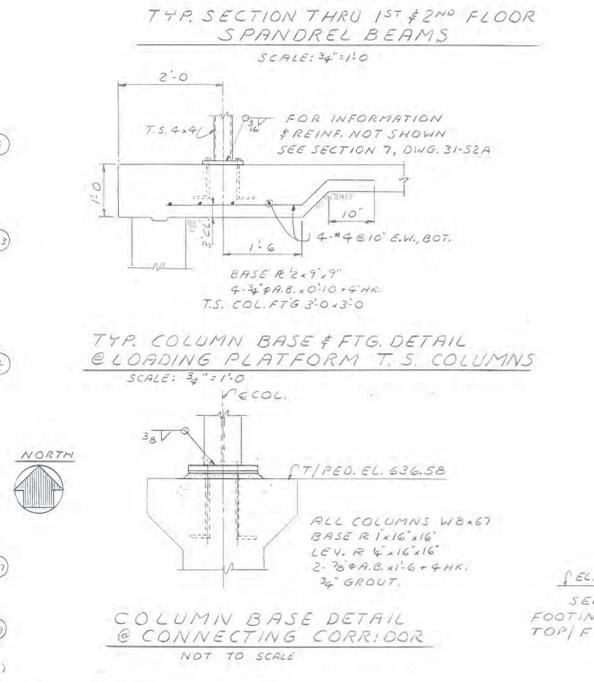


**TYP. COLUMN BASE & FTG. DETAIL @ LOADING PLATFORM T.S. COLUMNS**

SCALE: 3/4"=1'-0"

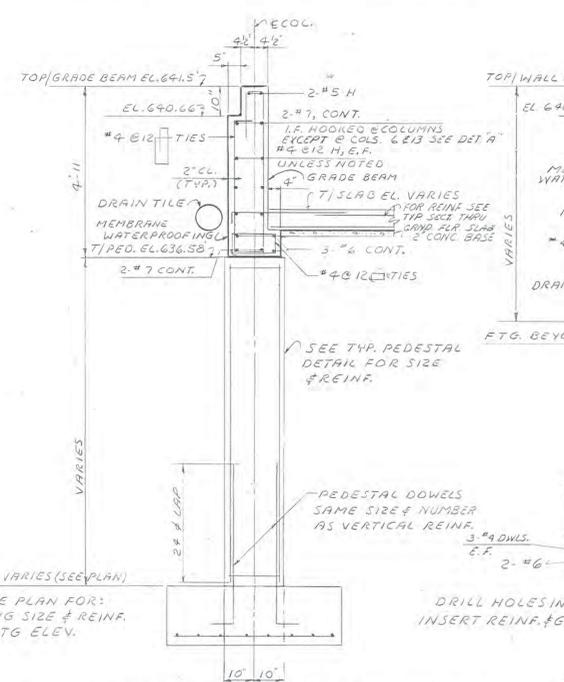


**TYP. PEDESTAL & GRADE BEAM DETAIL**

SCALE: 1/2"=1'-0"

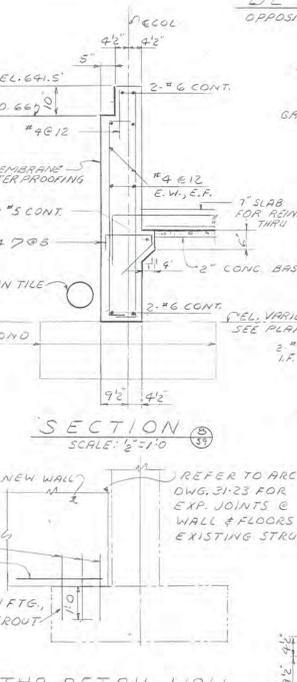


**TYP. DETAIL WALL @ EXISTING FTG.**

SCALE: 1/2"=1'-0"

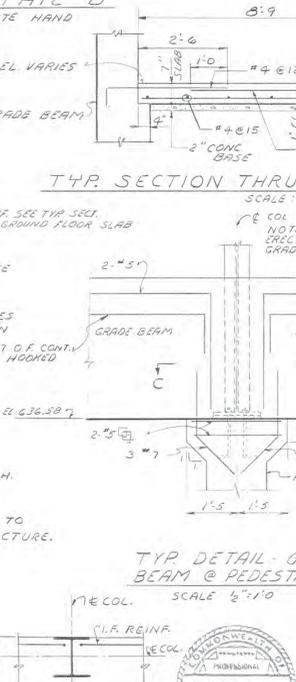

**TYP. SECTION THRU GROUND FLOOR SLAB**

SCALE: 1/2"=1'-0"

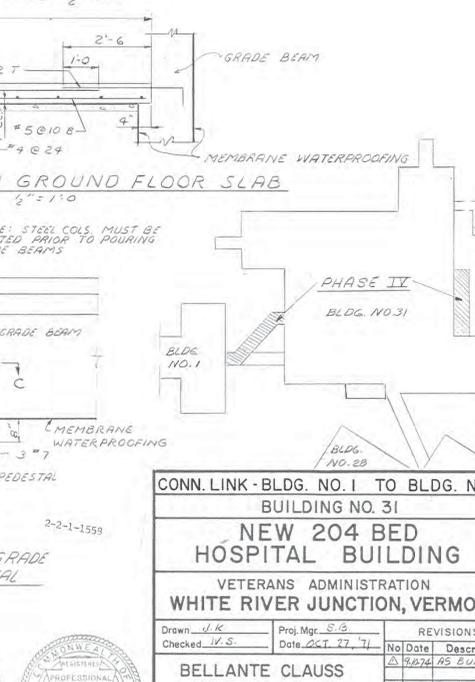

**TYP. DETAIL GRADE BEAM @ PEDESTAL**


SCALE: 1/2"=1'-0"

CONN. LINK - BLDG. NO. 1 TO BLDG. NO. 31  
BUILDING NO. 31  
**NEW 204 BED HOSPITAL BUILDING**  
VETERANS ADMINISTRATION  
WHITE RIVER JUNCTION, VERMONT

Drawn: J.K.	Proj. Mgr.: S.B.	REVISIONS
Checked: J.S.	Date: 2/27/71	No. Date Description
		1 1/2" AS BUILT


**BELLANTE CLAUS MILLER & NOLAN**  
ARCHITECTS ENGINEERS PLANNERS  
130 NORTH WASHINGTON AVE. SCRANTON, PA.

**DRAWING NUMBER**  
31-S9  
Sheet 9 of 12  
Proj. No. 44-5553

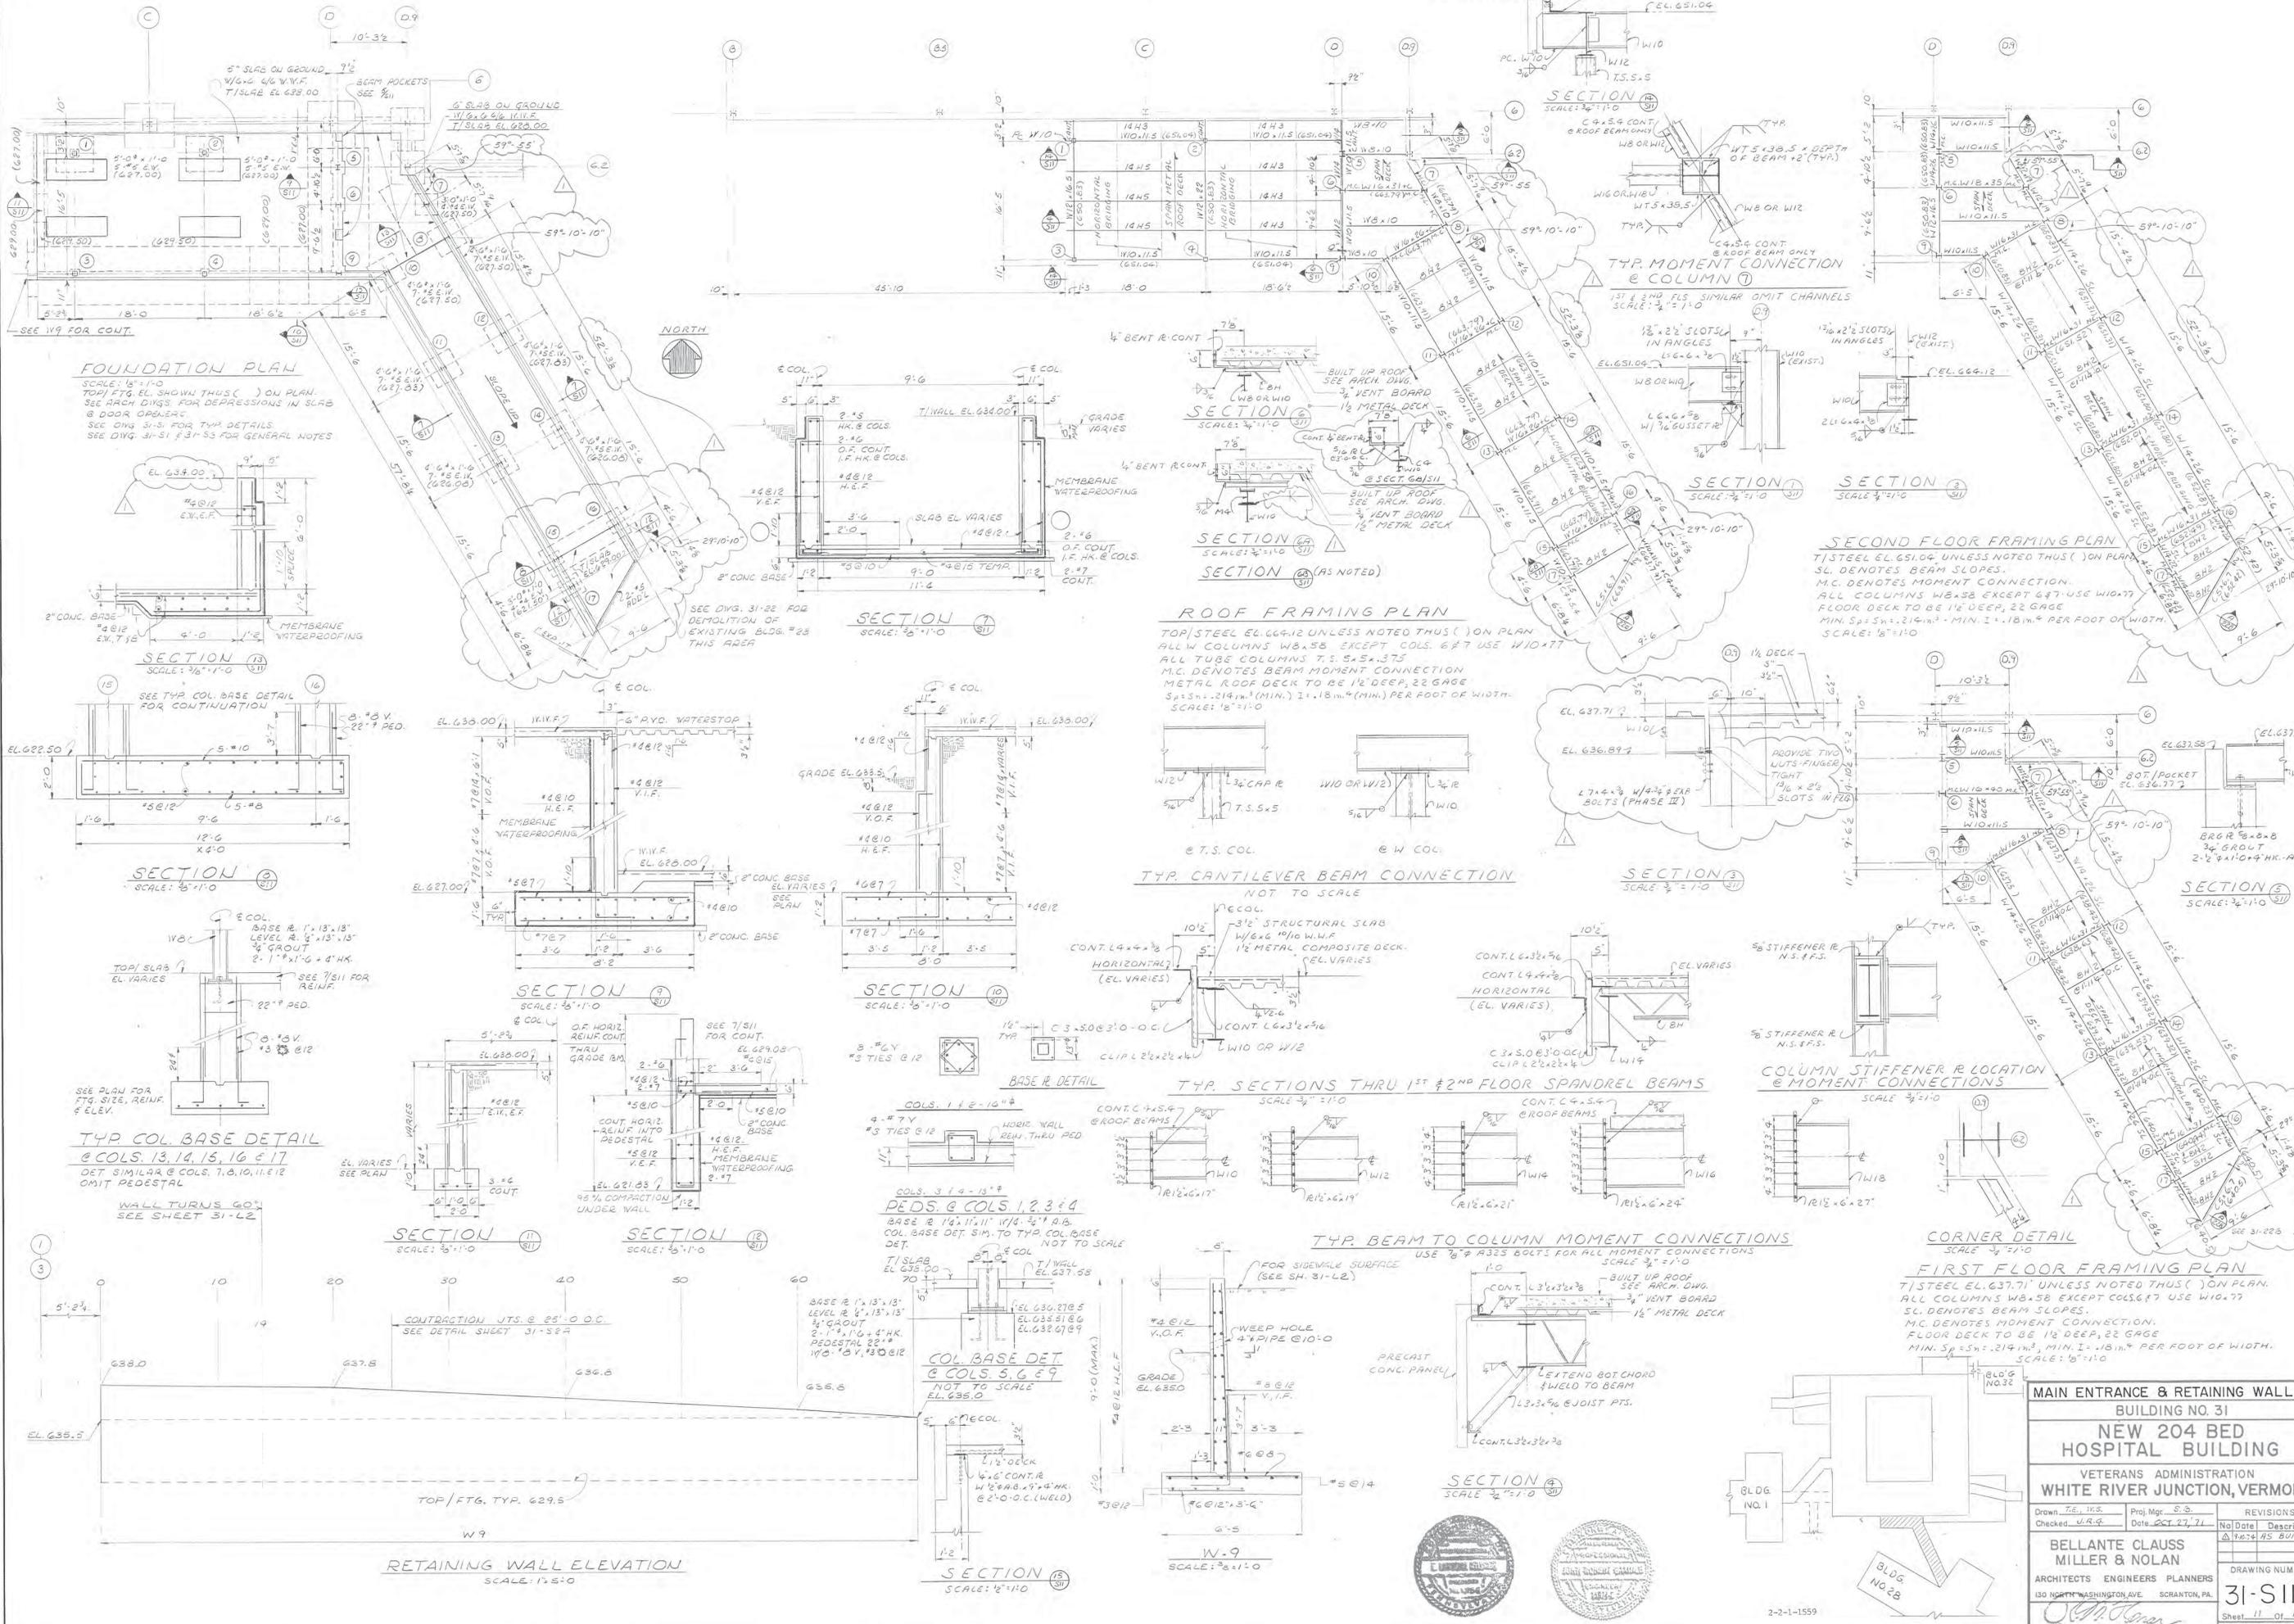


**FOUNDATION PLAN**


SCALE: 1/8"=1'-0"  
 TOP/FTG. EL. SHOWN THUS ( ) ON PLAN.  
 SEE ARCH. DIVS. FOR DEPRESSIONS IN SLAB  
 @ DOOR OPENERS.  
 SEE DIVG. 31-33 FOR TYP. DETAILS.  
 SEE DIVG. 31-51 & 31-53 FOR GENERAL NOTES.

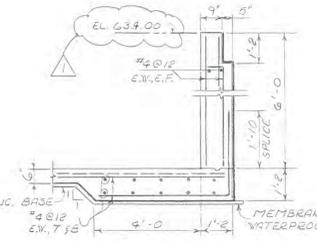

**SECTION 13**  
 SCALE: 3/8"=1'-0"

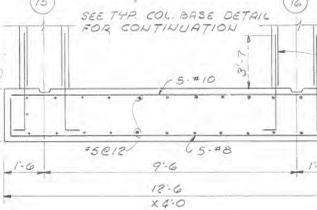


**SECTION 15**  
 SCALE: 3/8"=1'-0"

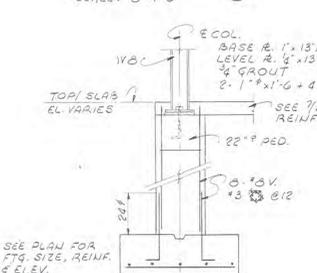


**SECTION 16**  
 SCALE: 3/8"=1'-0"

**TYP. COL. BASE DETAIL**  
 @ COLS. 13, 14, 15, 16 & 17  
 DET. SIMILAR @ COLS. 7, 8, 10, 11 & 12  
 OMIT PEDESTAL


WALL TURNS 60°  
 SEE SHEET 31-L2

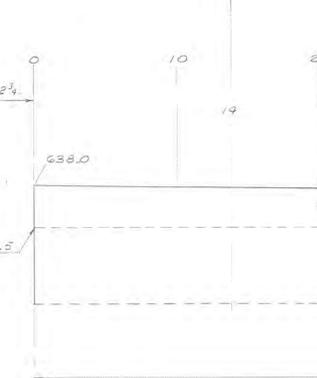


**RETAINING WALL ELEVATION**  
 SCALE: 1/2"=1'-0"

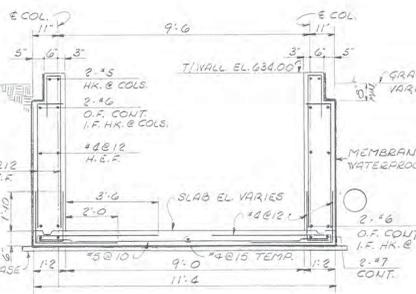


**SECTION 7**  
 SCALE: 3/8"=1'-0"

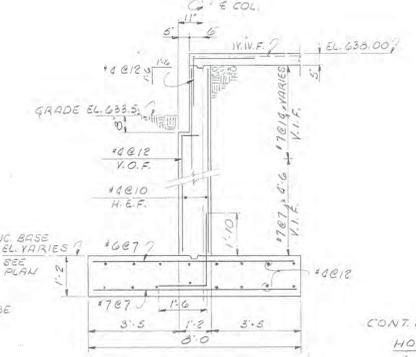

**SECTION 9**  
 SCALE: 3/8"=1'-0"

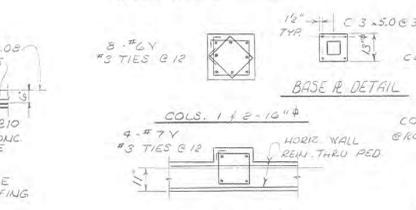


**SECTION 10**  
 SCALE: 3/8"=1'-0"

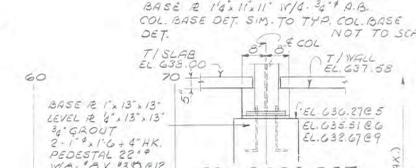

**SECTION 11**  
 SCALE: 3/8"=1'-0"




**SECTION 12**  
 SCALE: 3/8"=1'-0"

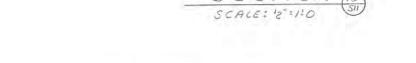


**SECTION 17**  
 SCALE: 3/8"=1'-0"

**ROOF FRAMING PLAN**


TOP/STEEL EL. 664.12 UNLESS NOTED THUS ( ) ON PLAN  
 ALL W. COLUMNS W.B.58 EXCEPT COLS. 6 & 7 USE W10x77  
 ALL TUBE COLUMNS T.S. 5x5x3/8  
 M.C. DENOTES BEAM MOMENT CONNECTION  
 METAL ROOF DECK TO BE 1/2" DEEP, 22 GAGE  
 MIN. SP. 5/8" x 2 1/4" MIN. 1.18 IN. 4 PER FOOT OF WIDTH.  
 SCALE: 1/8"=1'-0"

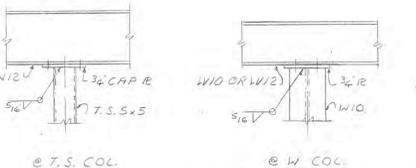


**TYP. CANTILEVER BEAM CONNECTION**  
 NOT TO SCALE

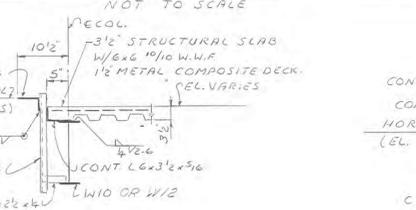


**TYP. SECTIONS THRU 1ST & 2ND FLOOR SPANDREL BEAMS**  
 SCALE: 3/8"=1'-0"

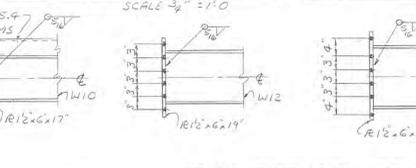

**TYP. BEAM TO COLUMN MOMENT CONNECTIONS**  
 USE 7/8" A325 BOLTS FOR ALL MOMENT CONNECTIONS  
 SCALE: 3/8"=1'-0"

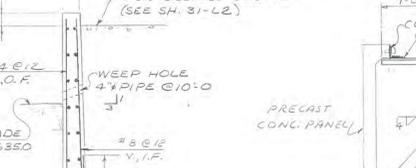

**COL. BASE DET @ COLS. 3, 6 & 9**  
 NOT TO SCALE

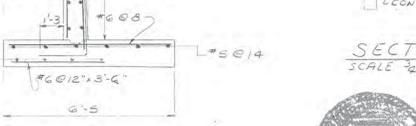


**SECTION 14**  
 SCALE: 3/8"=1'-0"




**SECTION 15**  
 SCALE: 3/8"=1'-0"

**SECOND FLOOR FRAMING PLAN**


T/STEEL EL. 651.02 UNLESS NOTED THUS ( ) ON PLAN  
 SL. DENOTES BEAM SLOPES.  
 M.C. DENOTES BEAM MOMENT CONNECTION.  
 ALL COLUMNS W.B.58 EXCEPT 6 & 7 USE W10x77  
 FLOOR DECK TO BE 1/2" DEEP, 22 GAGE  
 MIN. SP. 5/8" x 2 1/4" MIN. 1.18 IN. 4 PER FOOT OF WIDTH.  
 SCALE: 1/8"=1'-0"

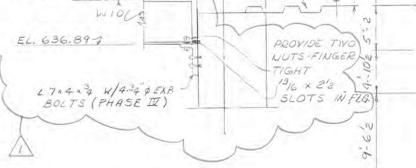

**CORNER DETAIL**  
 SCALE: 3/8"=1'-0"

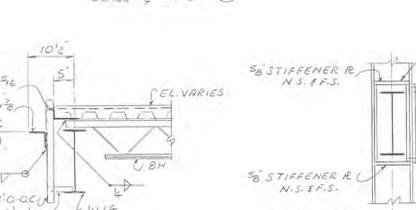

**COLUMN STIFFENER R LOCATION @ MOMENT CONNECTIONS**  
 SCALE: 3/8"=1'-0"

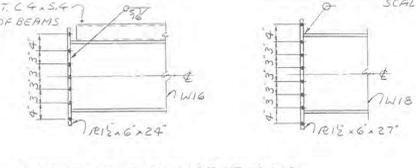

**FIRST FLOOR FRAMING PLAN**  
 T/STEEL EL. 637.71 UNLESS NOTED THUS ( ) ON PLAN.  
 ALL COLUMNS W.B.58 EXCEPT COLS. 6 & 7 USE W10x77  
 SL. DENOTES BEAM SLOPES.  
 M.C. DENOTES BEAM MOMENT CONNECTION.  
 FLOOR DECK TO BE 1/2" DEEP, 22 GAGE  
 MIN. SP. 5/8" x 2 1/4" MIN. 1.18 IN. 4 PER FOOT OF WIDTH.  
 SCALE: 1/8"=1'-0"



**MAIN ENTRANCE & RETAINING WALL**  
 BUILDING NO. 31

**NEW 204 BED HOSPITAL BUILDING**

VETERANS ADMINISTRATION  
 MILLER & NOLAN  
 ARCHITECTS ENGINEERS PLANNERS  
 150 NORTH WASHINGTON AVE. SCRANTON, PA.

Drawn: T.E., H.S. Checked: U.R.G. Proj. Mgr.: S.B. Date: OCT. 27, 71. REVISIONS: No. Date Description: 1. 10/27/71 AS BUILT.


BELLANTE CLAUS MILLER & NOLAN ARCHITECTS ENGINEERS PLANNERS 150 NORTH WASHINGTON AVE. SCRANTON, PA.

DRAWING NUMBER: 31-S11

Sheet 11 of 13 Proj. No. 44-5063


2-2-1-1559

RETURN DRAWINGS TO PLAN LIBRARY

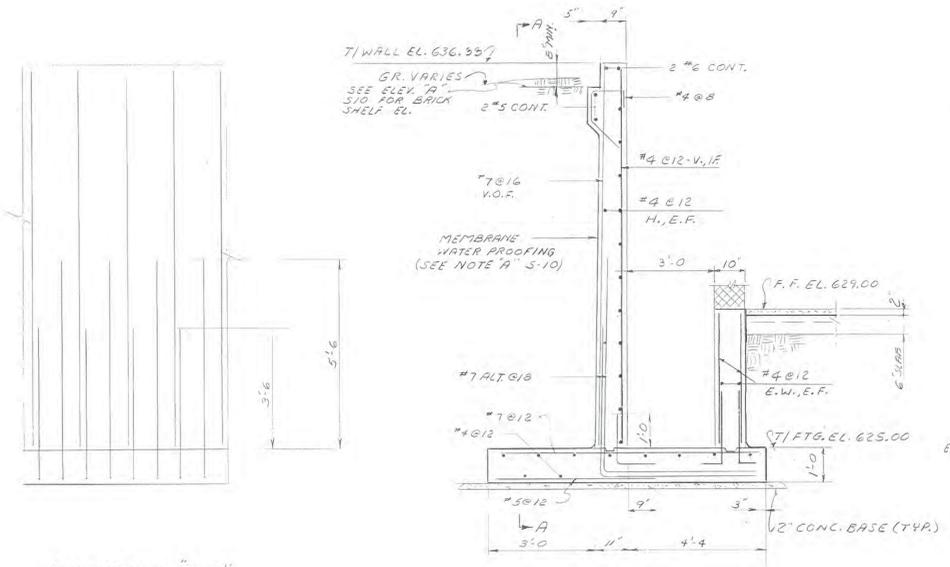


ELEVATION "A-A"

SECTION 1  
SCALE: 1/2"=1'-0"

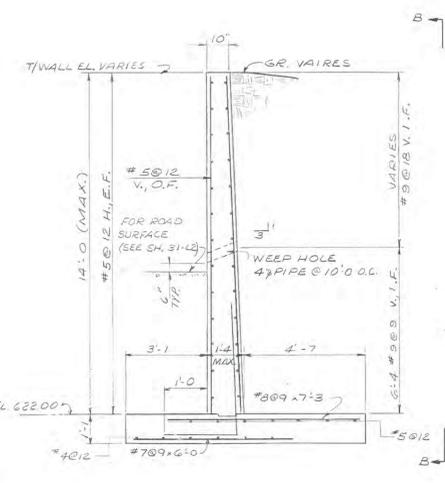


ELEVATION "B-B"

W 4  
SCALE: 3/8"=1'-0"

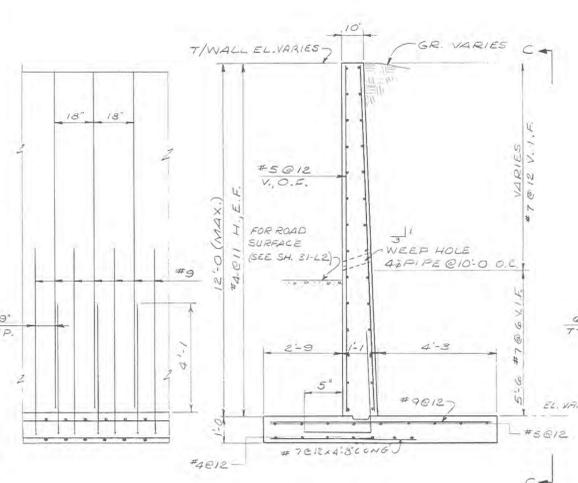


ELEVATION "C-C"


W 5  
SCALE: 3/8"=1'-0"

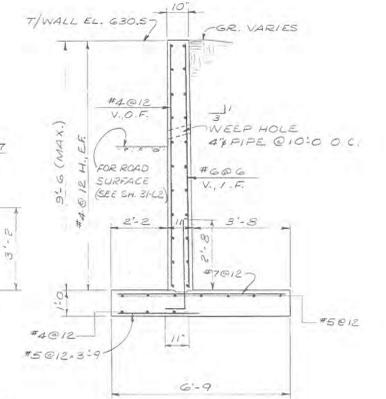


W 6  
SCALE: 3/8"=1'-0"

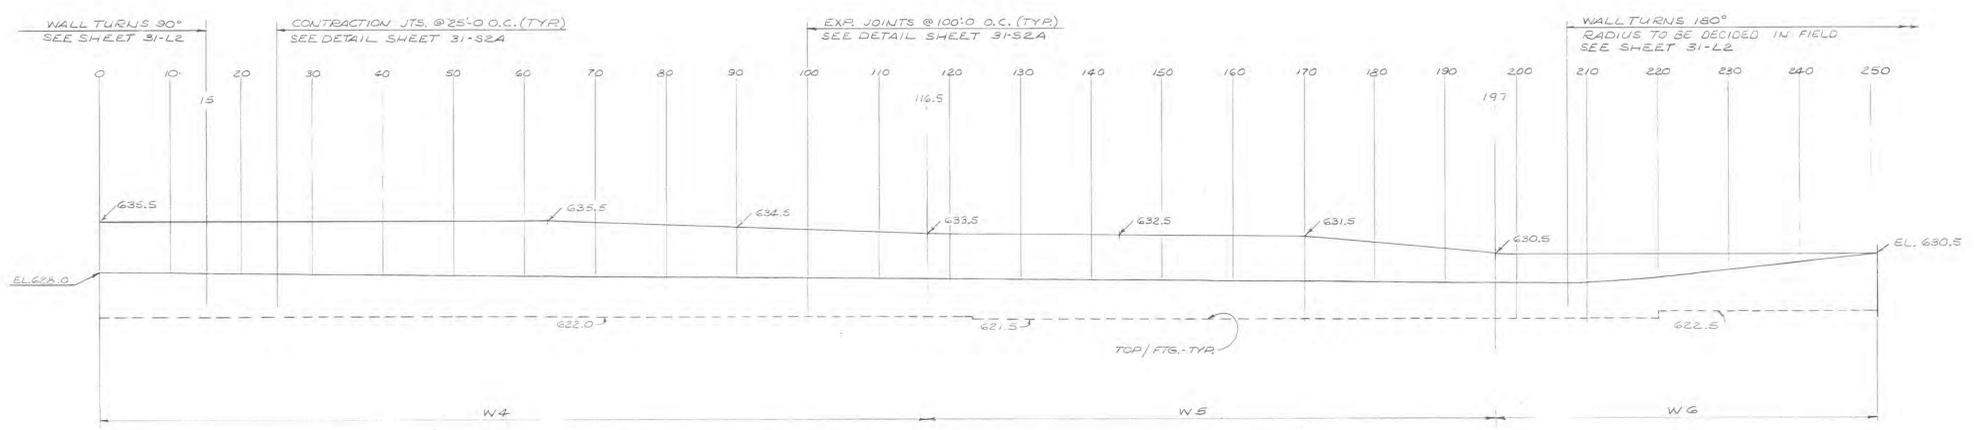

RETAINING WALL ELEVATION  
SCALE: 1"=10'-0"  
EAST PARKING NEAR OXYGEN STORAGE

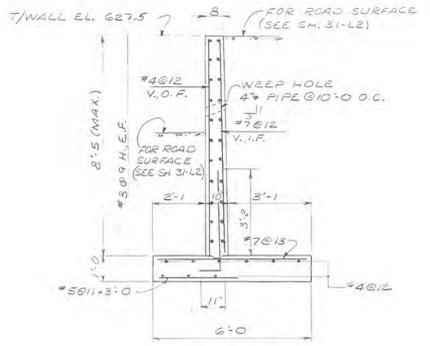

W 7 & W 8  
SCALE: 3/8"=1'-0"

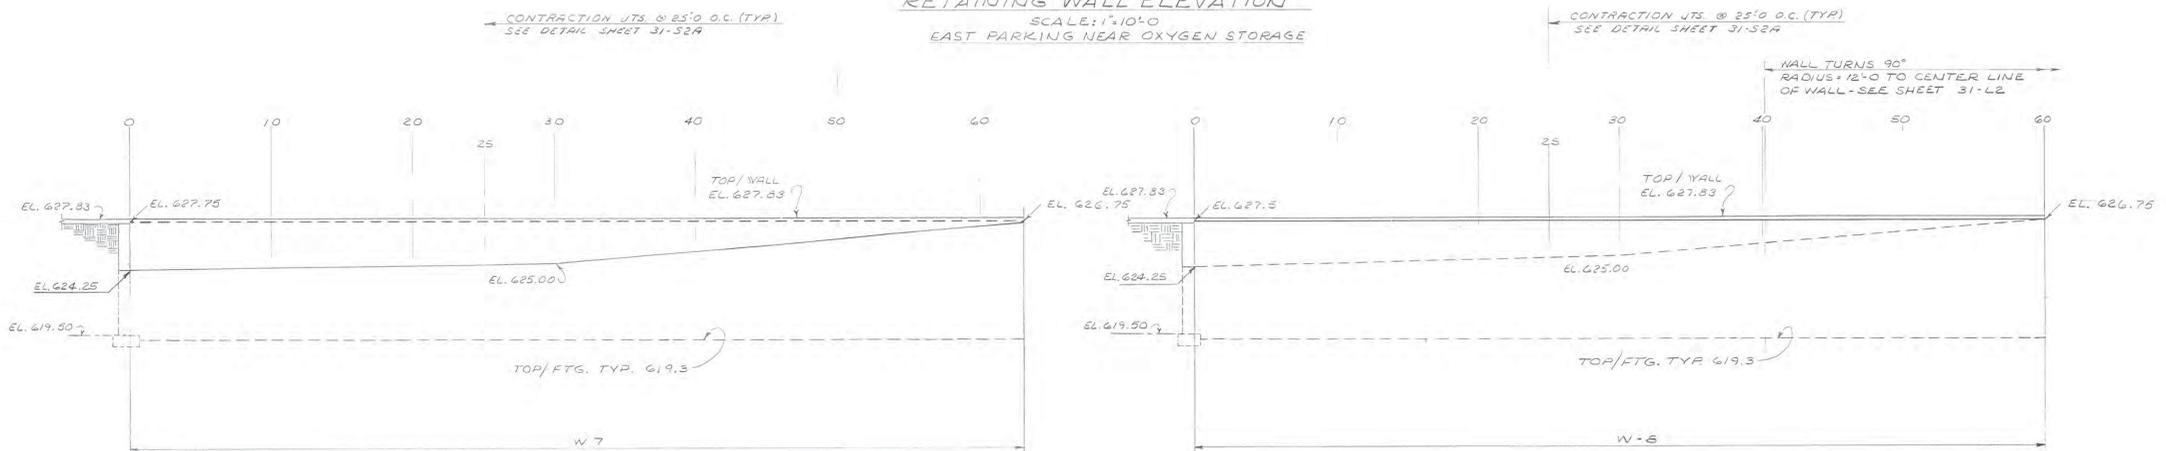


RETAINING WALL ELEVATION  
SCALE: 1"=5'-0"  
LOADING DOCK


RETAINING WALL ELEVATION  
SCALE: 1"=5'-0"  
LOADING DOCK

RETAINING WALLS		
BUILDING NO. 31		
NEW 204 BED HOSPITAL BUILDING		
VETERANS ADMINISTRATION WHITE RIVER JUNCTION, VERMONT		
Drawn: F.S.	Proj. Mgr.: J.B.	REVISIONS
Checked: J.C.	Date: 2/27/71	No.   Date   Description
BELLANTE CLAUS MILLER & NOLAN		1   9.27.73   BUILT
ARCHITECTS ENGINEERS PLANNERS 130 NORTH WASHINGTON AVE. SCRANTON, PA.		DRAWING NUMBER
31-S12		Sheet: 12 of 13
Proj. No. 44-5053		




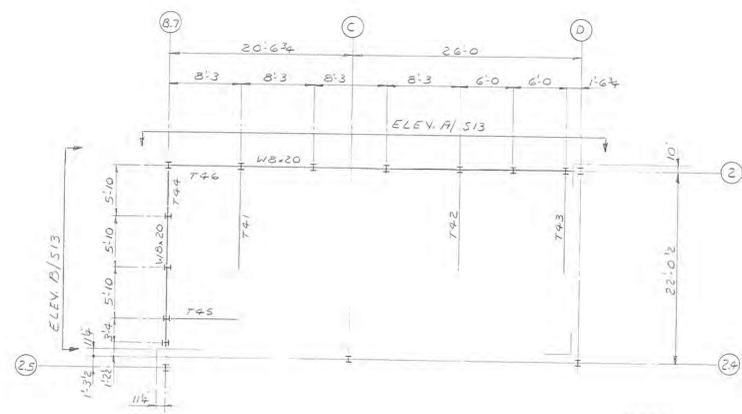


**ROOF SCREEN PLAN**  
 ALL COLUMNS W6x8.5  
 SCALE: 1/8"=1'-0"  
 SEE DWG. NO. 31-53 FOR GENERAL NOTES.

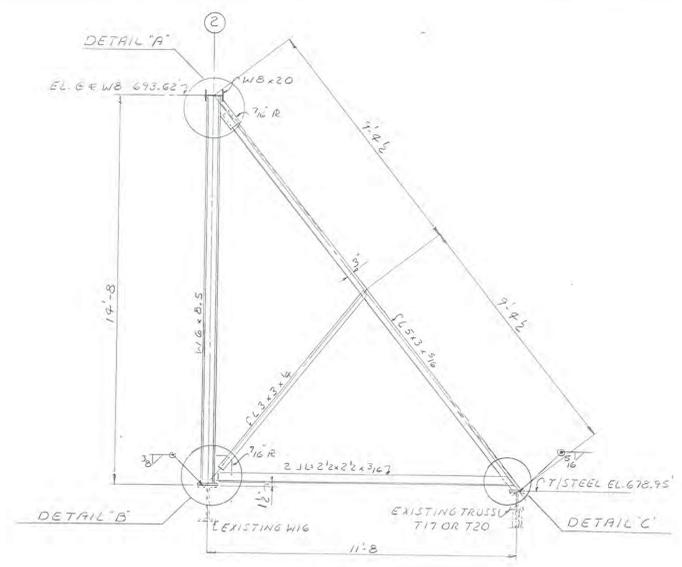


**TRUSS T41**  
**TRUSS T42**  
**TRUSS T43**  
 SCALE: 3/8"=1'-0"

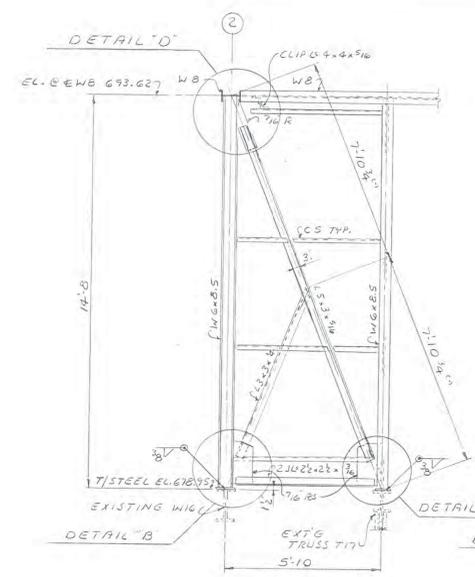


**TRUSS T44**  
 SCALE: 3/8"=1'-0"

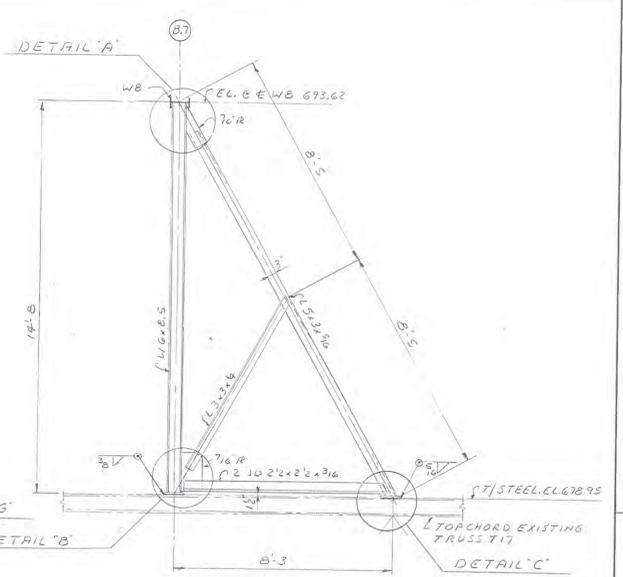


**TRUSS T45**  
 SCALE: 3/8"=1'-0"

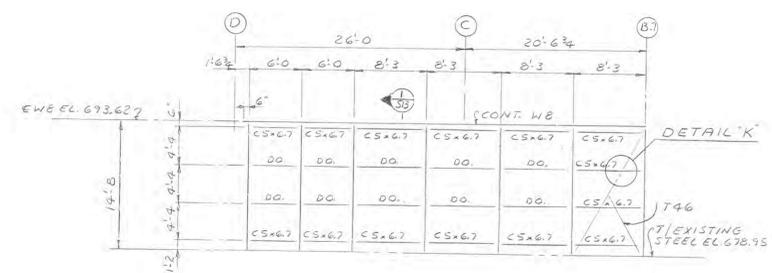


**ELEVATION A**  
 SCALE: 1/8"=1'-0"

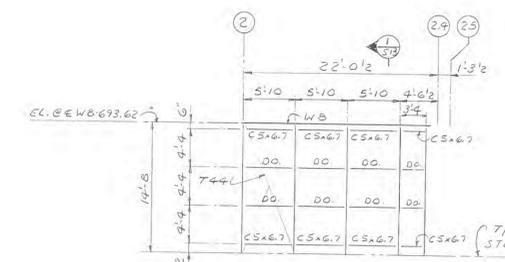


**ELEVATION B**  
 SCALE: 1/8"=1'-0"

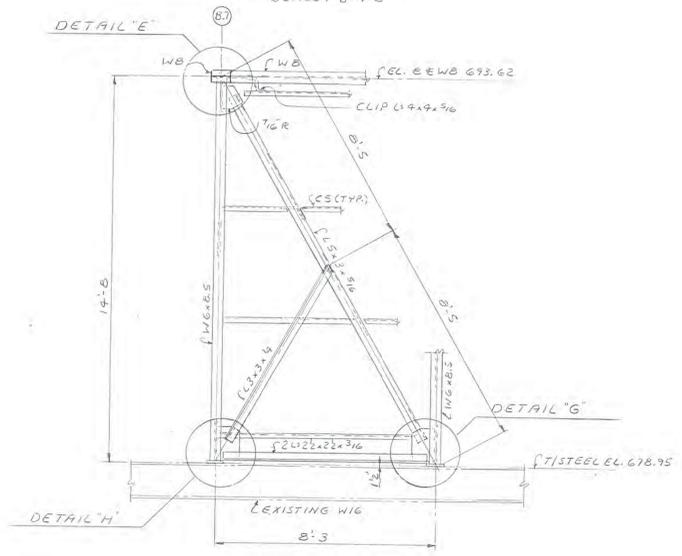


**TRUSS T46**  
 SCALE: 3/8"=1'-0"

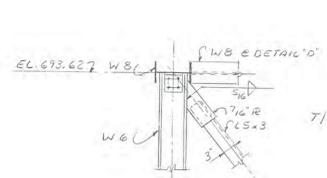


**DETAIL A'**  
 DETAIL D' SIMILAR  
 SCALE: 3/4"=1'-0"

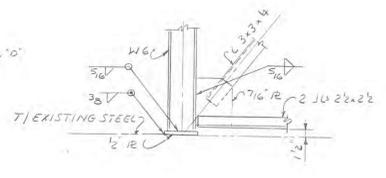


**DETAIL B'**  
 SCALE: 3/4"=1'-0"

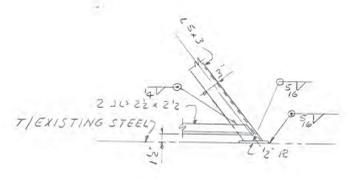


**DETAIL C'**  
 SCALE: 3/4"=1'-0"

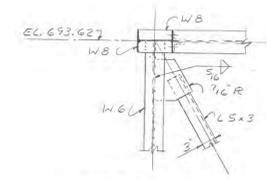


**DETAIL E'**  
 SCALE: 3/4"=1'-0"

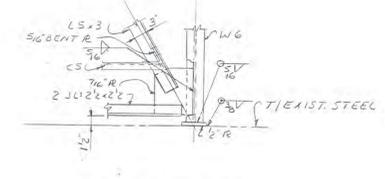


**DETAIL G'**  
 SCALE: 3/4"=1'-0"

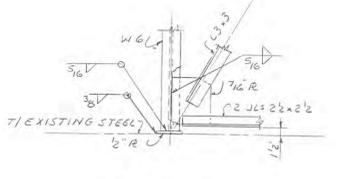


**DETAIL H'**  
 SCALE: 3/4"=1'-0"

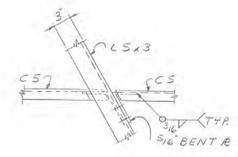


**DETAIL K'**  
 SCALE: 1"=1'-0"

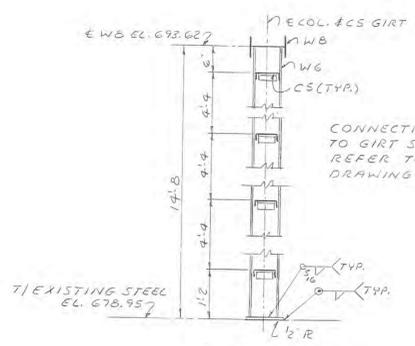

**SECTION**  
 SCALE: 3/4"=1'-0"

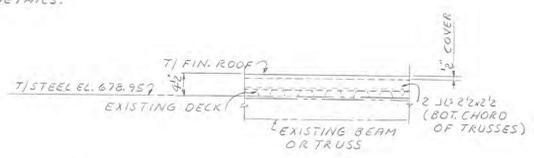

**TYP. DETAIL @ TRUSS BOTTOM CHORD**  
 SCALE: 3/4"=1'-0"

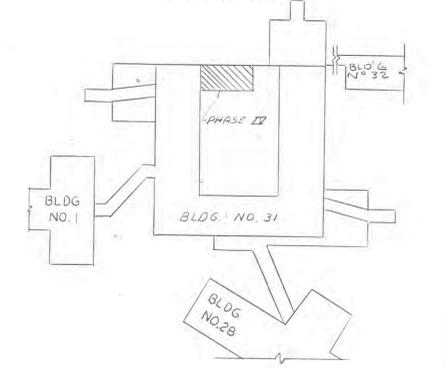

**PHASE IV**

**WIND SCREEN PLAN & DETAILS**  
 BUILDING NO. 31  
**NEW 204 BED HOSPITAL BUILDING**  
 VETERANS ADMINISTRATION  
 WHITE RIVER JUNCTION, VERMONT

Drawn: J.E. Proj. Mgr.: S.B.  
 Checked: J.R.G. Date: 04/27/11

**BELLANTE CLAUSS MILLER & NOLAN**  
 ARCHITECTS ENGINEERS PLANNERS  
 130 NORTH WASHINGTON AVE. SCRANTON, PA.

REVISIONS  
 No. Date Description  
 1 10/28/09 AS BUILT

DRAWING NUMBER  
**31-S13**  
 Sheet 01 of 27  
 Proj. No. 44-5083

