

ASBESTOS CONTAINING MATERIAL

1. - 12"x 12" BEIGE W/DARK BEIGE STREAKS VINYL FLOOR TILE
2. - BLACK FLOOR TILE MASTIC
3. - WHITE DUCT MASTIC
4. - BROWN METAL DUCT SEAM SLEANT
5. - WHITE SADDLE BLOCK
6. - WHITE PIPE MASTIC
7. - 12" x 12" BEIGE W/TAN STREAKS VINYL FLOOR TILE

○ - ASBESTOS CONTAINING MATERIAL DESIGNATION

PIV Renovations	9/29/15
Revisions	Date

Professional Seal

Z:\BEC Templates\BEC Logo 2013\BEC Logo: PDF.jpg


Boggs Environmental Consultants Inc.
200 W. Main Street, Middletown, MD 21769
Phone: 301-694-5687
www.boggsenvironmental.com

Drawing Title: BASEMENT FLOOR PLAN ARCHITECTURAL	Project Title: AS-BUILT Drawings		Date: 02-08-2017
Site:	Building Number: 500	Checked	Drawn
Approved:	Location: VAMC, MARTINSBURG WEST VIRGINIA		Project No. / Drawing No.

VAMC, MARTINSBURG

VA Department of Veterans Affairs

VA FORM 08-6231, OCT 1978

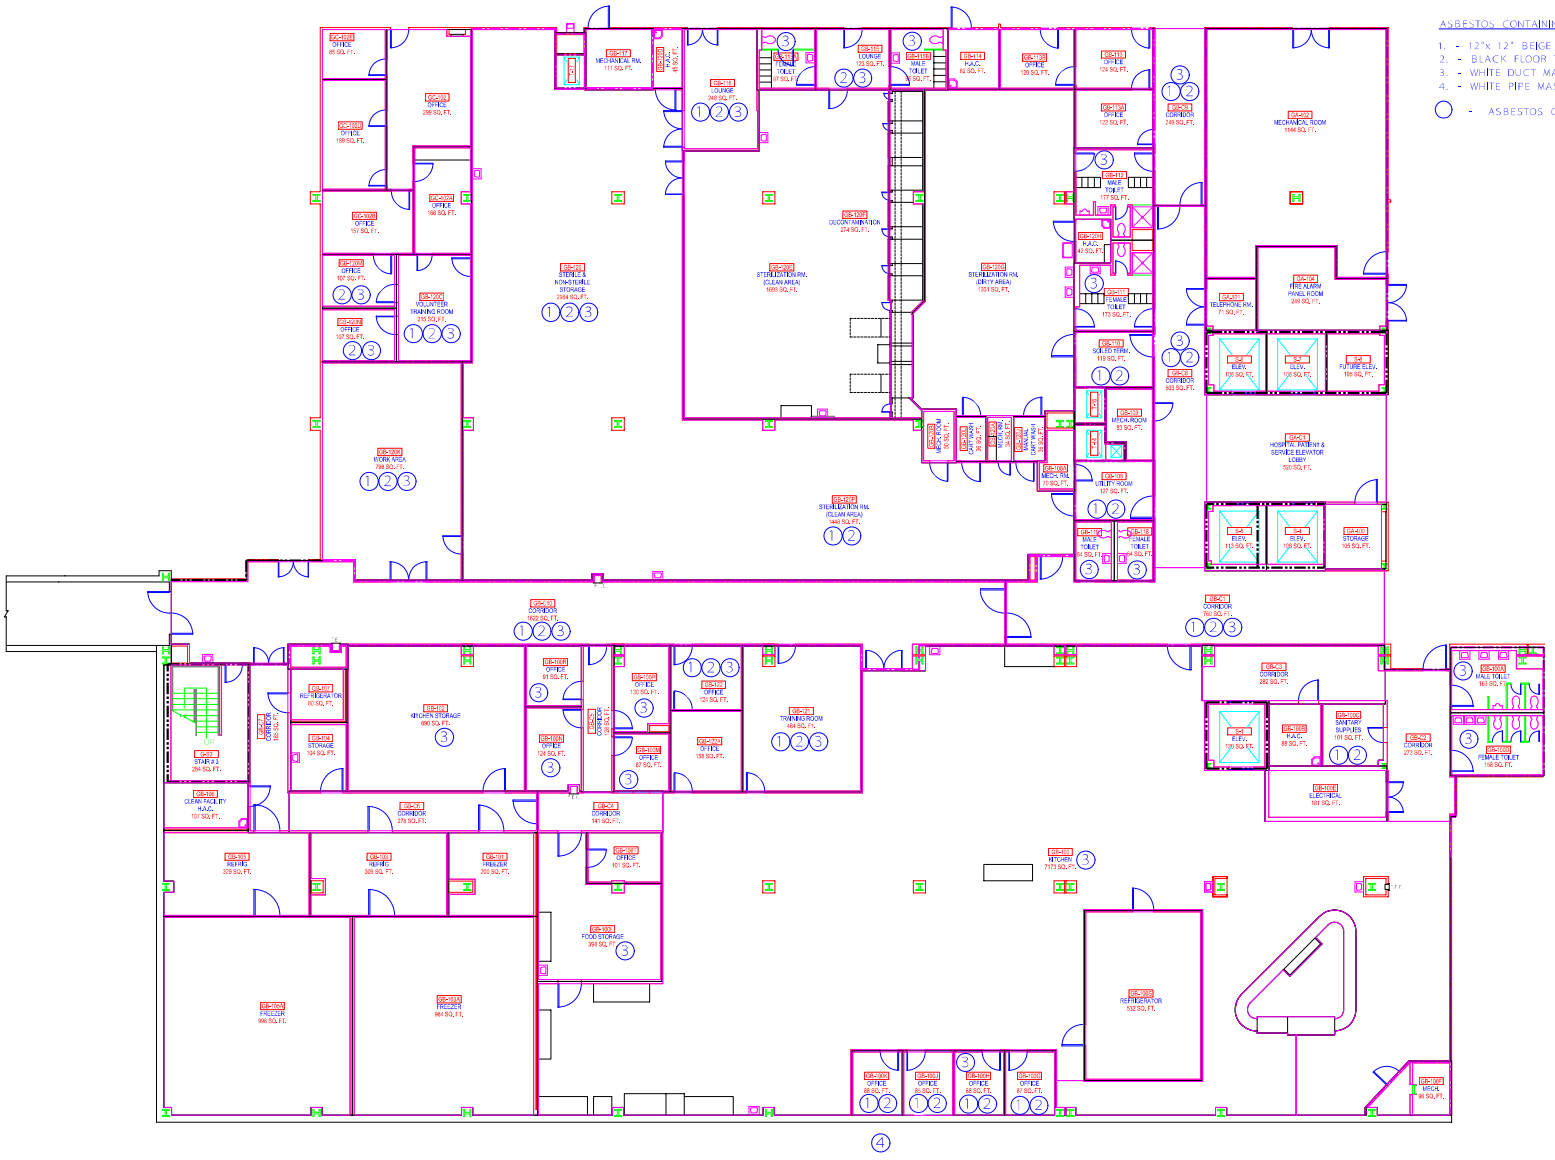

Boggs Environmental Consultants Inc.
200 W. Main Street, Middletown, MD 21769
Z:\BEC Templates\BEC Logo 2013\BEC Logo: PDF.jpg 301-694-5687
www.boggsenvironmental.com


Drawing Title: BASEMENT FLOOR PLAN ARCHITECTURAL
Project Title: AS-BUILT Drawings
Date: 02-08-2017
Project No.:
Drawing No.:
Site:
Building Number: 500
Checked:
Drawn:
Approved:
Location: VAMC, MARTINSBURG WEST VIRGINIA

PIV Renovations 9/29/15
Revisions Date

Professional Seal

VAMC, MARTINSBURG
VA Department of Veterans Affairs

VA FORM OR-6231, OCT 1978

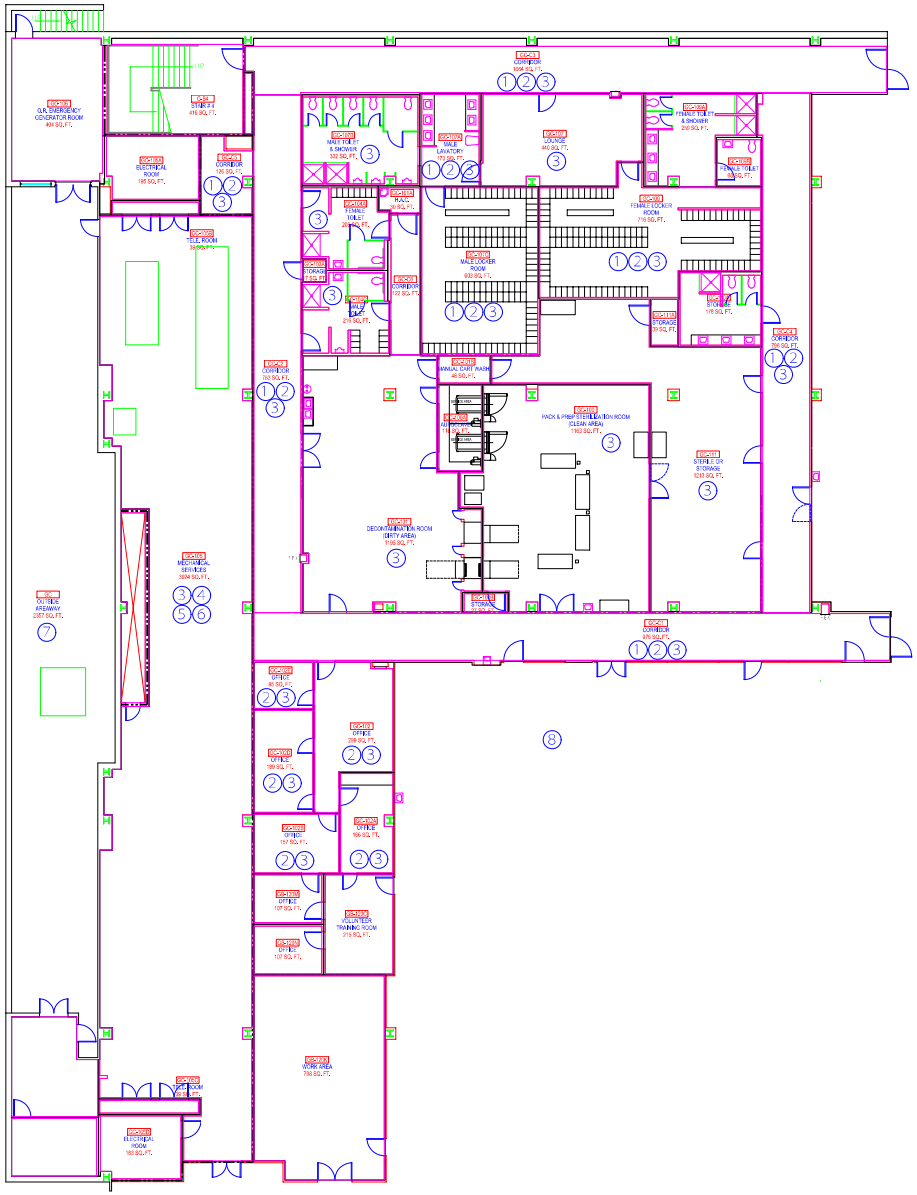

ASBESTOS CONTAINING MATERIAL

1. - 12"x 12" BEIGE W/DARK BEIGE STREAKS VINYL FLOOR TILE
2. - BLACK FLOOR TILE MASTIC
3. - WHITE DUCT MASTIC
4. - GRAY DUCT PUTTY
5. - WHITE SADDLE BLOCK
6. - YELLOW/GREEN/BROWN SEAM SEALANT
7. - TRANSITE
8. - WHITE PIPE MASTIC

◯ - ASBESTOS CONTAINING MATERIAL DESIGNATION

Boggs Environmental Consultants Inc.
200 W. Main Street, Middletown, MD 21769
(301) 694-5687
www.boggsenvironmental.com

Z:\BEC Templates\BEC Logo 2013\BEC Logo PDF.jpg

Drawing Title: BASEMENT FLOOR PLAN ARCHITECTURAL

Project Title: AS-BUILT Drawings

Date: 02-08-2017

Project No.:

Drawing No.:

Site:

Building Number: 500

Checked:

Drawn:

Approved:

Location: VAMC, MARTINSBURG WEST VIRGINIA

VAMC MARTINSBURG

VA Department of Veterans Affairs

PIV Renovations 9/29/15

Revisions Date


Professional Seal

VA FORM OR-6231, OCT 1978

ASBESTOS CONTAINING MATERIAL

1. - 12"x 12" BEIGE W/DARK BEIGE STREAKS VINYL FLOOR TILE
2. - BLACK FLOOR TILE MASTIC
3. - WHITE DUCT MASTIC
4. - GRAY METAL DUCT SEAM SEALANT
5. - WHITE SADDLE BLOCK
6. - YELLOW/GREEN/BROWN SEAM SEALANT
7. - TAN INSULATION PIN MASTIC
8. - EXPANSION JOINT CAULKING
9. - GRAY MASONRY SEAM SEALANT
10. - WHITE PIPE MASTIC

○ - ASBESTOS CONTAINING MATERIAL DESIGNATION

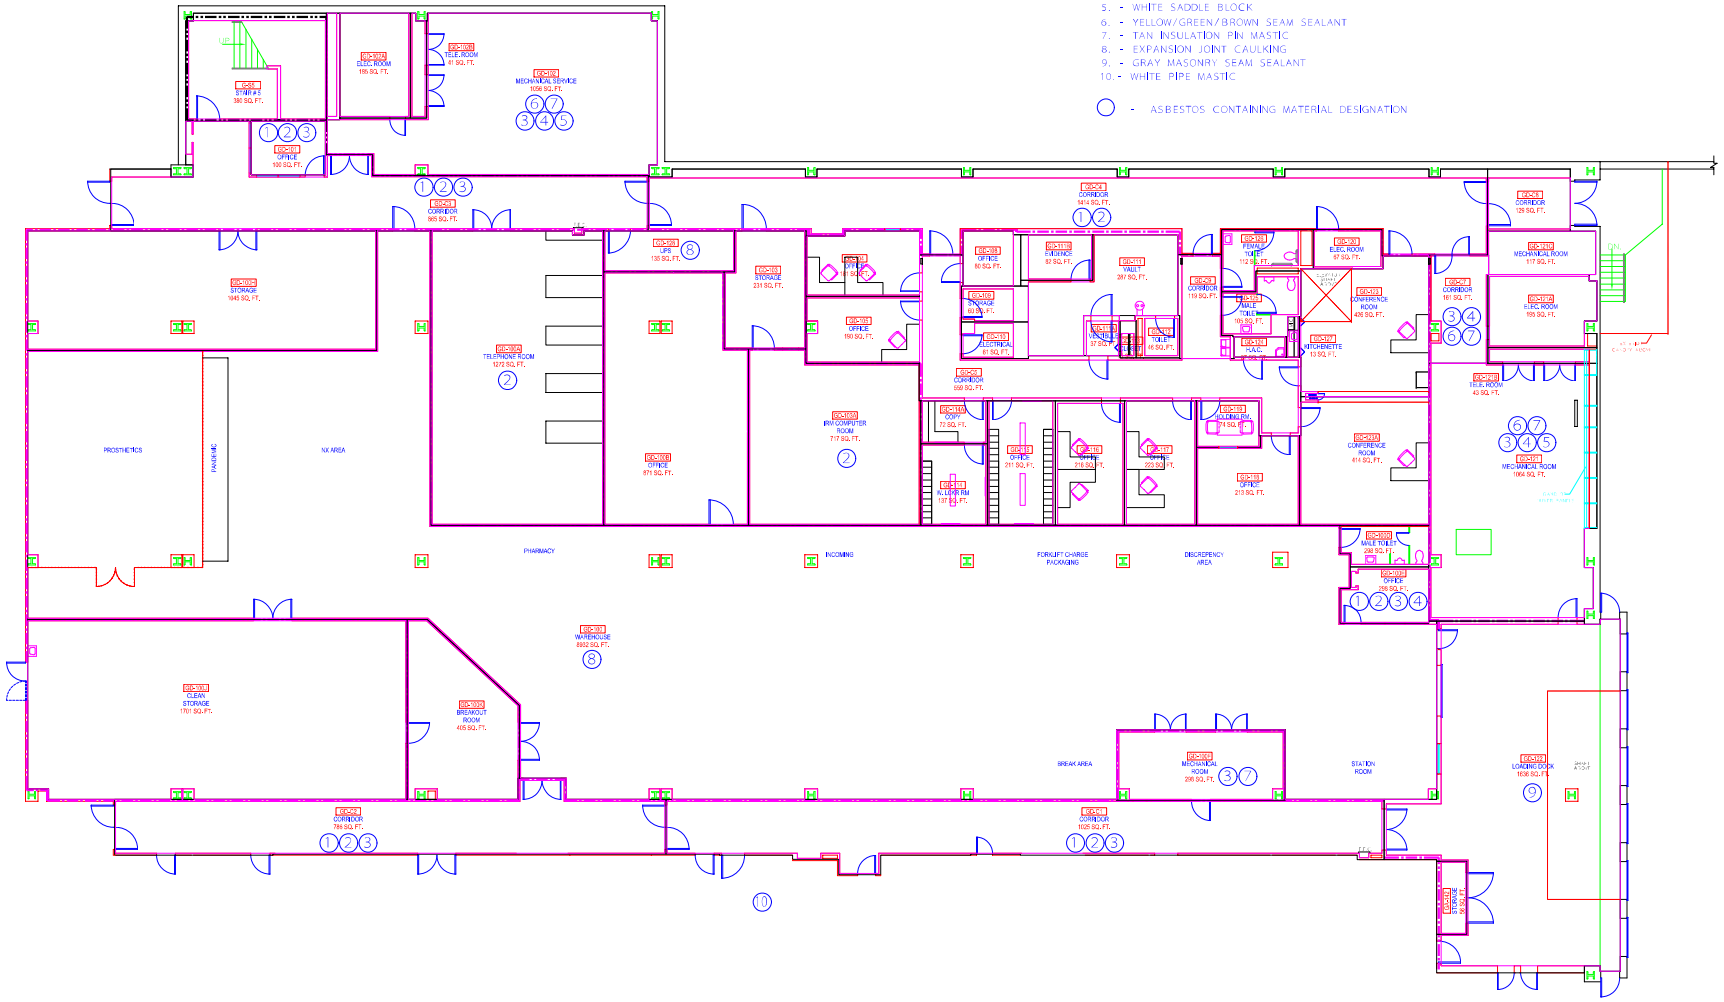


PIV Renovations	9/29/15	Boggs Environmental Consultants Inc.	Drawing Title: BASEMENT FLOOR PLAN ARCHITECTURAL	Project Title: AS-BUILT Drawings	Date: 02-08-2017
Revisions	Date	200 W. Main Street, Middletown, MD 21769	Site:	Building Number: 500	Checked:
		Z:\BEC Templates\BEC Logo 2013\BEC Logo PDF.pdf	Approved:	Location: VAMC, MARTINSBURG WEST VIRGINIA	Drawn:
		www.boggsenvironmental.com			Project No.
		Professional Seal			Drawing No.

VAMC, MARTINSBURG

VA Department of Veterans Affairs

VA FORM 08-6231, OCT 1978

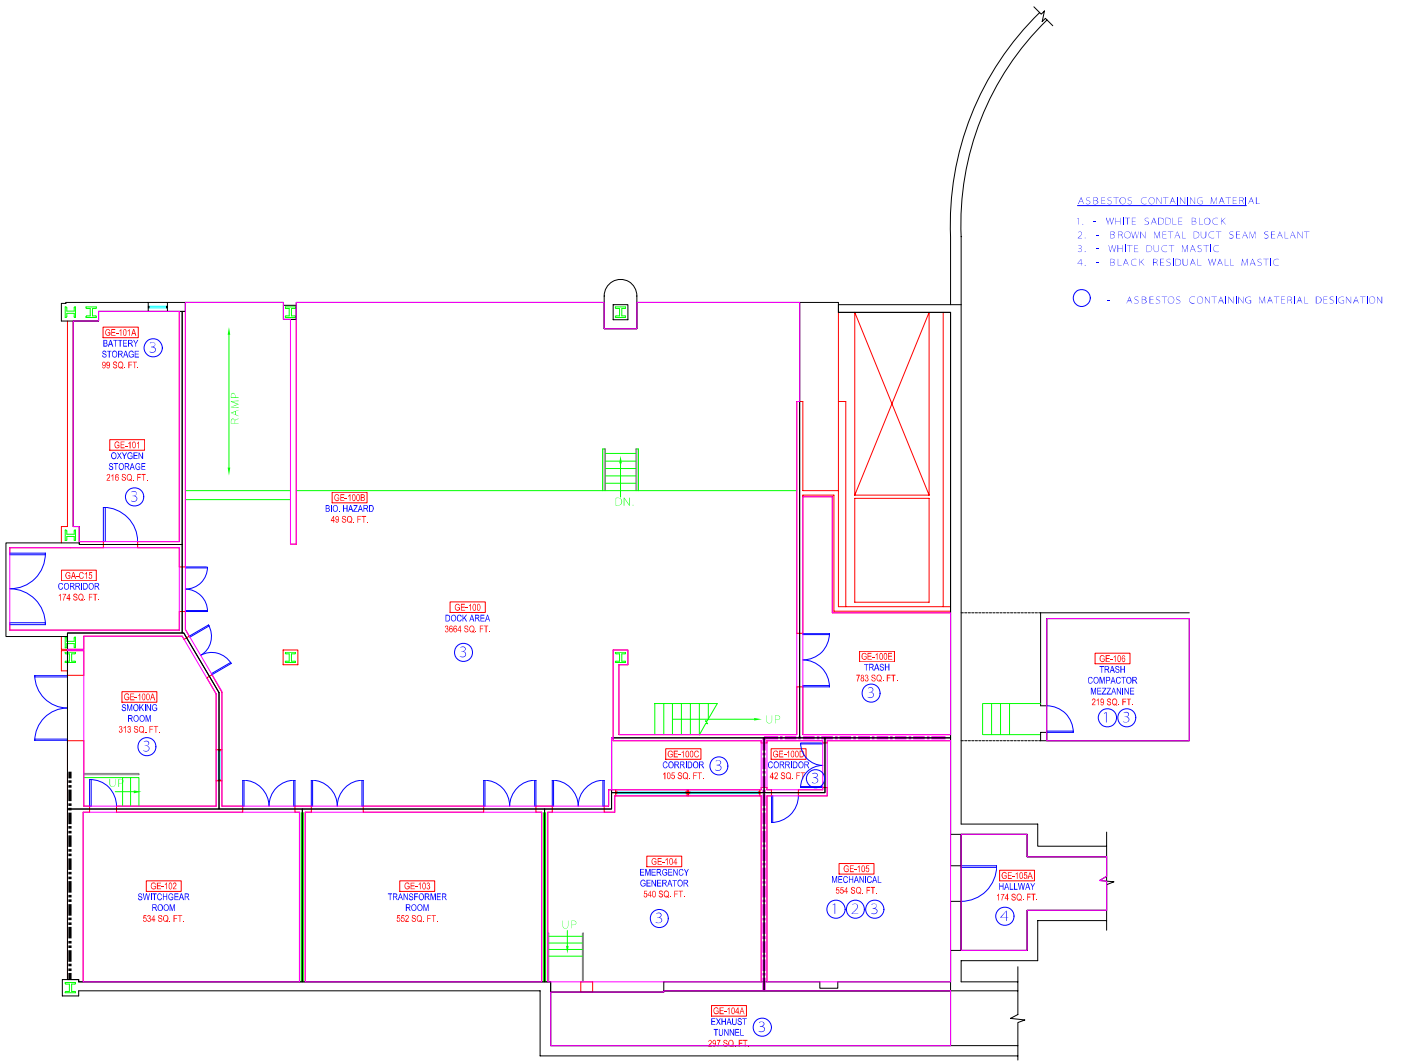

PIV Renovations	9/29/15	Z:\BEC Templates\BEC Logo 2013\BEC Logo PDF.pdf	Boggs Environmental Consultants Inc. 200 W. Main Street, Middletown, MD 21769 (301) 694-5687 www.boggsenvironmental.com	Drawing Title: BASEMENT FLOOR PLAN ARCHITECTURAL	Project Title: AS-BUILT Drawings	Date: 02-08-2017
Revisions	Date			Site:	Building Number: 500 / Checked / Drawn	Project No.
		Professional Seal		Approved:	Location: VAMC, MARTINSBURG WEST VIRGINIA	Drawing No.

VAMC MARTINSBURG

Department of Veterans Affairs

VA FORM 08-6231, OCT 1978