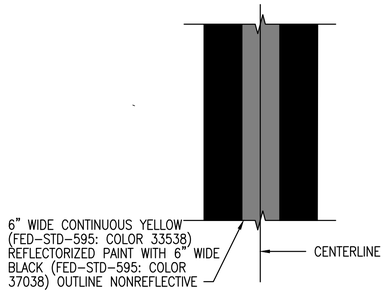

CENTERLINE MARKING C1

NOT TO SCALE

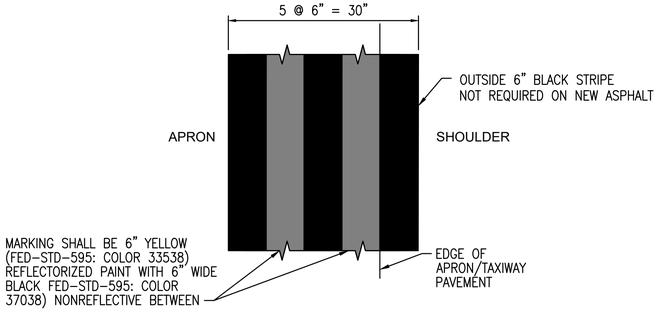

NOTE:

1. SEE DETAIL B2, THIS SHEET, FOR EDGE MARKINGS AT CONCRETE FILLET/RADII.

TAXIWAY/HCP APRON EDGE MARKING C2

NOT TO SCALE

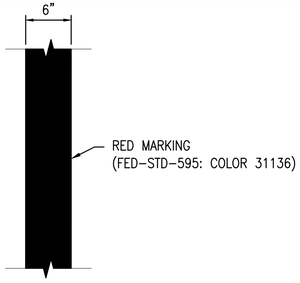

NOTE:

1. SEE DETAIL A1, THIS SHEET FOR ADDITIONAL MARKINGS.
2. SEE DETAILS B1, THIS SHEET, FOR RESTRICTED BOUNDARY SIGNS TO BE PAINTED EVERY 100' ALONG RESTRICTED BOUNDARY MARKINGS. COORDINATE WITH JOINT BASE ANDREWS SECURITY OFFICE.

RESTRICTED BOUNDARY MARKING (RED LINE) C3

NOT TO SCALE

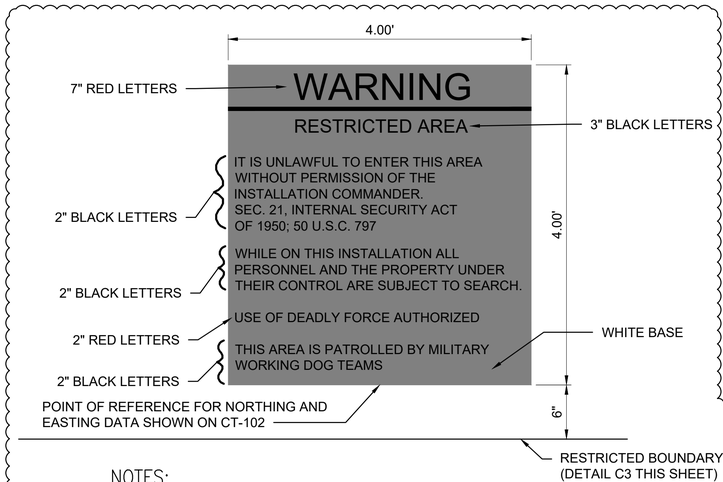

NOTES:

1. SIGN SHALL BE PAINTED ON PAVEMENT AT ECP AND EVERY 100FT ALONG REDLINE.
2. COORDINATE LOCATION WITH COR.
3. SIGN SHALL MEET REQUIREMENTS OF JOINT BASE ANDREWS SECURITY OFFICE.

RESTRICTED AREA PAVEMENT SIGN B1

NOT TO SCALE

TYPICAL EDGE STRIPE AT FILLET B2

NOT TO SCALE

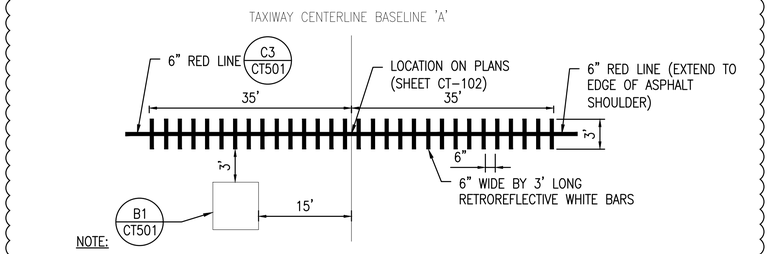

NOTE:

1. ENTRY CONTROL POINT MARKINGS ARE 6" WIDE BY 3' LONG RETROREFLECTIVE WHITE BARS SEPARATED BY 6" GAPS.
2. RESTRICTED AREA BOUNDAR IS A 6" WIDE RED BORDER AROUND THE RESTRICTED AREA.
3. SEE DETAIL B1, THIS SHEET, FOR ADDITIONAL MARKINGS.
4. SIGN SHALL MEET REQUIREMENTS OF JOINT BASE ANDREWS SECURITY OFFICE.

ENTRY CONTROL POINT (ECP) A1

NOT TO SCALE

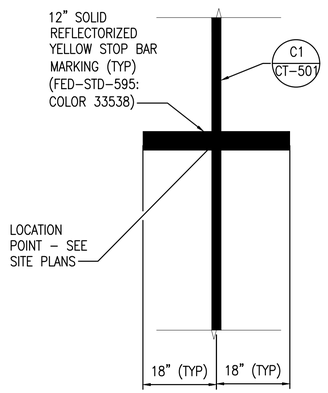

STOP BAR MARKING A4

NOT TO SCALE

SYM	DESCRIPTION	DATE	APPR
2	AMENDMENT 0005	04/15/2023	
1	AMENDMENT 0004	04/01/2023	
0	ISSUE FOR CONSTRUCTION	09/26/2022	

NAVFAC

STATE OF MARYLAND — KEVIN WAYNE MARKS — 29726 — PROFESSIONAL ENGINEER — 09/26/2022

SEAL

Wiley|Wilson | BURNS McDONNELL

JOINT VENTURE

A/E INFO

APPROVED

FOR COMMANDER NAVFAC

ACTIVITY

SATISFACTORY TO DATE

DES | DRW | CHK

PMOM

BRANCH MANAGER

CHIEF ENG/ARCH

FIRE PROTECTION

MDE NO. 21-SF-0064

DEPARTMENT OF THE NAVY
NAVAL FACILITIES ENGINEERING COMMAND
WASHINGTON NAVY YARD

NAVAL FACILITIES ENGINEERING COMMAND – WASHINGTON
WASHINGTON, DC

JOINT BASE ANDREWS NAVAL AIR FACILITY
CAMP SPRINGS, MD

P-3002 RELOCATE HAZARDOUS CARGO PAD AND EOD PROFICIENCY RANGE

TAXIWAY MARKING DETAILS

SCALE: AS NOTED

EPROJECT NO.: 1396650

CONSTR. CONTR. NO. N40080-22-R-8580

NAVFAC DRAWING NO. 13140359

SHEET 89 OF 229

CT-501

DRAWFORM REVISION: 06 APRIL 2017